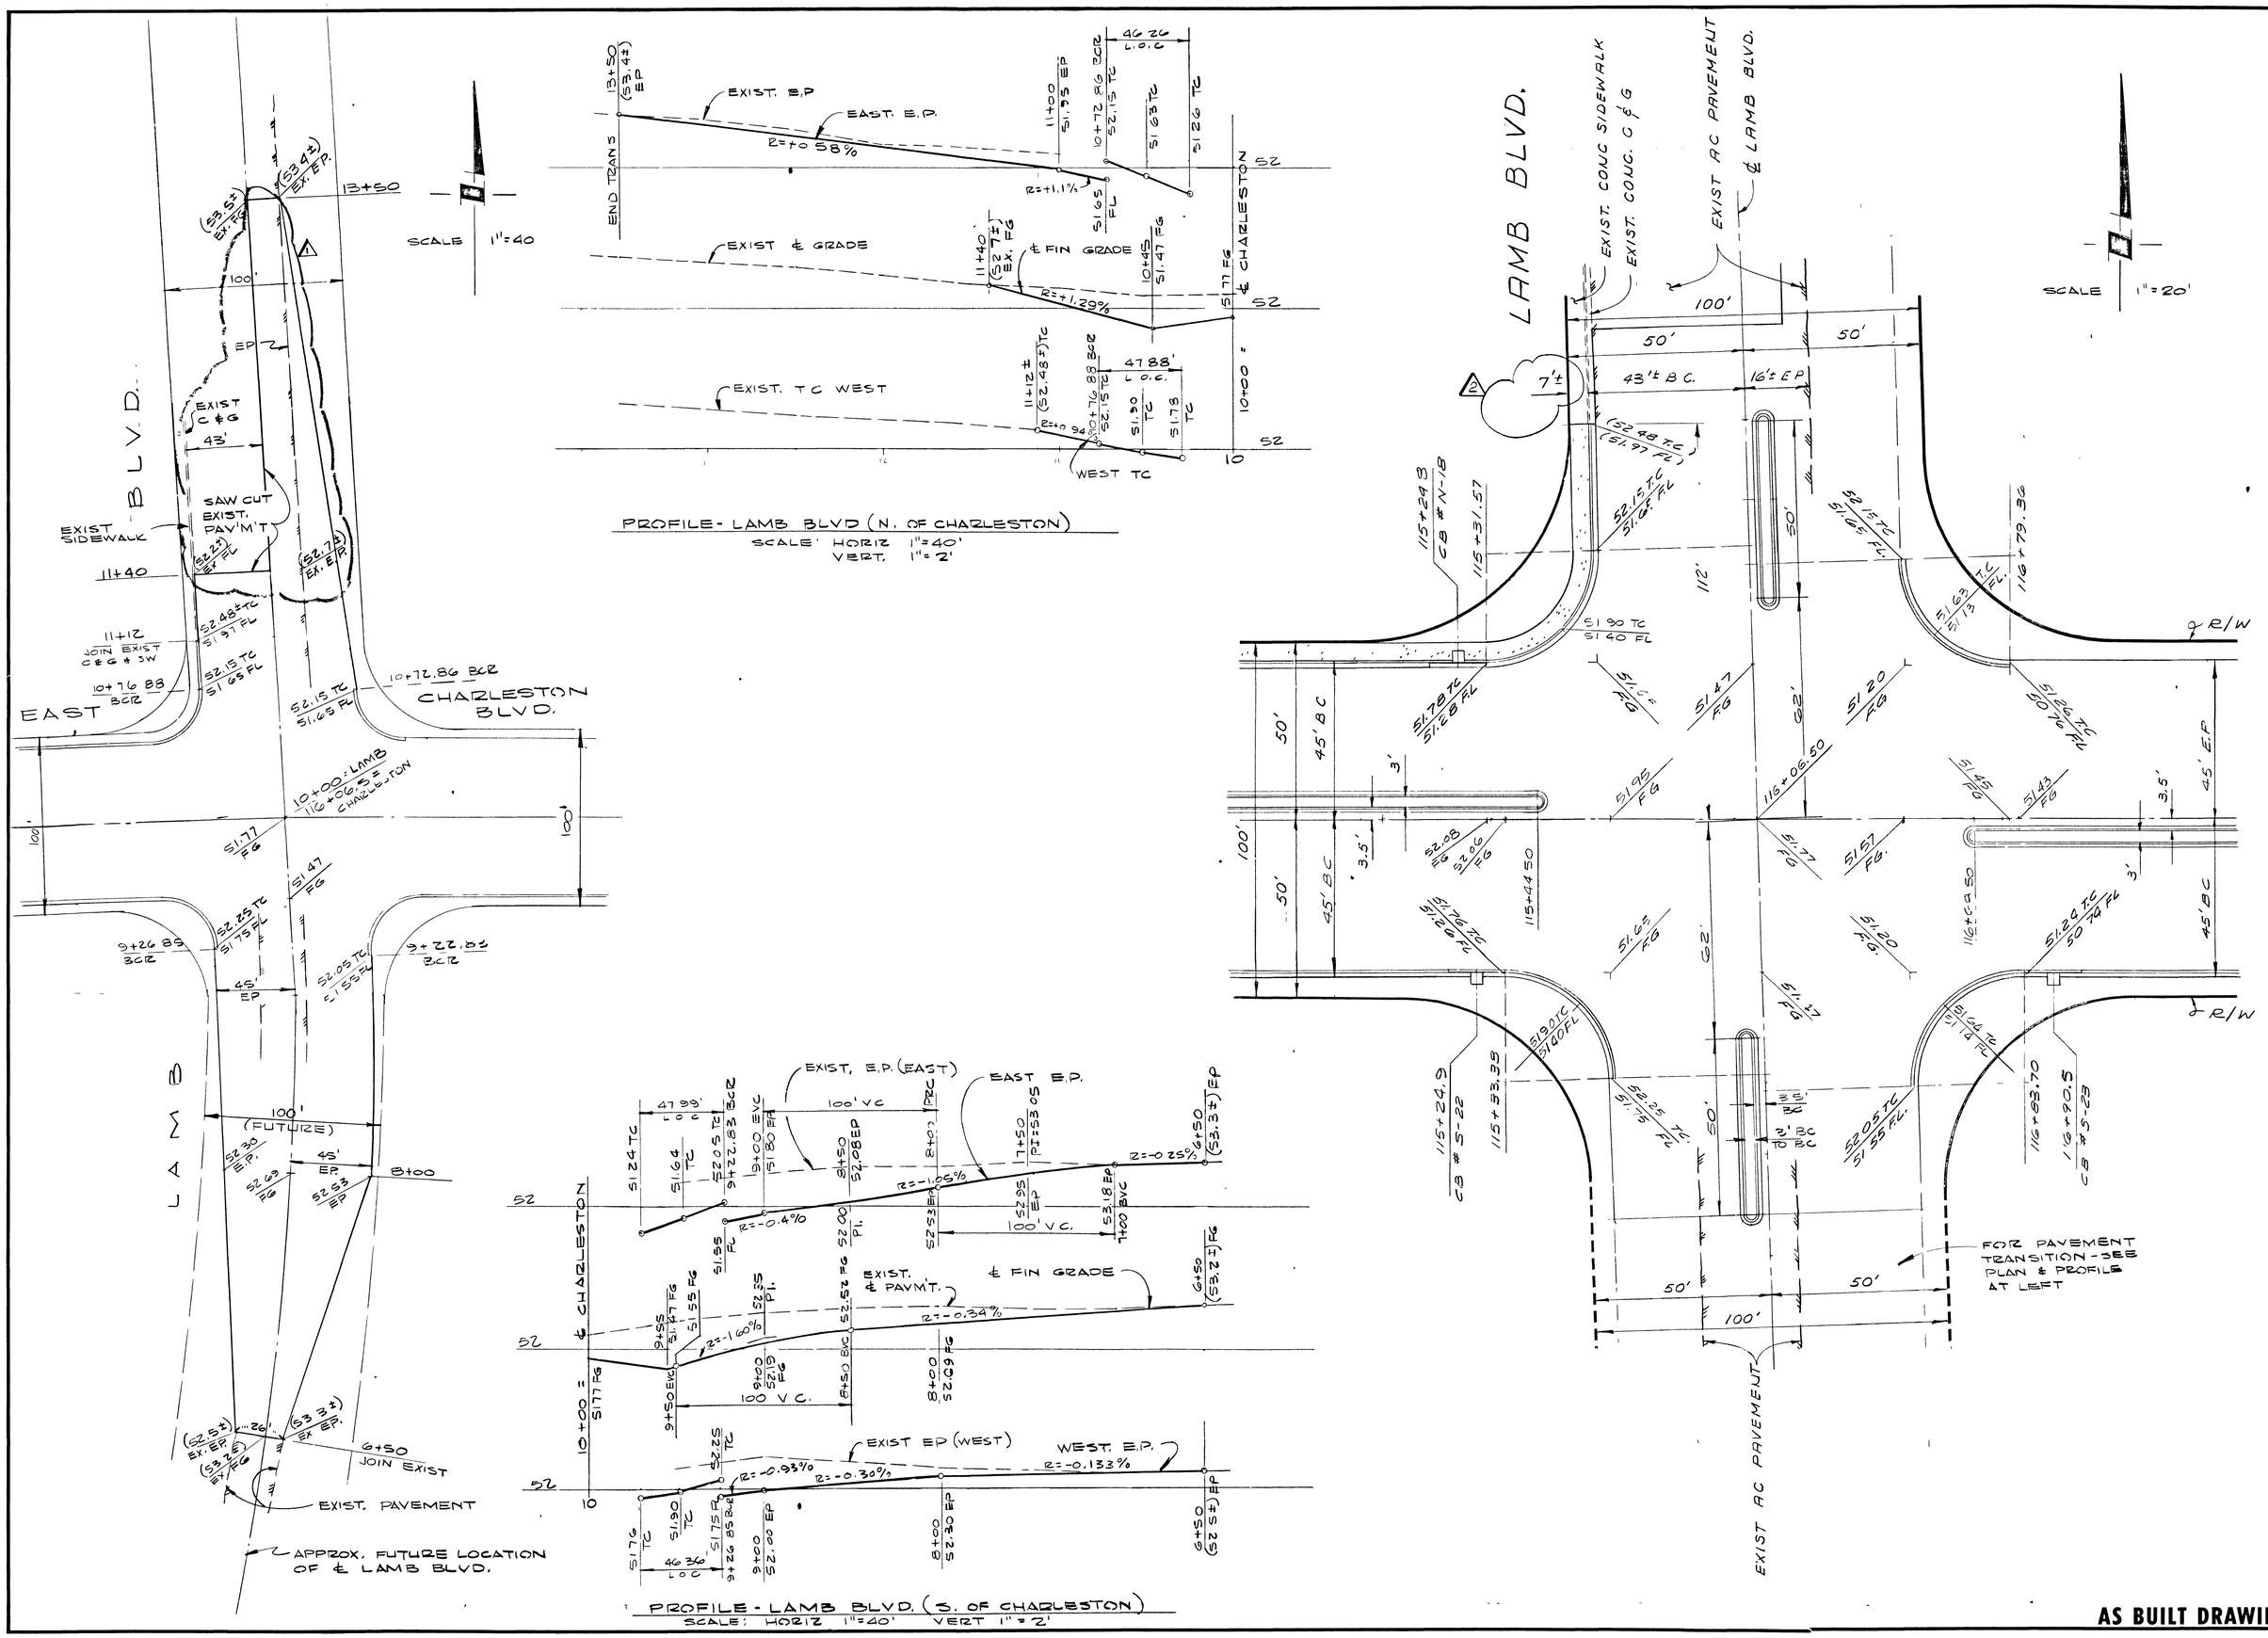

PROFILE - LAMB BLVD (N. OF CHARLESTON)
SCALE: HORIZ 1"=40'
VERT. 1"=2'

PROFILE - LAMB BLVD. (S. OF CHARLESTON)
SCALE: HORIZ 1"=40' VERT 1"=2'

REV	DATE	DESCRIPTION
1	9-5-78	AS BUILT

RECOMMENDED G. C. WALLACE R E NO 13/5 DATE 5/8/77
MONTGOMERY ENGINEERS OF NEVADA R E NO 23/5 DATE 5-2-73

WALLACE - MONTGOMERY, A JOINT VENTURE
G. C. WALLACE, Consulting Engineer 735-5709
MONTGOMERY ENGINEERS OF NEVADA 735-7198
LAS VEGAS, NEVADA

REGIONAL STREET AND HIGHWAY COMMISSION, CLARK CO., NEV
EAST CHARLESTON BLVD FROM FREMONT ST TO NELLIS BLVD

STREET INTERSECTION
LAMB BOULEVARD

SHEET 20 OF 53 SHEETS

AS BUILT DRAWING

22-4-136 107-V943