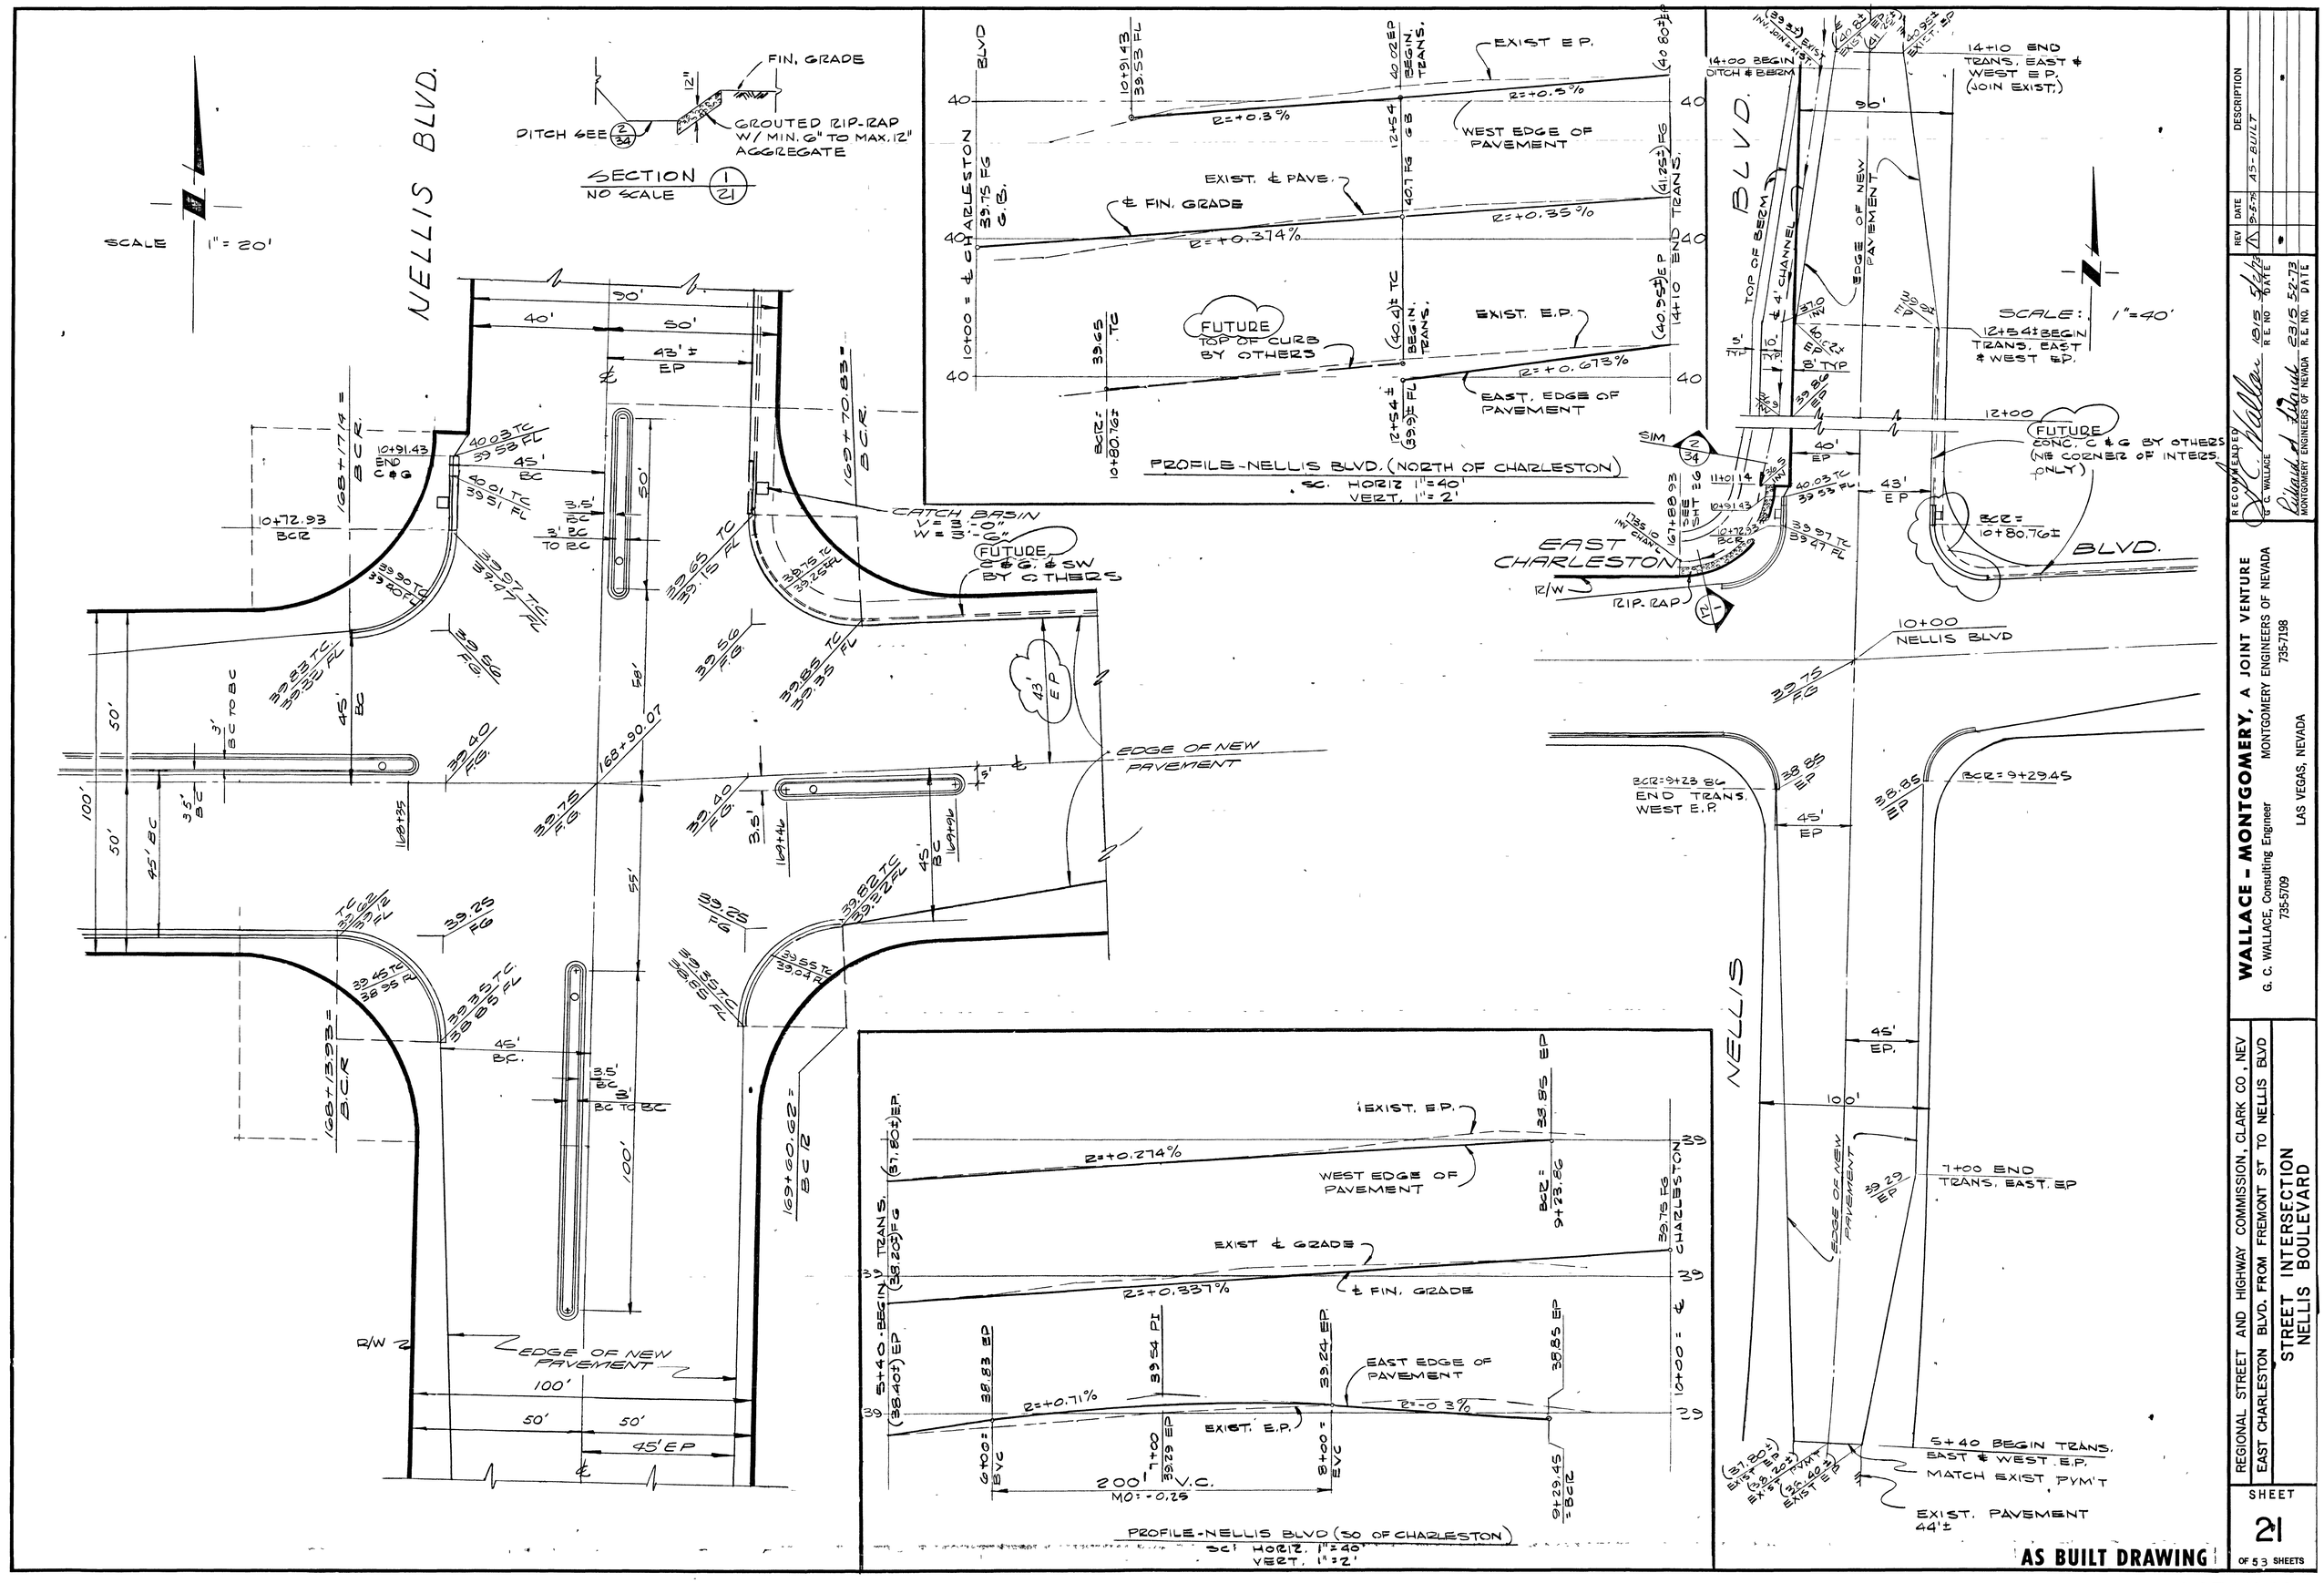

REV	DATE	DESCRIPTION
1	9-5-73	AS-BUILT

RECOMMENDED: G. C. WALLACE R.E. NO. 8115 DATE 5-6-73

APPROVED: MONTGOMERY ENGINEERS OF NEVADA R.E. NO. 2315 DATE 5-2-73

WALLACE - MONTGOMERY, A JOINT VENTURE
G. C. WALLACE, Consulting Engineer — MONTGOMERY ENGINEERS OF NEVADA
735-5709 — 735-7198
LAS VEGAS, NEVADA

REGIONAL STREET AND HIGHWAY COMMISSION, CLARK CO., NEV
EAST CHARLESTON BLVD. FROM FREMONT ST TO NELLIS BLVD

STREET INTERSECTION NELLIS BOULEVARD

SHEET 21 OF 53 SHEETS

22-4-137 107-V943