


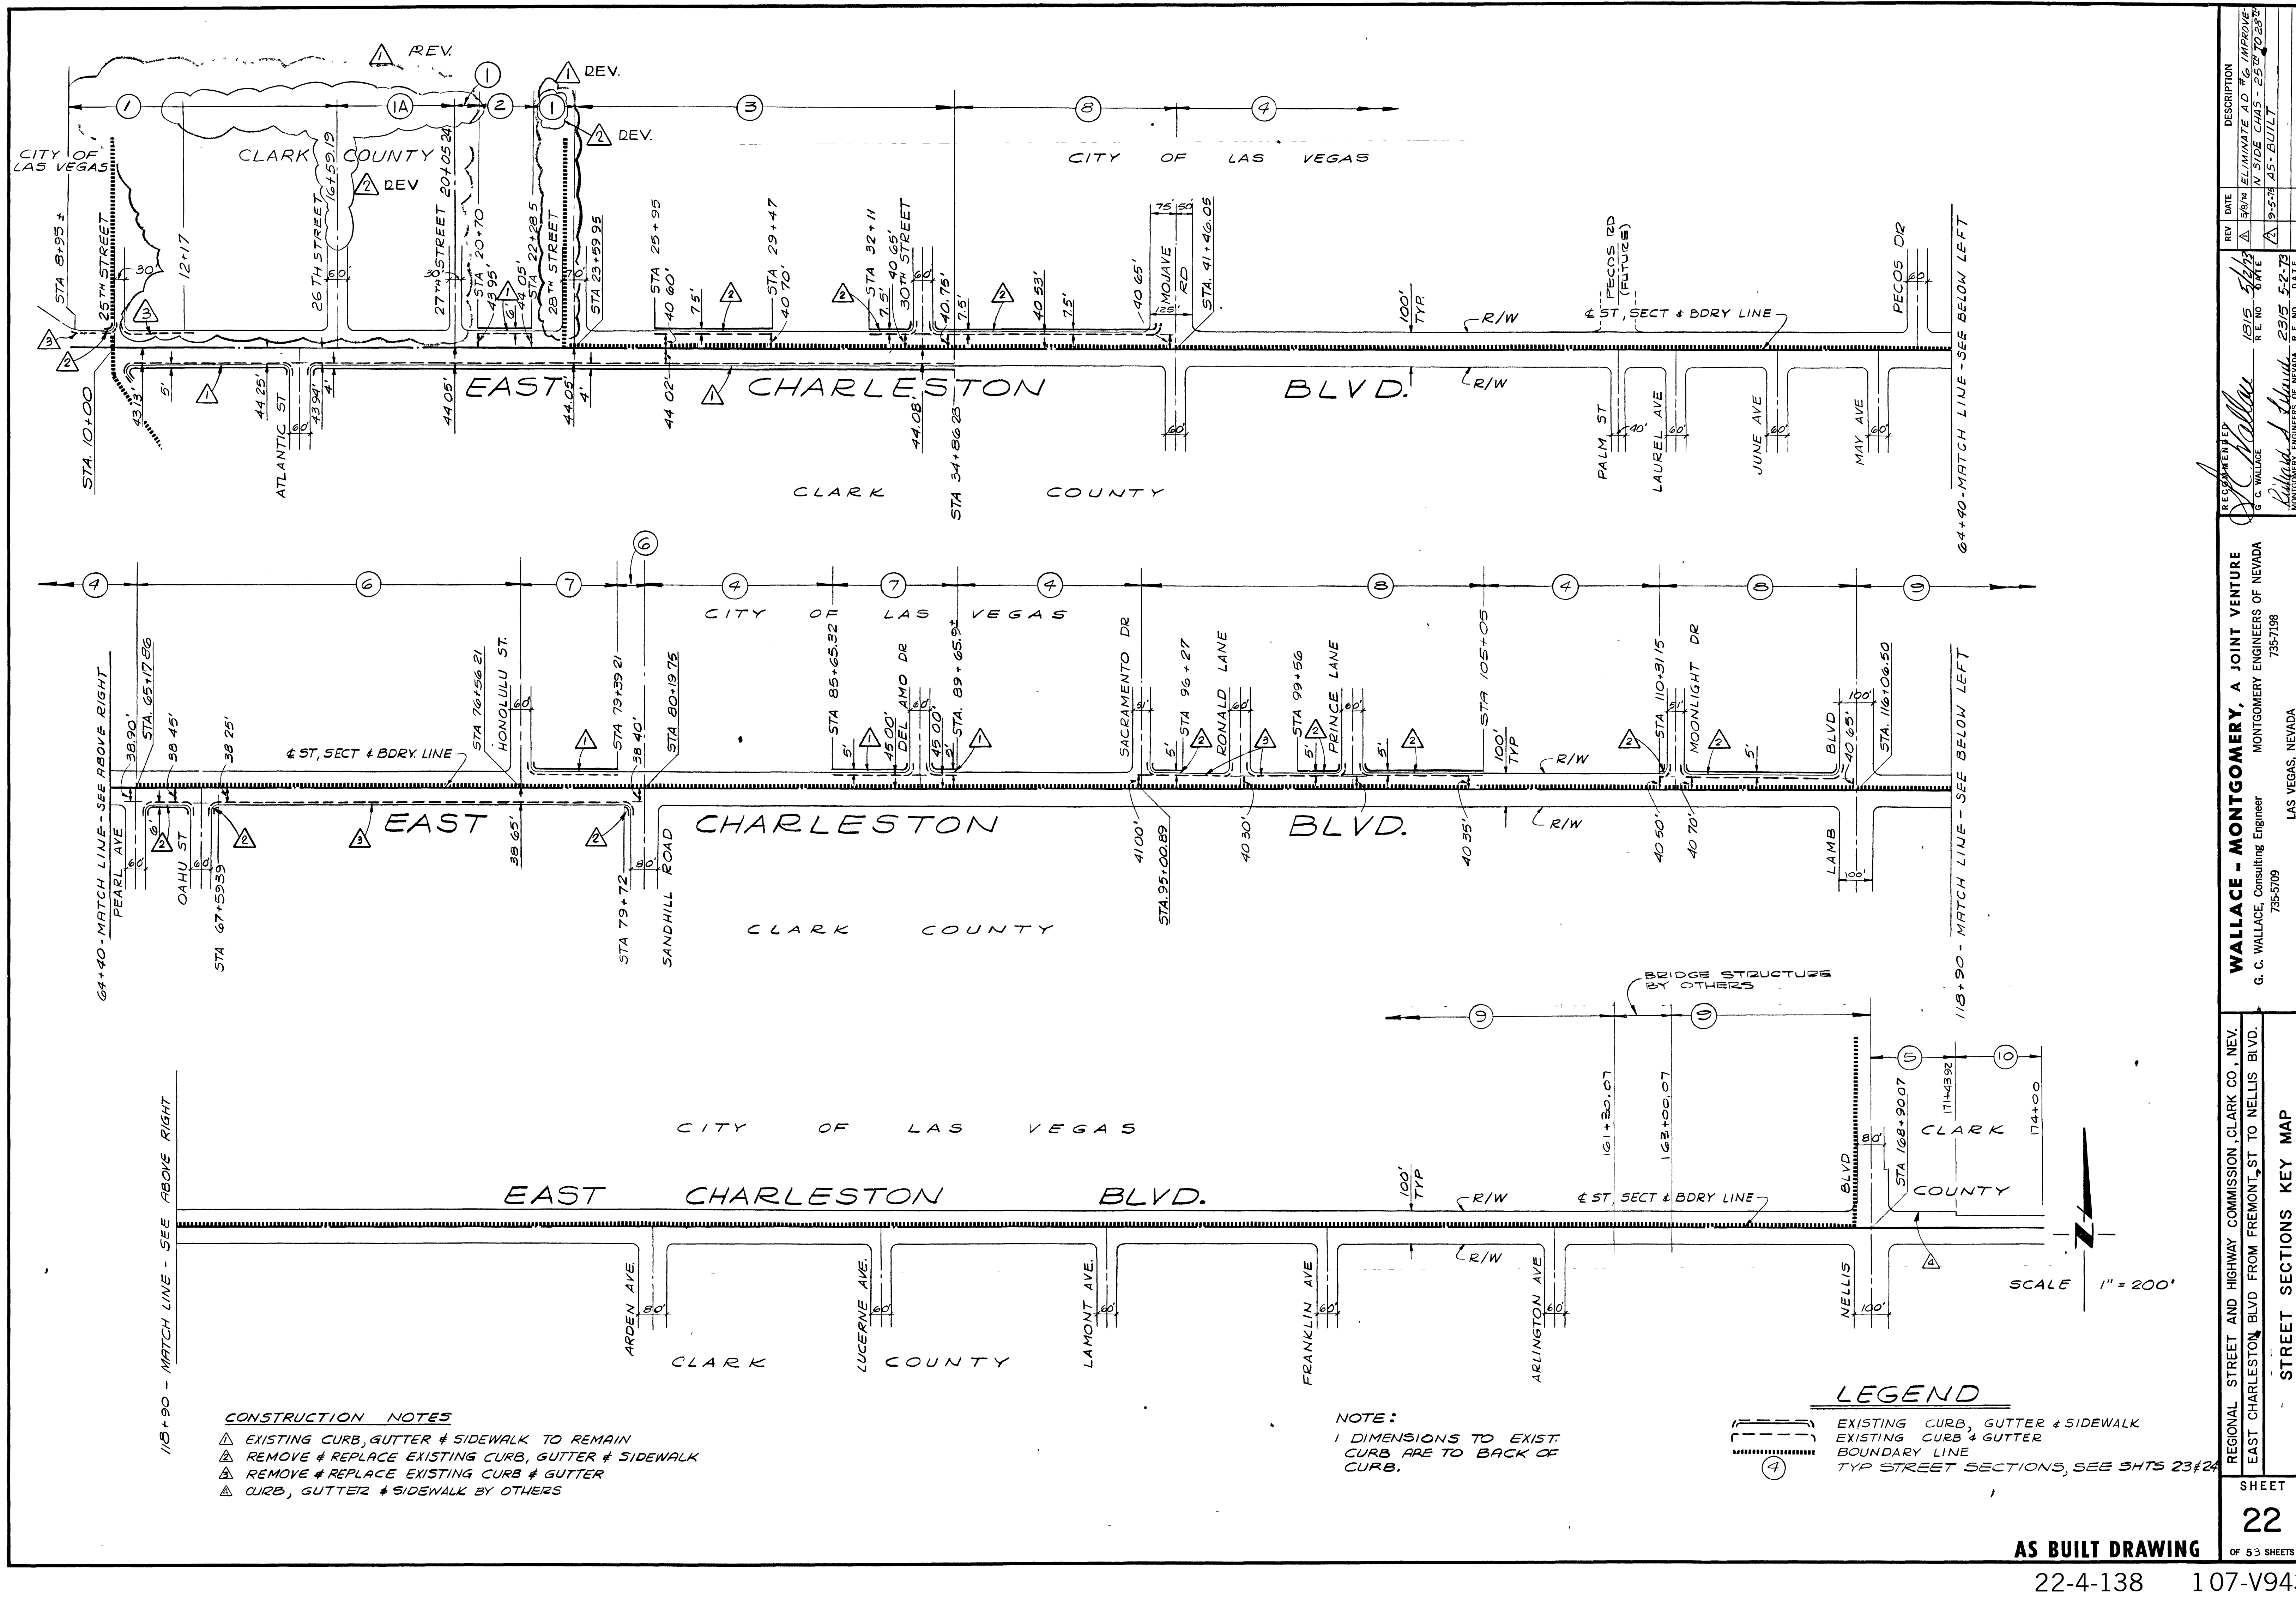

- CONSTRUCTION NOTES**
- △ EXISTING CURB, GUTTER & SIDEWALK TO REMAIN
 - △ REMOVE & REPLACE EXISTING CURB, GUTTER & SIDEWALK
 - △ REMOVE & REPLACE EXISTING CURB & GUTTER
 - △ CURB, GUTTER & SIDEWALK BY OTHERS

NOTE:
1. DIMENSIONS TO EXIST. CURB ARE TO BACK OF CURB.

- LEGEND**
- △ EXISTING CURB, GUTTER & SIDEWALK
 - △ EXISTING CURB & GUTTER
 - △ BOUNDARY LINE
 - △ TYP STREET SECTIONS, SEE SHTS 23 & 24

SCALE 1" = 200'

REV	DATE	DESCRIPTION



SHEET	22
OF 53 SHEETS	