


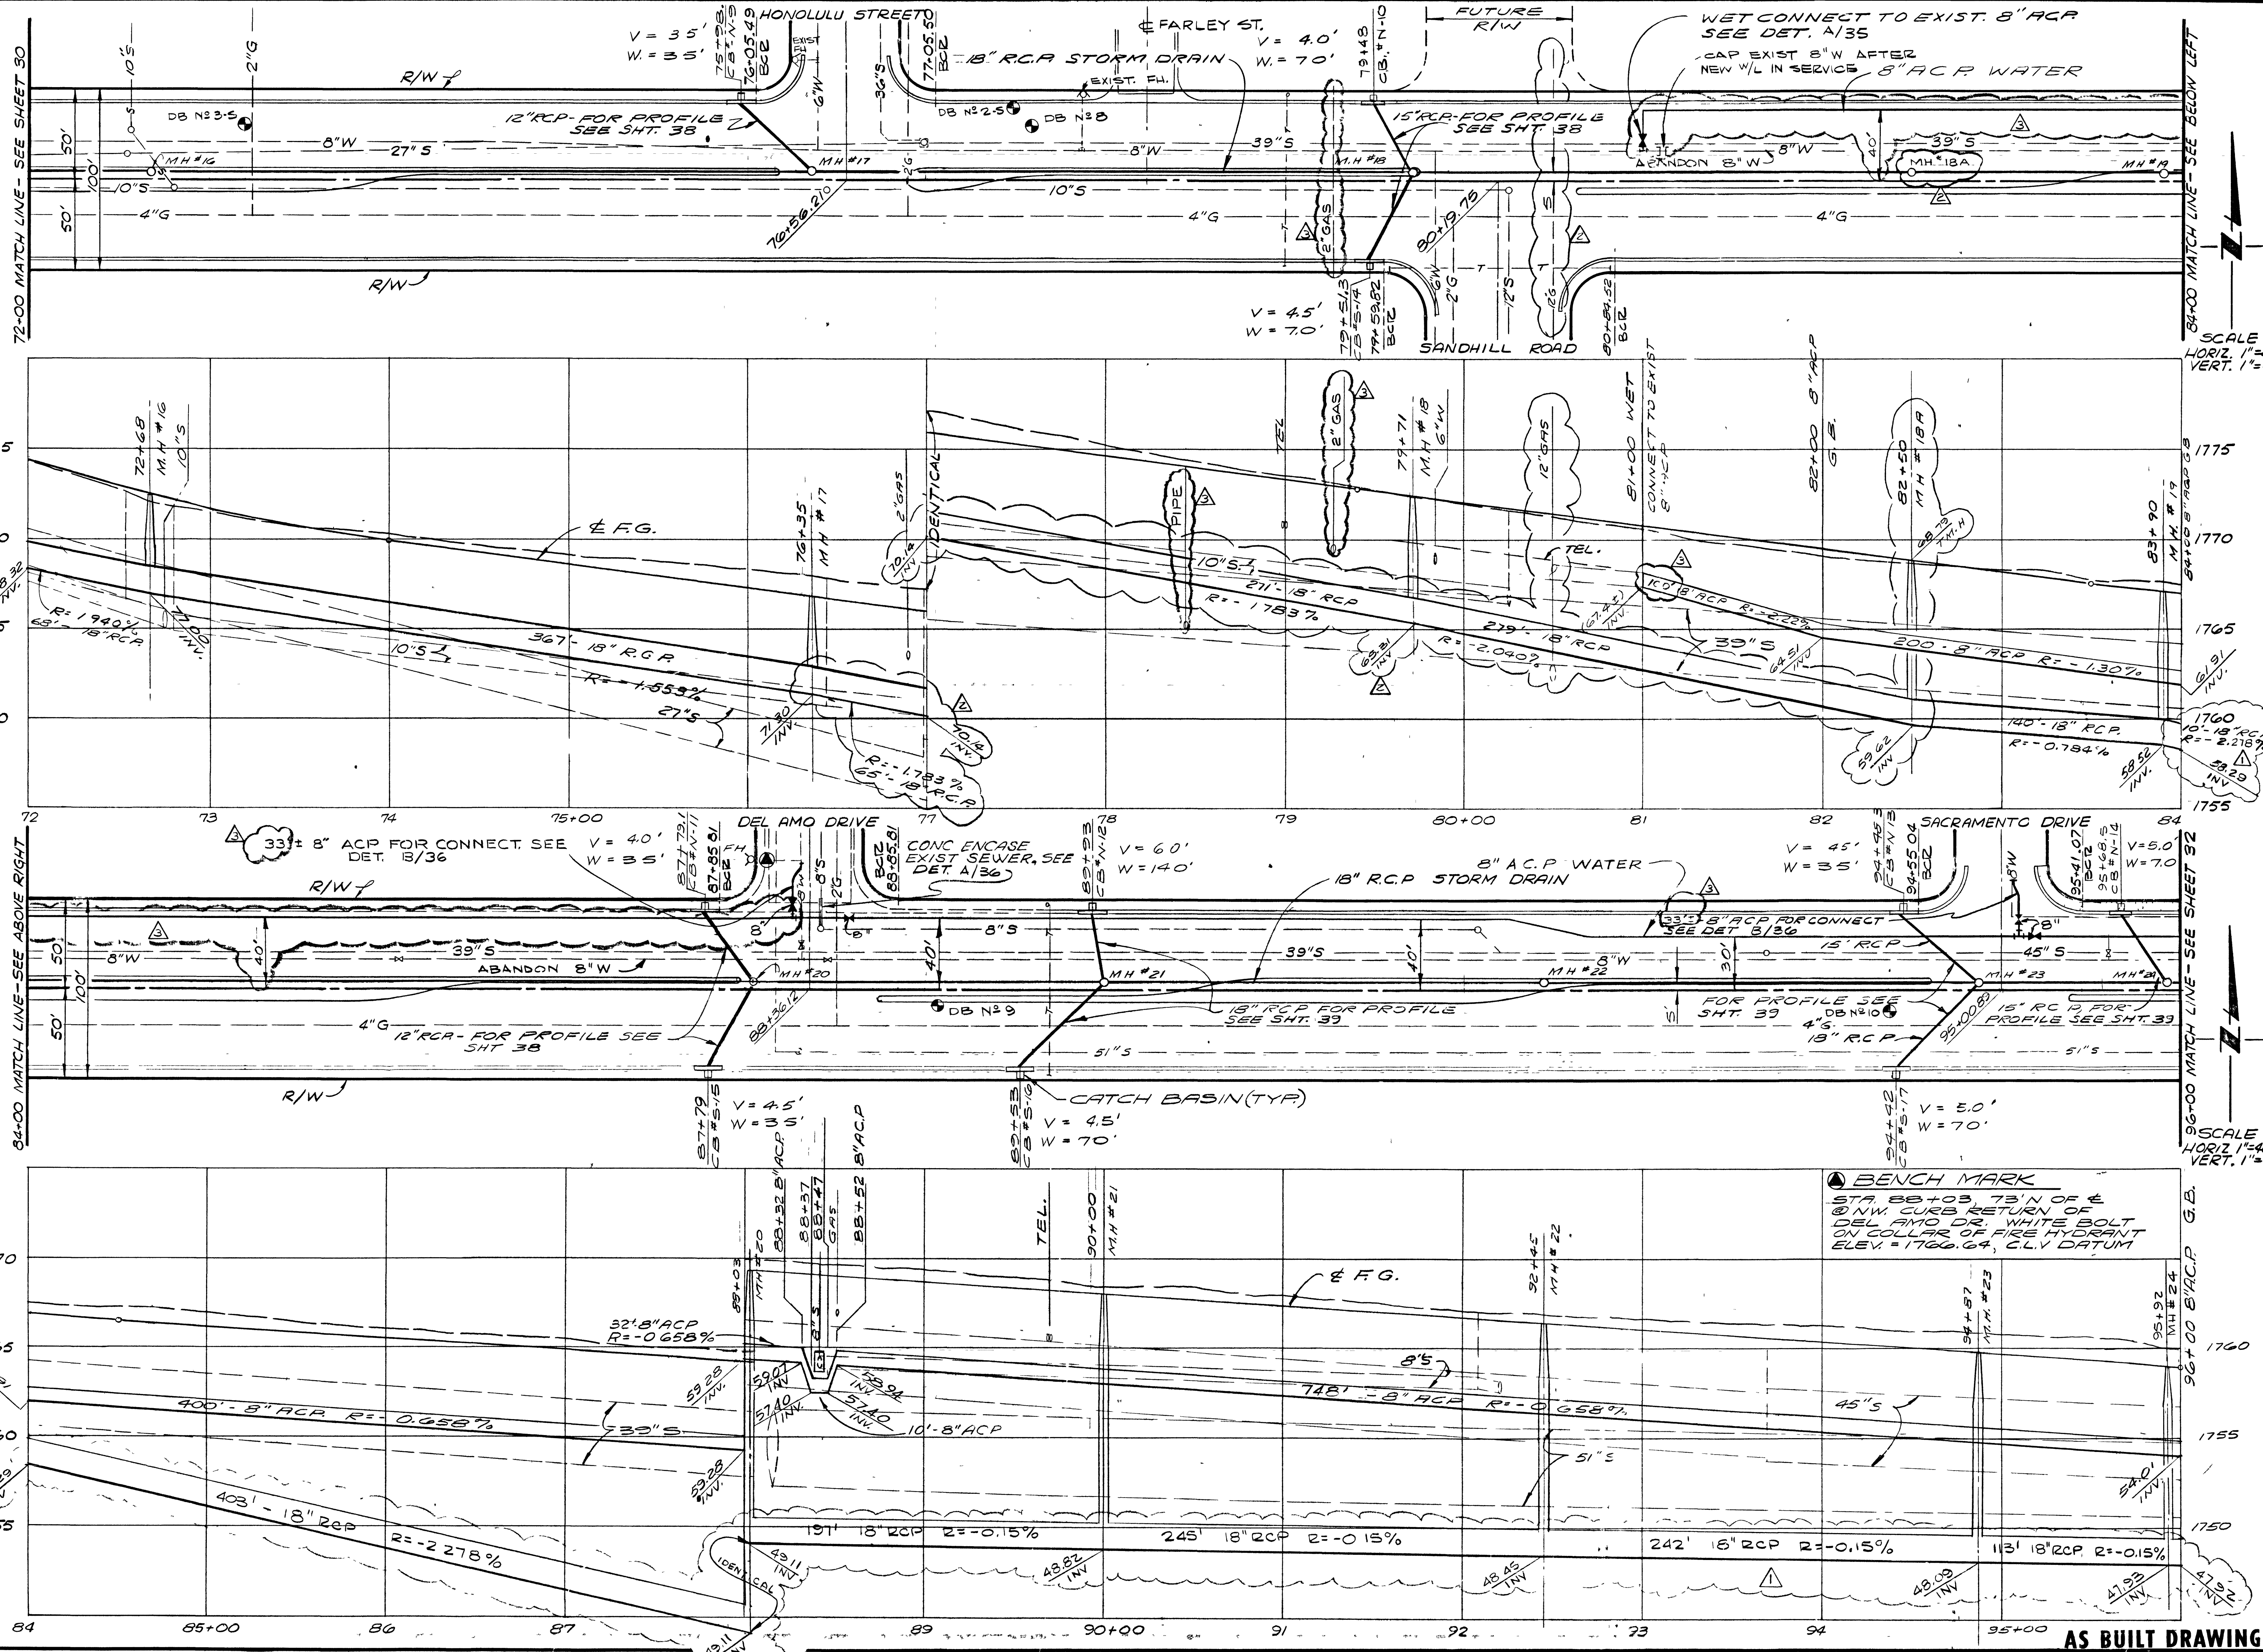

| REV | DATE    | DESCRIPTION          |
|-----|---------|----------------------|
| 1   | 1/15/13 | REV. 18" STORM DRAIN |
| 2   | 1/15/13 | REV. 18" STORM DRAIN |
