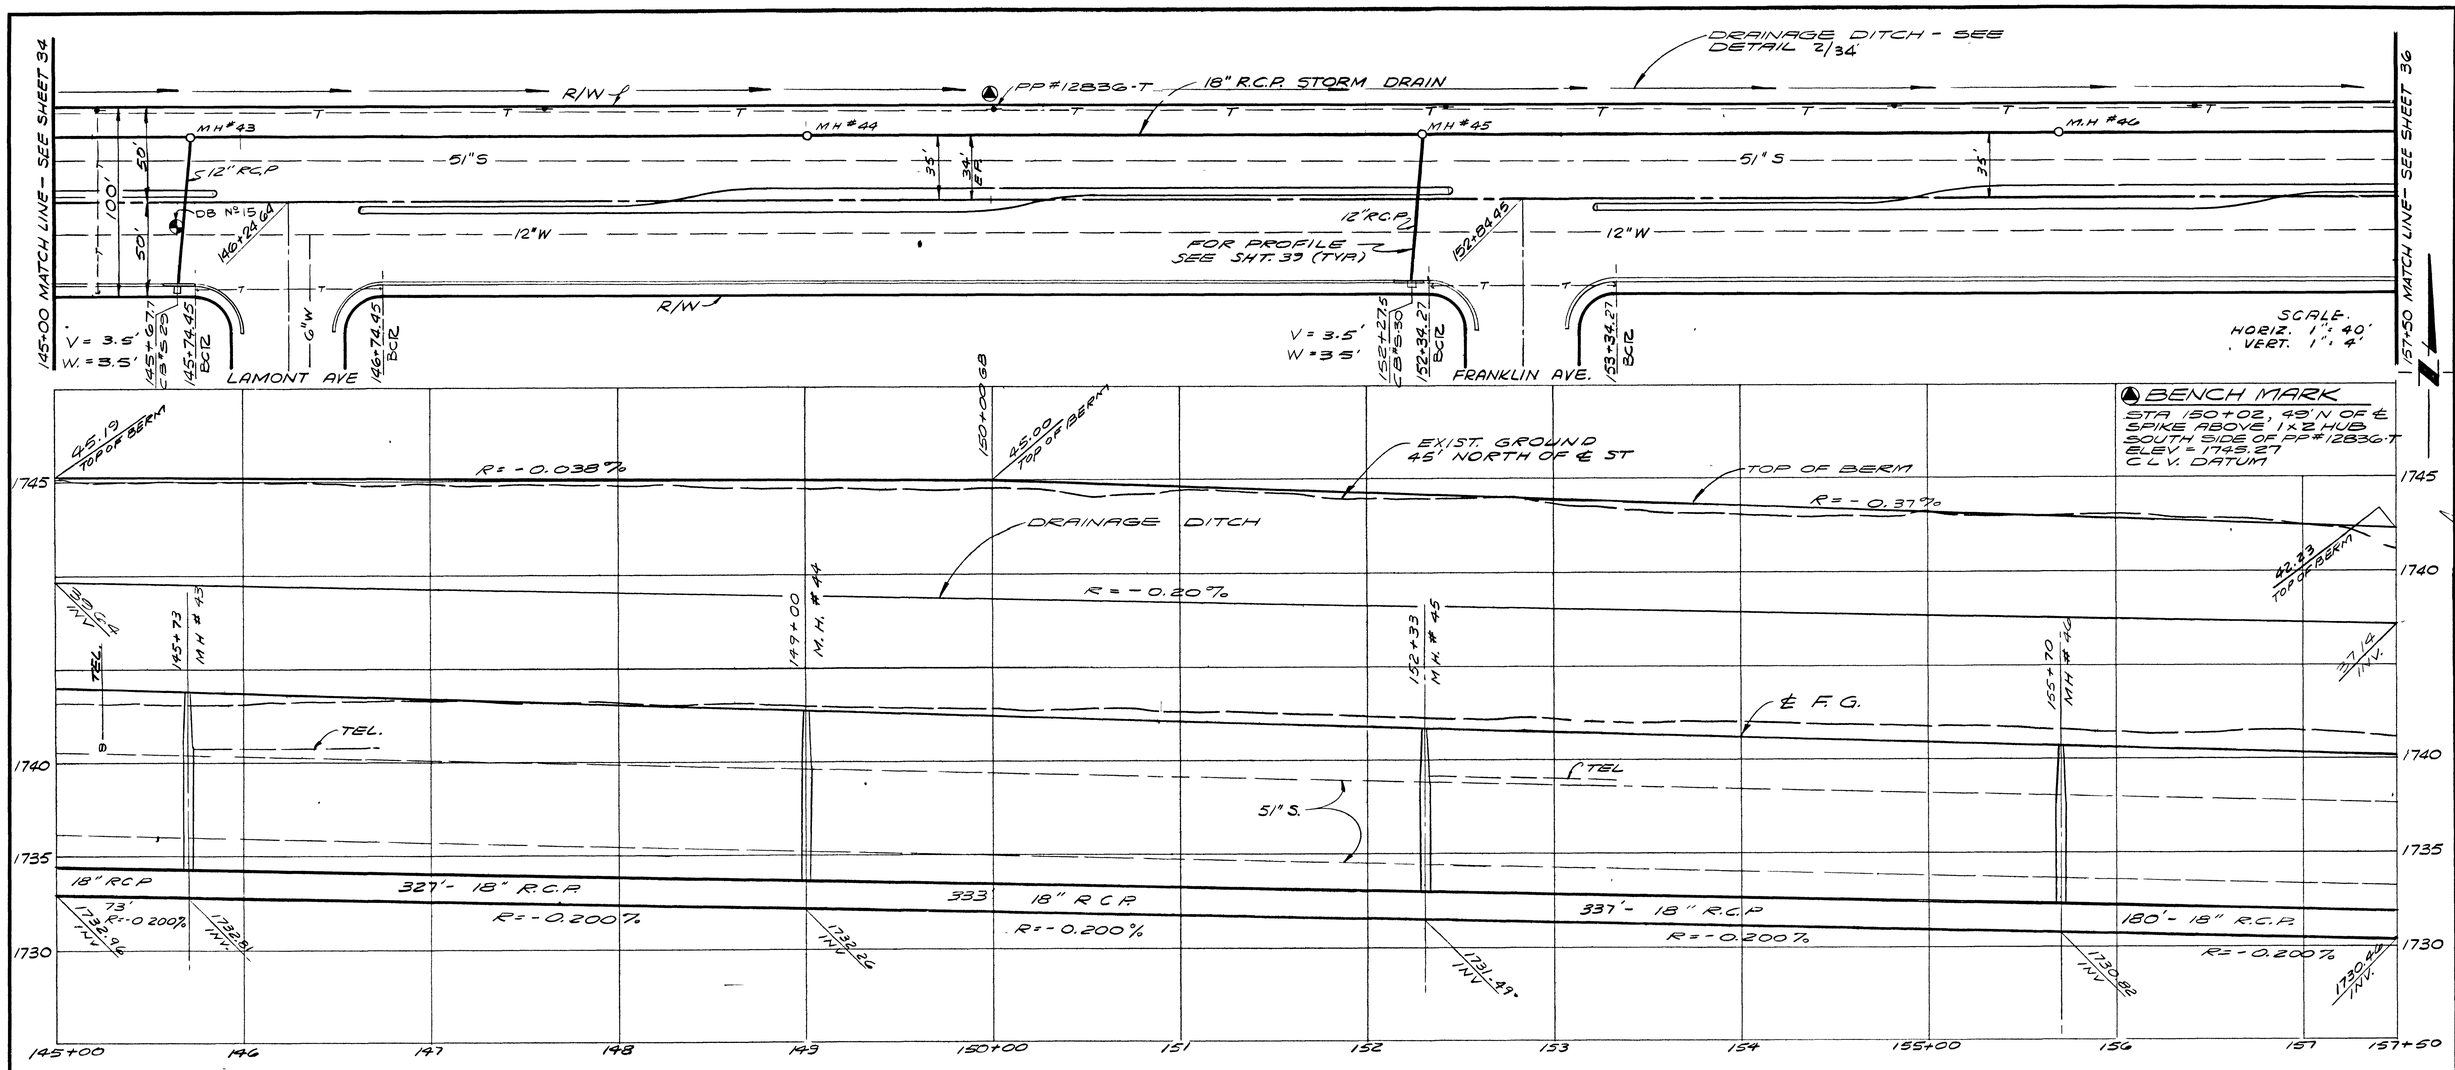

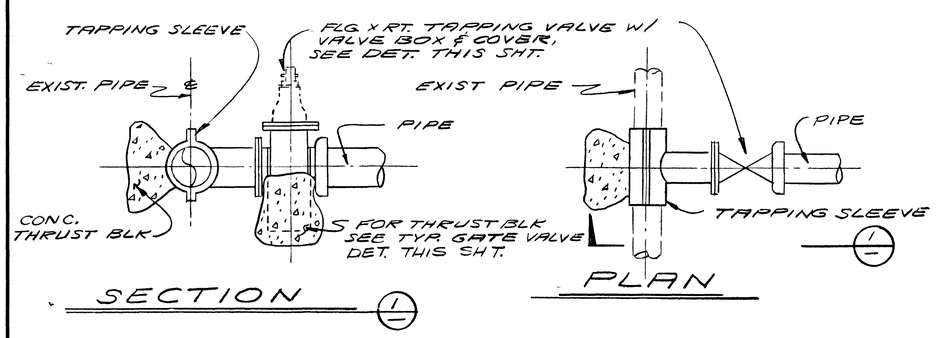

TYPICAL WET CONNECTION DET. (A/35)

NO SCALE

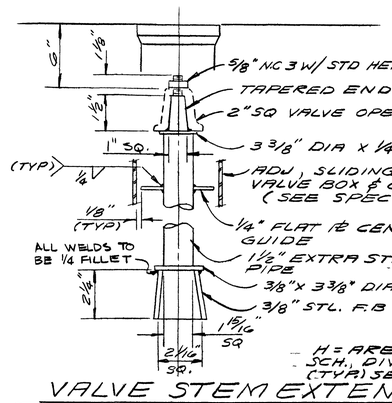

VALVE STEM EXTENSION DET.

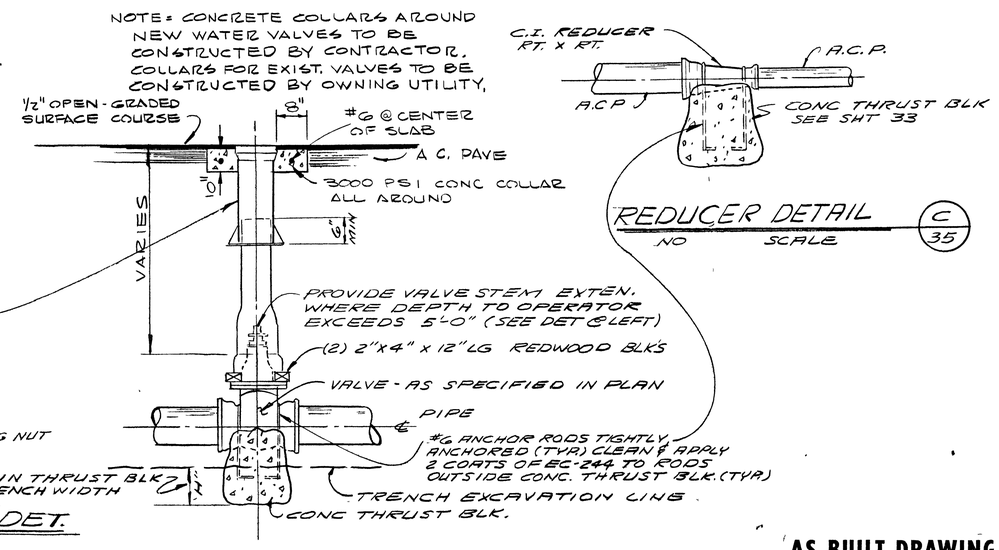

REDUCER DETAIL (C/35)

NO SCALE

TYPICAL GATE VALVE, BOX AND COVER DETAIL (B/35)

NO SCALE

REV	DATE	DESCRIPTION
1	9-5-75	AS-BUILT

RECOMMENDED: G. C. WALLACE — R.E. NO 1815 — DATE 5/2/73

MONTGOMERY ENGINEERS OF NEVADA — R.E. NO 2315 — DATE 5-21-73

WALLACE - MONTGOMERY, A JOINT VENTURE
MONTGOMERY ENGINEERS OF NEVADA
G. C. WALLACE, Consulting Engineer 735-7198
735-5709
LAS VEGAS, NEVADA

REGIONAL STREET AND HIGHWAY COMMISSION, CLARK CO., NEV
EAST CHARLESTON BLVD FROM FREMONT ST. TO NELLIS BLVD.

STORM DRAIN PLAN AND PROFILE
145+00 TO 157+50, AND DETAILS

AS BUILT DRAWING

SHEET 35 OF 53 SHEETS

107-V943 22-4-151