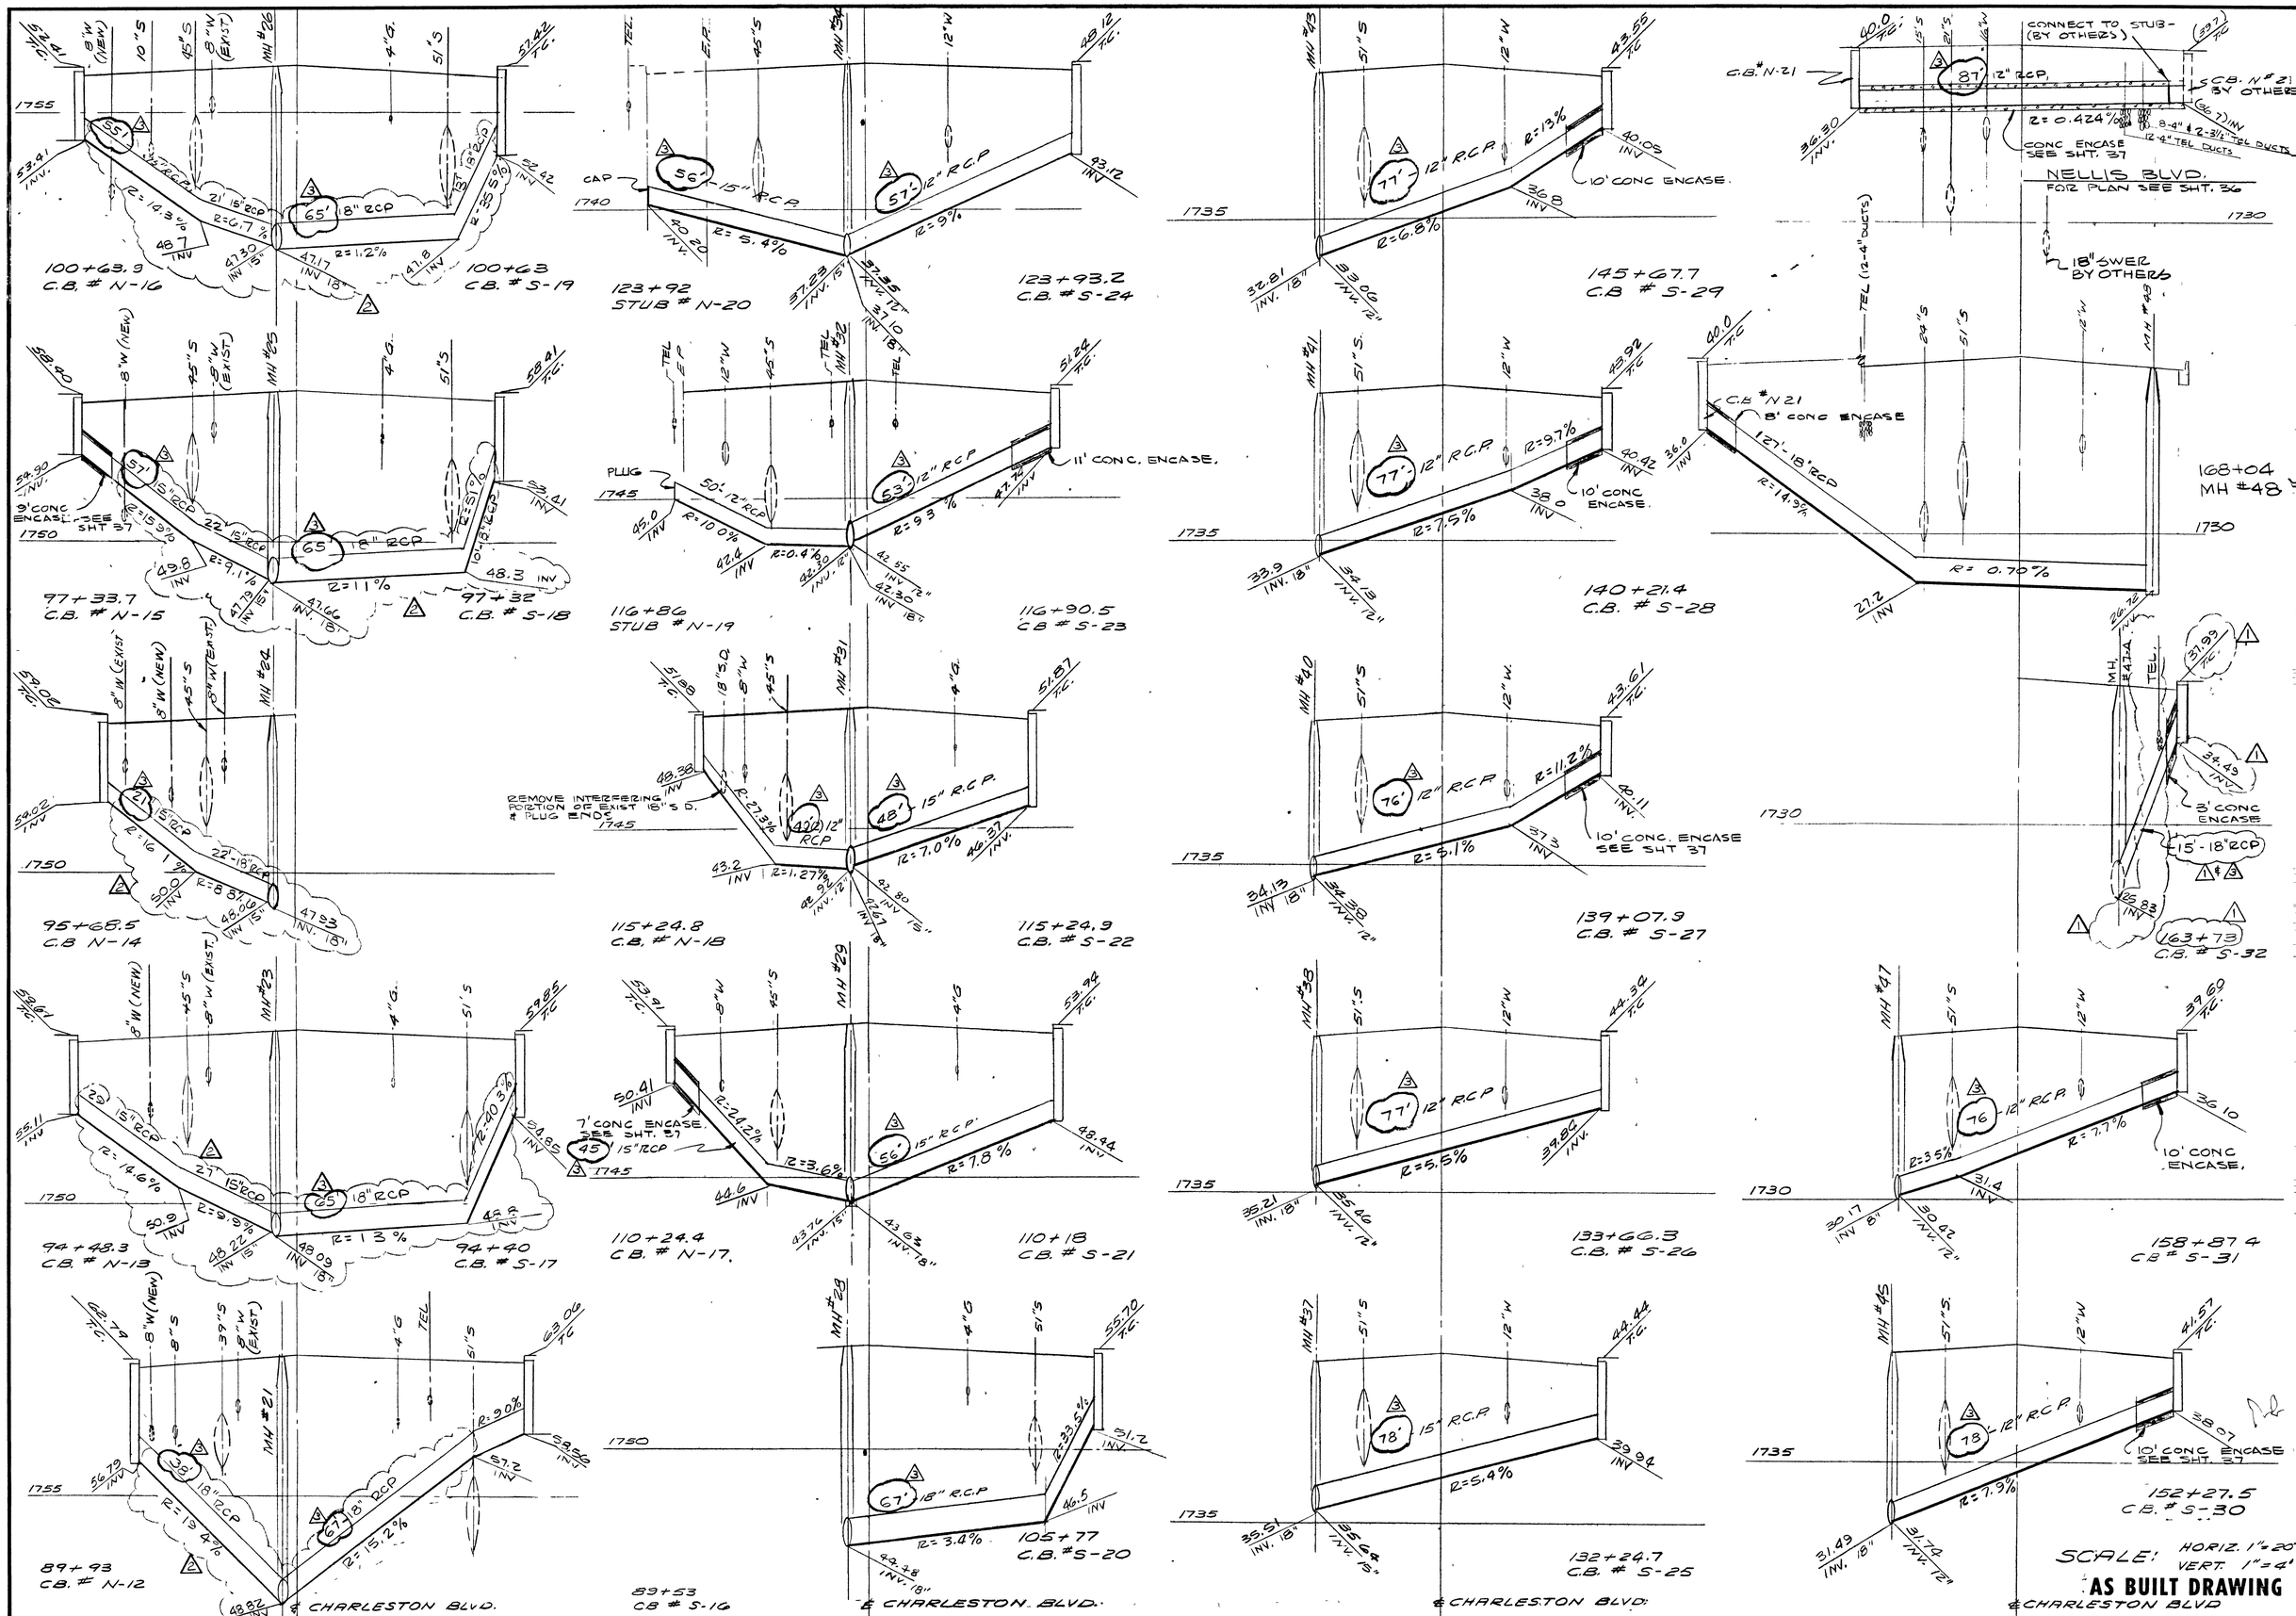

REV	DATE	DESCRIPTION
1	8-16-72	2 EA C.B. S-32
2	11-9-72	2 EA C.B. S-19; C.B. S-18, C.B. N-14; C.B. S-17, C.B. N-12 PIPES
3	9-5-73	AS-BUILT

RECOMMENDED G. C. WALLACE DATE 8/15/72
MONTGOMERY ENGINEERS OF NEVADA R.E. NO. 2315 DATE 5-2-73

WALLACE - MONTGOMERY, A JOINT VENTURE
G. C. WALLACE, Consulting Engineer MONTGOMERY ENGINEERS OF NEVADA
735-7198 735-5709
LAS VEGAS, NEVADA

REGIONAL STREET AND HIGHWAY COMMISSION, CLARK CO., NEV.
EAST CHAR.-ESTON BLVD. FROM FREMONT ST TO NELLIS BLVD.

STORM DRAIN - CONNECTOR PIPE
DETAILS
II

SHEET 39 OF 53 SHEETS

22-4-155 107-V943