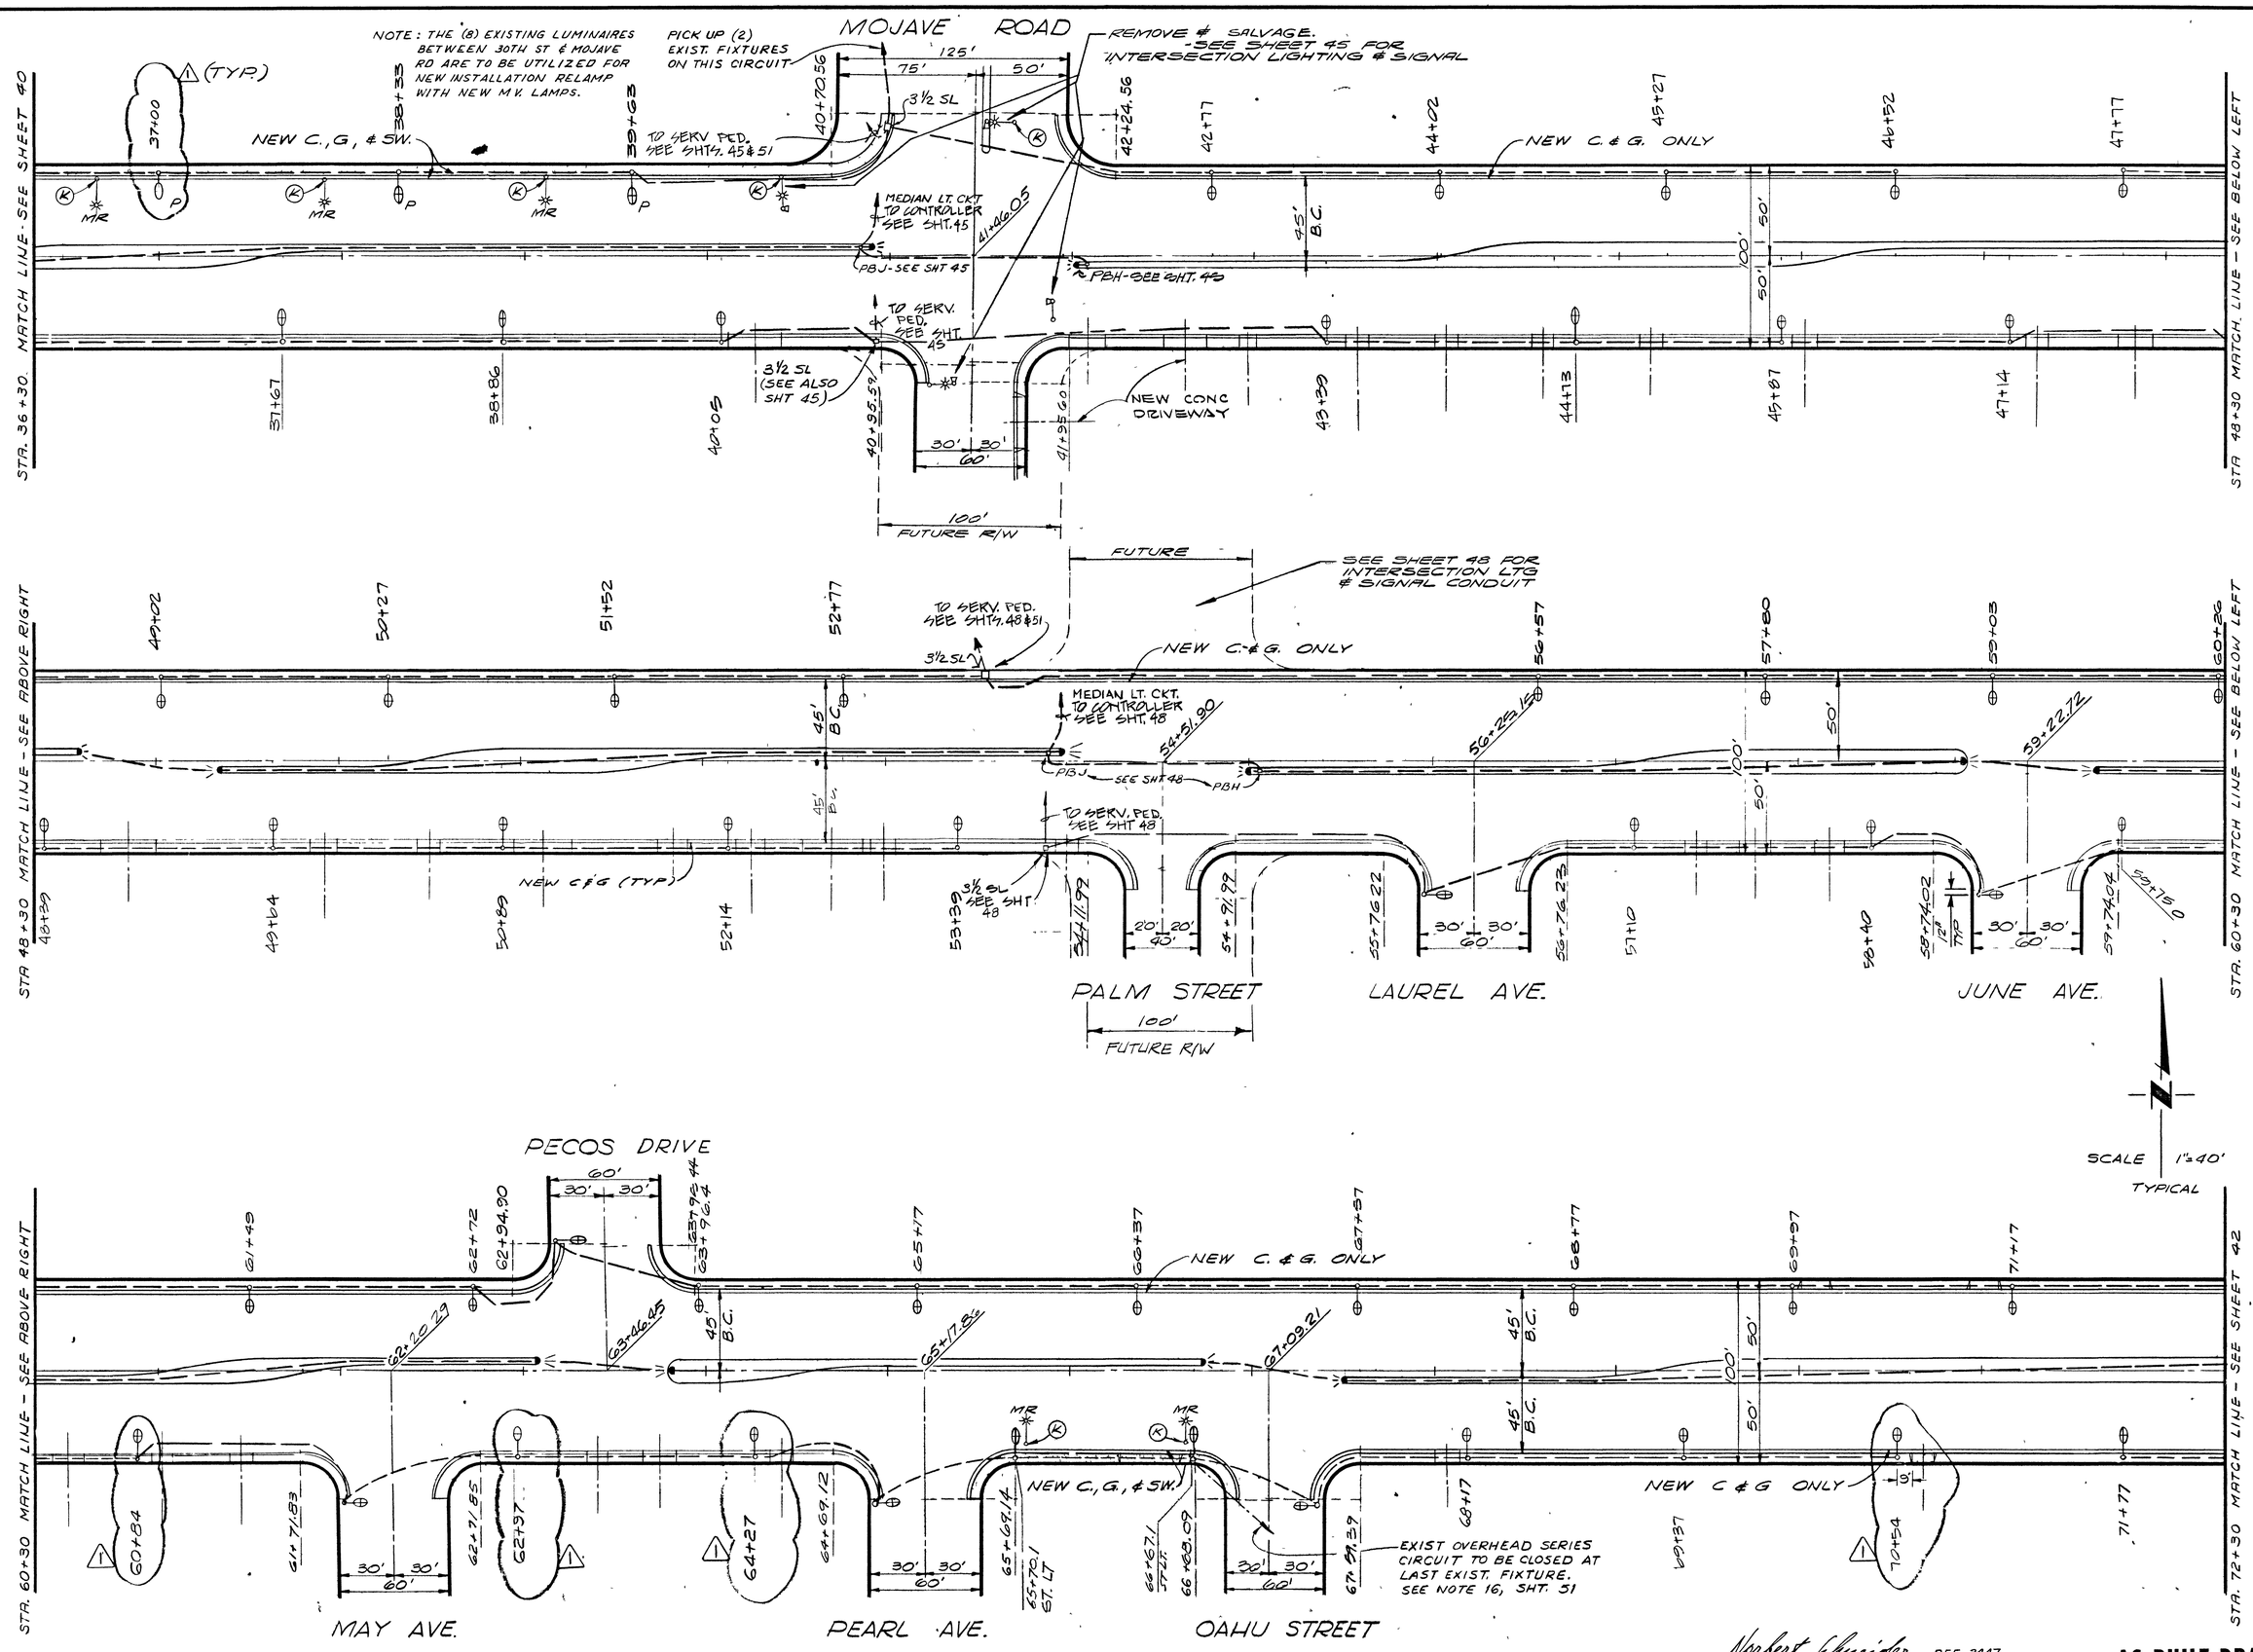

Norbert Schneider REE 3447

AS BUILT DRAWING

REV	DATE	DESCRIPTION
A	7/31/73	DUALT

RECOMMENDED G. C. WALLACE R.E. NO. DATE 18/5 9/4/73

MONTGOMERY ENGINEERS OF NEVADA R.E. NO. DATE 3 E 72

WALLACE - MONTGOMERY, A JOINT VENTURE
G. C. WALLACE, Consulting Engineer
735-5709
MONTGOMERY ENGINEERS OF NEVADA
735-7198
LAS VEGAS, NEVADA

REGIONAL STREET AND HIGHWAY COMMISSION, CLARK CO., NEV.
EAST CHARLESTON BLVD. FROM FREMONT ST. TO NELLIS BLVD.
STREET AND MEDIAN LIGHTING PLAN
36+30 TO 72+30

SHEET 41 OF 53 SHEETS

22-4-1578 107-V943