

APPROXIMATE EXISTING CONTOUR GRADE


FINISH CONTOUR GRADE AT SURFACE

0.00 FINISH SPOT ELEVATION AT SURFACE


0.00TW (SAME) TOP OF WALL

0.00TC (SAME) TOP OF CURB

0.00FL (SAME) FLOW LINE

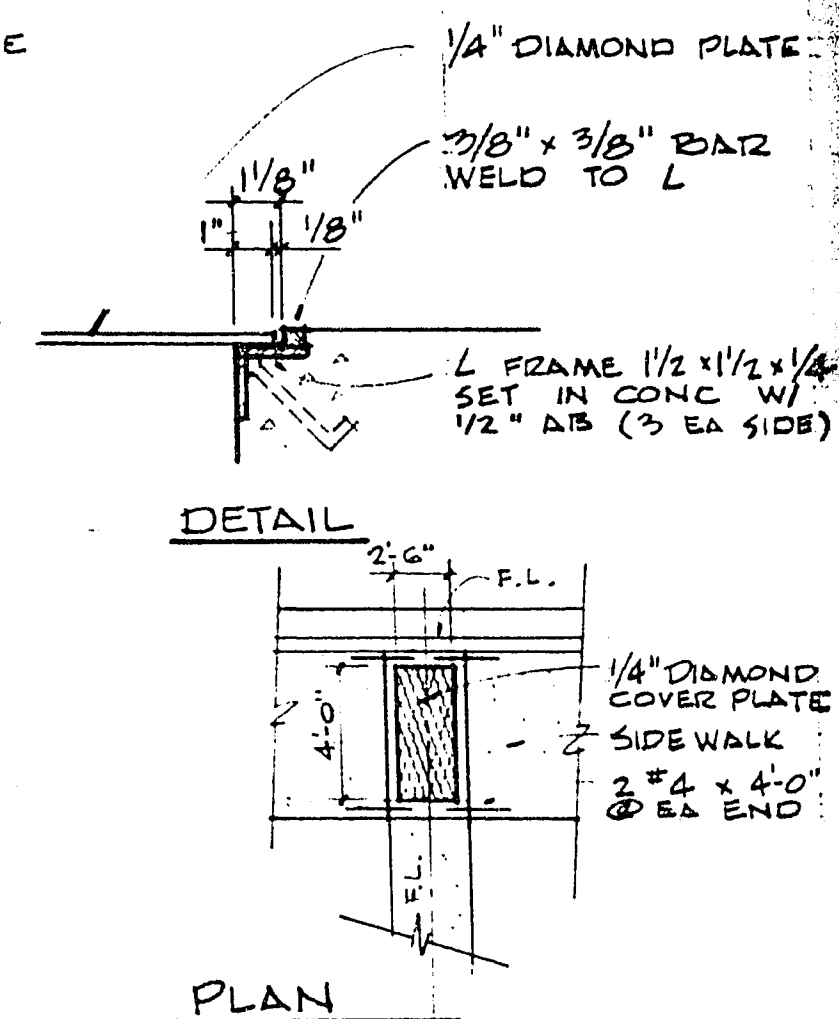

DRAIN UNDER SIDEWALK
SCALE 1" = 1'-0"

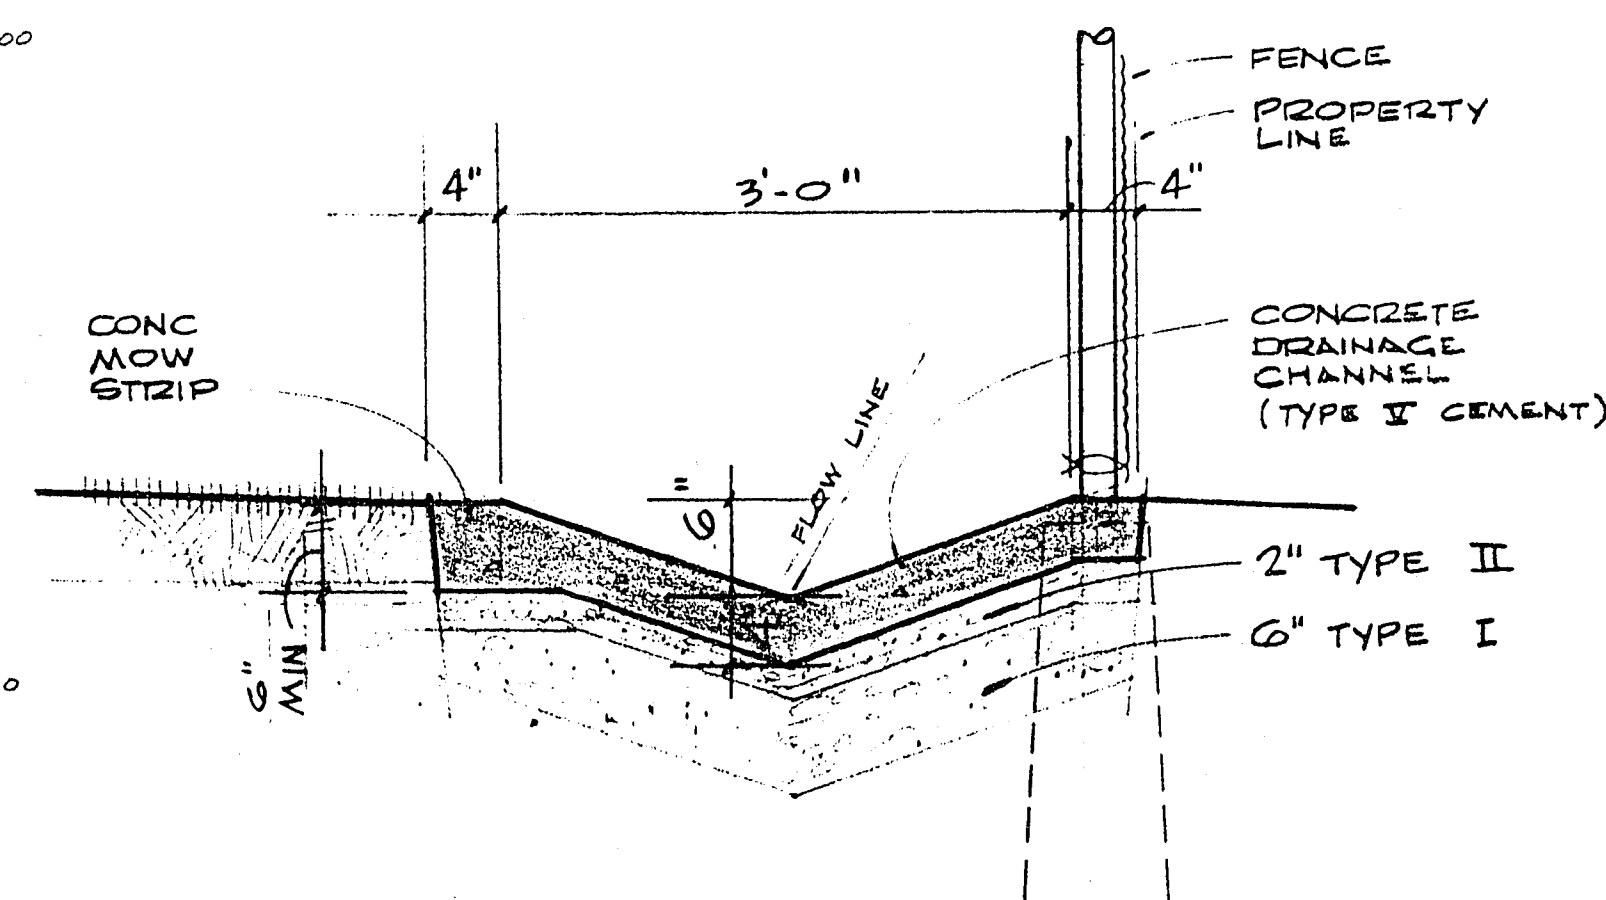

2 SECTION THRU DRAINAGE CHANNEL
SCALE 1" = 1'-0"

1. SEE CIVIL DRAWINGS FOR SIDEWALK WIDTHS
2. FINISH GRADES AS SHOWN IN TURF AREA SHALL BE TOP OF PLANTING SOIL.

Lawrence Hampton
CITY ENGINEER

C. D. Peterson
FIELD ENGINEER

7/14/76
DATE

7/15/76
DATE

② JULY 12, 76 DELETED CHILD SAC & ADDED WOOD BARRIER.
① JULY 12, 76 ADDED DRAINAGE ALONG EAST PROP LINE.

SITE GRADING PLAN

SCALE 1" = 40'