

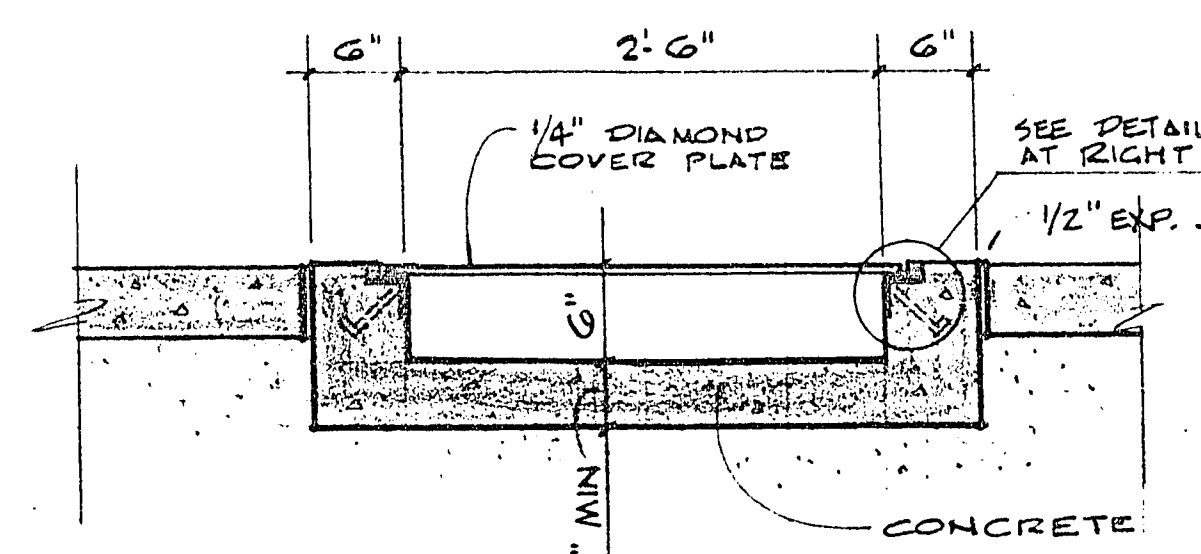
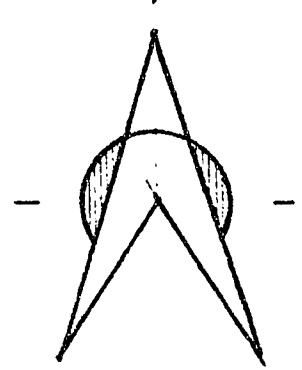
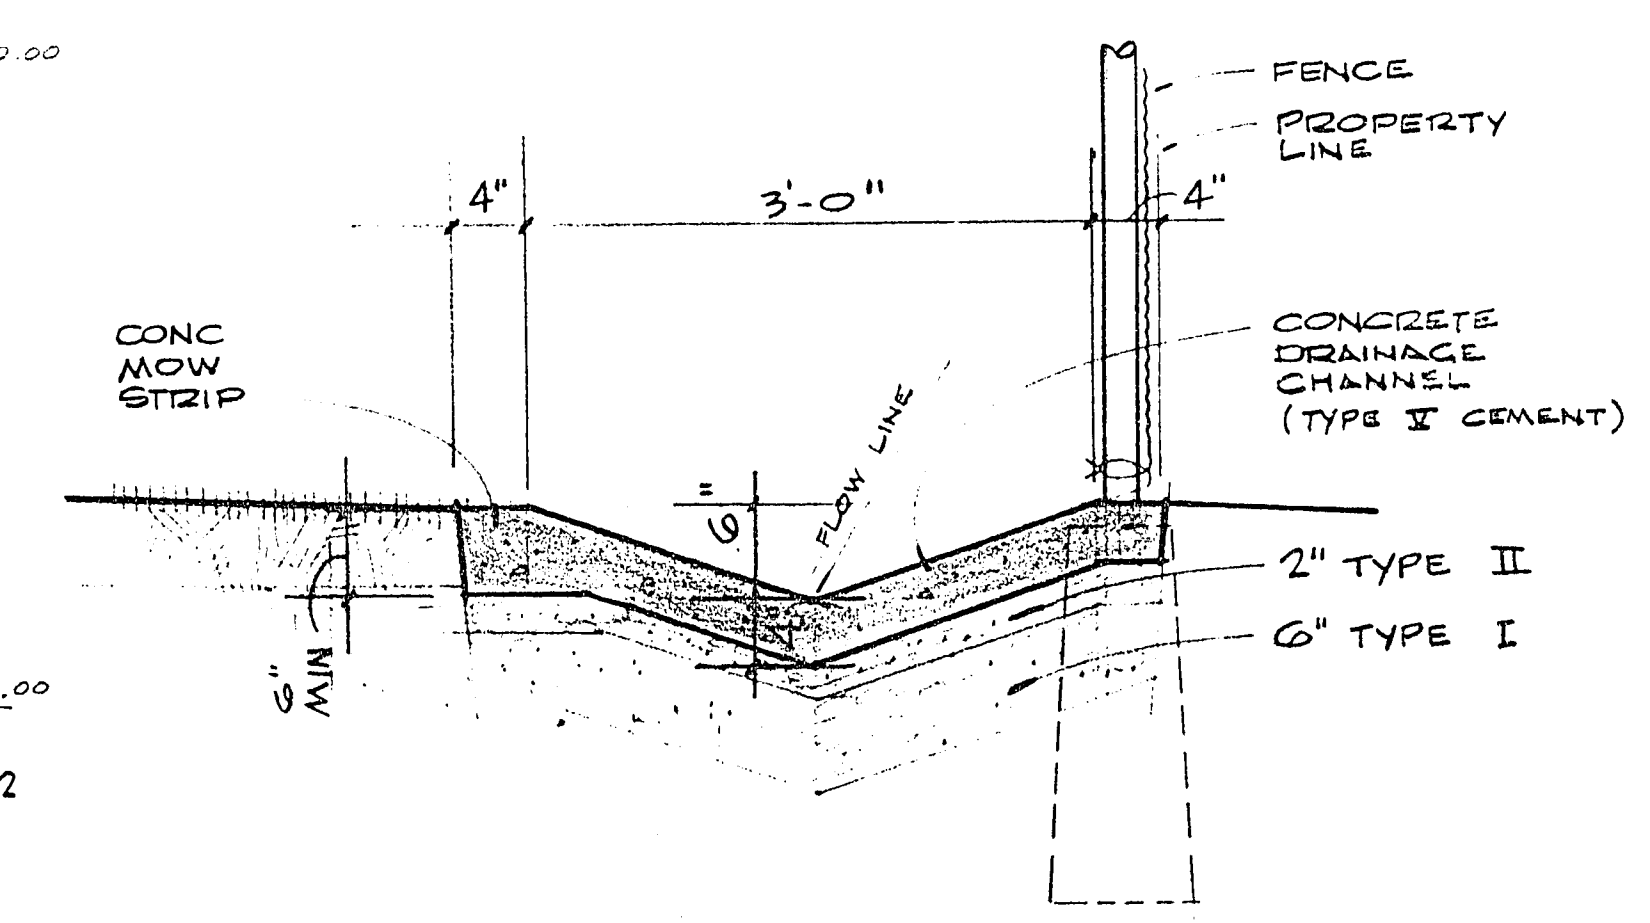


LEGEND

- APPROXIMATE EXISTING CONTOUR GRADE
- FINISH CONTOUR GRADE AT SURFACE
- 0.00 FINISH SPOT ELEVATION AT SURFACE
- 0.00TW (SAME) TOP OF WALL
- 0.00TC (SAME) TOP OF CURB
- 0.00FL (SAME) FLOW LINE

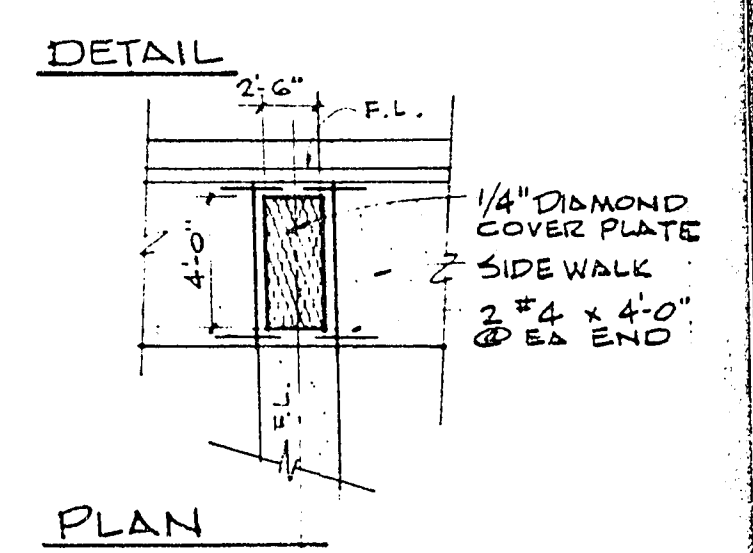

1 DRAIN UNDER SIDEWALK
SCALE 1" = 1'-0"

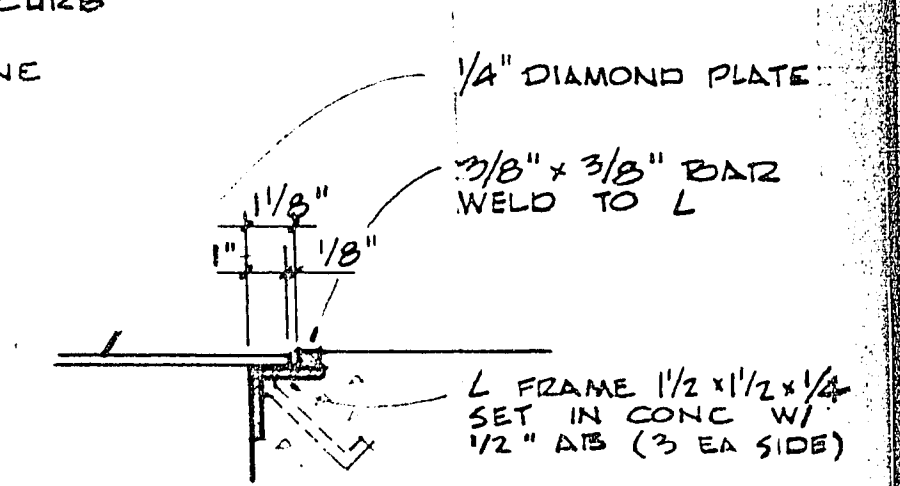


2 SECTION THRU DRAINAGE CHANNEL
SCALE 1" = 1'-0"

NOTES:

1. SEE CIVIL DRAWINGS FOR SIDEWALK WIDTHS
2. FINISH GRADES AS SHOWN IN TURF AREA SHALL BE TOP OF PLANTING SOIL.

APPROVALS:

[Signature] 7/14/76
CITY ENGINEER DATE
[Signature] 7/15/76
FIELD ENGINEER DATE

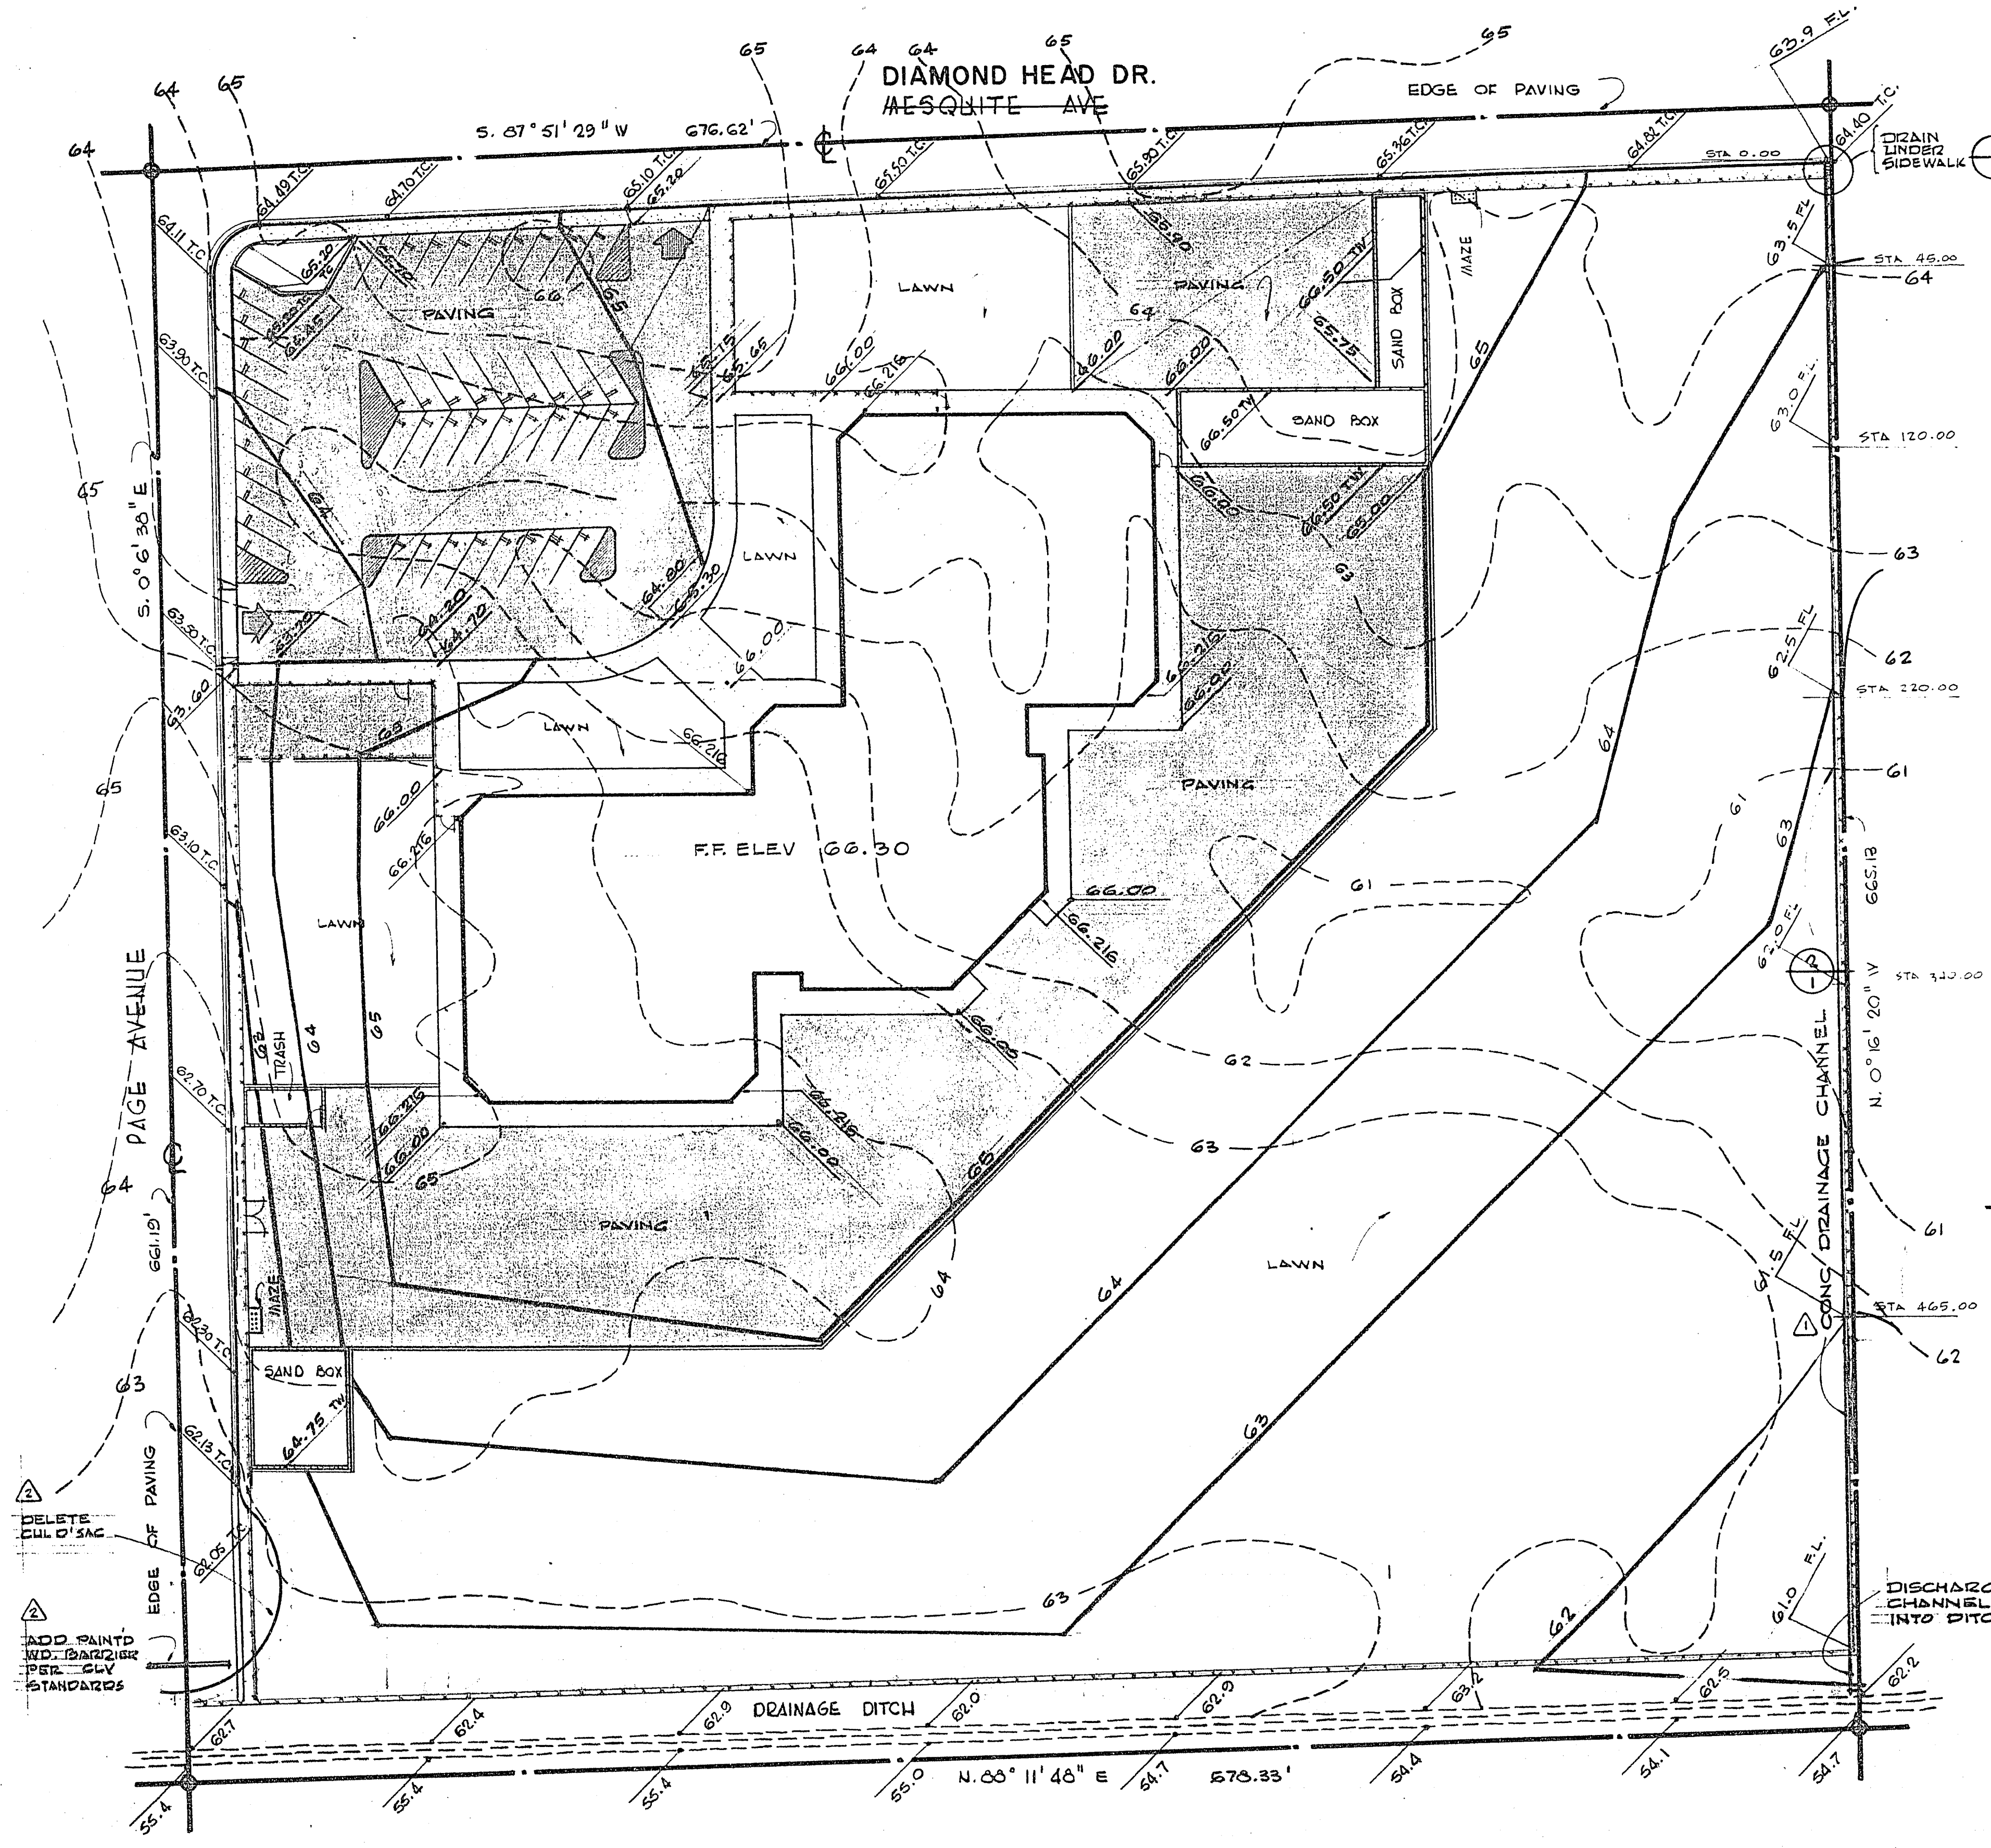

SITE GRADING PLAN

SCALE 1" = 40'

Welles Tate & Kenneedy

70 EAST SAVANA AVENUE • LAS VEGAS, NEVADA • 89104 • TEL. 733-1111

REGISTERED PROFESSIONAL ENGINEER
No. 873
EXPIRATION DATE 12/31/80

GRADING PLAN

ELEMENTARY SCHOOL # 12
CLARK COUNTY SCHOOL DISTRICT

DATE 7/12/76
SHEET 2
OF 18 SHEETS
PROJ. NO. 76-06
107-4970