
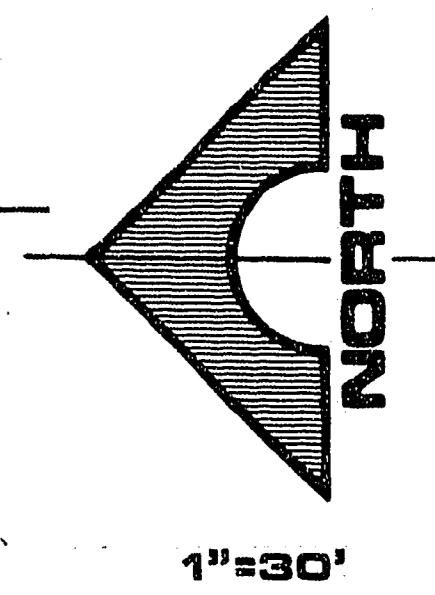


JOB NO. 632.040

854 DIETRICH-POST 65328

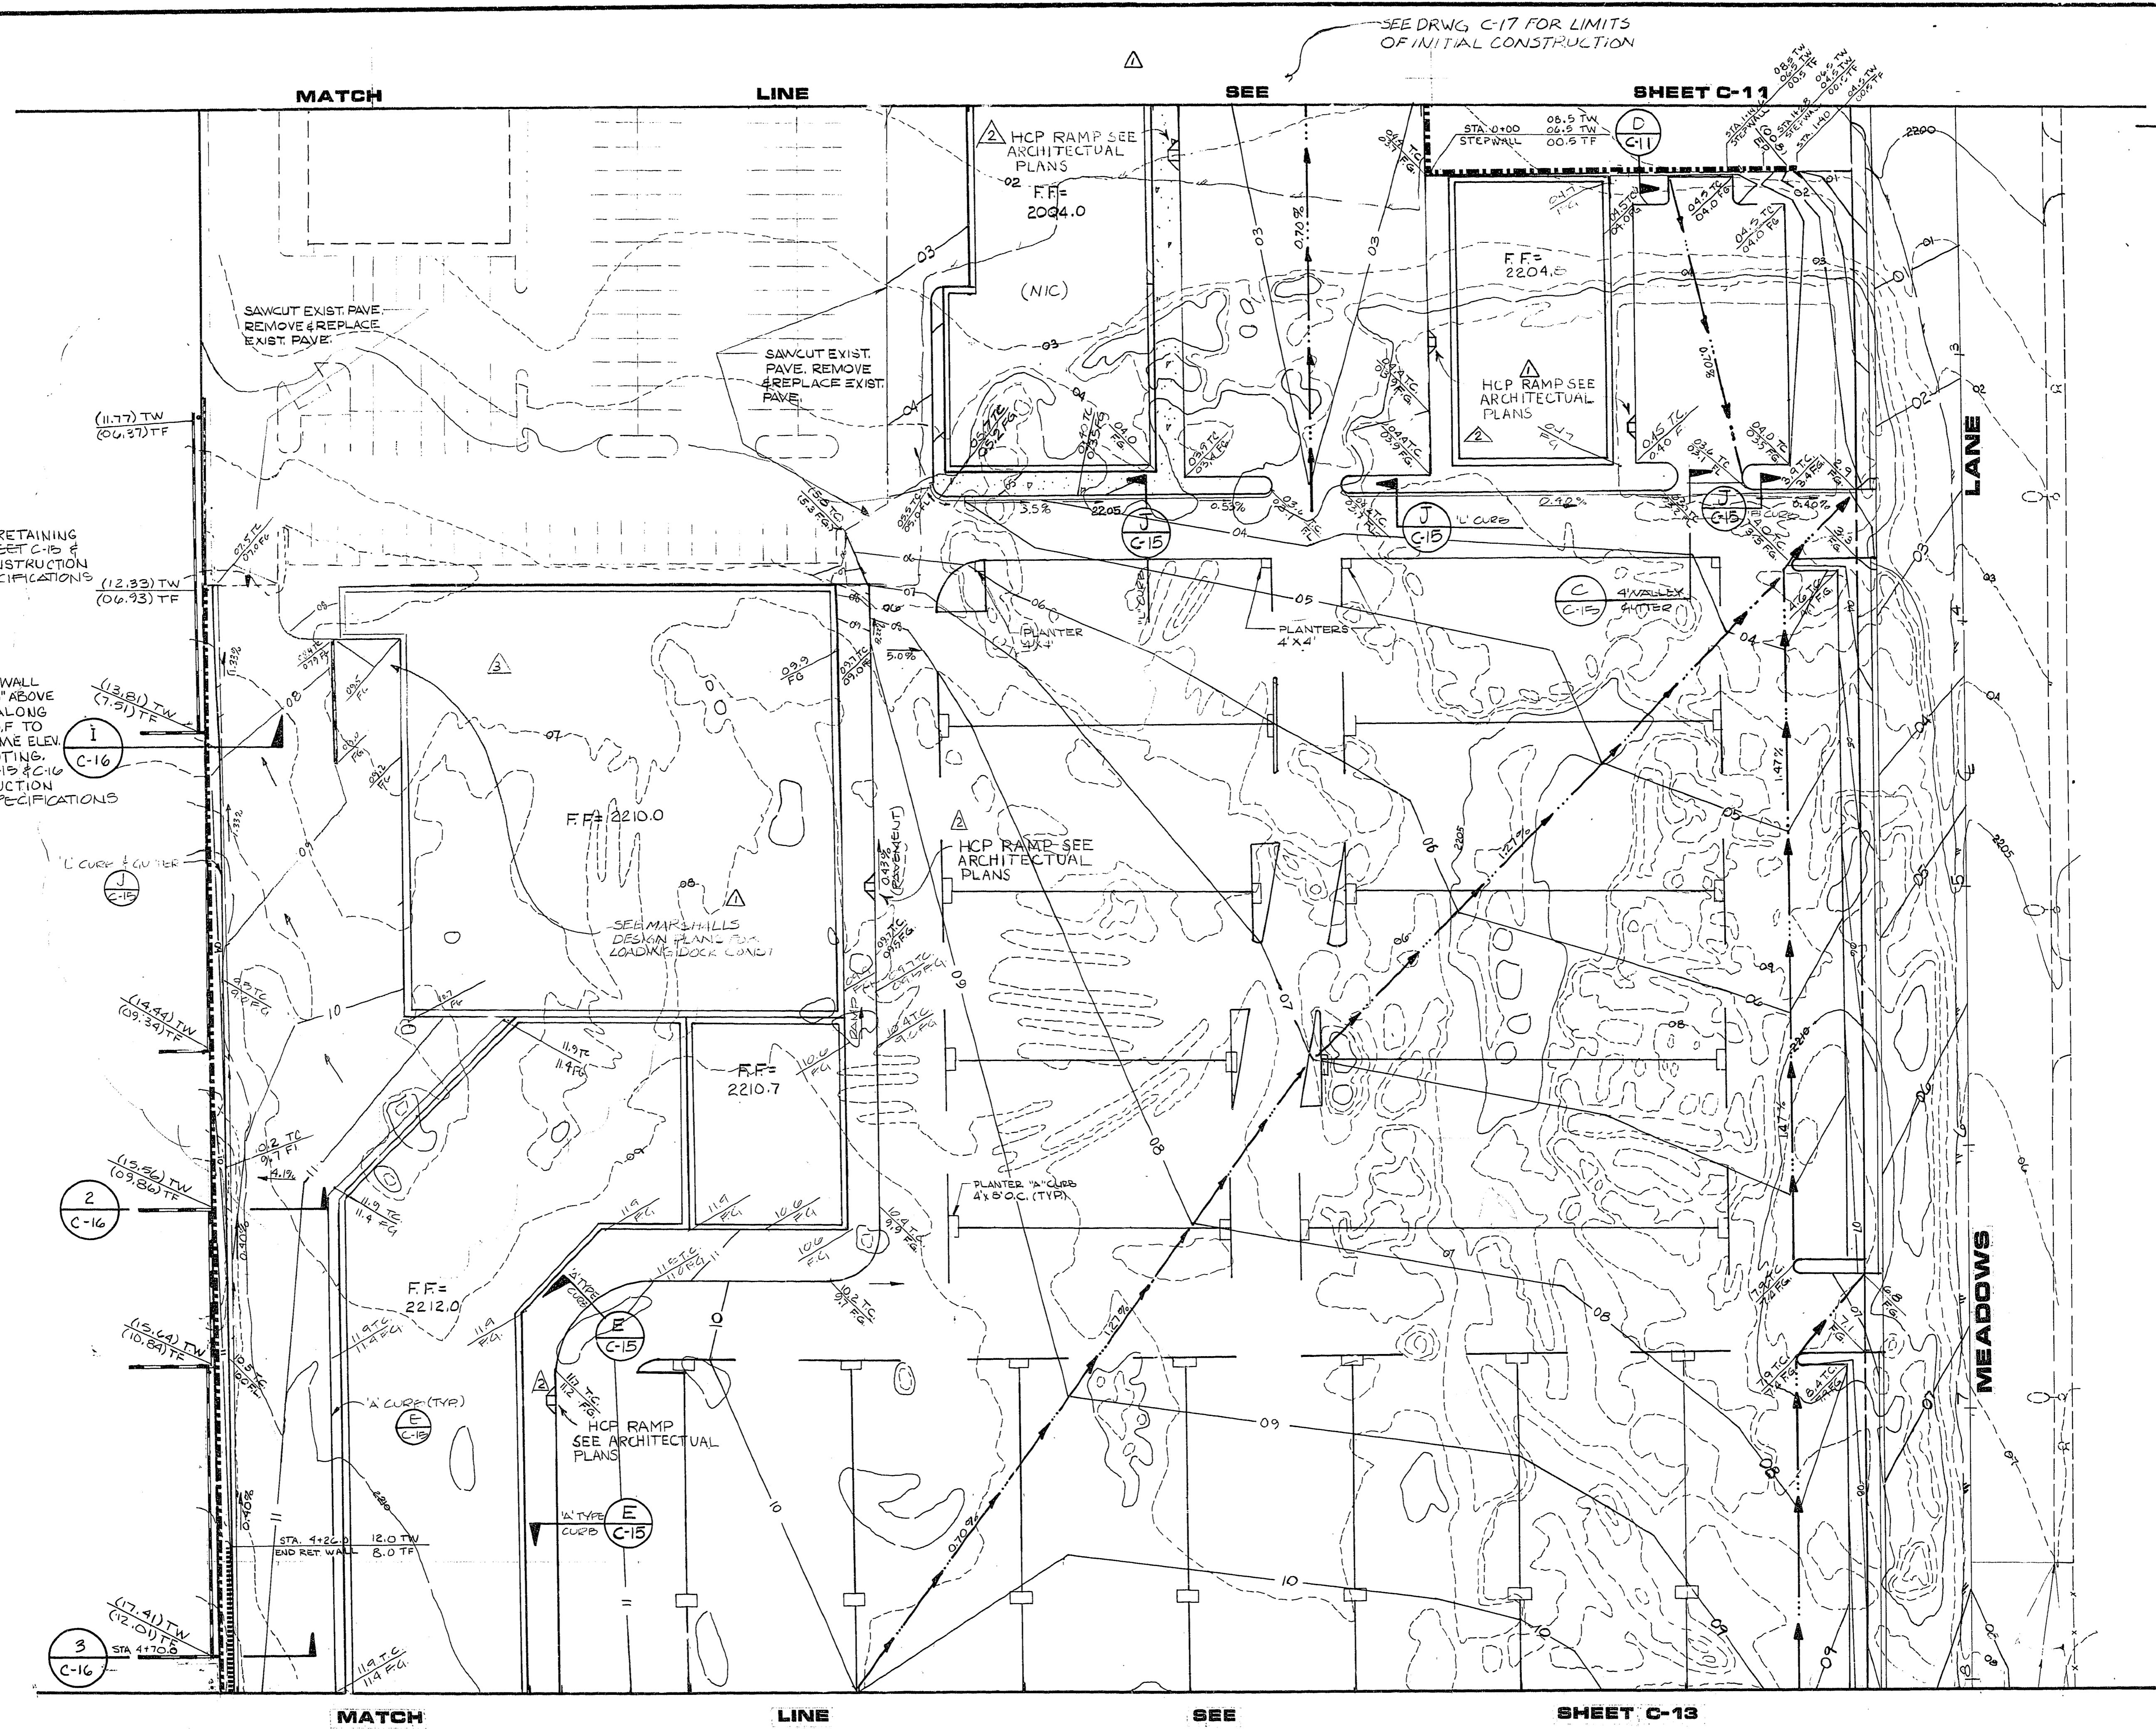

REV	DATE	DESCRIPTION
1	11/16/86	ADD C-17 ANGLE, REVISED GRABES, LANDING, S.W.C. ELEV., MOVES, PAVES, M.S.S. WALLS, NOTES
2	8-20-87	ADDED HCP RAMP, SEE ARCHITECTURAL PLANS
3	5/1/87	REVISED HCP RAMP, SEE ARCHITECTURAL PLANS

RECORDED & RETURNED TO THE OFFICE OF THE CLERK OF THE DISTRICT COURT
 DEAN A. BECK & ASSOCIATES
 Engineering/Architecture
 1535 SOUTH RAINBOW BLVD. LAS VEGAS, NEVADA 89102
G.C. WALLACE, INC.
 Engineering/Architecture

DECATUR CROSSING
 DEAN A. BECK & ASSOCIATES
GRADING & DRAINAGE PLAN

SEE CONTROL PLAN C-14
 FOR DIMENSIONS DO NOT SCALE

CLV
 CLV CHIEF LAND DEVELOPMENT
 DATE 8-21-86

SHEET
C-12
 OF 17 SHEETS

1074-1229