


JOB NO. 632.040


894 DIETRICH-POST 65328

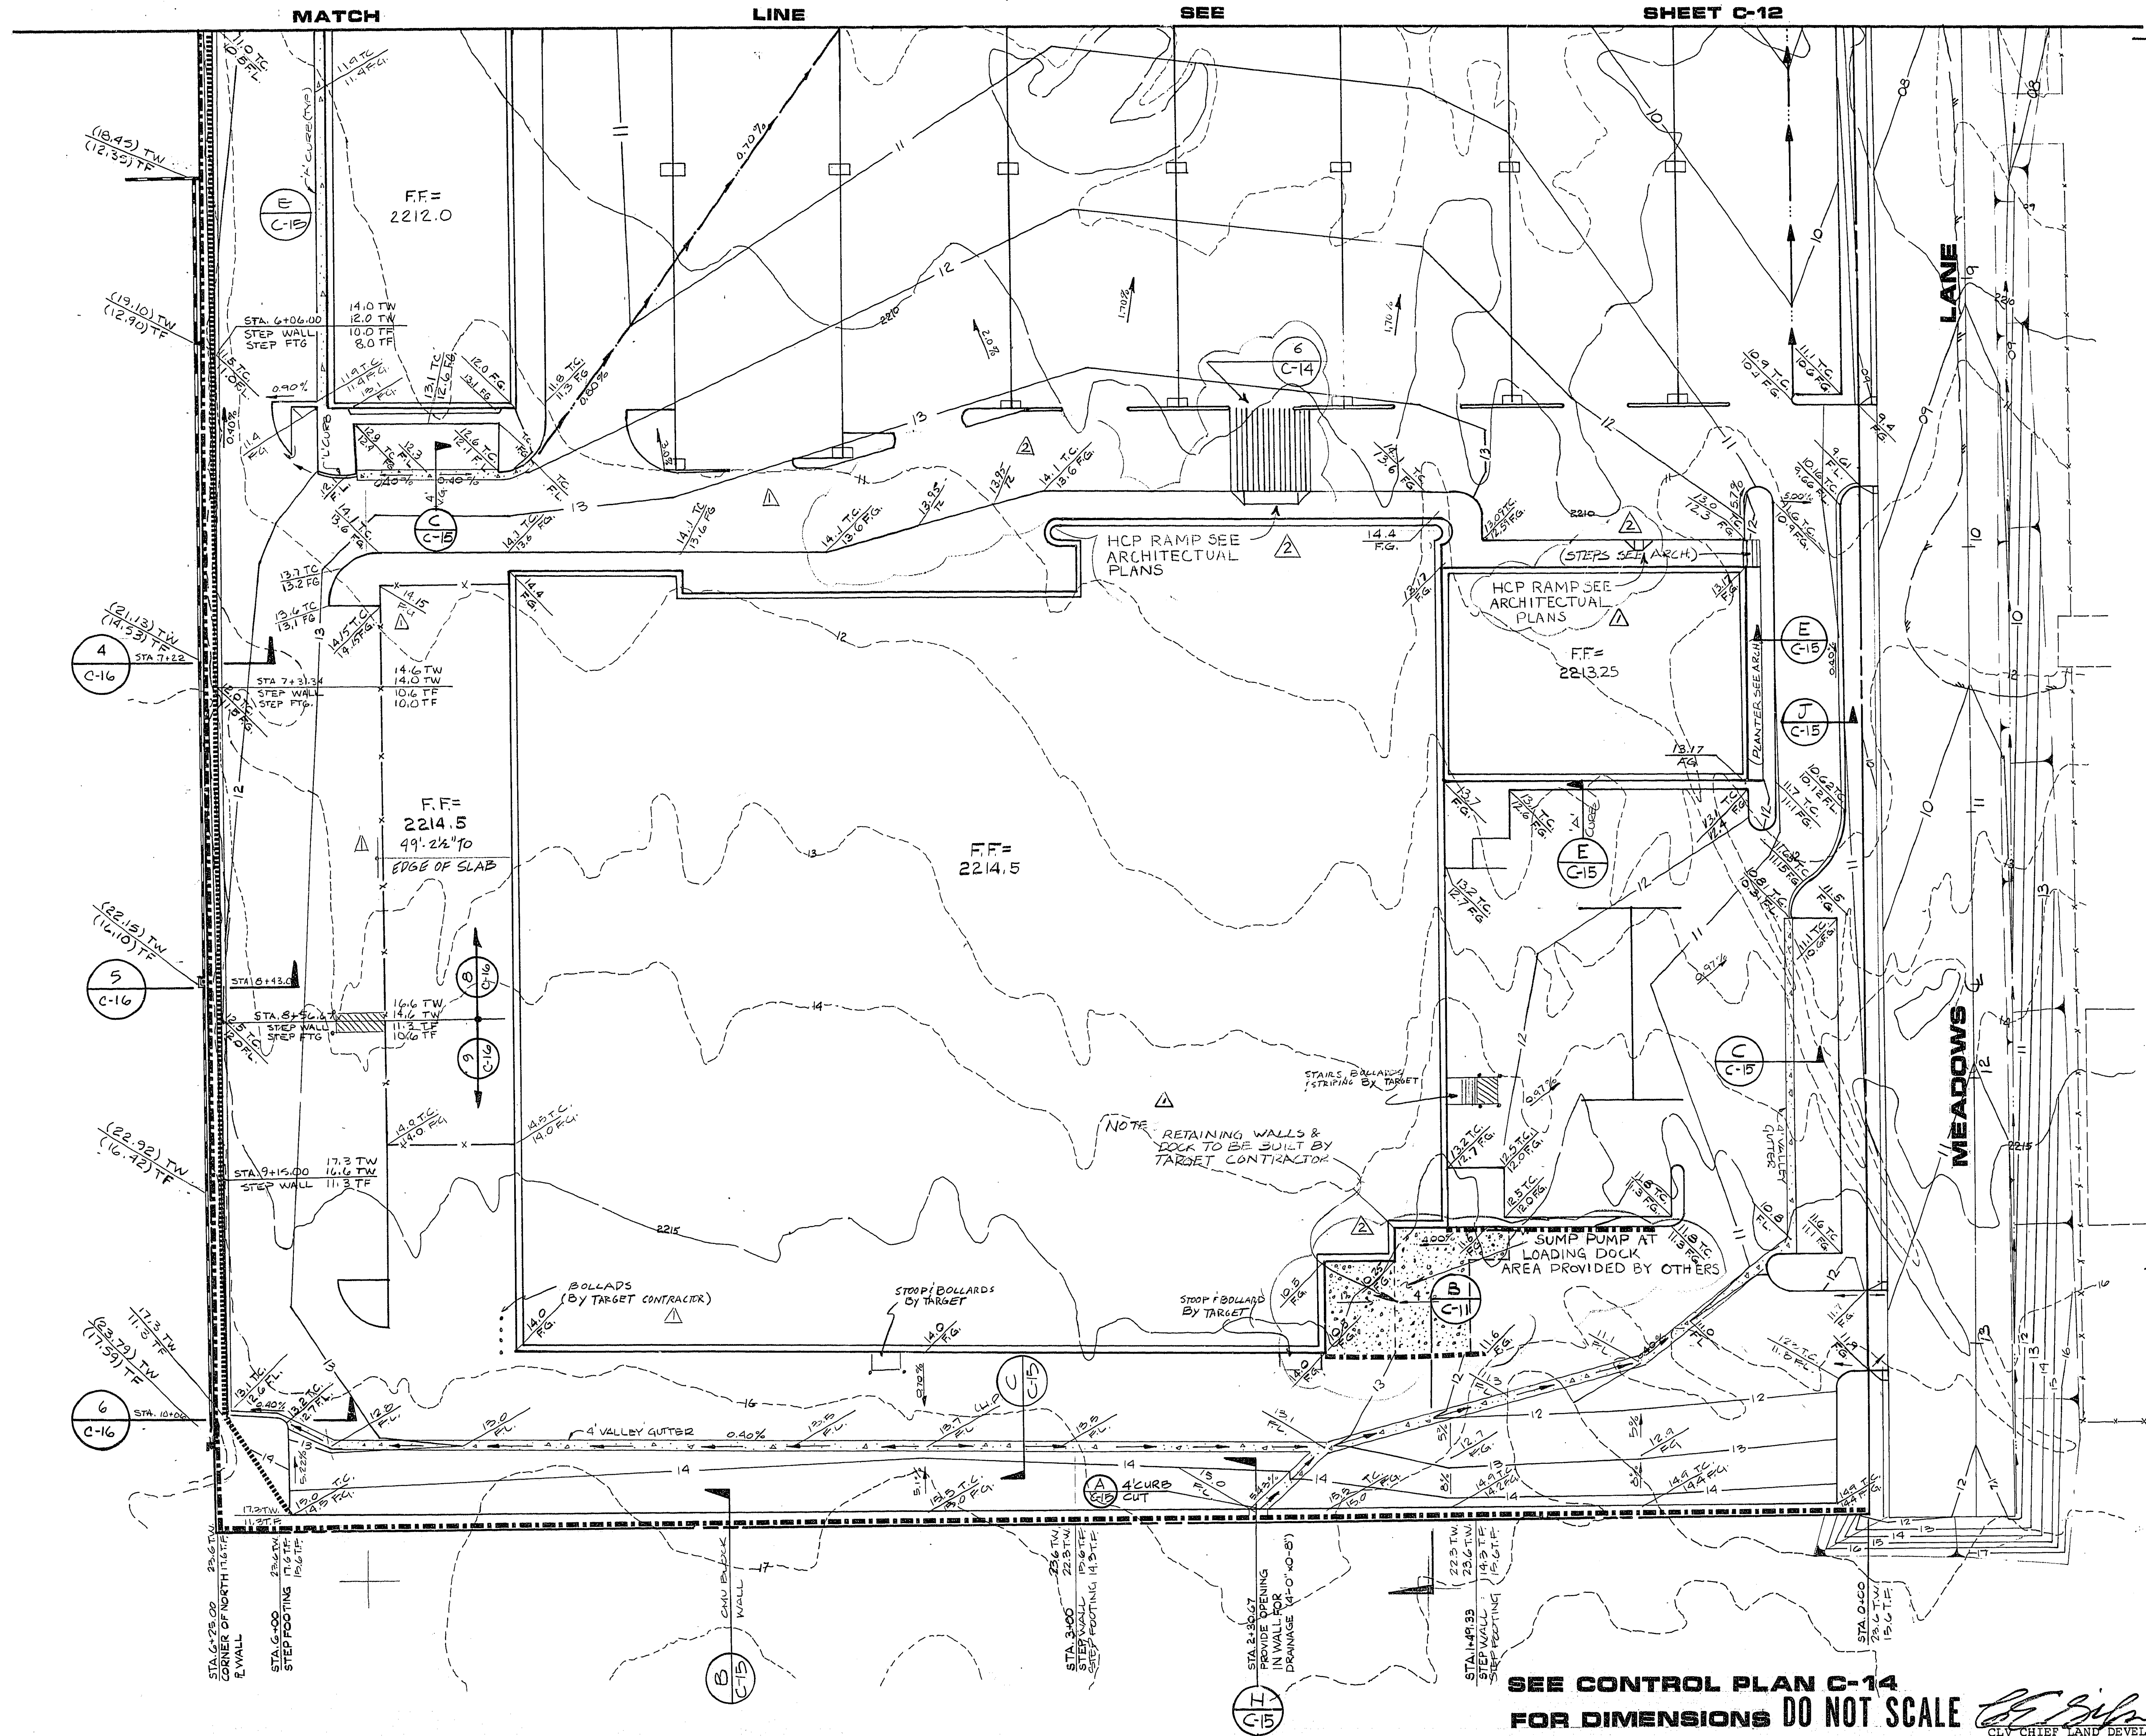

SEE CONTROL PLAN C-14  
 FOR DIMENSIONS DO NOT SCALE

*CLV*  
 CLV CHIEF LAND DEVELOPMENT

8-21-86  
 DATE

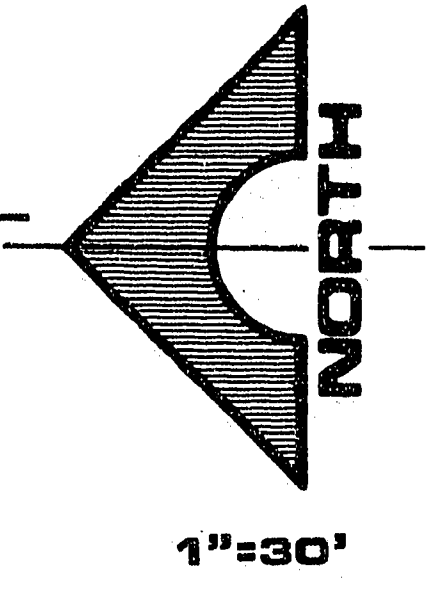

REV	DATE	DESCRIPTION
1	11/18/85	ISSUED FOR PERMITS
2	11/18/85	ISSUED FOR PERMITS
 155 SOUTH RAINBOW BLVD. LAS VEGAS, NEVADA 89102  
**G.C. WALLACE, INC.**  
 Engineering/Architecture

DECATUR CROSSING  
 DEAN A. BECK & ASSOCIATES  
 GRADING & DRAINAGE PLAN

SHEET  
**C-13**  
 OF 17 SHEETS

1074-1229