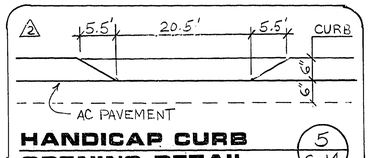

HANDICAP CURB OPENING DETAIL 5 / C-14

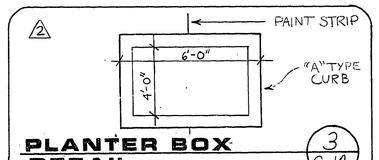

PLANTER BOX DETAIL 3 / C-14

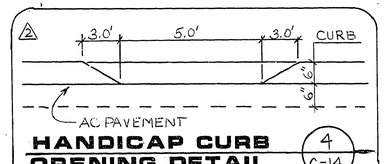

HANDICAP CURB OPENING DETAIL 4 / C-14

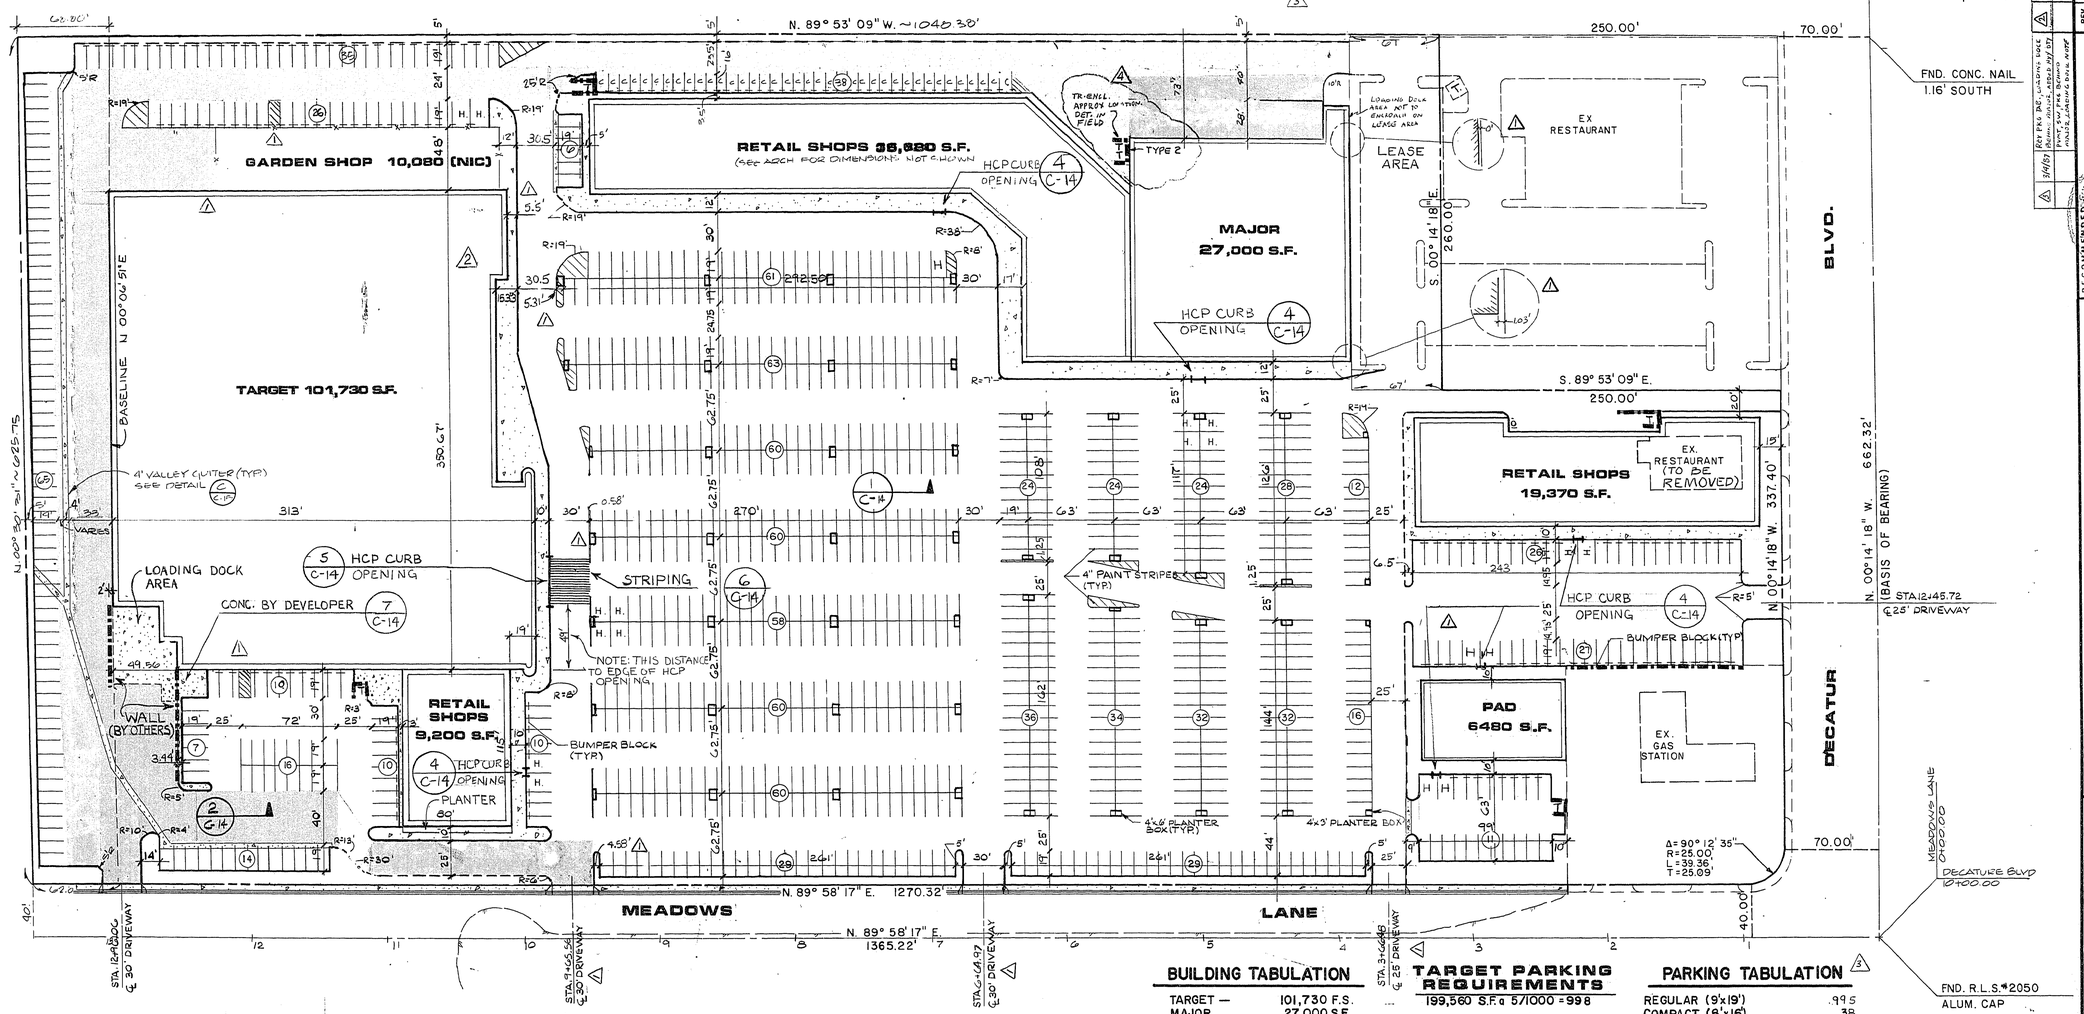

BUILDING TABULATION

TARGET —	101,730 F.S.
MAJOR	27,000 S.F.
RETAIL SHOPS	64,350 S.F.
PADS	6,480 S.F.
TOTAL	199,560 S.F.

TARGET PARKING REQUIREMENTS

199,560 S.F. @ 5/1000 = 998

NOTE: SEE ARCH. FOR BLDG. DIMENSIONS NOT SHOWN

PARKING TABULATION

REGULAR (9'x19')	995
COMPACT (8'x16')	38
HANDICAP (13.5x19')	19
TOTAL	1052

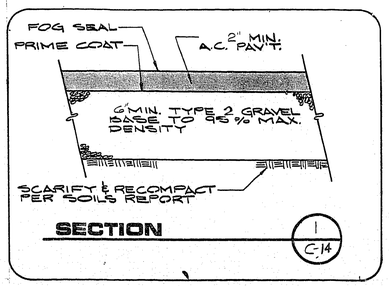

SECTION 1 / C-14

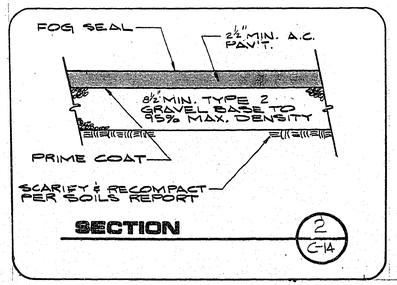

SECTION 2 / C-14

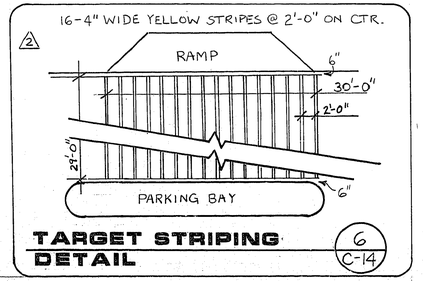

TARGET STRIPING DETAIL 6 / C-14

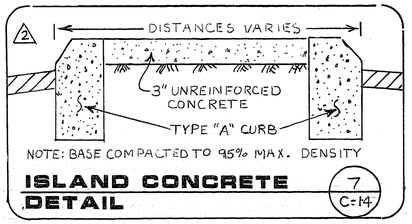

ISLAND CONCRETE DETAIL 7 / C-14

LEGEND

- WALL (NO CURB)
- "A" CURB (E / C-15)
- "L" CURB (J / C-15)
- HANDICAP CURB OPENING (4 / C-14)
- TRASH ENCLOSURE (C / C-11)

CLV CHIEF LAND DEVELOPMENT — DATE 8-21-86

REV	DATE	DESCRIPTION
	1/14/87	REVISE & INSERT LOADING DOCK AREA, DELINEATE LIMITS OF AC CURB, WALLCURB, HCP CURB ADDED DETAIL 4 & 6, RV TARGET SIM.
A	11/5/86	REVISED DIMENSIONS, MOVED PAD & PARKING LOT, REVISED DRIVEWAY STATIONS, RELOCATE TRASH ENCL. BEHIND TARGET
	8/21/86	
A	6-19-86	REVISE TRASH ENCL. LOCATION

REV. PER DE, LOADING DOCK, PAVING, & LANDSCAPING — 3/4/87

RECOMMENDED: 8-21-86 — DATE

REV. PER DE, LOADING DOCK, PAVING, SW, FIRE, BUILDING, HANDICAPPING & DRIVE WAYS — 1/14/87

RECEIVED: 8-20-86 — R.E. NO. DATE

G.C. WALLACE, INC.
Engineering/Architecture
1555 SOUTH RAINBOW BLVD. / LAS VEGAS, NEVADA 89102

DECATUR CROSSING
DEAN A. BECK & ASSOCIATES
DIMENSION CONTROL & PAVING PLAN

SHEET C-14 OF 17 SHEETS

JOB NO. 632.040

8/84 DIETERICH-POST 65328

107-1229