

N532,500

N532,000

N531,500


N531,000

Avoid cutting underground utility lines. It's costly.

**Call before you Dig.**

1-800-227-2600  
UNDERGROUND SERVICE UTILITIES

REV	DATE	DESCRIPTION
1	11-22-84	DESIGN/UNDERGROUND DITCH - SEE SHT. 1
2	1-29-85	REV. DATE
3	1-29-85	REV. DATE

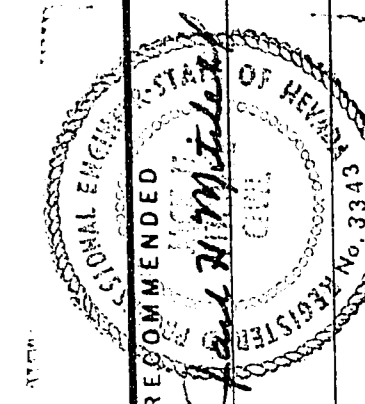


1155 SOUTH RAINBOW BLVD., LAS VEGAS, NEVADA 89102

**G.C. WALLACE, INC.**  
Engineering/Architecture

R A HOMES  
DESERT SHORES  
MASS GRADING PLAN

SHEET  
**6**  
OF 9 SHEETS

Grid 107Y-12 48

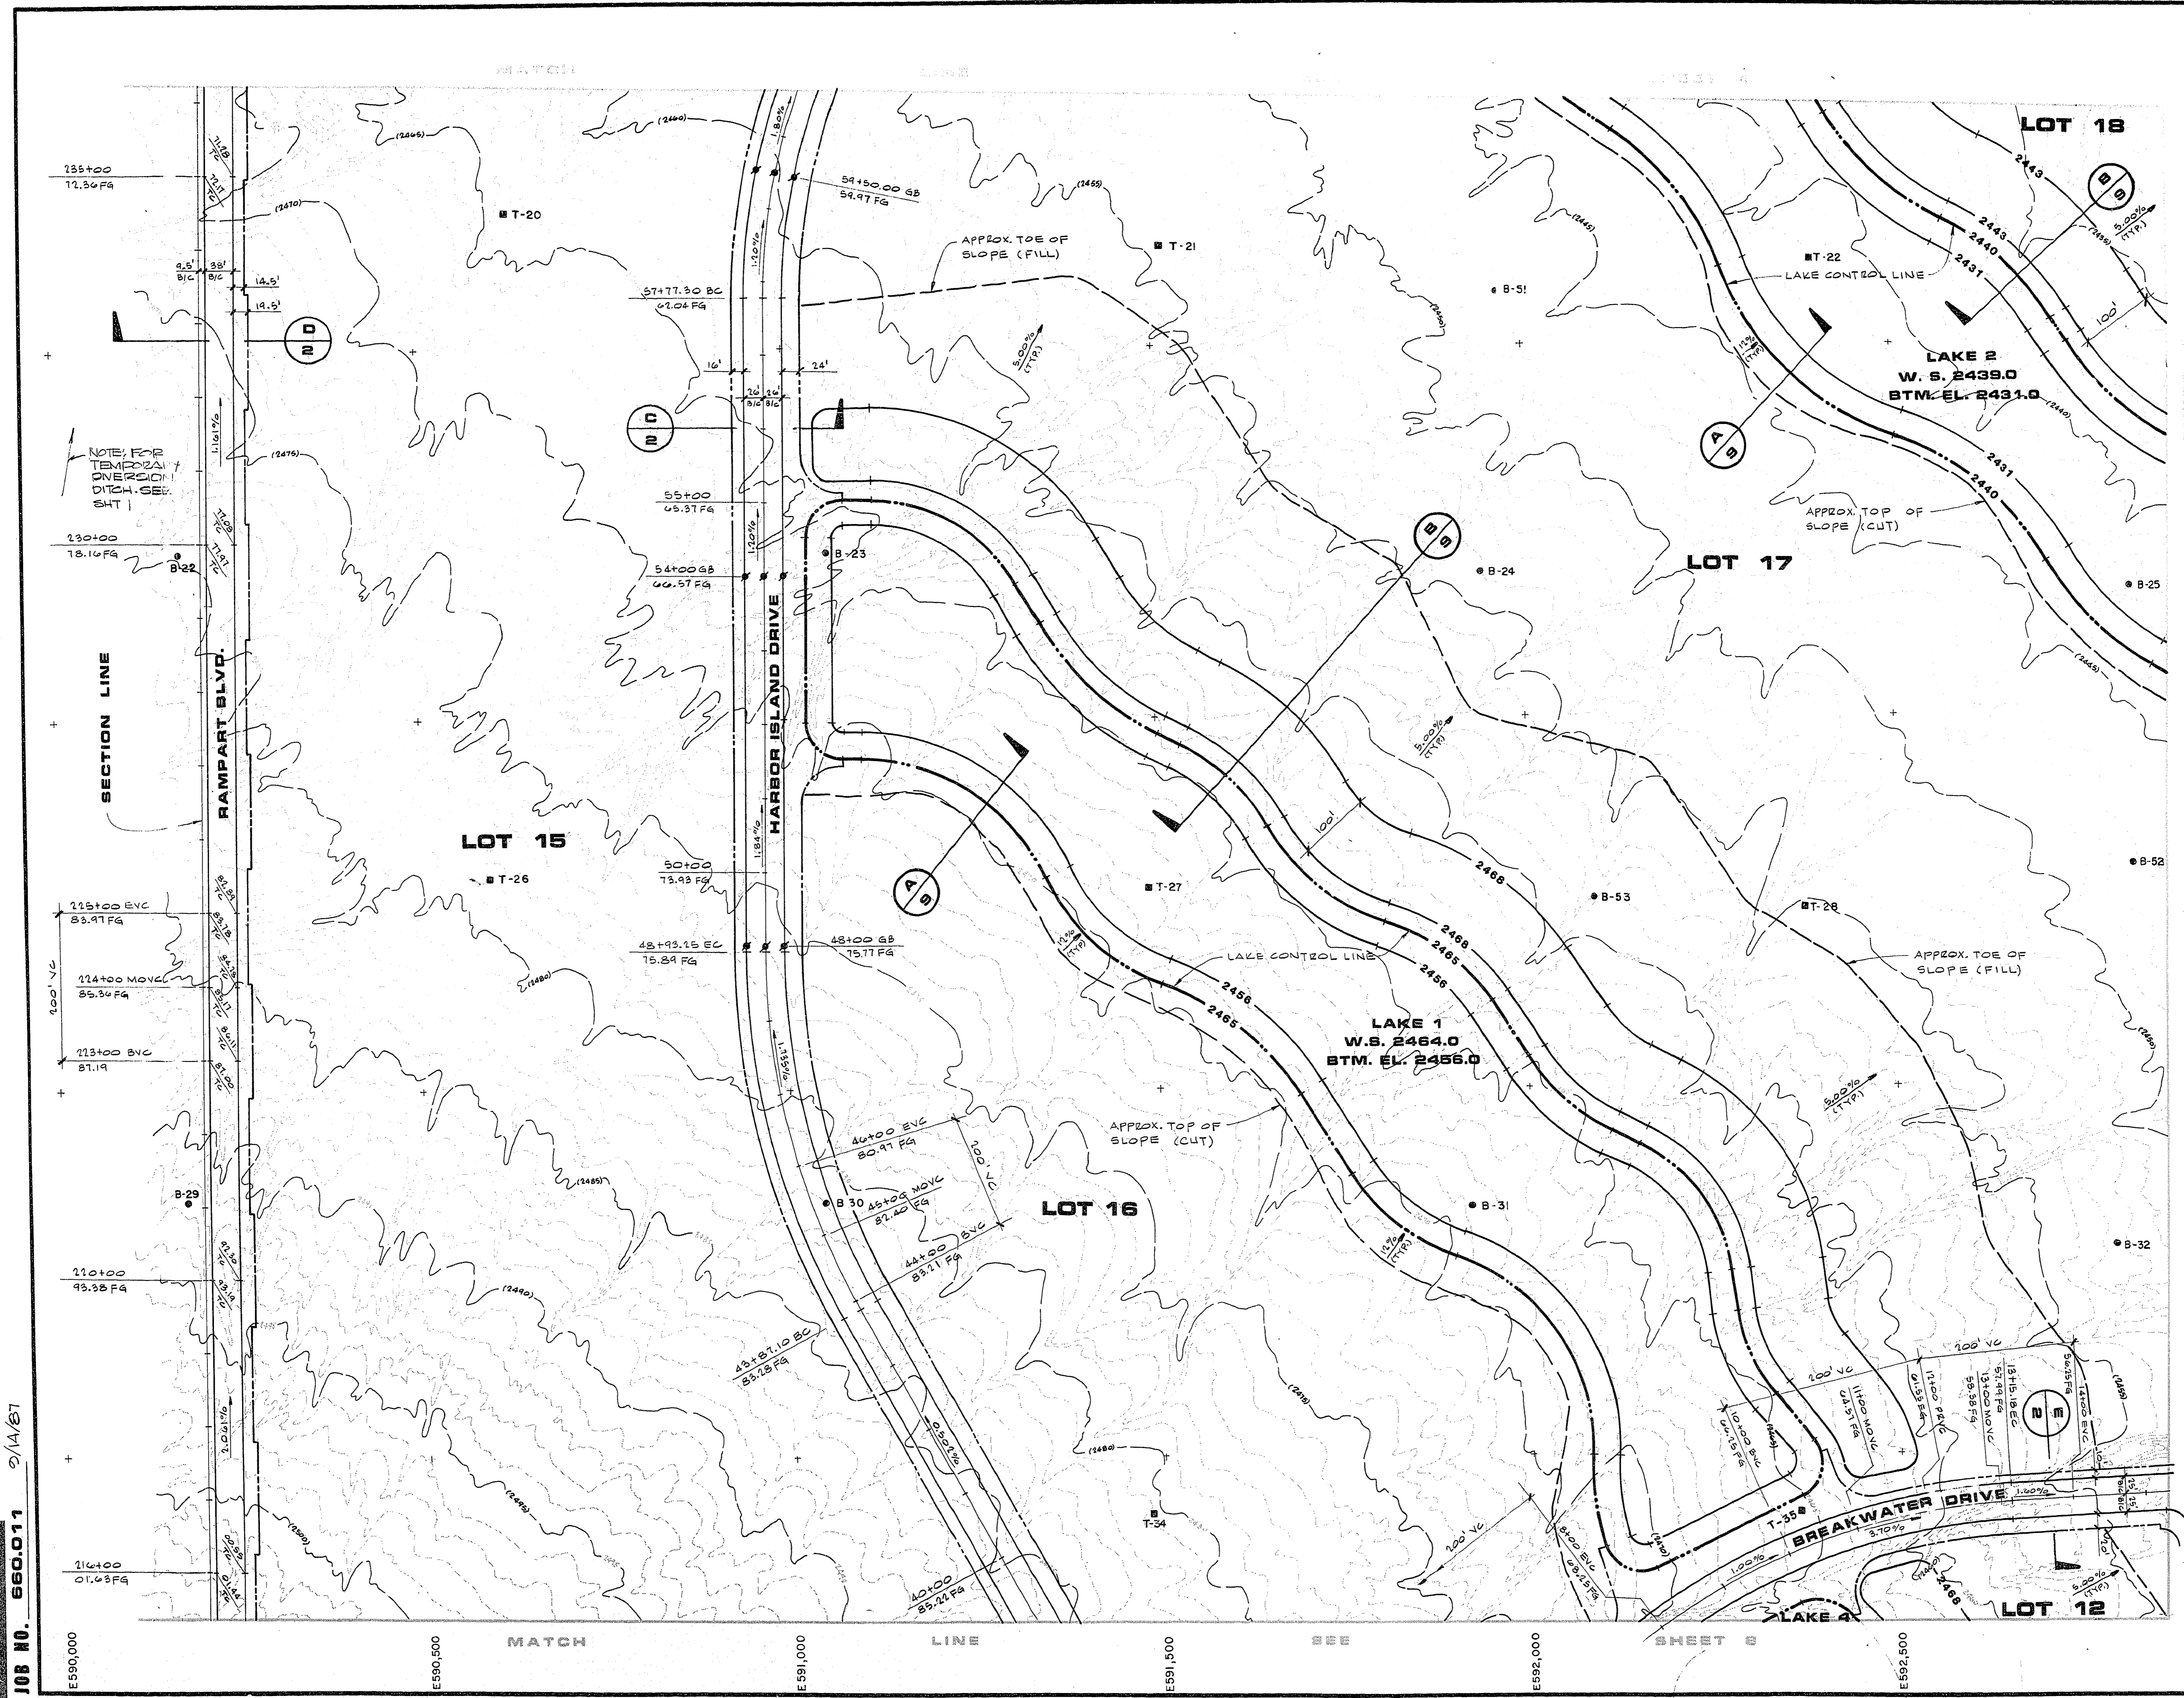

JOB NO. 660.011 9/14/87

E590,000

E590,500

E591,000

E591,500

E592,000

E592,500

8/84 DIETRICH-POST 65328