

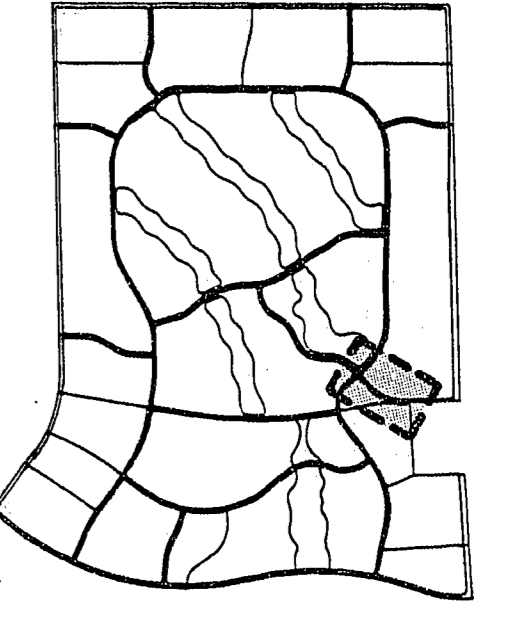


PROFILE
 SCALE: HORIZ. 1" = 40'
 VERT. 1" = 8'

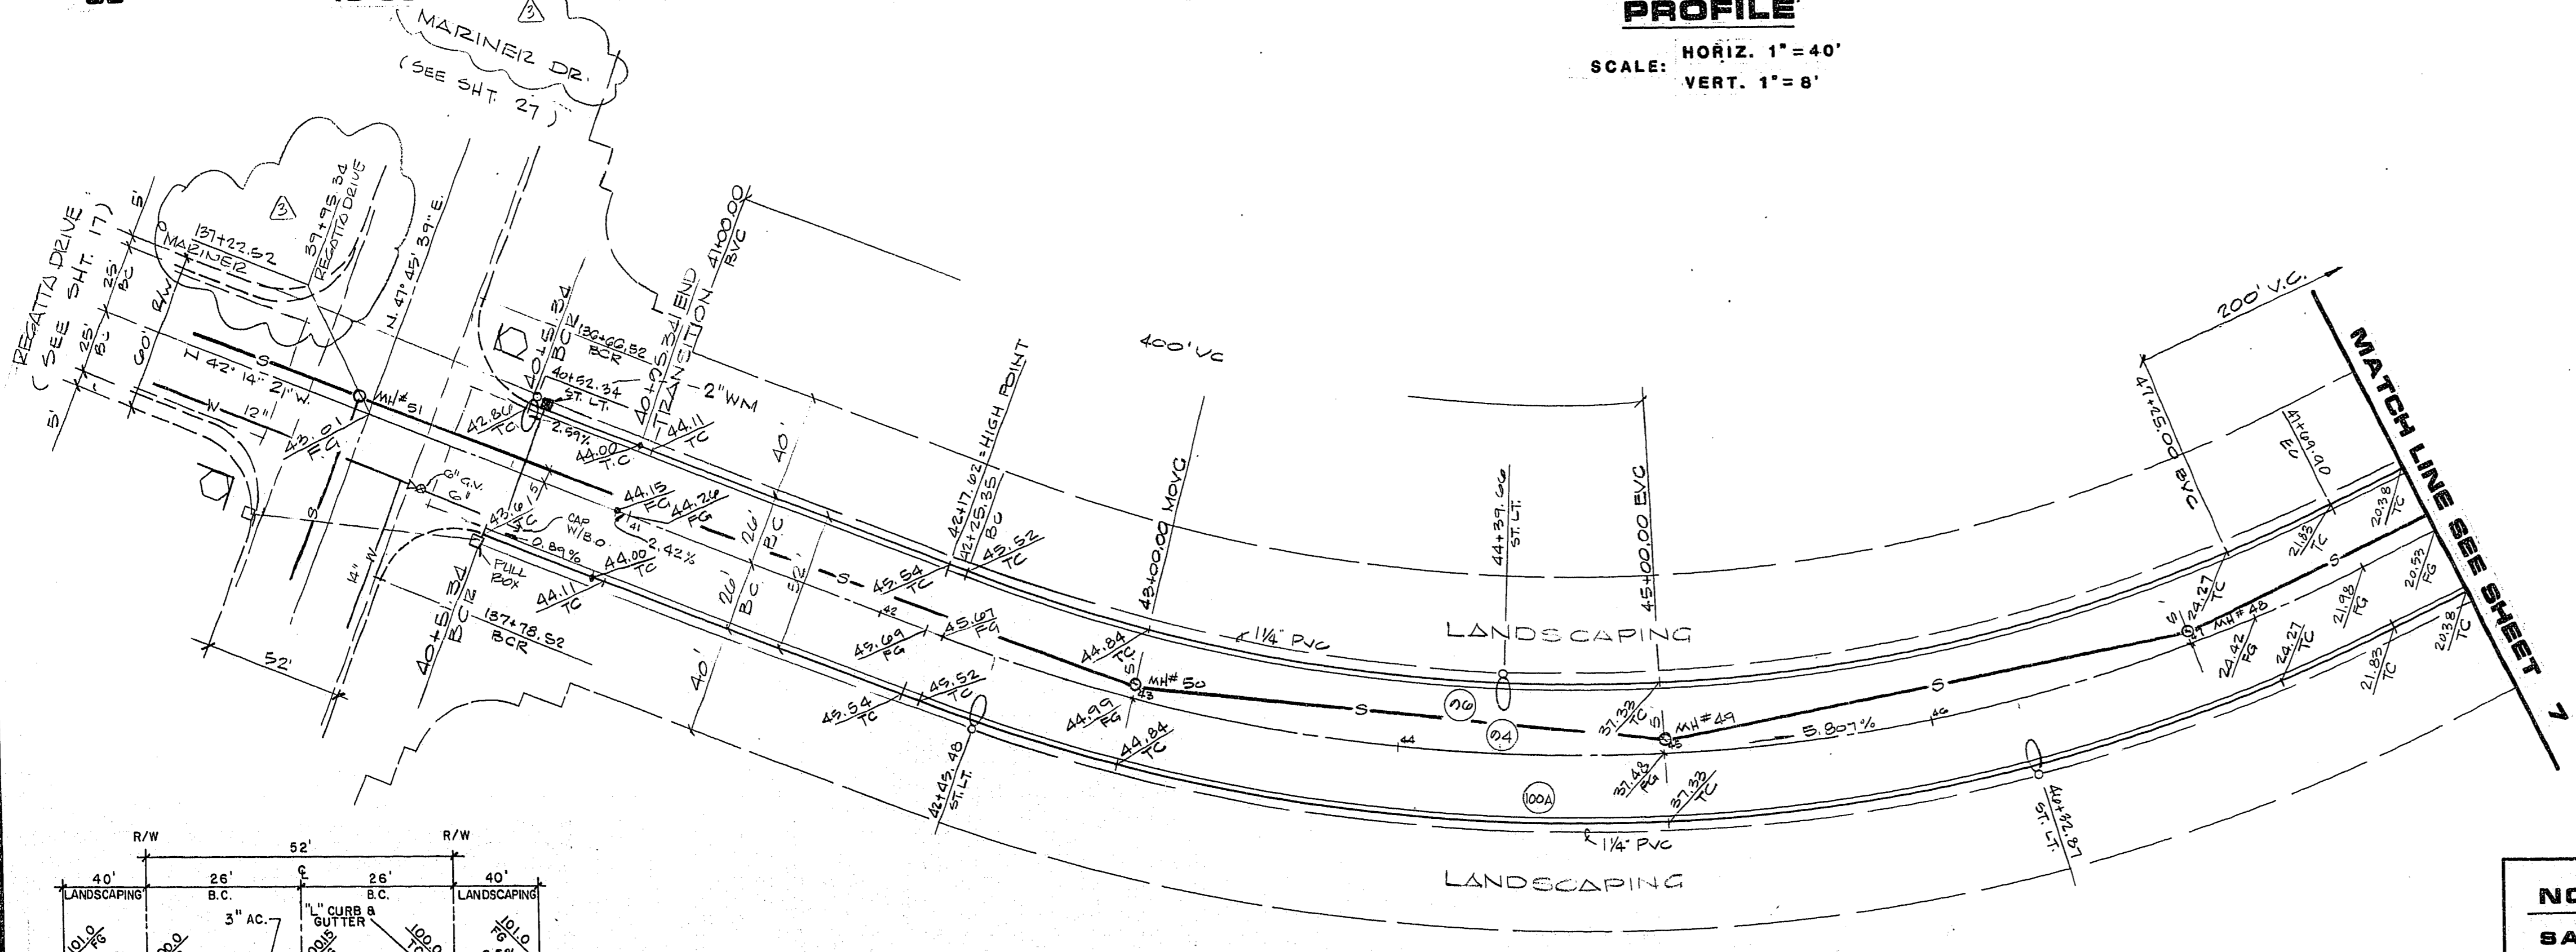

KEY MAP

NOTE:
 SANITARY SEWER
 PIPE TO BE PVC

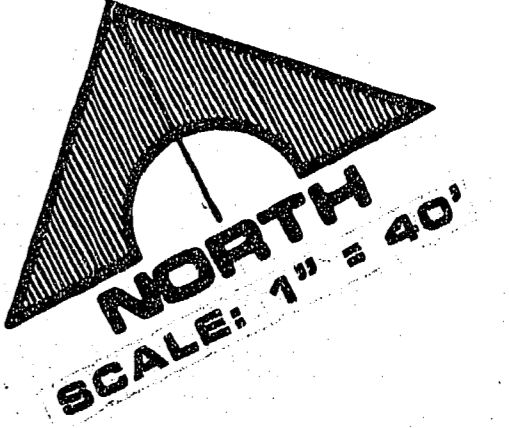

BCR CURVE DATA

No.	Δ	R	L	T
04	48°00'00"	650.00	544.54	289.40
06	48°00'00"	624.00	522.76	277.82
00A	48°00'00"	676.00	566.32	300.97

- NOTES:**
- STRUCTURAL SECTION OF STREET TO CONFORM TO C.L.V. STANDARD DRAWINGS.
 - NATIVE MATERIAL MAY BE USED IN LIEU OF TYPE I WHEN PROCESSED FOR APPROVAL IN ACCORDANCE WITH CITY OF LAS VEGAS STATEMENT OF POLICY DATED 7/25/86.

STREET "A"
 (SMOKE RANCH)

REV	DATE	DESCRIPTION
1	1-19-88	REVISED PER ST. SEC. NOTE 2 DATE
2		ADDED VALLEY GUTTER
3		ADDED PROJECT TITLE AND STREET NAMES

RECOMMENDED
 DATE: 1-19-88
 REVISION NO. 3

1555 SOUTH RAINBOW BLVD. LAS VEGAS, NEVADA 89102

G.C. WALLACE, INC.
 Engineering/Architecture

RA HOMES
 DESERT SHORES - PHASE 1
 REGATTA DRIVE
 STA. 39+95.34 TO STA. 48+00.00

APPROVAL

CLV CHIEF LAND DEVELOPMENT

DATE

SHEET
 OF 43 SHEETS

JOB NO. 660009 0-14-87