




JOB NO. 660.009 2-14-87

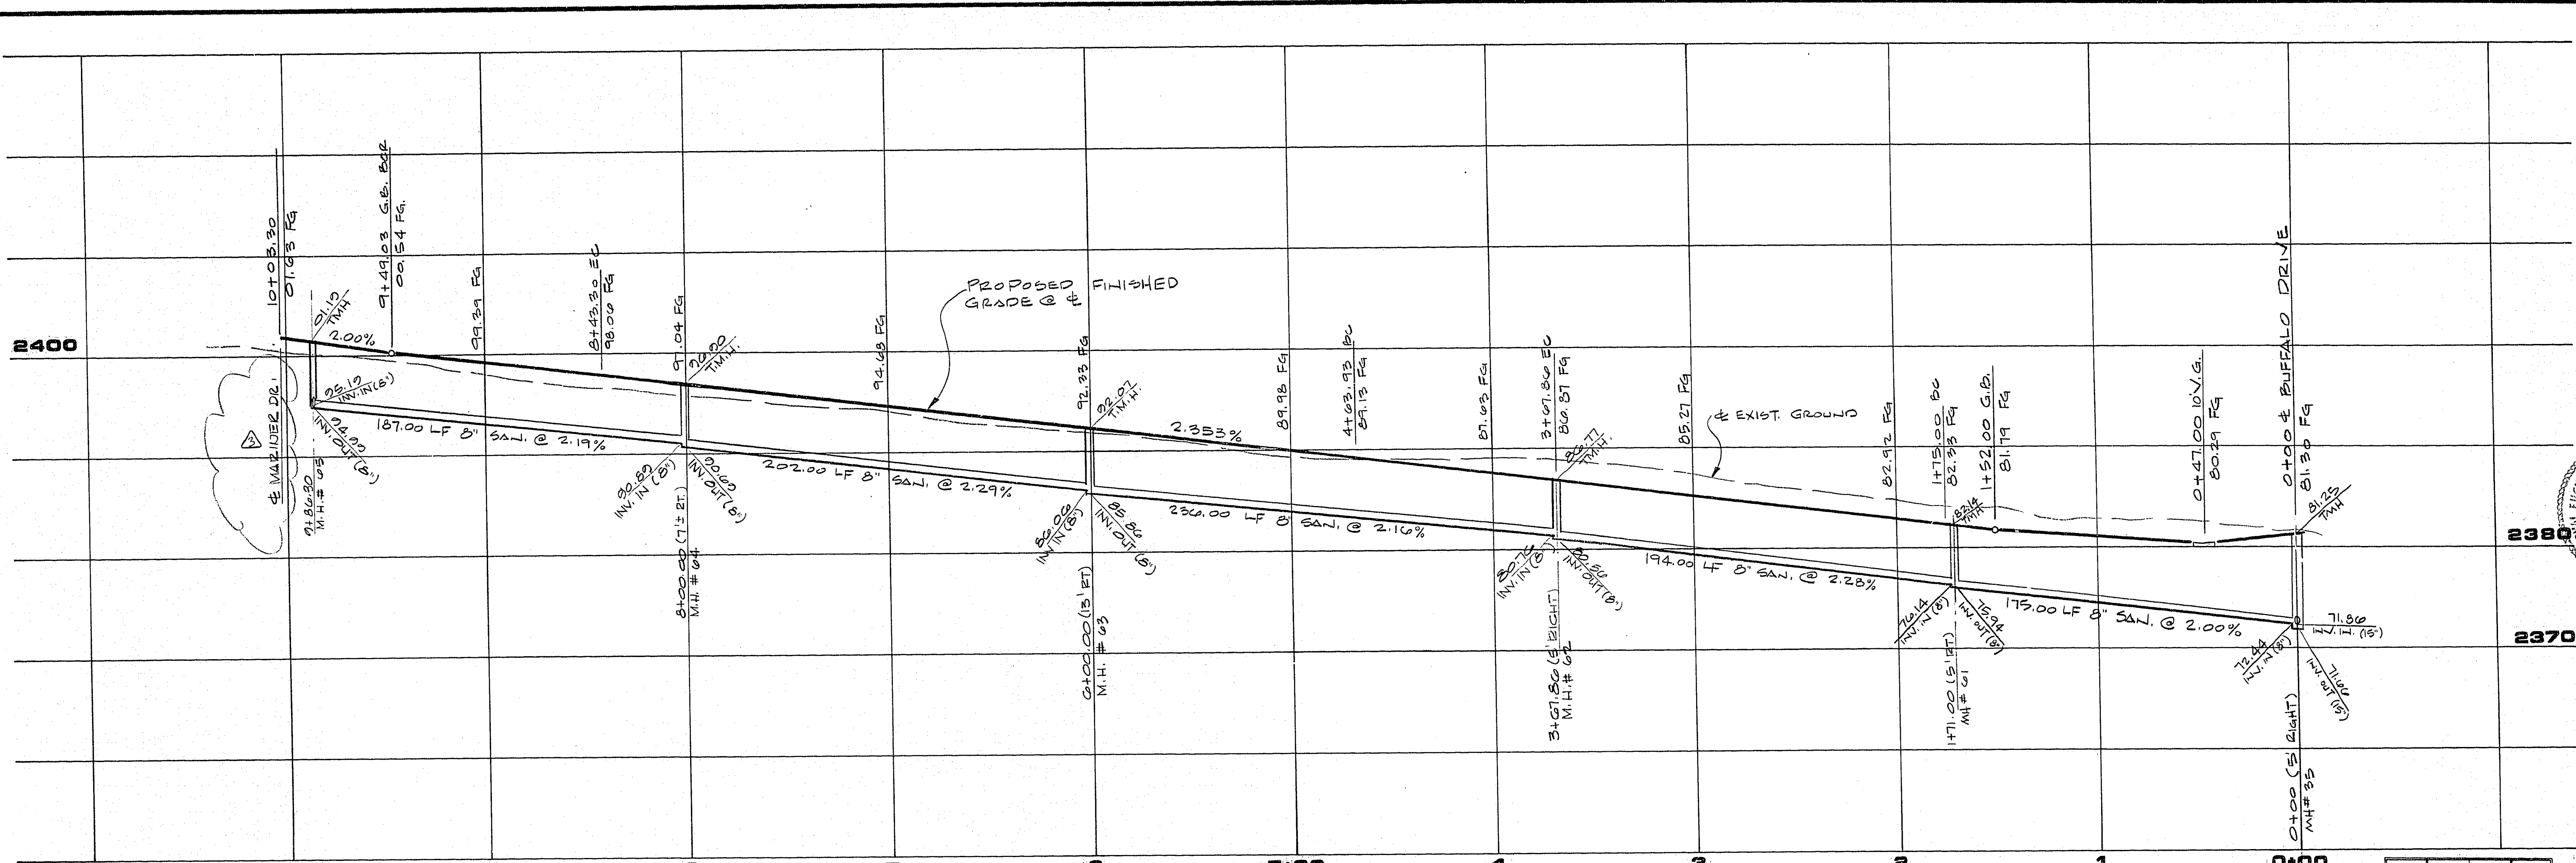

PROFILE
SCALE: HORIZ. 1"=40'
VERT. 1"=8'

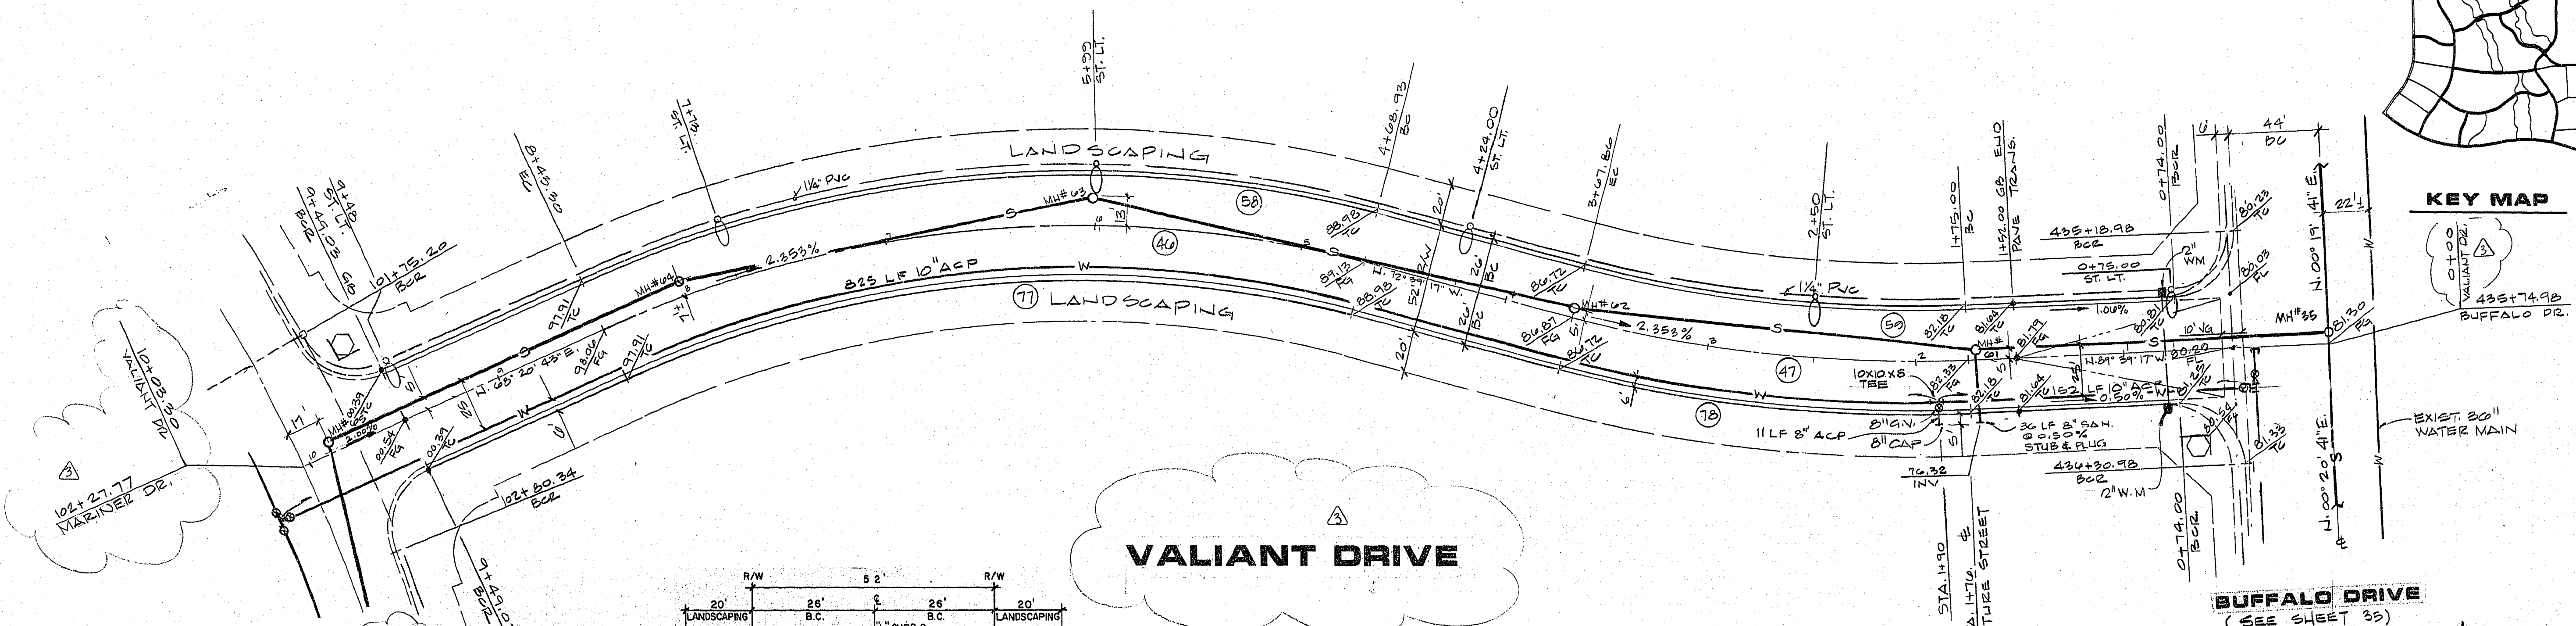


VALIANT DRIVE

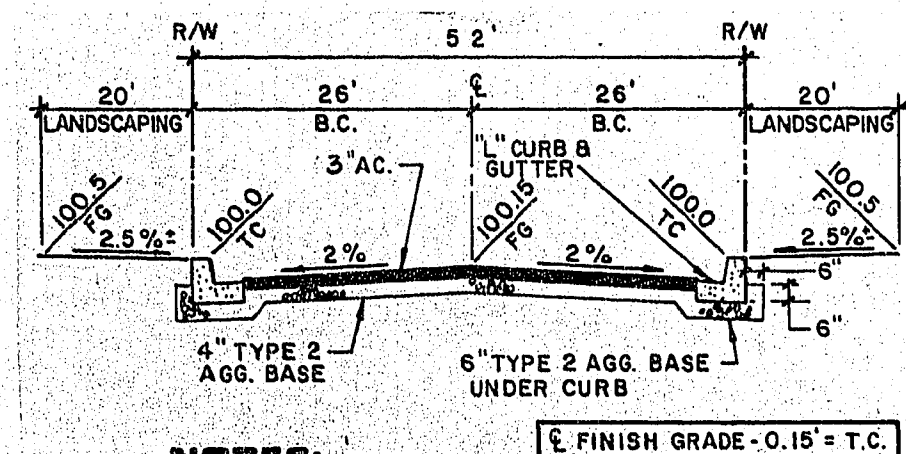

- NOTES:**
- STRUCTURAL SECTION OF STREET TO CONFORM TO C.L.V. STANDARD DRAWINGS.
 - NATIVE MATERIAL M/M BE USED IN LIEU OF TYPE 1 WHEN PROCESSED FOR APPROVAL IN ACCORDANCE WITH CITY OF LAS VEGAS STATEMENT OF POLICY DATED 7/25/86.

BCR CURVE DATA				
NO.	Δ	R	L	T
46	30°00'00"	550.00	374.37	194.77
47	17°00'00"	450.00	192.86	97.14
58	30°00'00"	370.00	392.07	203.97
59	17°00'00"	624.00	185.14	93.26
77	30°00'00"	524.00	350.68	185.56
78	17°00'00"	670.00	200.57	101.03

NOTE:
SANITARY SEWER
PIPE TO BE PVC

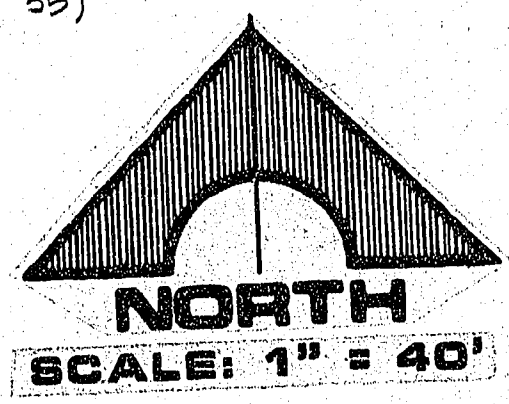

APPROVAL

CLV CHIEF LAND DEVELOPMENT DATE

REVISIONS

REV	DATE	DESCRIPTION
1	1-19-87	GENERAL REVISIONS
2	2-11-87	ADD ST. L.I. CONDUIT
3	2-11-87	ADD PROJECT TITLE AND SHEET

DESIGNER

G.C. WALLACE, INC.

Engineering/Architecture

PROJECT

DESERT SHORES - PHASE 1

VALIANT DRIVE

STA. 0+00.00 TO STA. 10+03.30

SHEET

8

OF 45 SHEETS