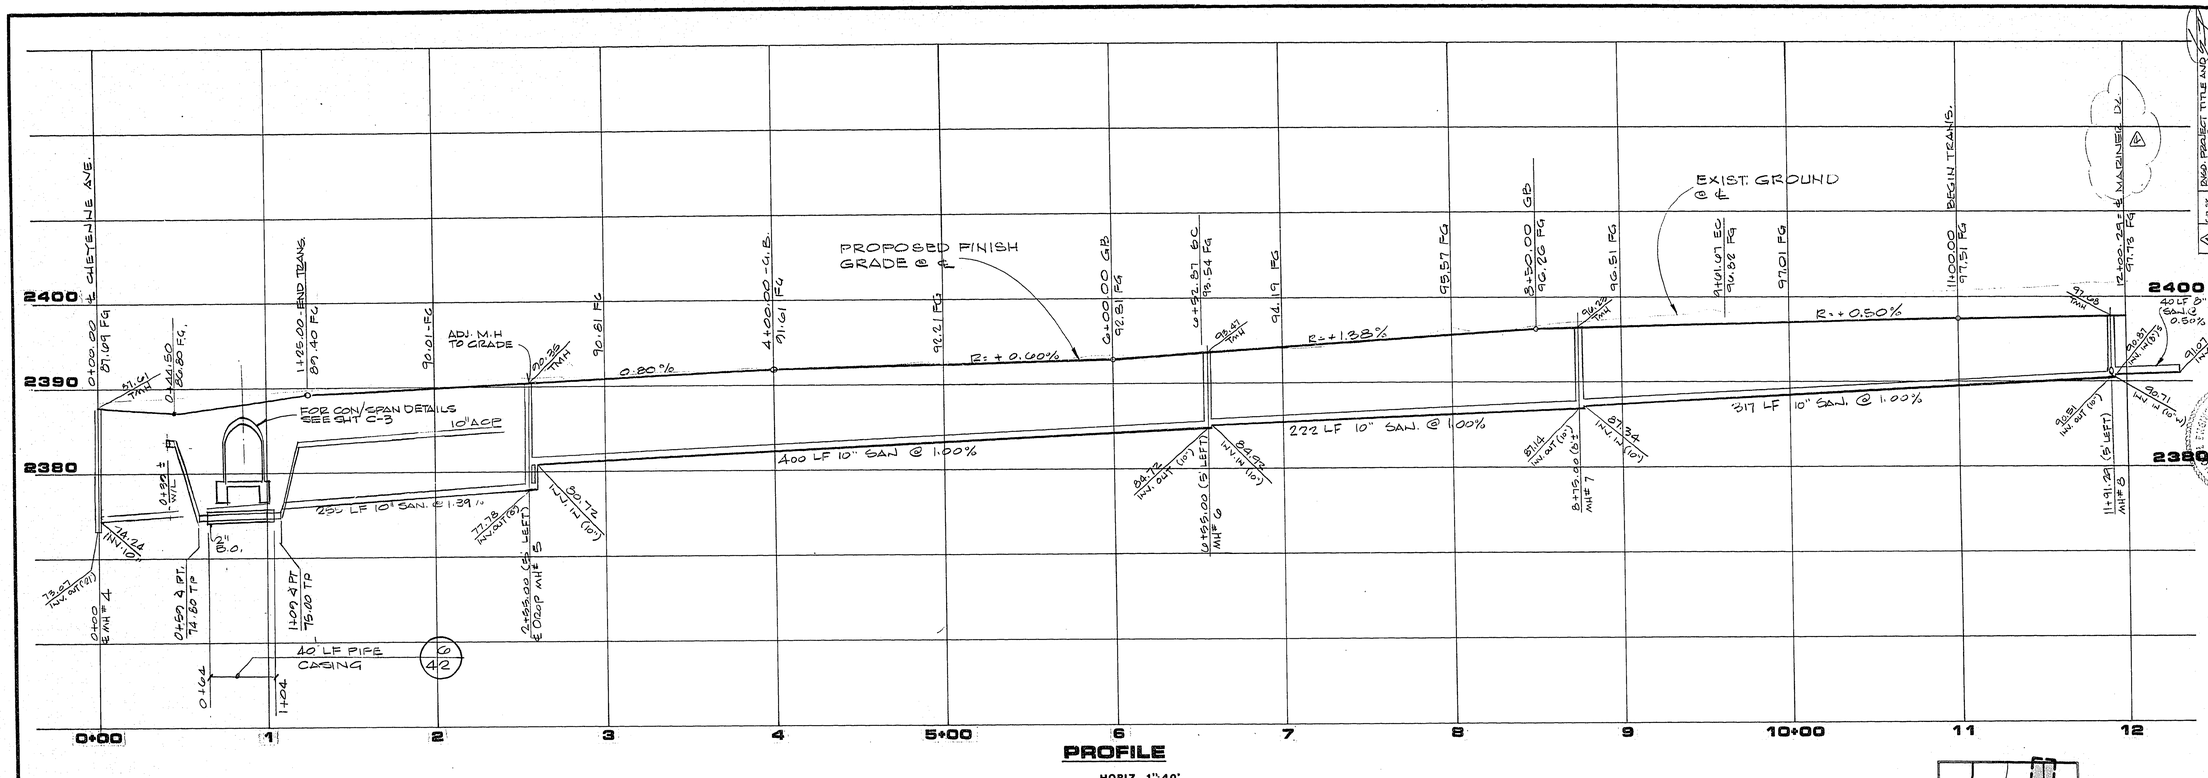

PROFILE

SCALE: HORIZ. 1"=40'
VERT. 1"=8'

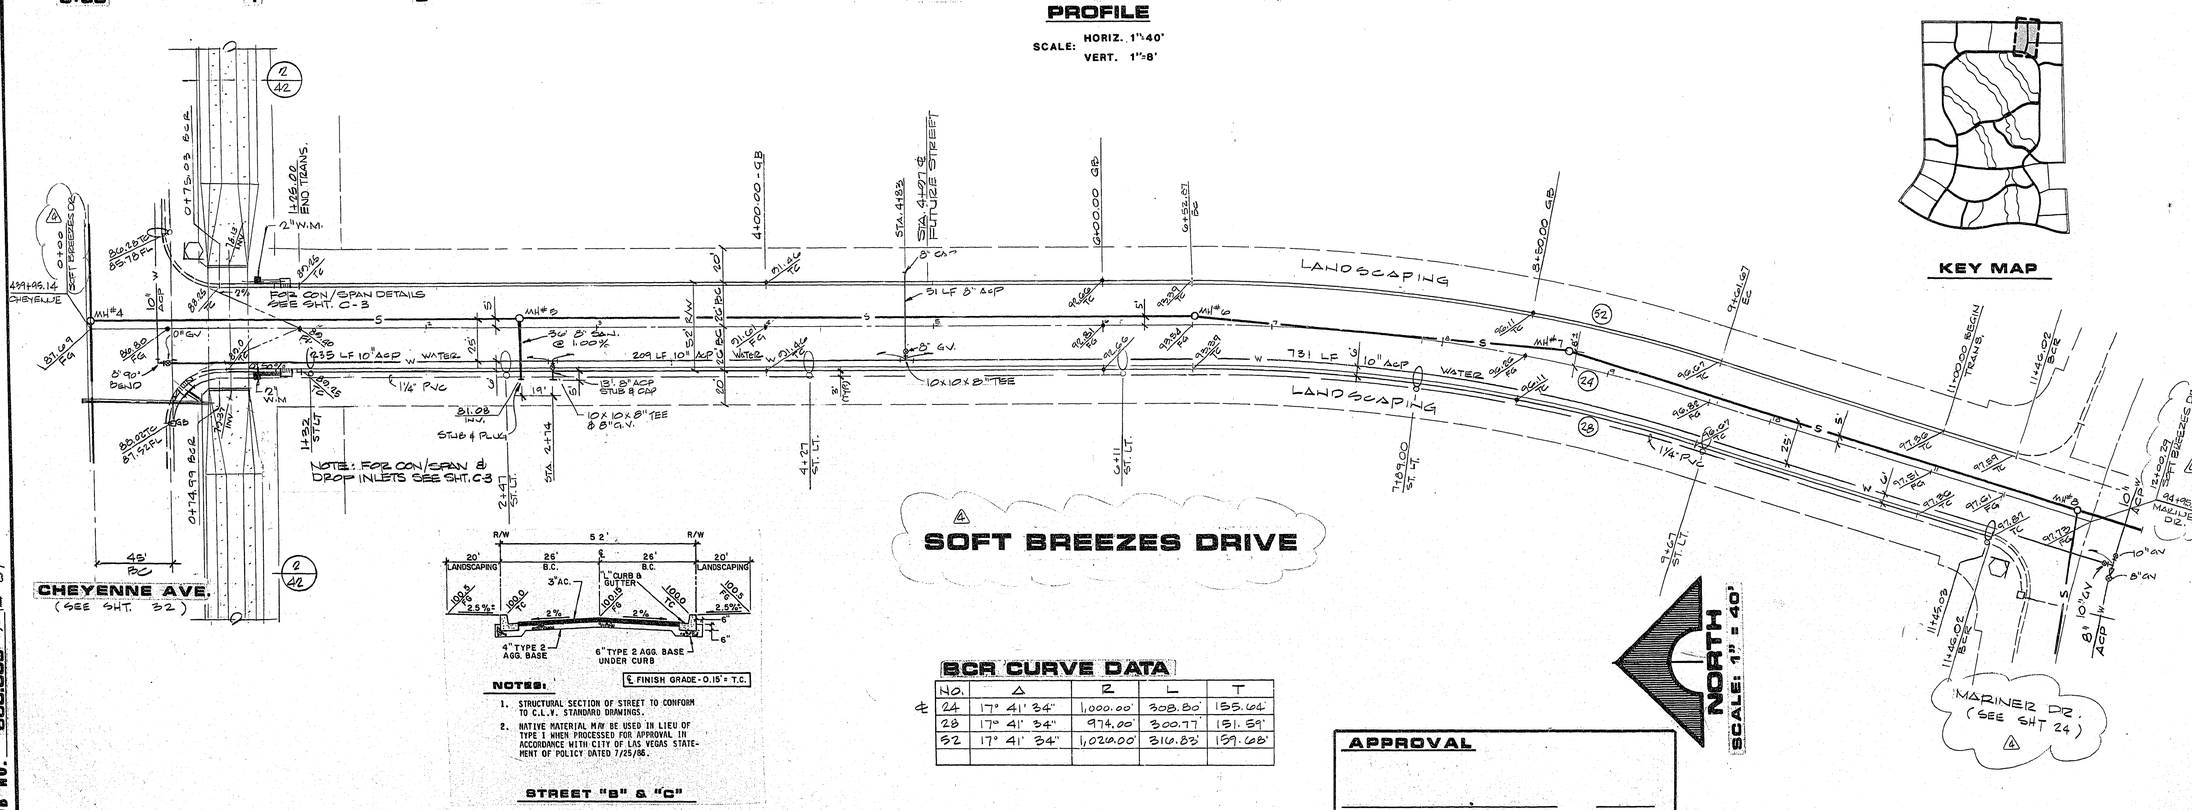

NOTES:

1. STRUCTURAL SECTION OF STREET TO CONFORM TO C.L.V. STANDARD DRAWINGS.
2. NATIVE MATERIAL M/W BE USED IN LIEU OF TYPE I WHEN PROCESSED FOR APPROVAL IN ACCORDANCE WITH CITY OF LAS VEGAS STATEMENT OF POLICY DATED 7/25/88.

STREET "B" & "C"

BCR CURVE DATA

	NO.	Δ	R	L	T
℄	24	17° 41' 34"	1,000.00'	308.80'	155.64'
	28	17° 41' 34"	974.00'	300.77'	151.59'
	52	17° 41' 34"	1,020.00'	316.83'	159.68'

APPROVAL

CLV CHIEF LAND DEVELOPMENT — DATE

REV	DATE	DESCRIPTION
1	5-9-88	DWG PROJECT TITLE AND SET-LINES
2	11/16/88	GENERAL REVISIONS
3	1/5/89	REVISED CLV. ROAD PROFILE & WIL. EL. @ CLV.
4	4-4-89	BIGG ST. SEC. NOTE & DATE
5		100 ST LT. COUNT

RECOMMENDED: 11-7-88
R.E. NO. 2842 DATE

G.C. WALLACE, INC.
Engineering/Architecture
1555 SOUTH RAINBOW BLVD./LAS VEGAS, NEVADA 89102

R A HOMES
DESERT SHORES - PHASE 1
SOFT BREEZES DRIVE
STA. 0+00.00 TO STA. 12+00.29

SHEET 9 OF 25 SHEETS

JOB NO. 660.009 9-14-87

8184 DIETERICH-POST 6532B

1074-1248-1