

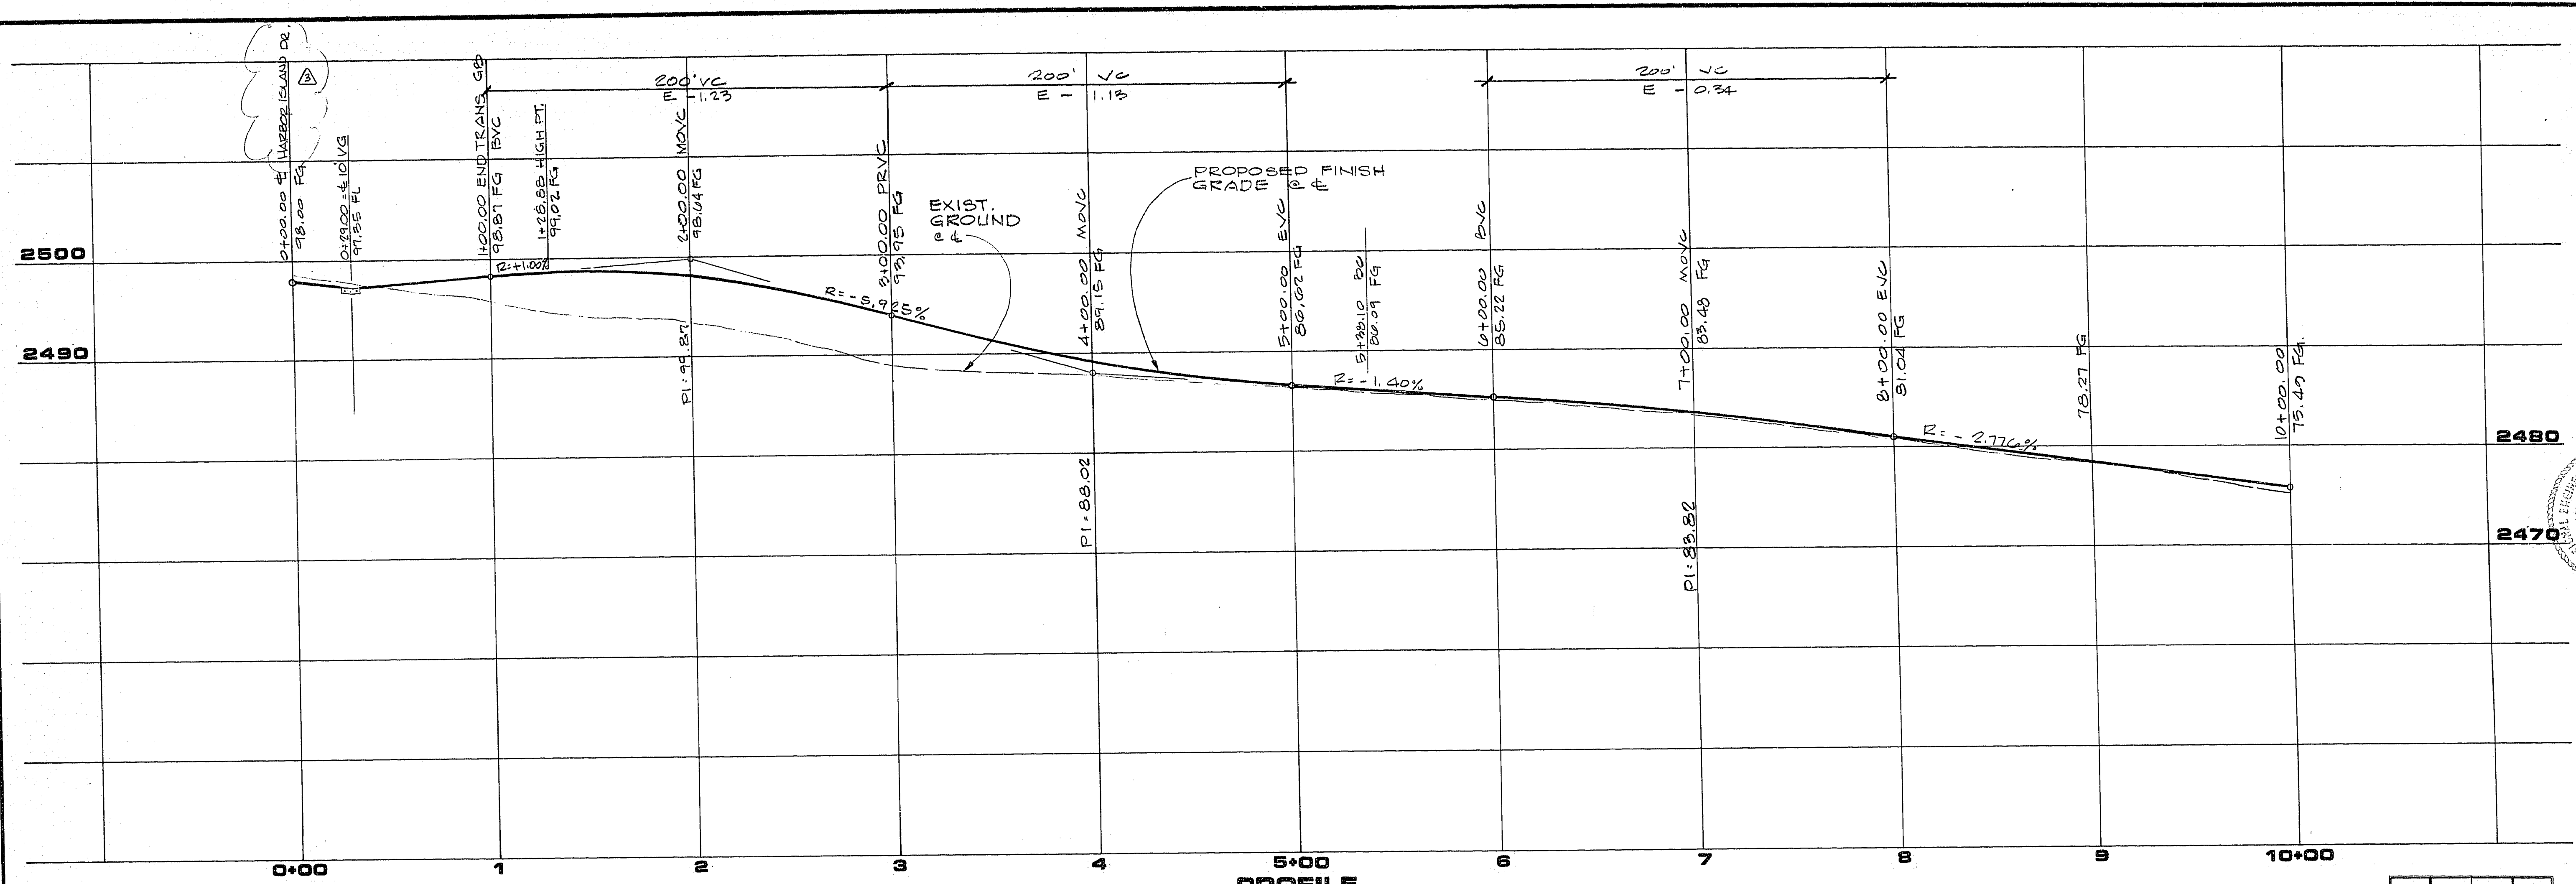
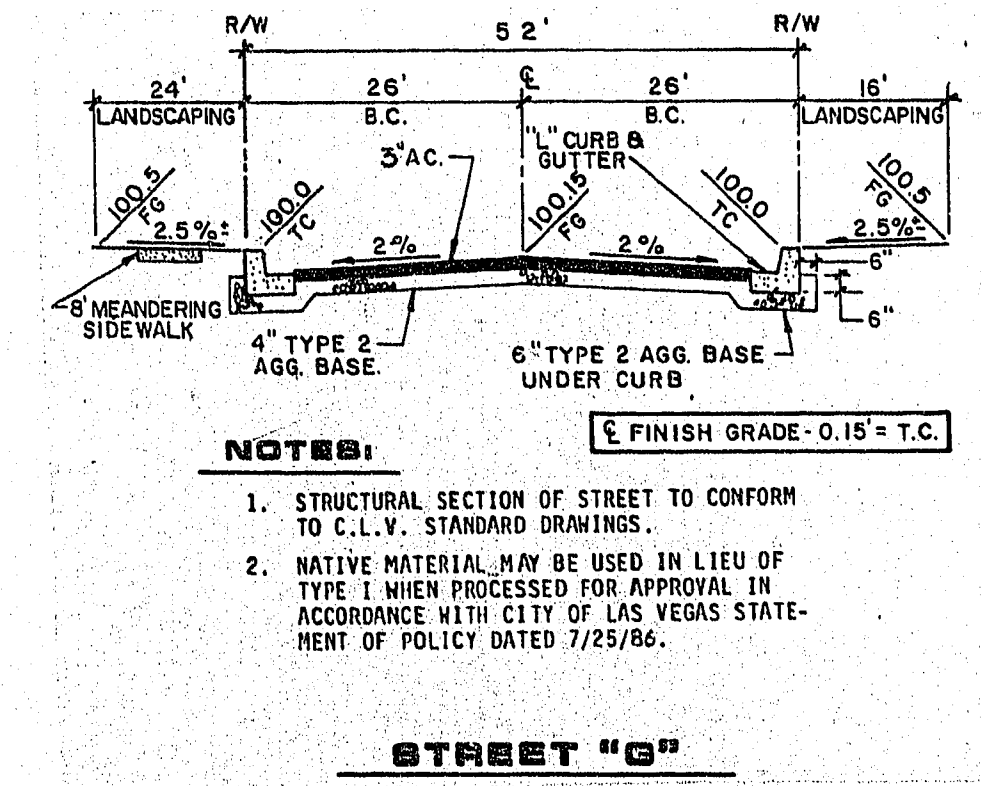


JOB NO. 660.008 2-14-87

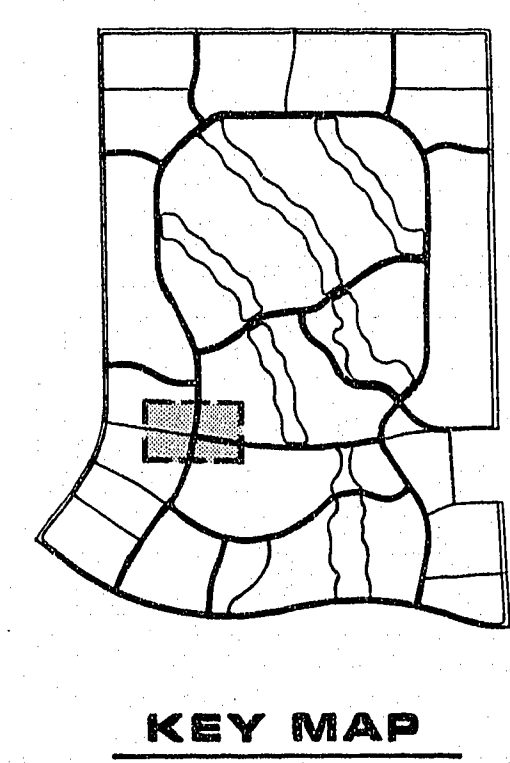


PROFILE
SCALE: HORIZ. 1"=40'
VERT. 1"=8'

NOTE
30" WATER MAIN TO BE DESIGNED
& CONSTRUCTED UNDER
SEPARATE CONTRACT, SEE
G.C. WALLACE PLANS
"2033 ZONE NORTH PIPEING PHASE II"

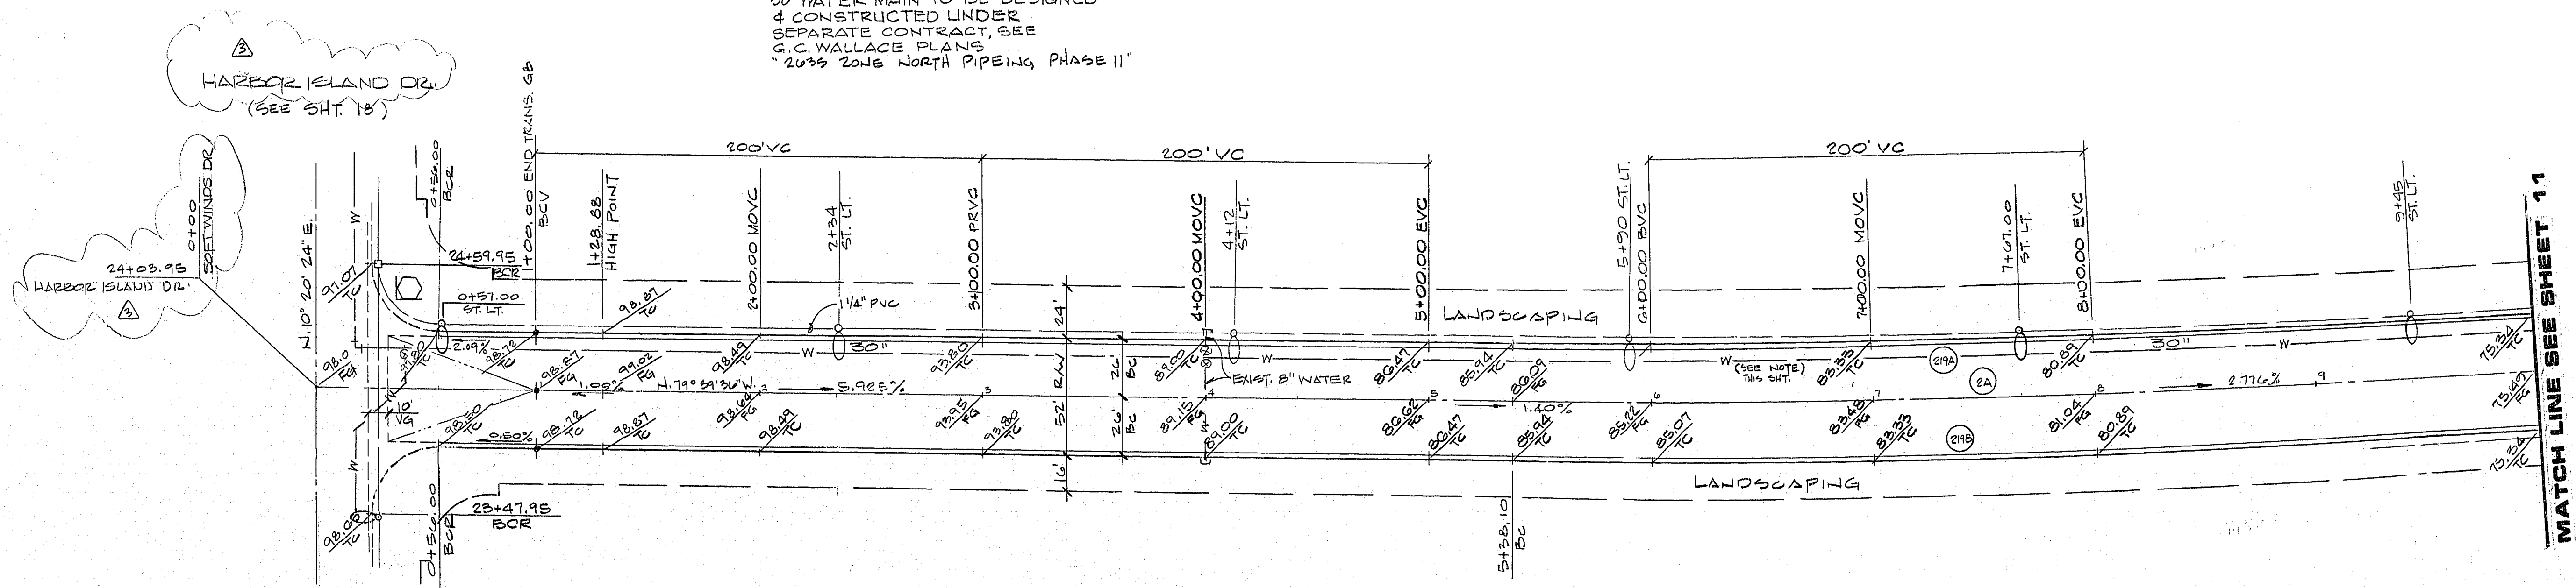

SOFT WINDS DRIVE

BCR CURVE DATA				
NO.	Δ	R	L	T
2A	20° 10' 15"	5800.00'	2041.38'	1,081.61'
21A	19° 39' 10"	5774.00'	1,980.51'	1,000.08'
21B	19° 39' 01"	5,820.00'	1,998.10'	1,008.96'

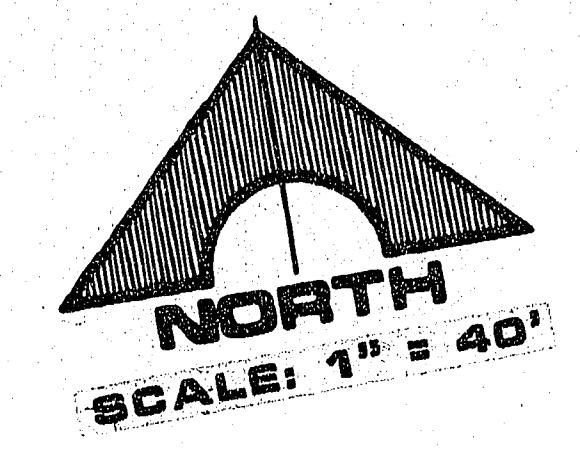

APPROVAL
CLV CHIEF LAND DEVELOPMENT
DATE

DESCRIPTION
GENERAL REVISIONS
11/5/81
4/1/88
5/1/84

DATE
1-19-88

REV. NO.
R.E. NO.

DATE
1-19-88

RECOMMENDED BY
G.C. WALLACE, INC.
Engineering/Architecture

1555 SOUTH RAINBOW BLVD. LAS VEGAS, NEVADA 8902

RA HOMES
DESERT SHORES - PHASE 1
SOFT WINDS DRIVE
STA. 0+00.00 TO STA. 10+00.00

SHEET
10
OF 45 SHEETS