


JOB NO. 660.009 0-14-87

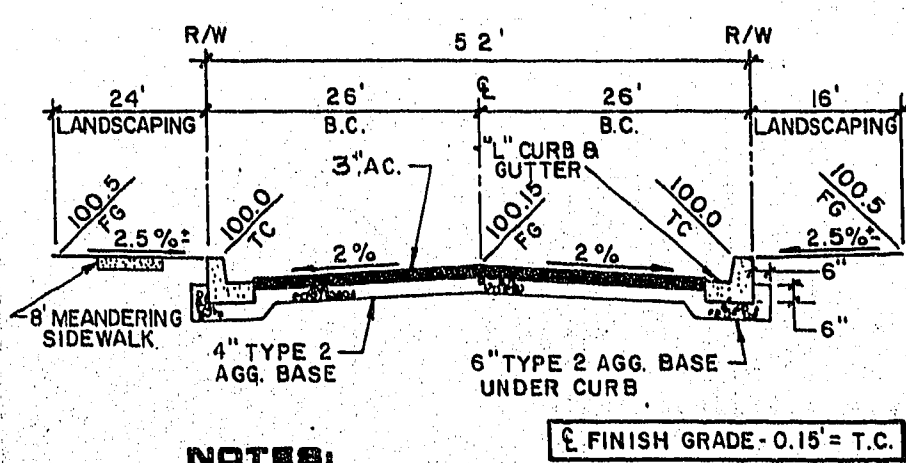


NOTES:

- STRUCTURAL SECTION OF STREET TO CONFORM TO C.I.V. STANDARD DRAWINGS.
- NATIVE MATERIAL MAY BE USED IN LIEU OF TYPE 1 WHEN PROCESSED FOR APPROVAL IN ACCORDANCE WITH CITY OF LAS VEGAS STATEMENT OF POLICY DATED 7/25/86.

STREET "G"

6/84 DIETERICH-POST 65328

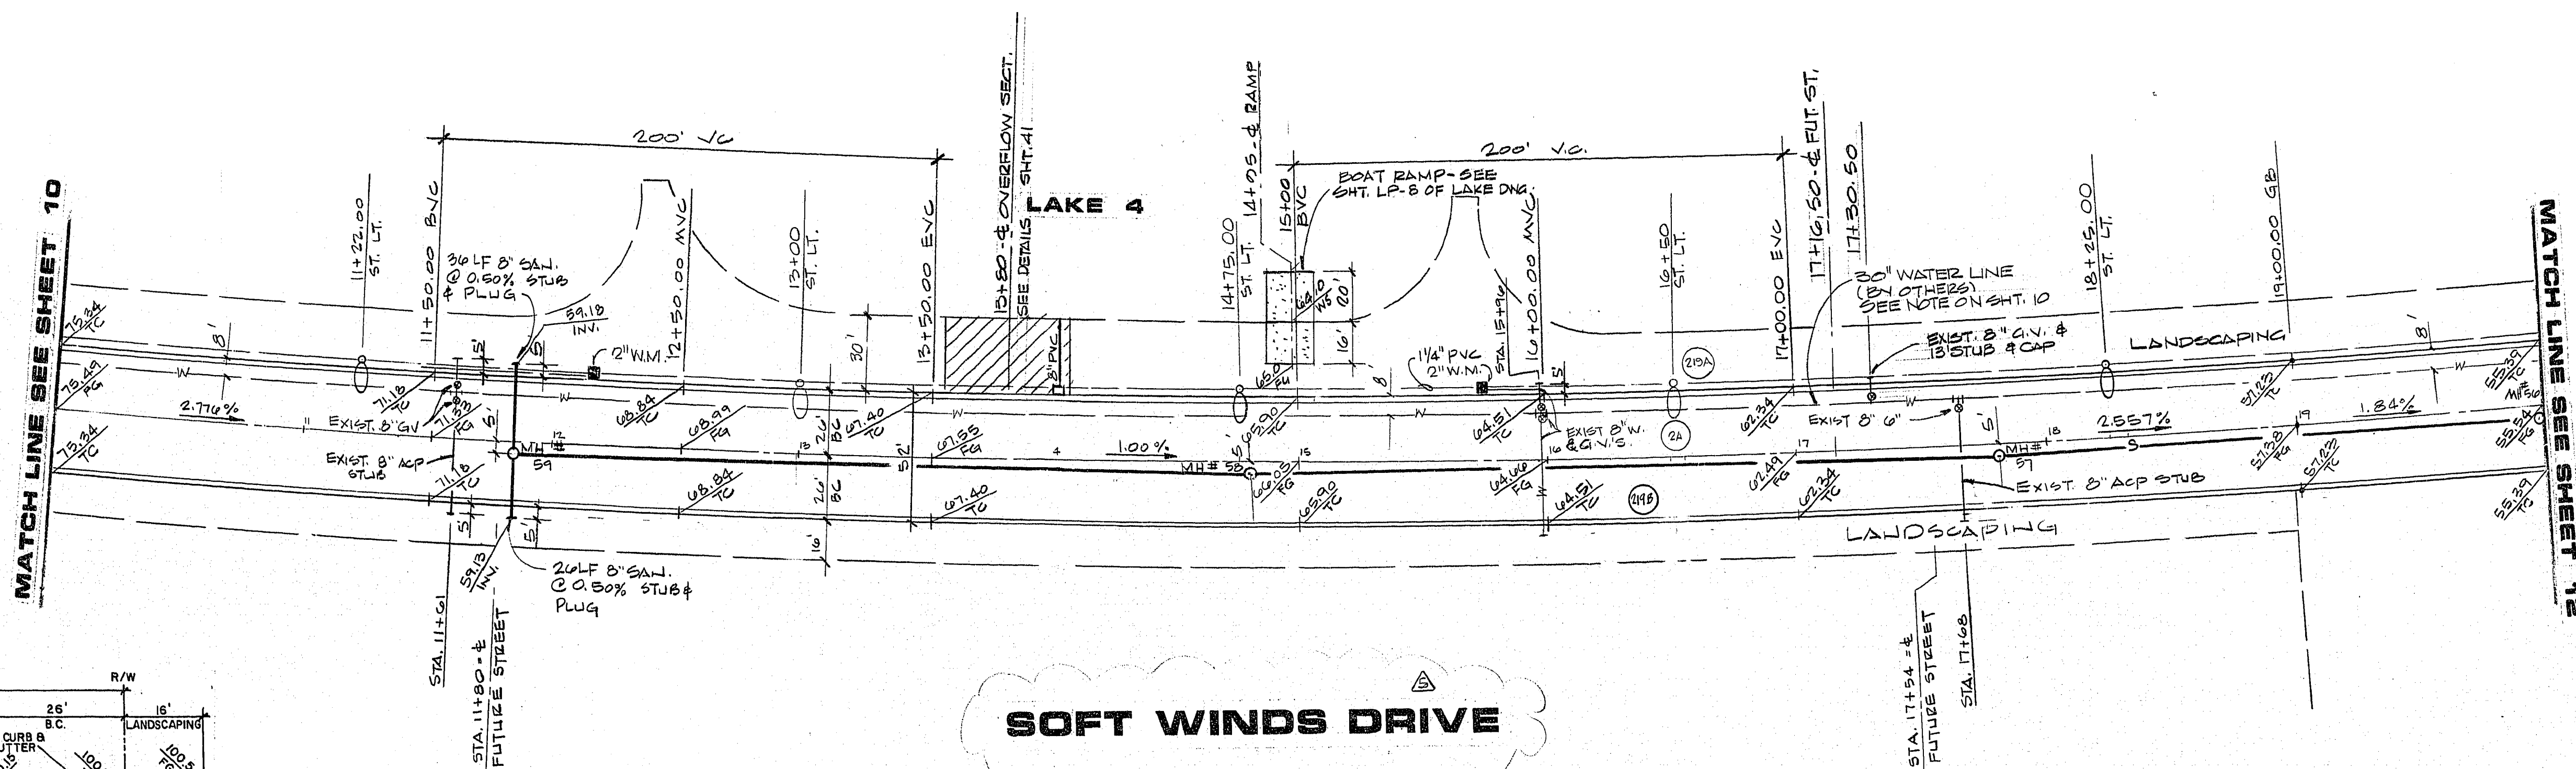


SOFT WINDS DRIVE

BCR CURVE DATA

NO.	Δ	R	L	T
2A	20° 10' 15"	5800.00	2041.88	1031.61

NOTE:

SANITARY SEWER PIPE TO BE PVC

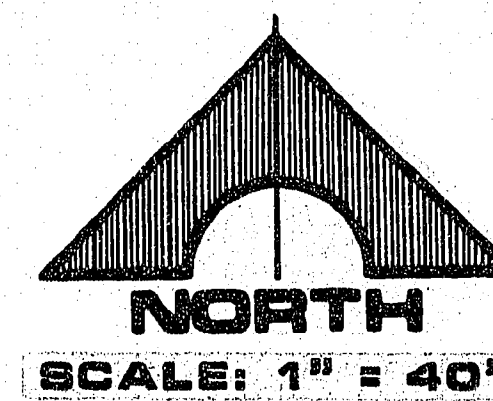

APPROVAL


CLV CHIEF LAND DEVELOPMENT

DATE

SHEET 11

OF 43 SHEETS

107Y-1248-1

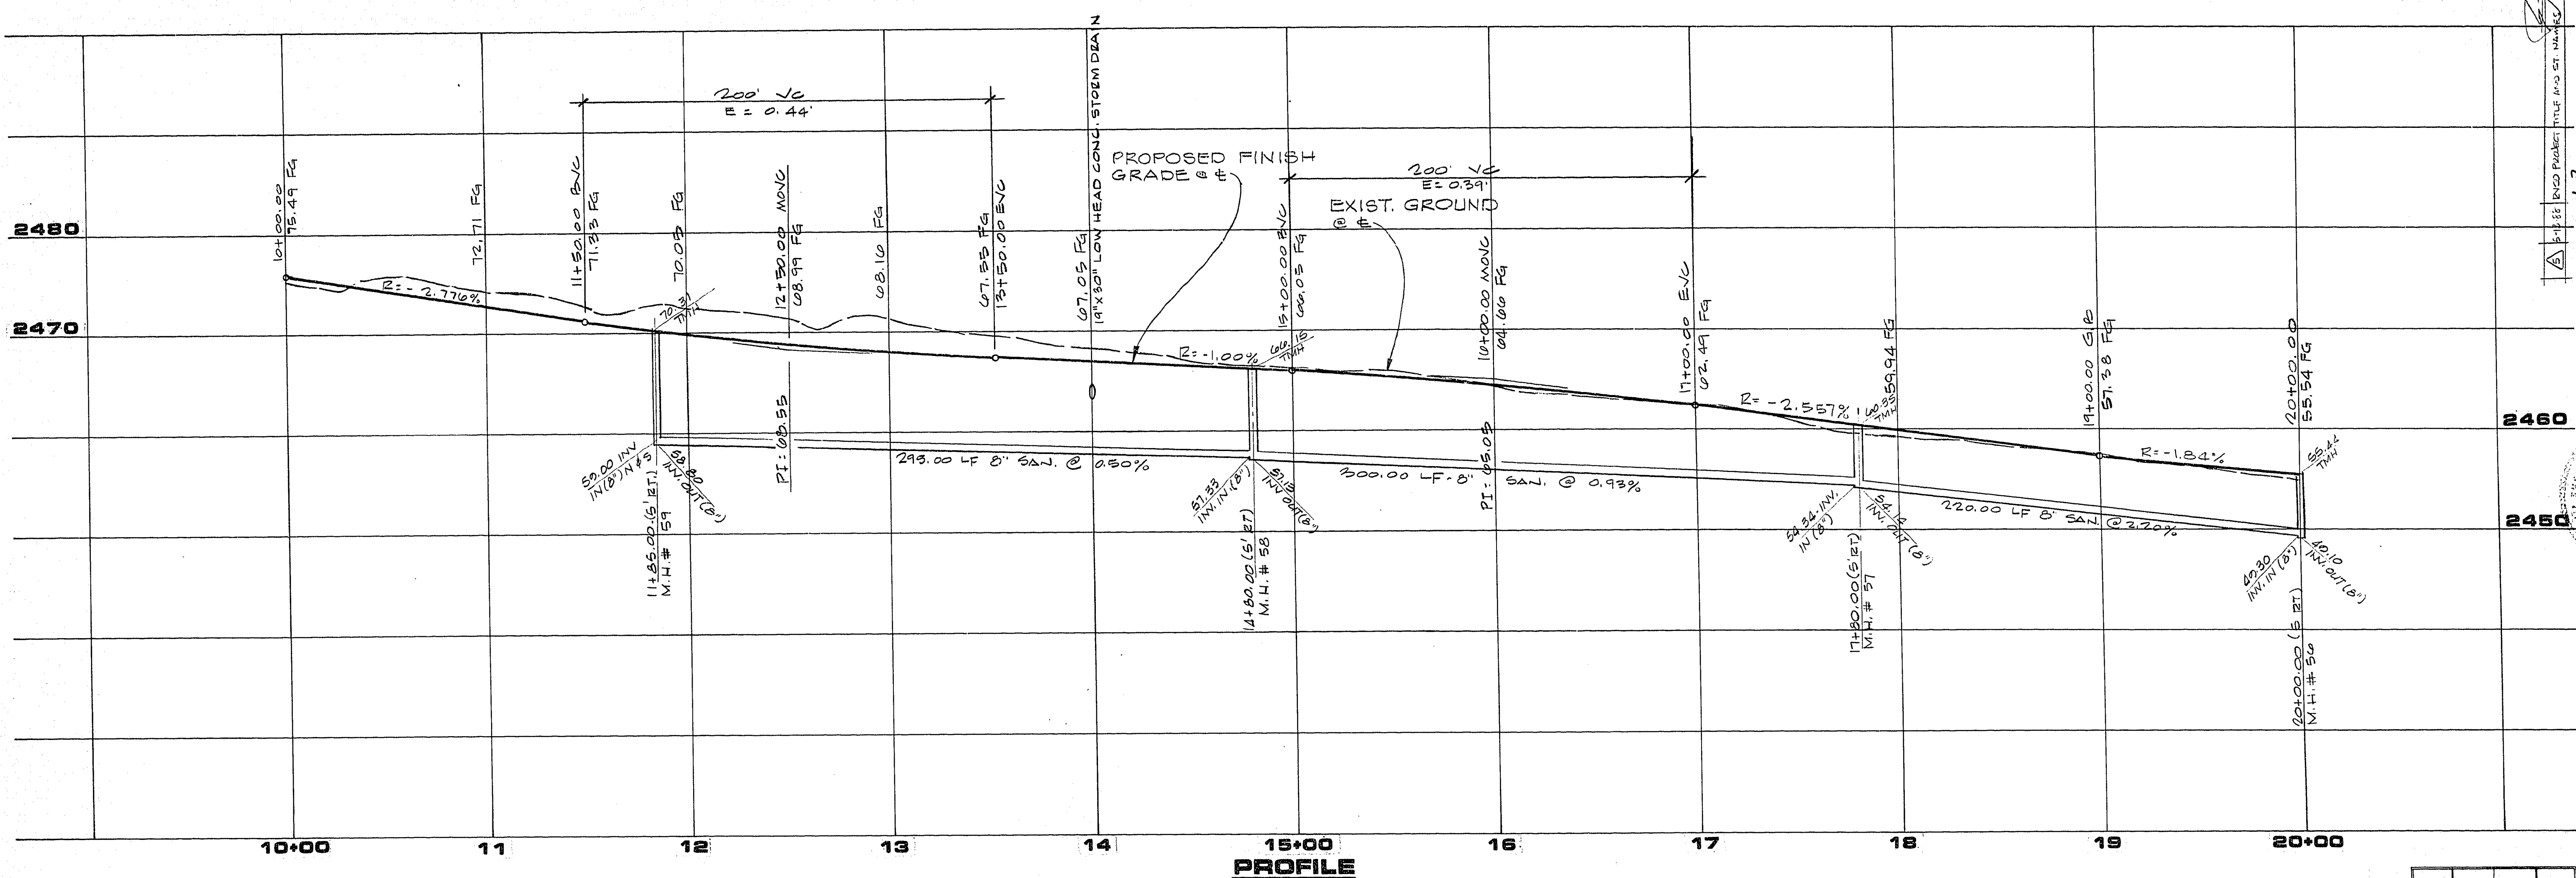

PROFILE

SCALE: HORIZ. 1"=40'
VERT. 1"=8'

REV	DATE	DESCRIPTION
1	11/15/87	GENERAL REVISIONS
2	11/15/87	ADDED 8" OUTLET TO STA. 11+30.00
3	11/15/87	DELETED 8" OUTLET TO STA. 11+30.00

RECOMMENDED
DATE
11/15/87
BY
G.C. WALLACE, INC.
ENGINEERING/ARCHITECTURE
155 SOUTH RAINBOW BLVD., LAS VEGAS, NEVADA 89102

G.C. WALLACE, INC.
Engineering/Architecture

DESERT SHORES - PHASE 1
SOFT WINDS DRIVE
STA. 10+00.00 TO STA. 20+00.00

SHEET 11

OF 43 SHEETS

107Y-1248-1