




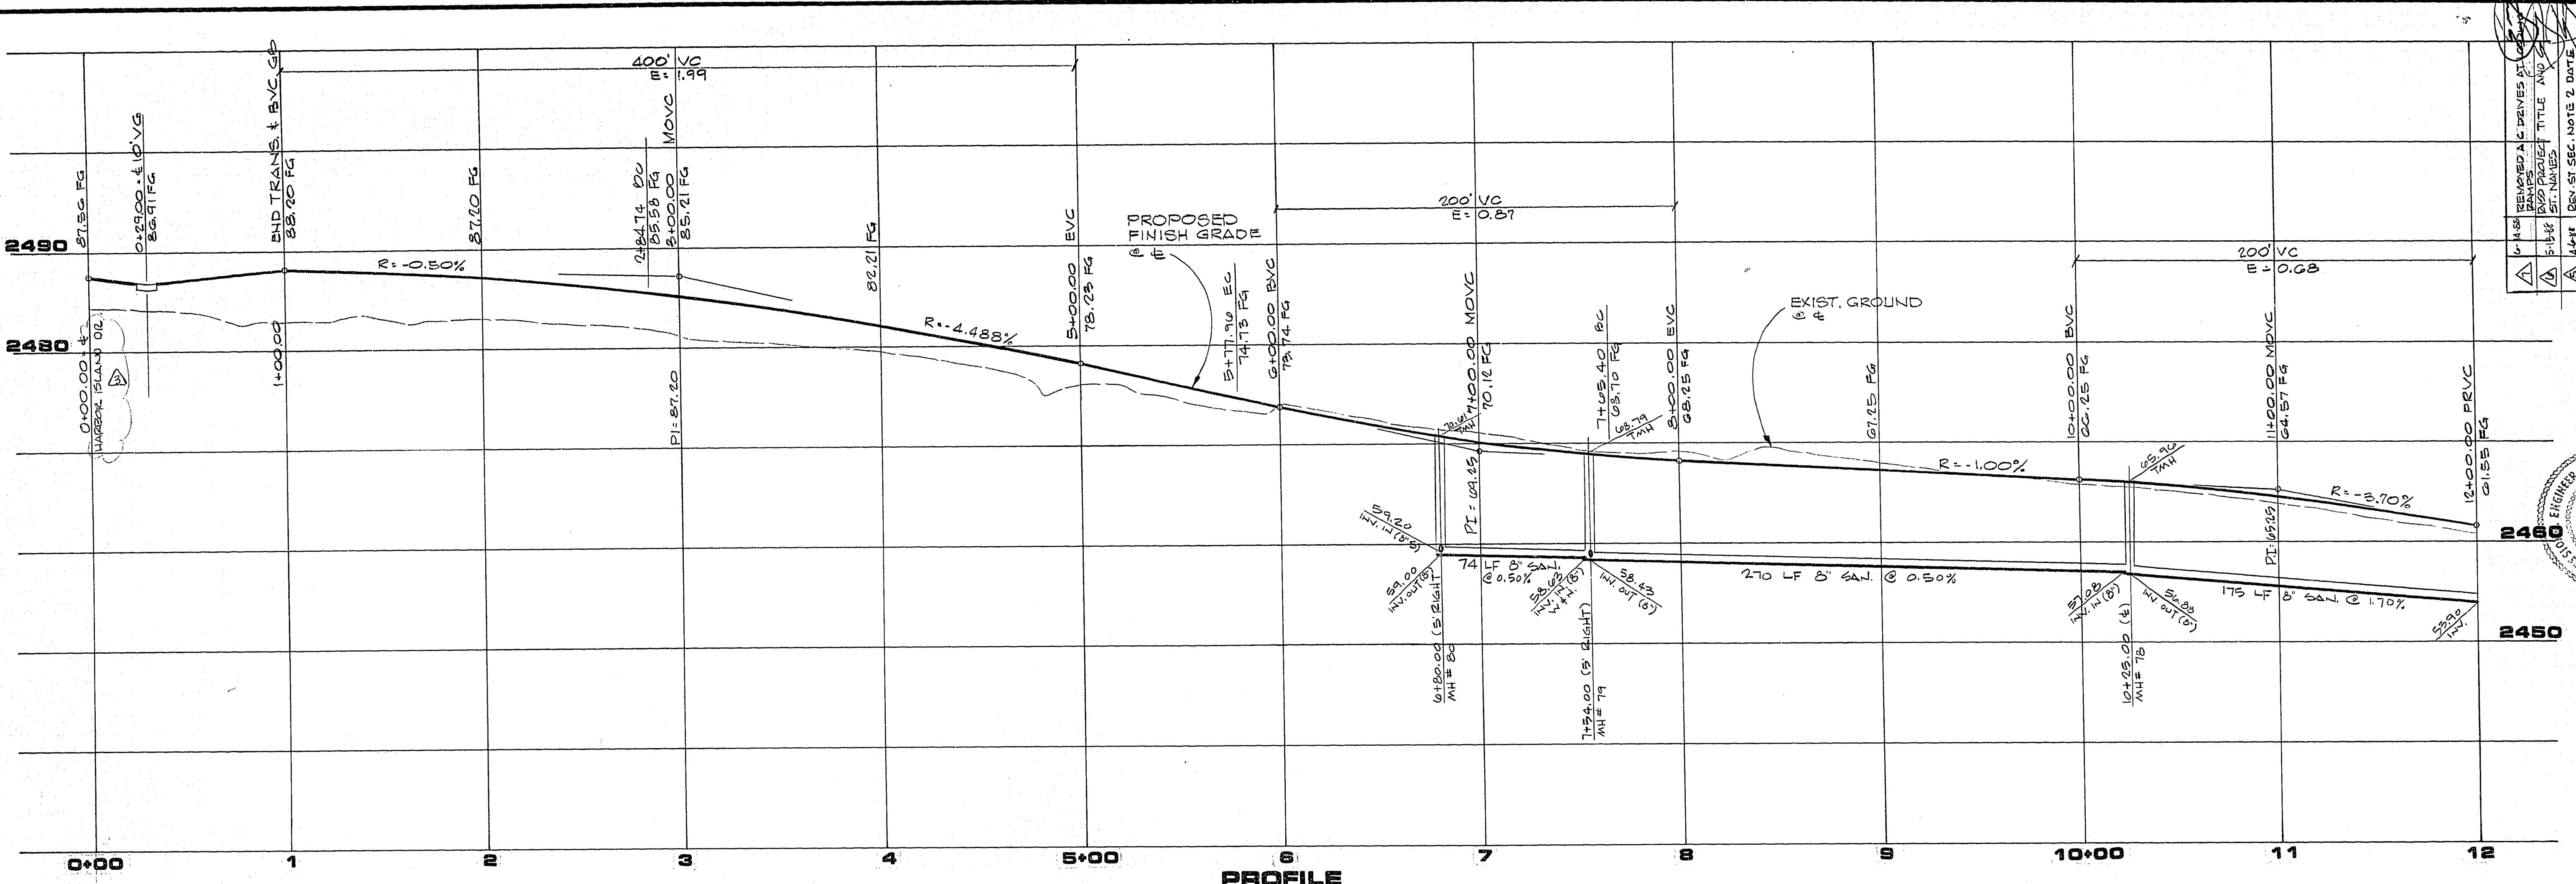

PROFILE
SCALE: HORIZ. 1"=40'
VERT. 1"=8'

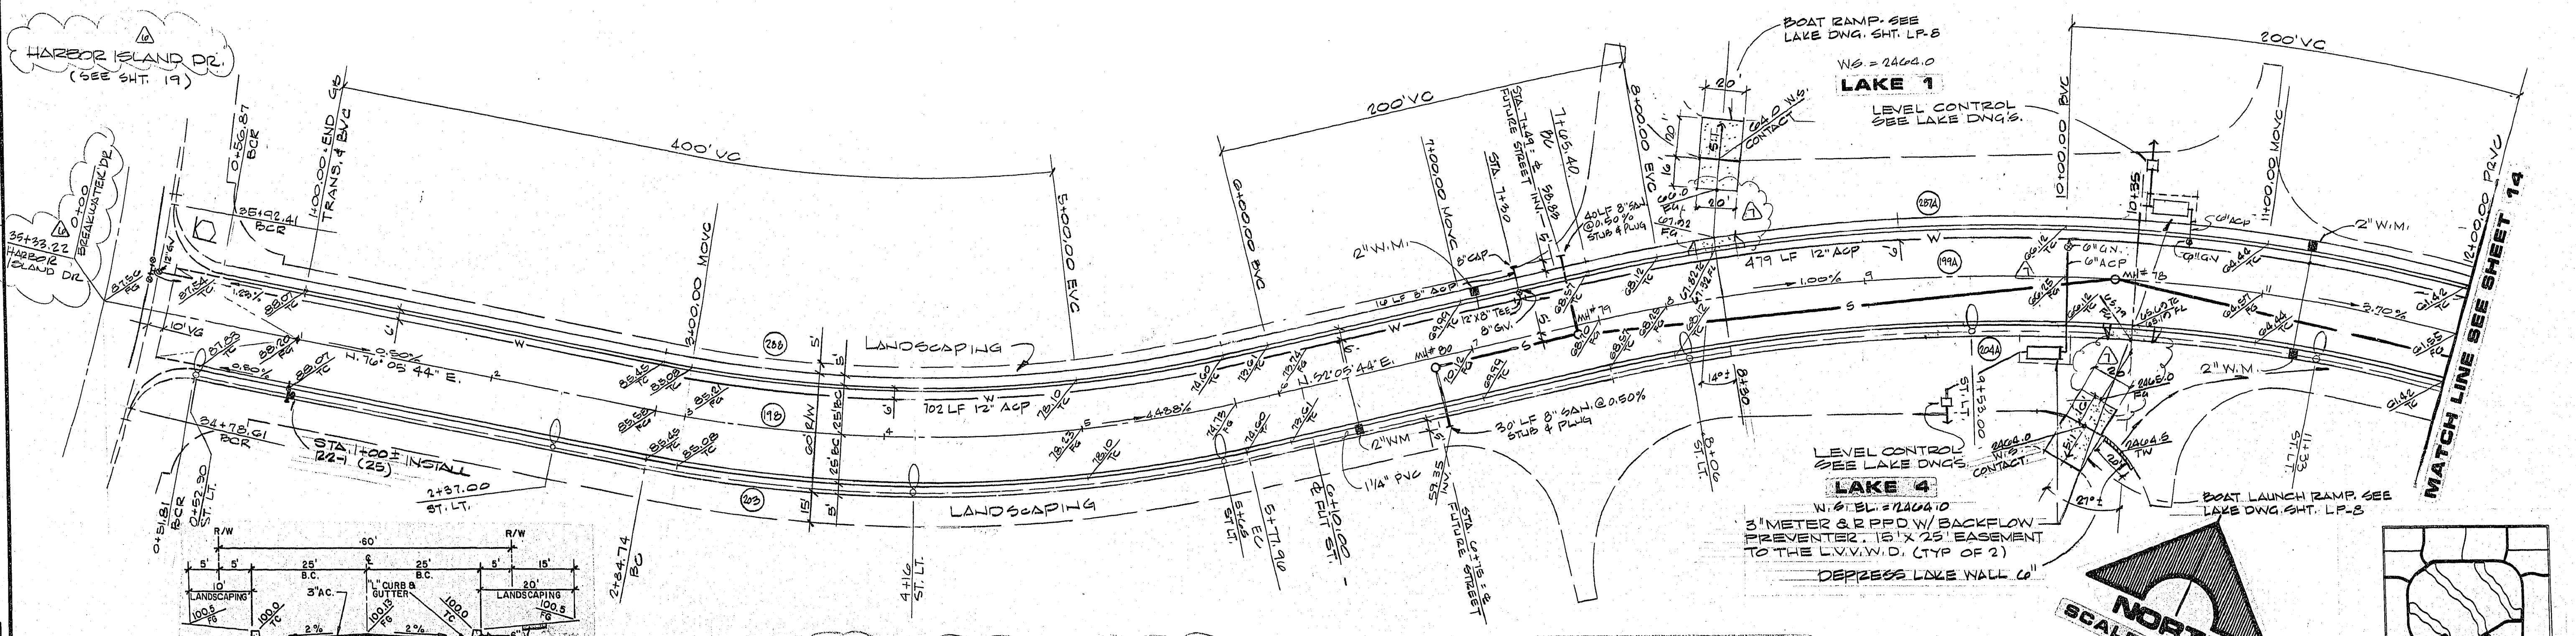

BREAKWATER DRIVE

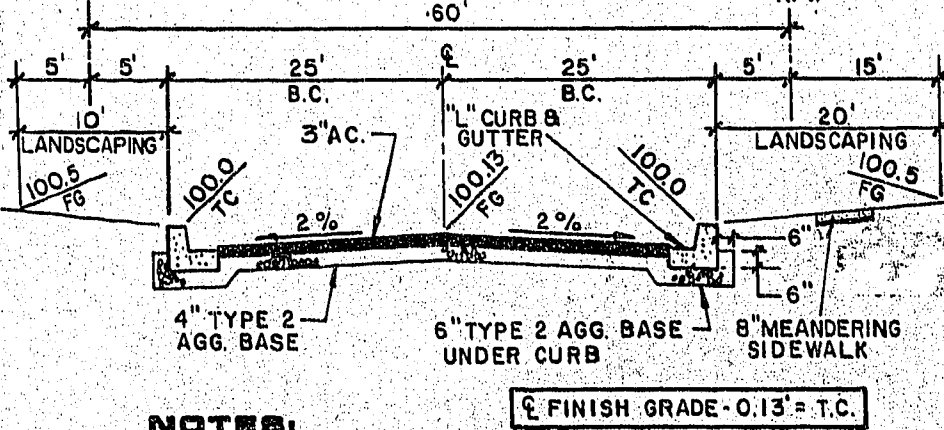


- NOTES:**
- STRUCTURAL SECTION OF STREET TO CONFORM TO C.L.V. STANDARD DRAWINGS.
 - NATIVE MATERIAL MAY BE USED IN LIEU OF TYPE 1 WHEN PROCESSED FOR APPROVAL IN ACCORDANCE WITH CITY OF LAS VEGAS STATEMENT OF POLICY DATED 7/25/86.

NOTE:
SANITARY SEWER PIPE TO BE PVC

BCR CURVE DATA

NO.	Δ	R	L	T
198	24° 00' 00"	700.00'	293.22'	148.79'
199A	25° 00' 00"	900.00'	349.78'	283.71'
203	24° 00' 00"	725.00'	303.69'	154.10'
204A	25° 00' 00"	875.00'	334.51'	275.89'
207A	25° 00' 00"	925.00'	365.08'	291.05'
208	24° 00' 00"	675.00'	282.74'	143.48'

APPROVAL
CLV CHIEF LAND DEVELOPMENT
DATE

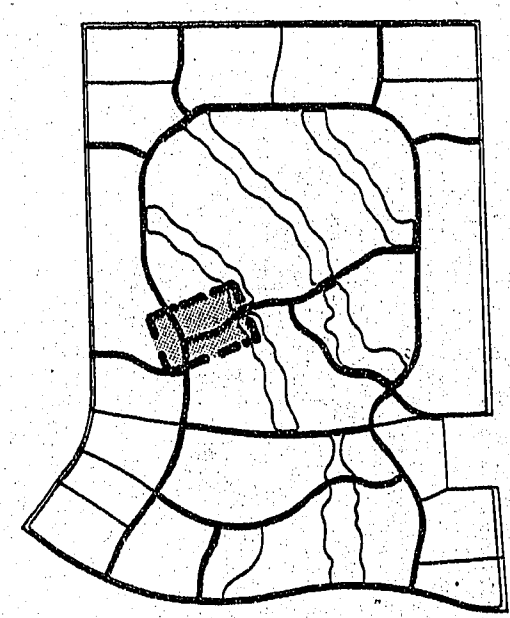

KEY MAP

REVISIONS

REV	DATE	DESCRIPTION
1	1/15/88	GENERAL REVISIONS
2	1/15/88	ADDED TRAFFIC SIGN. & DEPRESS LAKE WALL
3	1/15/88	ADDED BOAT DAMPS
4	1/15/88	PUT ST. REV. TO 6+10.00

G.C. WALLACE, INC.
Engineering/Architecture
1555 SOUTH RAINBOW BLVD. LAS VEGAS, NEVADA 89102

DESERT SHORES - PHASE 1
BREAKWATER DRIVE
STA. 0+00.00 TO STA. 12+00.00