


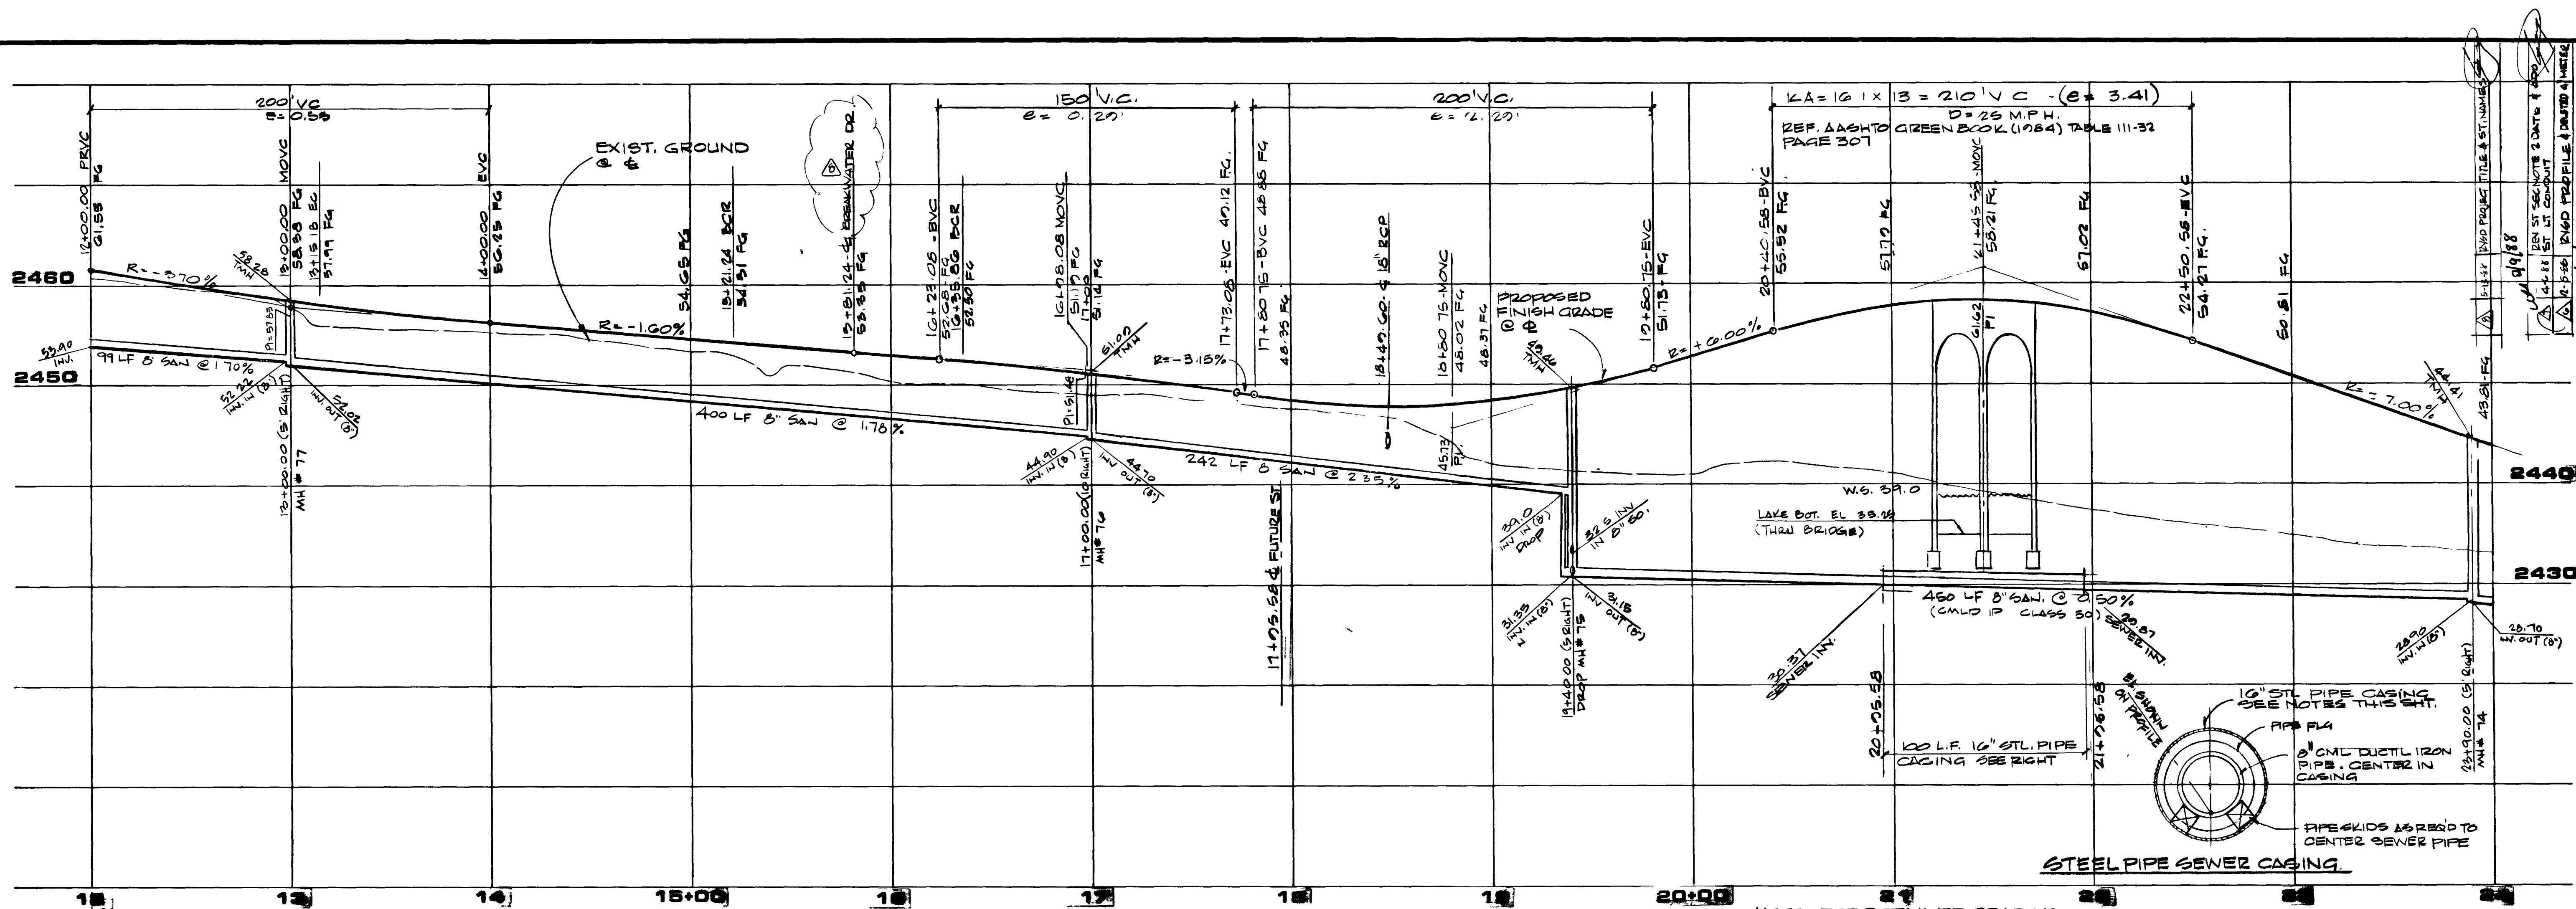

10817 1"-10"

1 SEE PLAN AND PROFILE FOR ELEVATIONS AND CASING LOCATION

2. NUMBER OF SKIPS SHALL BE IN ACCORDANCE WITH PIPE MANUFACTURER'S RECOMMENDATION.
3. STEEL PIPE CASING SHALL BE FABRICATED FROM A MINIMUM OF 1/4" THICK STEEL PLATE, CONFORMING TO THE REQUIREMENTS OF ASTM A203, GRADE B, C OR D. ALL JOINTS SHALL BE WELDED. ALL WELDING SHALL BE PERFORMED IN ACCORDANCE WITH AWWA C201. AWWA STANDARD FOR FABRICATED ELECTRICALLY WELDED STEEL WATER PIPE. COATINGS FOR STEEL CASING ARE NOT REQUIRED.
4. PIPE CASING SHALL BE LAID TRUE TO LINE AND GRADE WITH NO BENDS OR CHANGES IN GRADE FOR THE FULL LENGTH OF THE CASING.
5. PIPE SHALL BE SUPPORTED AT EACH END OF EACH JOINT WITH SKIPS.
6. CASING SHALL BE SEALED AT BOTH ENDS WITH PORTLAND OR CEMENTED BRICK.


2
THIS AREA, SEE PAGE 11-11

100

NOTES:
AT MR.

SEE LANDSCAPE DWGS.

NOTE:
- STA 24+00.23
END CURB & GUTTE
TRANSITION.

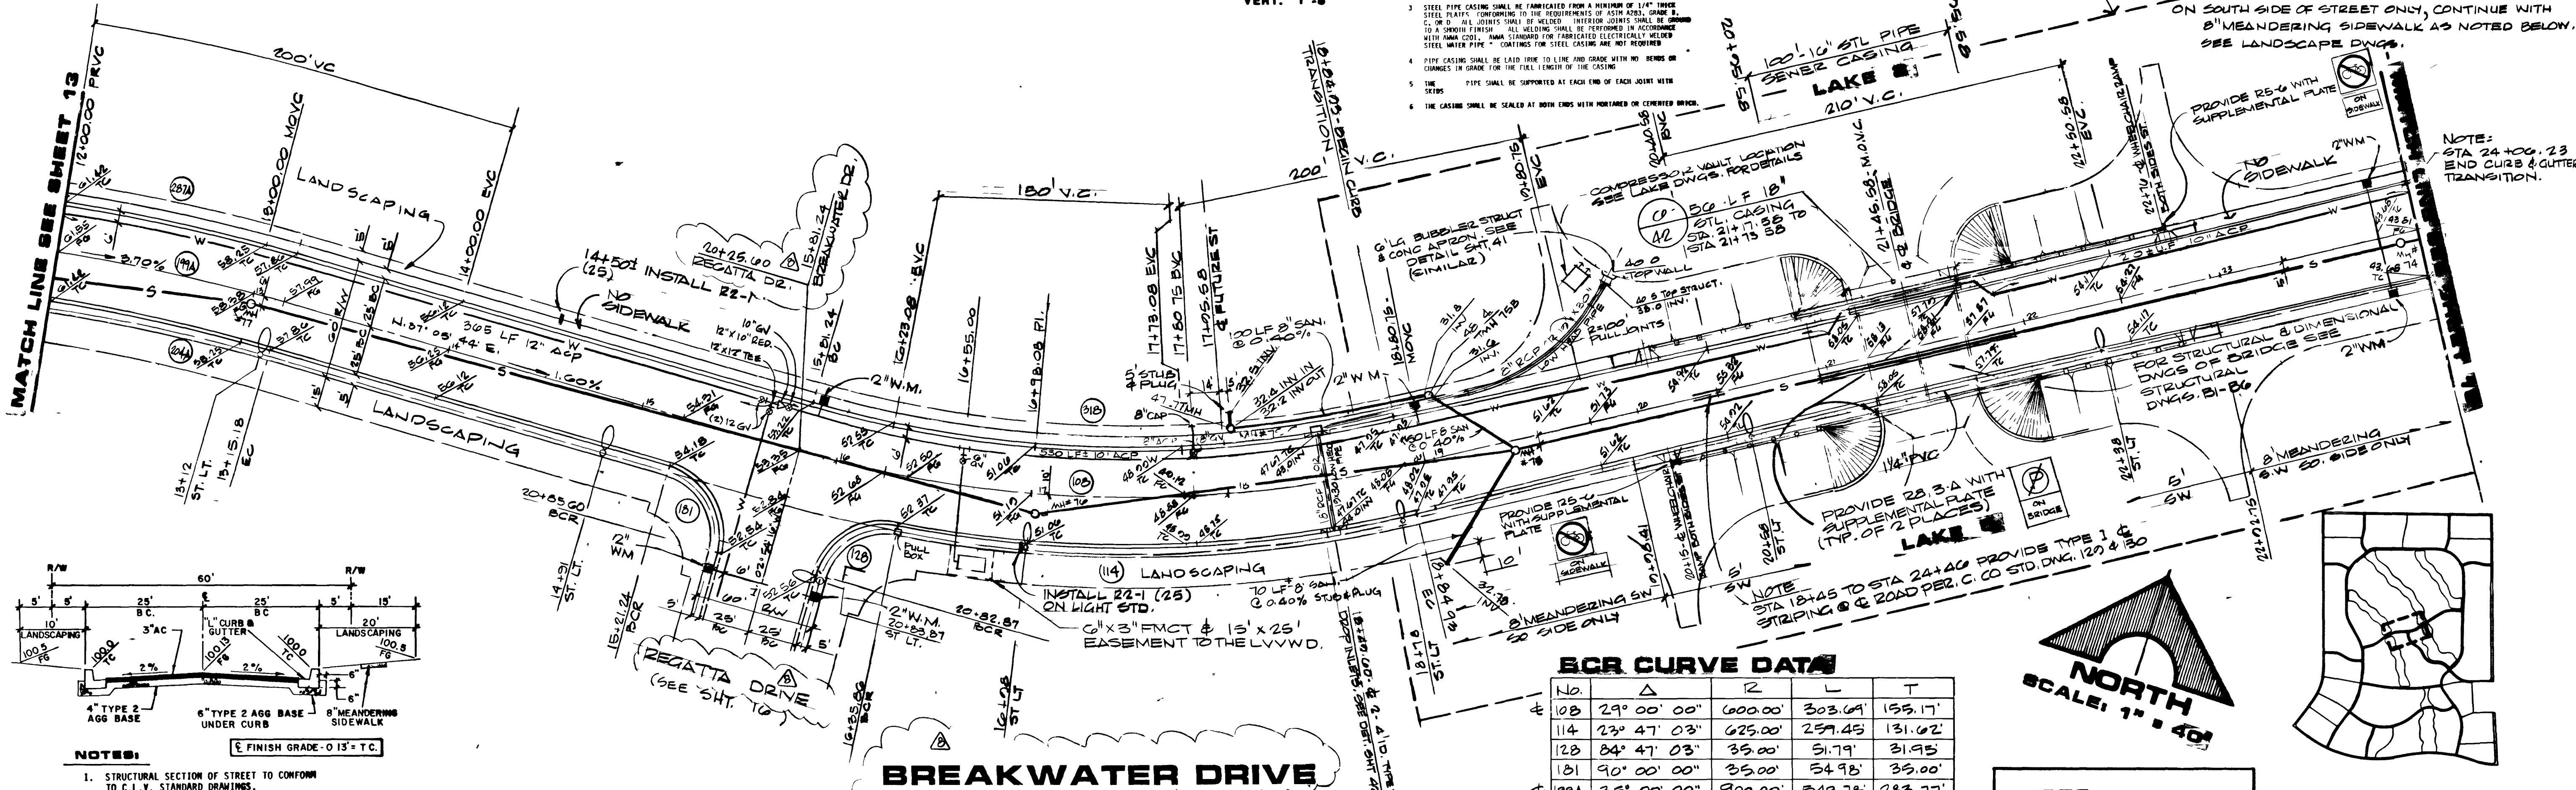

SCR CURVE DATA				
No.	Δ	I ₂	L	T
204A	3° 00' 00"	875.00	534.53	275.09
257A	3° 00' 00"	925.00	505.05	291.65
318	2° 00' 00"	575.00	291.03	148.71

NOTE:
**SANITARY SEWER
PIPE TO BE PVC**

KEY MAP


CLV CHIEF LAND DEVELOPMENT

DATE _____

STA. 18+84.1

(EXCEPT FROM STA. 18+84.03 TO STA 24+06.23



14

OF SHEETS

7Y-1248

