


108 NO. 660.009 7-14-87

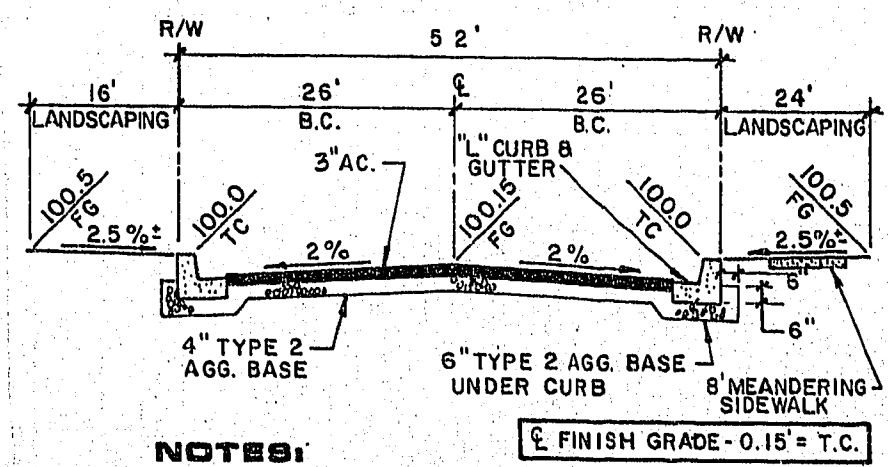


NOTES:

- STRUCTURAL SECTION OF STREET TO CONFORM TO C.I.V. STANDARD DRAWINGS.
- NATIVE MATERIAL MAY BE USED IN LIEU OF TYPE 1 WHEN PROCESSED FOR APPROVAL IN ACCORDANCE WITH CITY OF LAS VEGAS STATEMENT OF POLICY DATED 7/25/86.

LOOP ROAD

5/84 DIETRICH-POST 66328

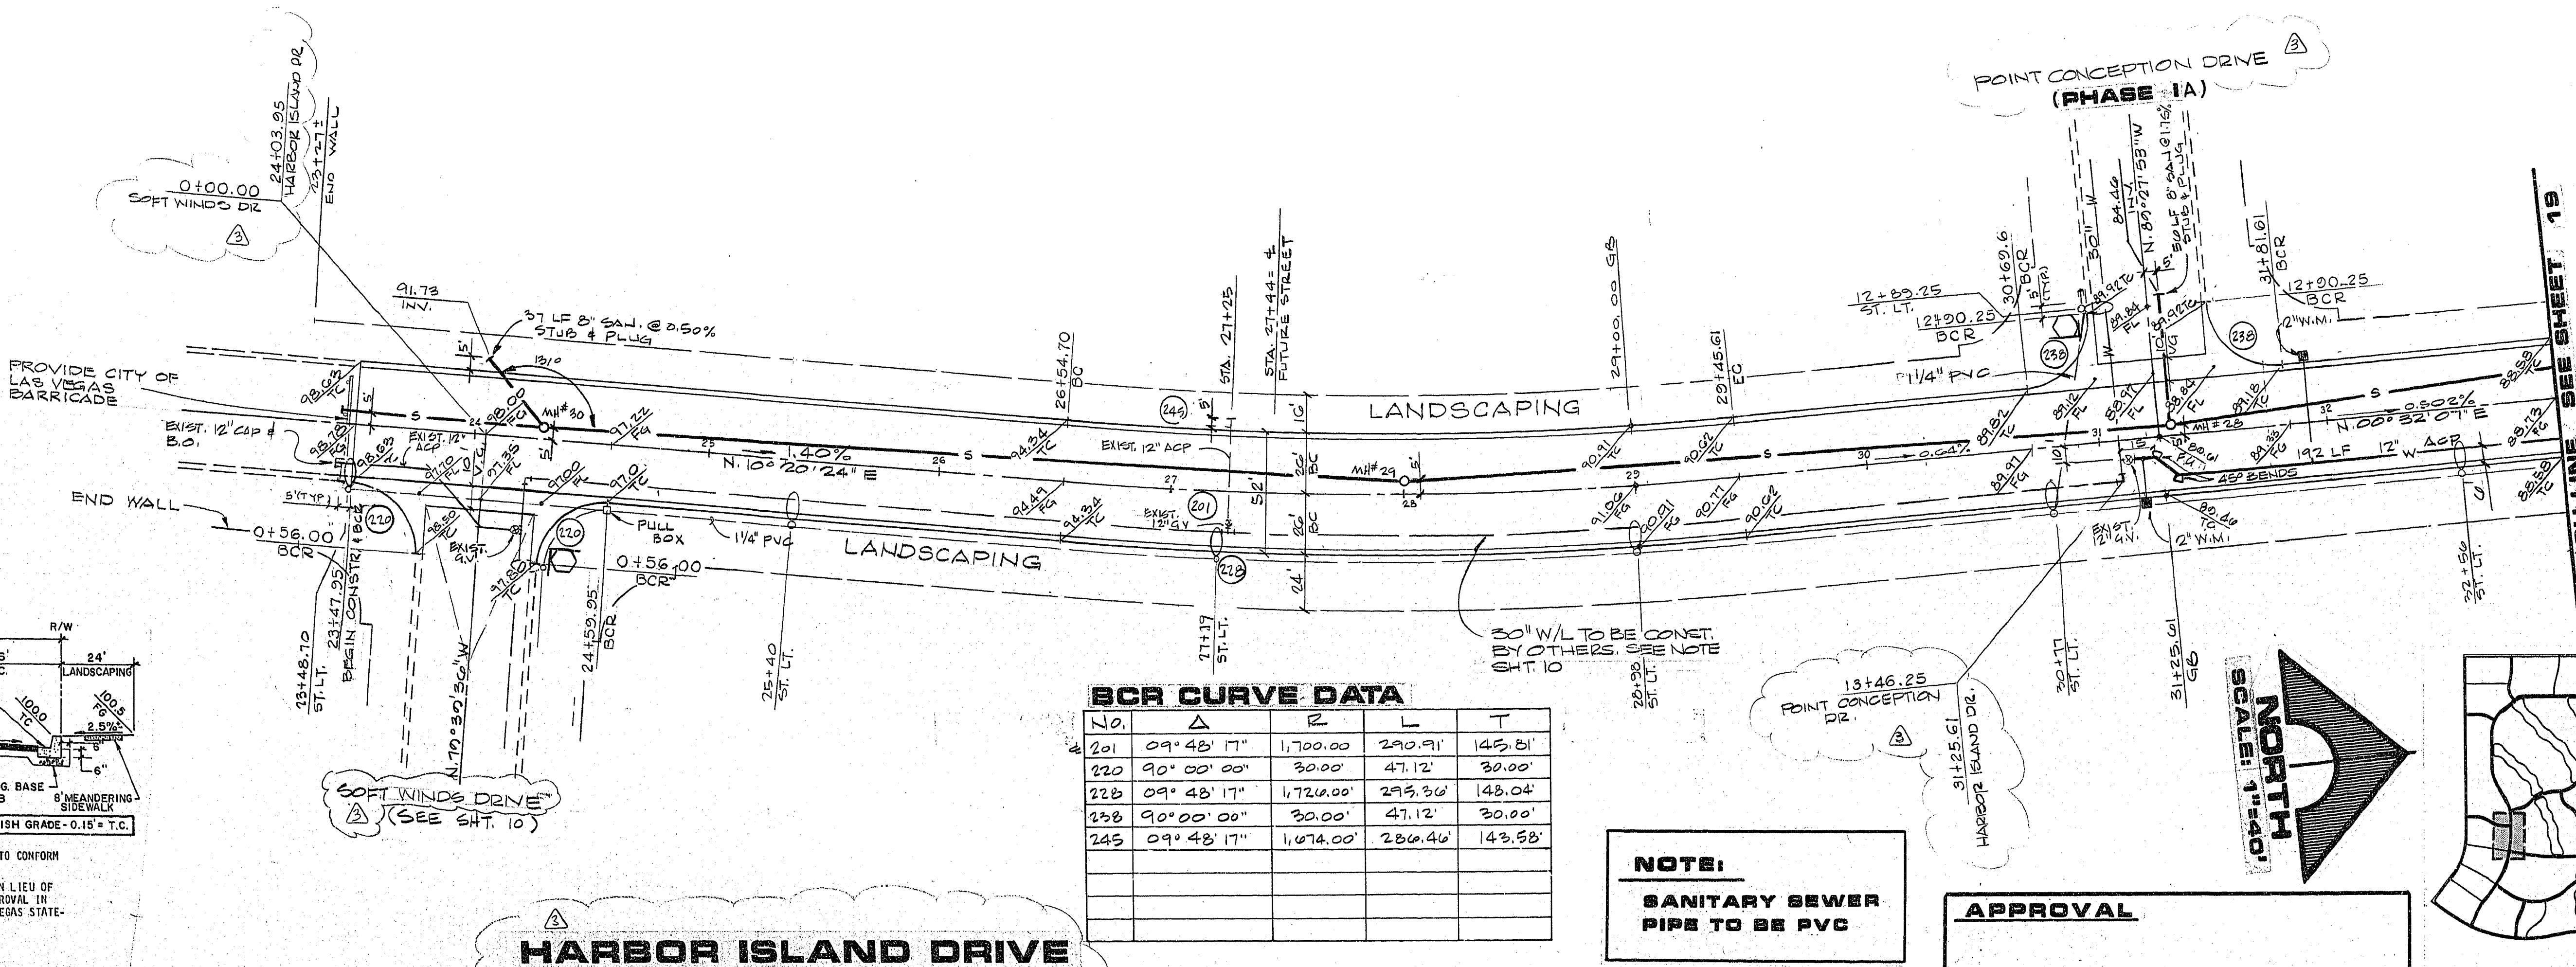

BCR CURVE DATA

NO.	Δ	R	L	T
201	09° 48' 17"	1,700.00	290.91'	145.81'
220	90° 00' 00"	30.00'	47.12'	30.00'
228	09° 48' 17"	1,720.00	295.36'	148.04'
238	90° 00' 00"	30.00'	47.12'	30.00'

NOTE:



SANITARY SEWER PIPE TO BE PVC

APPROVAL

CLV CHIEF LAND DEVELOPMENT



DATE

KEY MAP

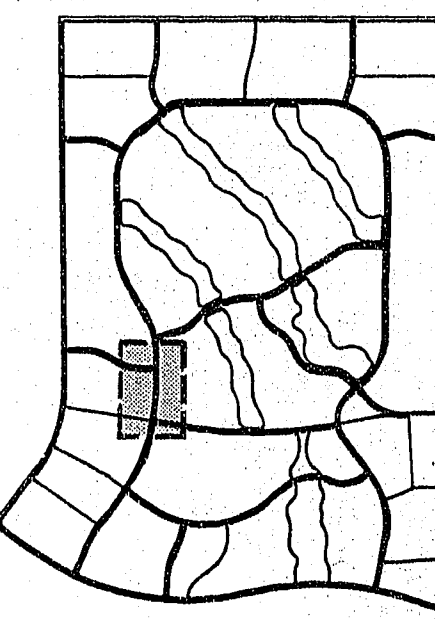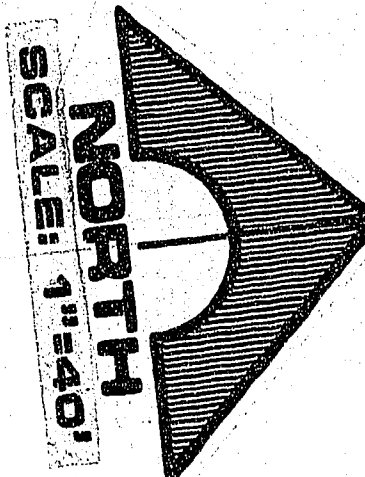

PROFILE

SCALE: HORIZ. 1"=40'
VERT. 1"=8'

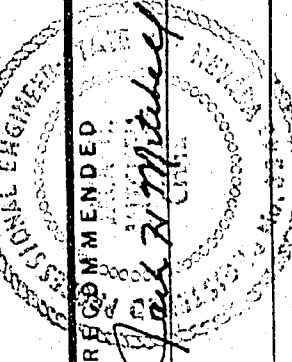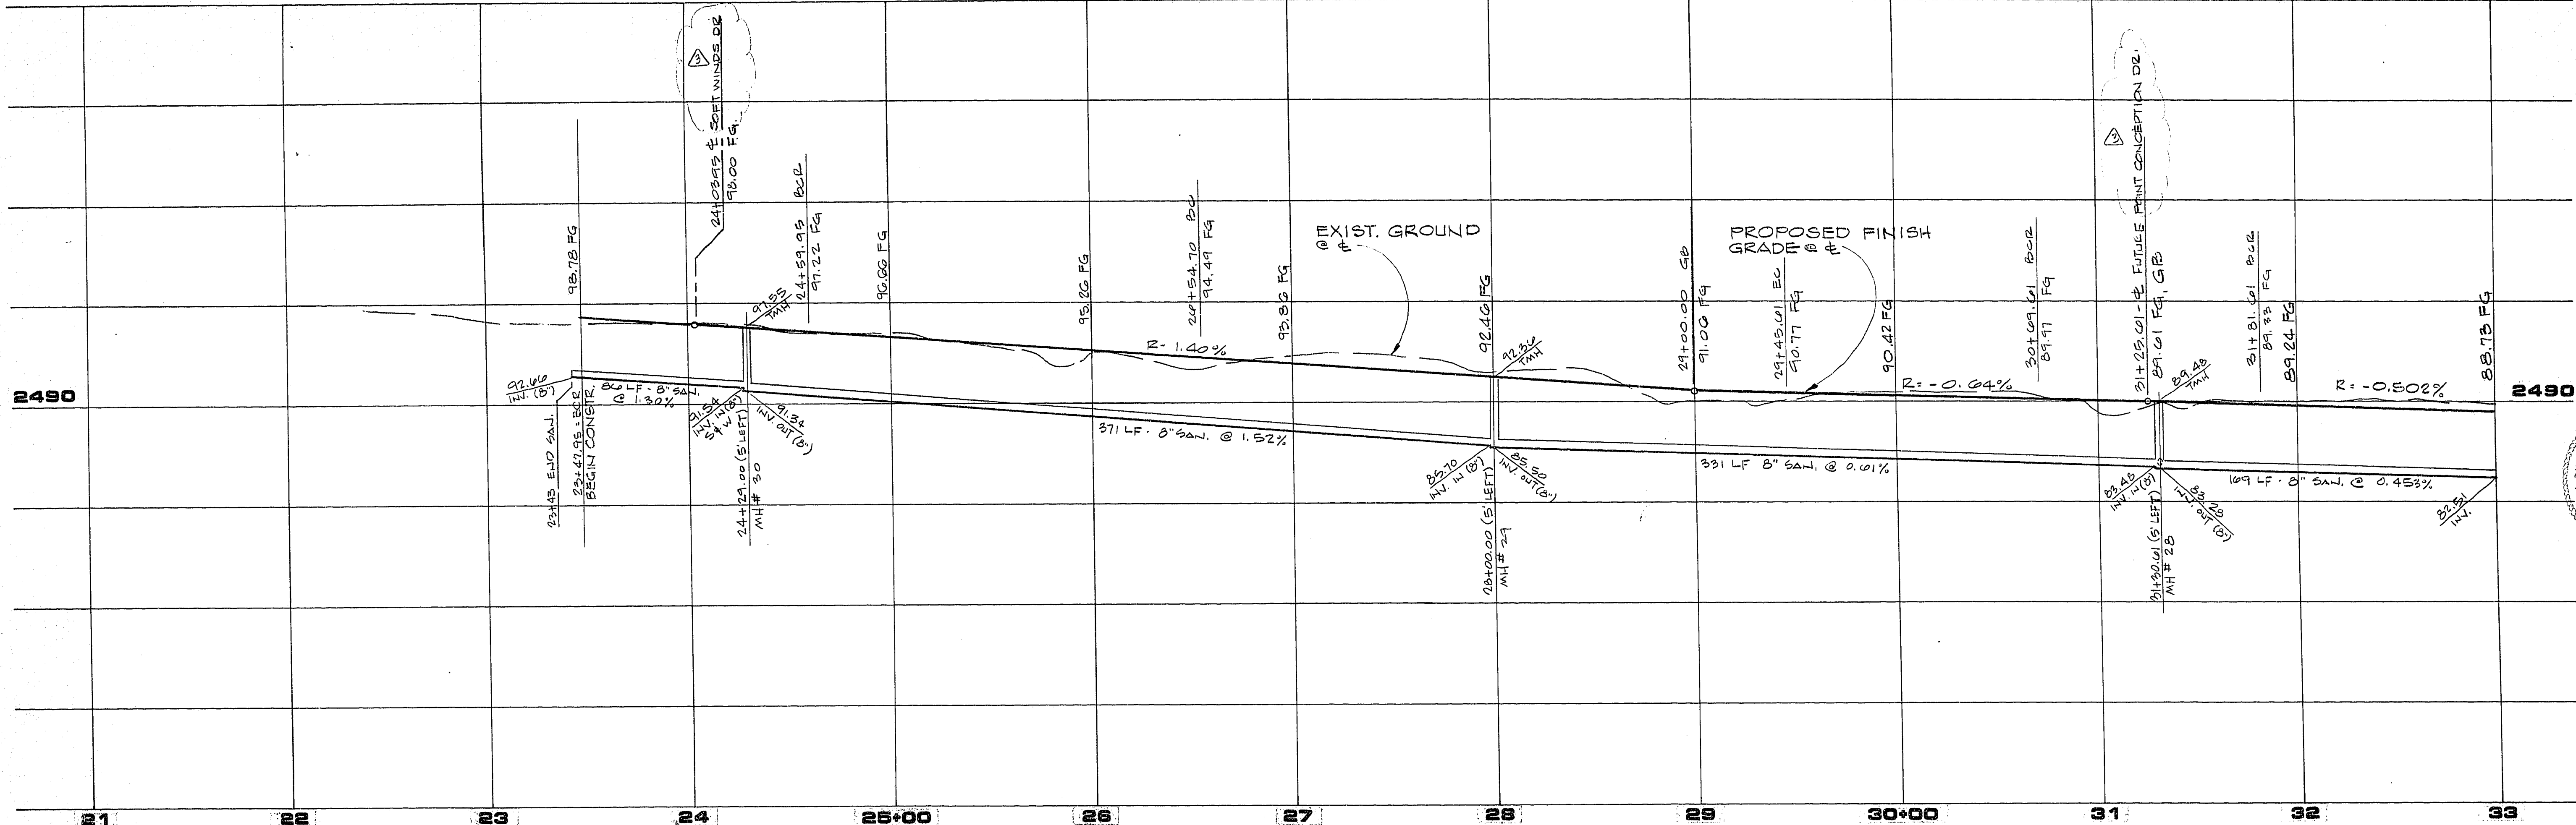

REV	DATE	DESCRIPTION
1	1/19/87	GENERAL REVISIONS
2	1/19/87	DESIGN REVISIONS
3	1/19/87	ST. LT. CONJ. OUT

155 SOUTH RAINBOW BLVD., LAS VEGAS, NEVADA 89102

G.C. WALLACE, INC.
Engineering/Architecture

DESERT SHORES - PHASE 1
HARBOR ISLAND DRIVE
STA. 23+47.95 TO STA. 33+00.00

SHEET
18
OF 25 SHEETS

1074-1248-1