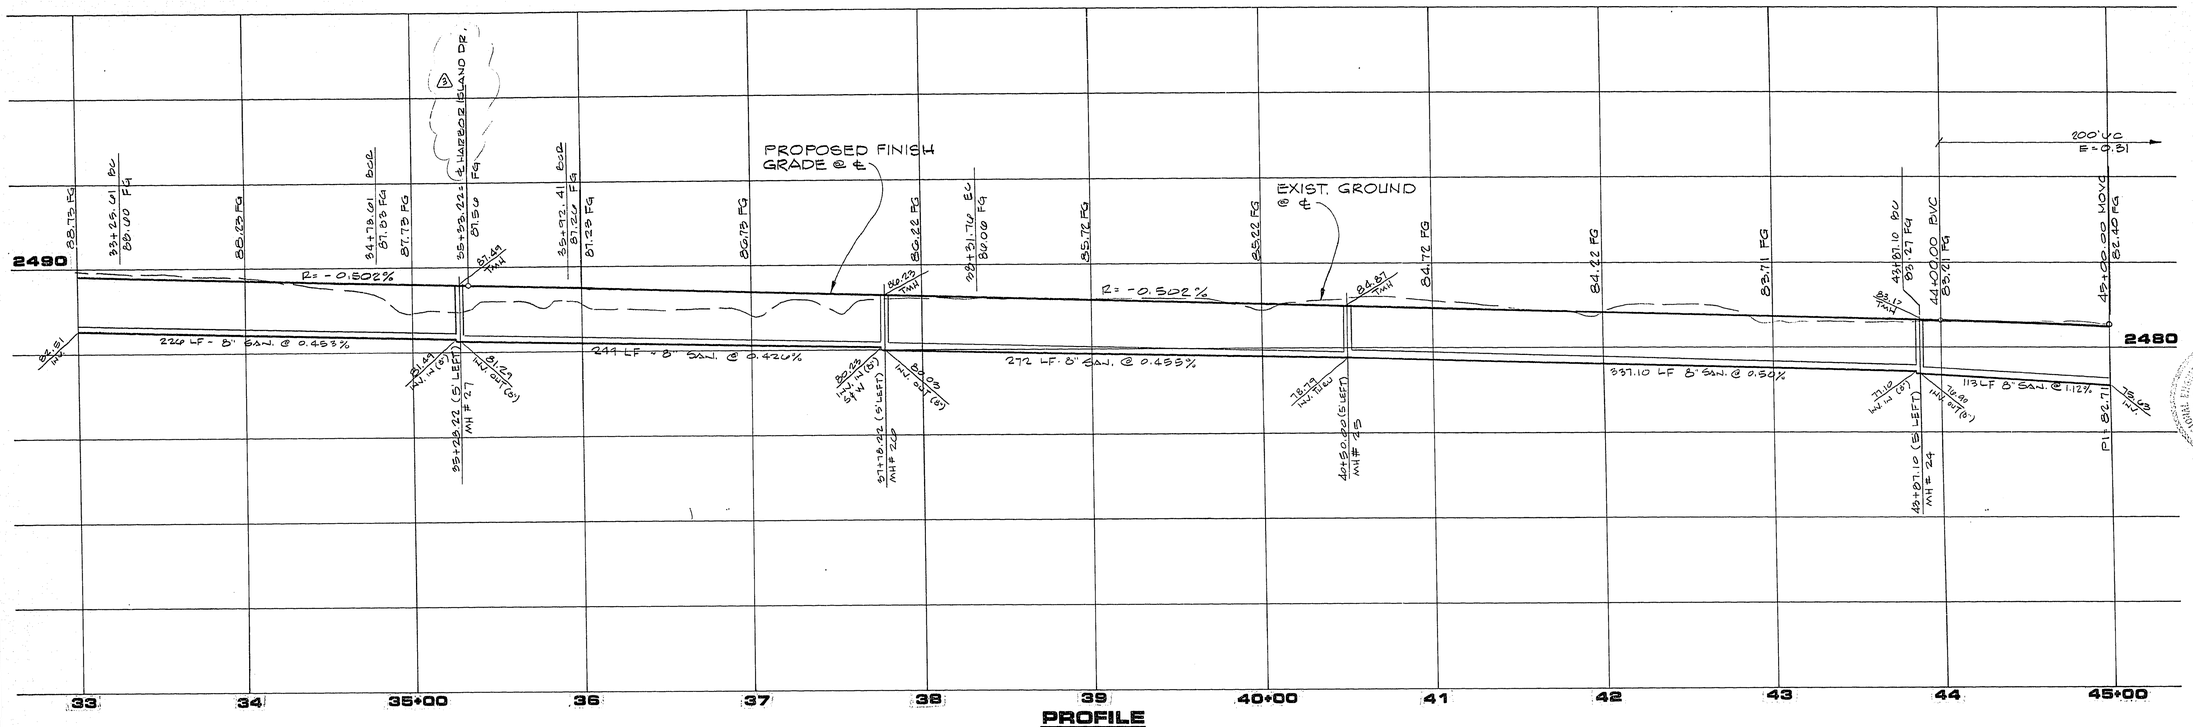

PROFILE

SCALE: HORIZ. 1"=40'
VERT. 1"=8'

BCR CURVE DATA

	NO.	Δ	R	L	T
℄	202	11° 53' 42"	1,000.00'	207.61'	104.18'
	229	08° 49' 57"	1,020.00'	156.97'	78.64'
	230	84° 19' 35"	30.00'	44.15'	27.17'
℄	234	29° 00' 00"	1,000.00'	506.15'	258.62'
	237	29° 00' 00"	974.00'	492.99'	251.89'
℄	260	29° 00' 00"	1,000.00'	506.15'	258.62'
	261	29° 00' 00"	1,020.00'	519.31'	265.34'
℄	286	17° 00' 18"	1,000.00'	298.54'	150.39'
	289	89° 09' 13"	30.00'	46.68'	29.56'
	290	13° 42' 50"	1,020.00'	245.58'	123.38'
	291	29° 00' 00"	974.00'	492.99'	251.89'

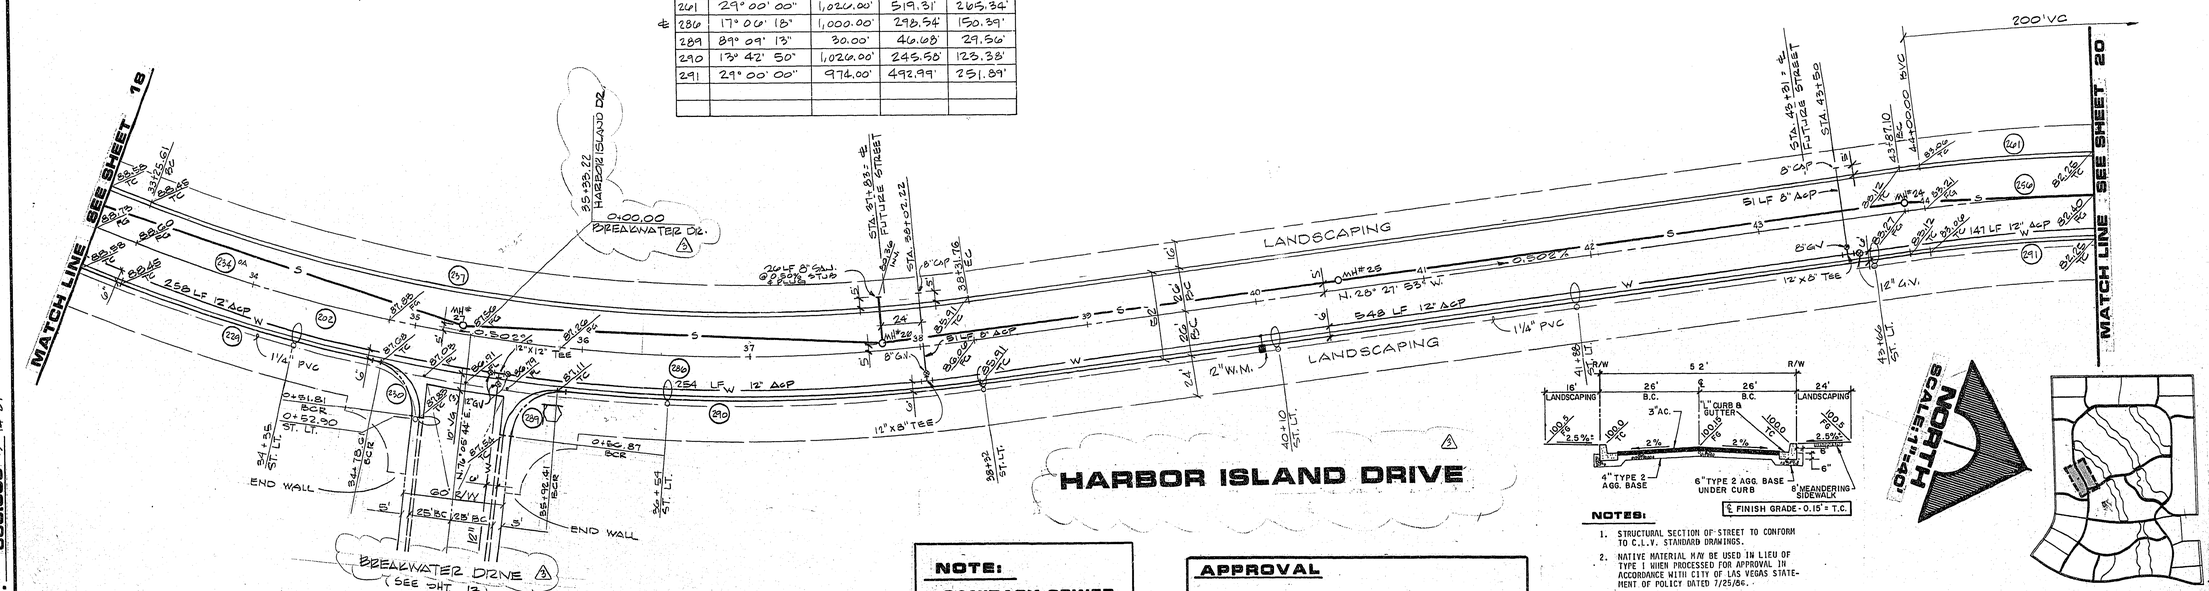

NOTES:

1. STRUCTURAL SECTION OF STREET TO CONFORM TO C.L.V. STANDARD DRAWINGS.
2. NATIVE MATERIAL MAY BE USED IN LIEU OF TYPE I WHEN PROCESSED FOR APPROVAL IN ACCORDANCE WITH CITY OF LAS VEGAS STATEMENT OF POLICY DATED 7/25/86.

LOOP ROAD

NOTE:
SANITARY SEWER PIPE TO BE PVC

APPROVAL

CLV CHIEF LAND DEVELOPMENT — DATE

REV	DATE	DESCRIPTION
1	11/8/91	GENERAL REVISIONS
2	1/6/97	UPS-SEGALINE &
3	6/4/98	REV PROJECT TITLE & PO ST. ISSUES

RECOMMENDED: Gary R. Mitchell — DATE 1-13-98
R.E. NO. 8943

G.C. WALLACE, INC.
Engineering/Architecture
1555 SOUTH RAINBOW BLVD./LAS VEGAS, NEVADA 89102

RA HOMES
DESERT SHORES - PHASE 1
HARBOR ISLAND DRIVE
STA 33+00.00 TO STA 45+00.00

SHEET 19 OF 43 SHEETS

JOB NO. 660.009 2-14-87

8/84 DIETERICH-POST 0532B

107Y-1248-1