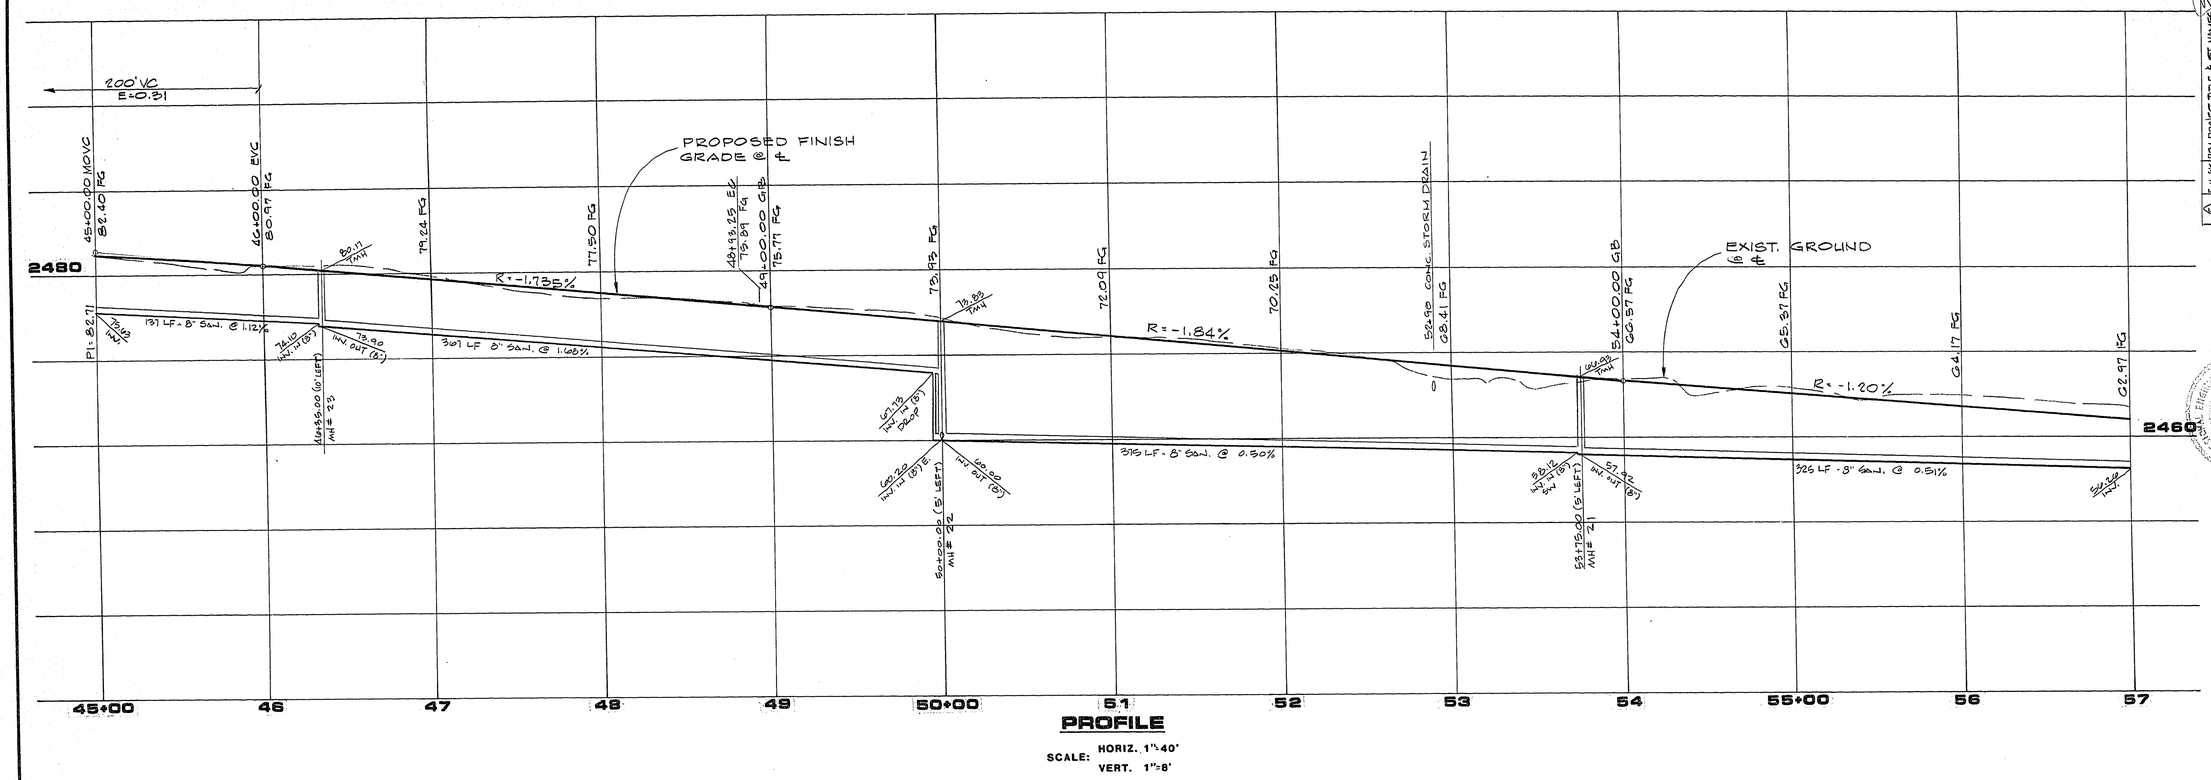

PROFILE

SCALE: HORIZ. 1"=40'
VERT. 1"=8'

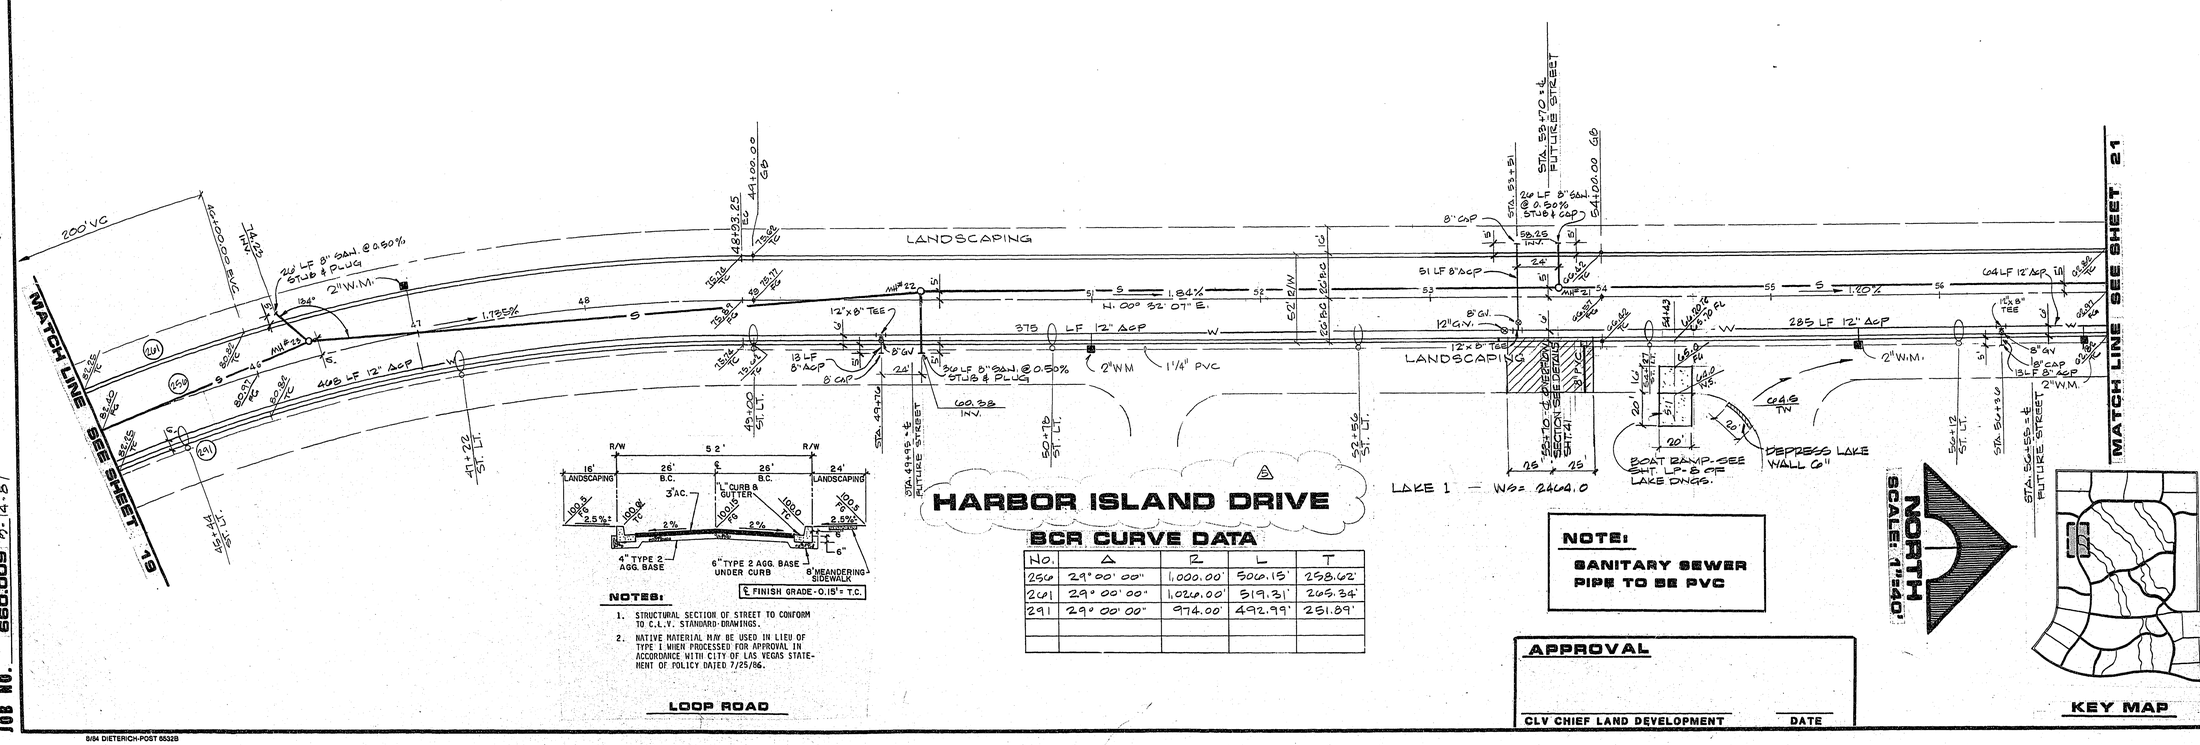

NOTES:

1. STRUCTURAL SECTION OF STREET TO CONFORM TO C.L.V. STANDARD DRAWINGS.
2. NATIVE MATERIAL MAY BE USED IN LIEU OF TYPE 1 WHEN PROCESSED FOR APPROVAL IN ACCORDANCE WITH CITY OF LAS VEGAS STATEMENT OF POLICY DATED 7/25/86.

LOOP ROAD

BCR CURVE DATA

NO.	Δ	R	L	T
261	29° 00' 00"	1,020.00'	519.31'	265.34'
291	29° 00' 00"	974.00'	492.99'	251.89'

NOTE:
SANITARY SEWER PIPE TO BE PVC

APPROVAL

CLV CHIEF LAND DEVELOPMENT — DATE

REV	DATE	DESCRIPTION
1	5-16-86	REV. PROJECT TITLE & ST. NAMES
2	11/5/87	GENERAL REVISIONS
3	12-8-88	ADDED DEPRESSED LAKE WALL
4	8/1/88	REV. ST. SEC. NOTE & DATE
5	4/16/85	REMOVED BUBBLE, RE-SHEETED AND ADDED SUBDIVISION SECT.

RECOMMENDED: Paul Wimbley — 2143 R.E. NO. — 1-13-88 DATE

G.C. WALLACE, INC.
Engineering/Architecture
1555 SOUTH RAINBOW BLVD./LAS VEGAS, NEVADA 89102

R A HOMES
DESERT SHORES - PHASE 1
HARBOR ISLAND DRIVE
STA 45+00.00 TO STA. 57+00.00

SHEET 20 OF 43 SHEETS

JOB NO. 660.009 2-14-87

8/84 DIETERICH-POST 5532B

107Y-1248-1