



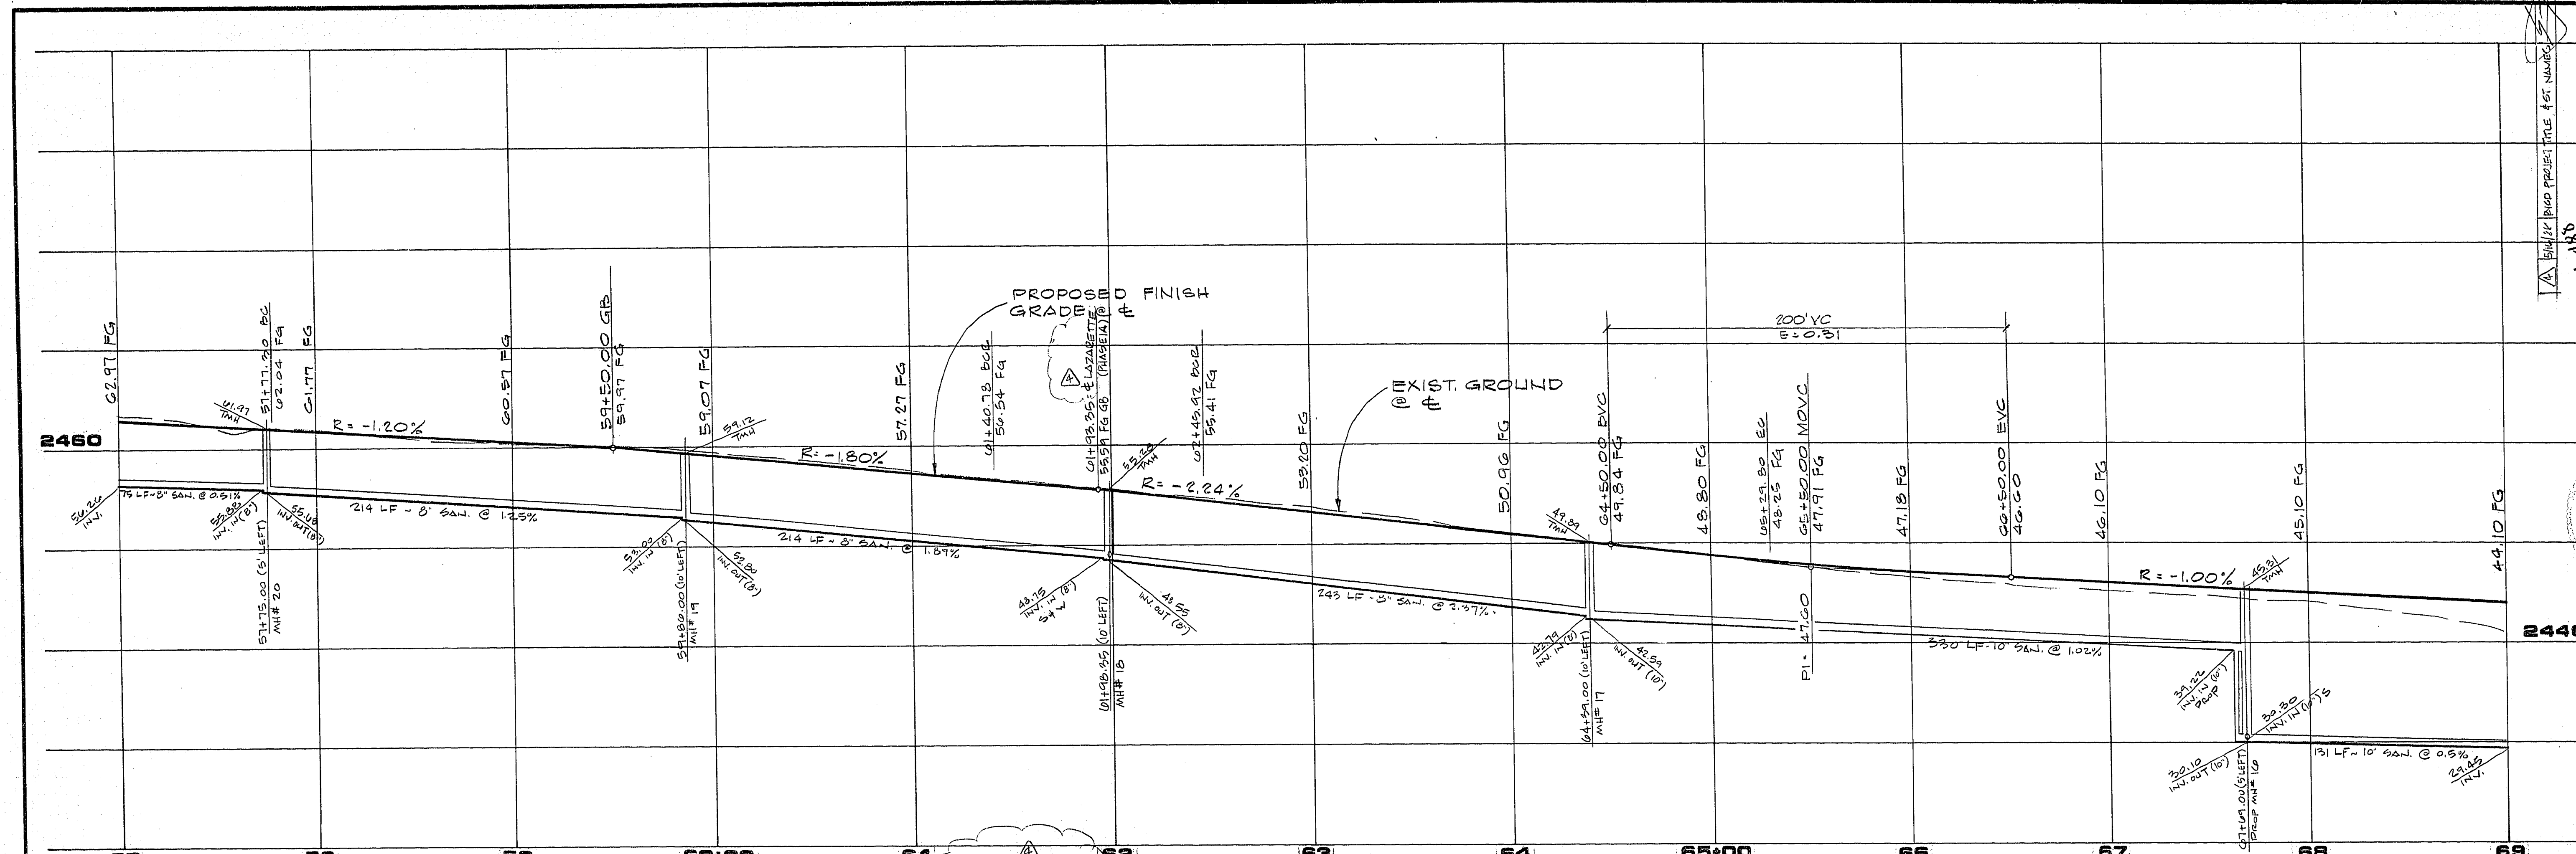

PROFILE
SCALE: HORIZ. 1"=40'
VERT. 1"=8'

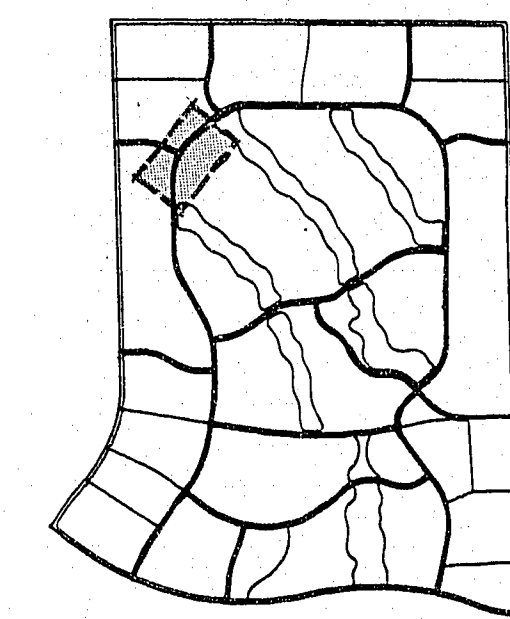


KEY MAP

NOTE:
1. C.V. NOT READ, IF
PHASE 1A IS INSTALLED
AT THE SAME TIME
2. 50.50
ST. LT.


HARBOR ISLAND DRIVE

BCR CURVE DATA				
NO	Δ	R	L	T
10	22° 40' 45"	850.00	330.45	170.40
11	19° 08' 08"	870.00	292.50	147.60
12	80° 27' 23"	30.00	45.27	28.20
255	28° 02' 41"	850.00	410.05	212.28
259	86° 27' 23"	30.00	45.27	28.20
260	24° 30' 03"	870.00	374.60	190.21
312	50° 43' 26"	850.00	752.50	402.92
320	50° 43' 26"	824.00	729.48	390.59

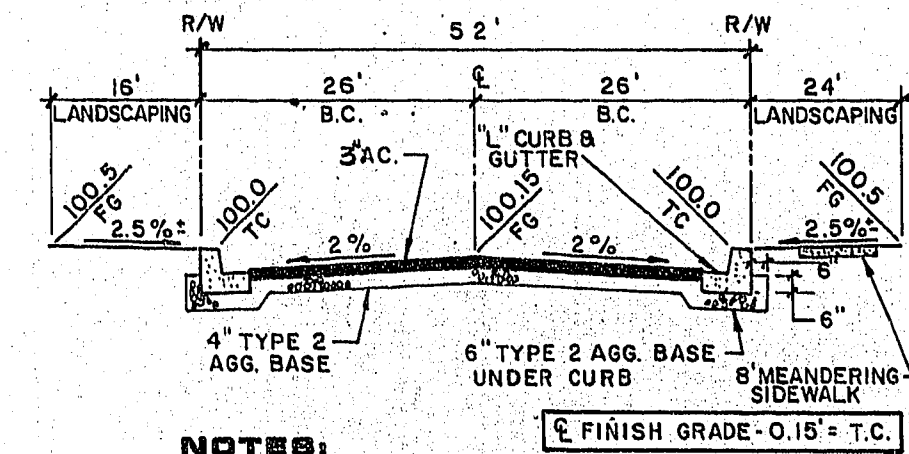

NOTES:
1. STRUCTURAL SECTION OF STREET TO CONFORM TO C.L.V. STANDARD DRAWINGS.
2. NATIVE MATERIAL MAY BE USED IN LIEU OF TYPE 1 WHEN PROCESSED FOR APPROVAL IN ACCORDANCE WITH CITY OF LAS VEGAS STATEMENT OF POLICY DATED 7/25/86.

LOOP ROAD

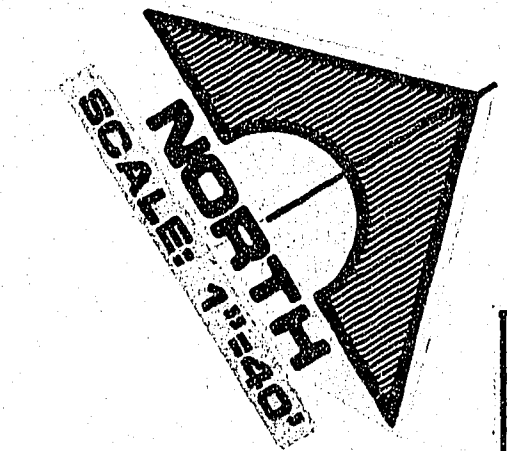

NOTE:
SANITARY SEWER
PIPE TO BE PVC

APPROVAL

CLV CHIEF LAND DEVELOPMENT

DATE

RECOMMENDED DATE 1/15/88 RE. NO. 983 DATE 1/15/88 RE. NO. 983	DESCRIPTION GENERAL REVISIONS 1. 1/15/88 2. 1/15/88 3. 1/15/88 4. 1/15/88 5. 1/15/88 6. 1/15/88 7. 1/15/88 8. 1/15/88 9. 1/15/88 10. 1/15/88 11. 
