


JOB NO. 660.009 0-14-87



PROFILE


SCALE: HORIZ. 1"=40'
VERT. 1"=8'

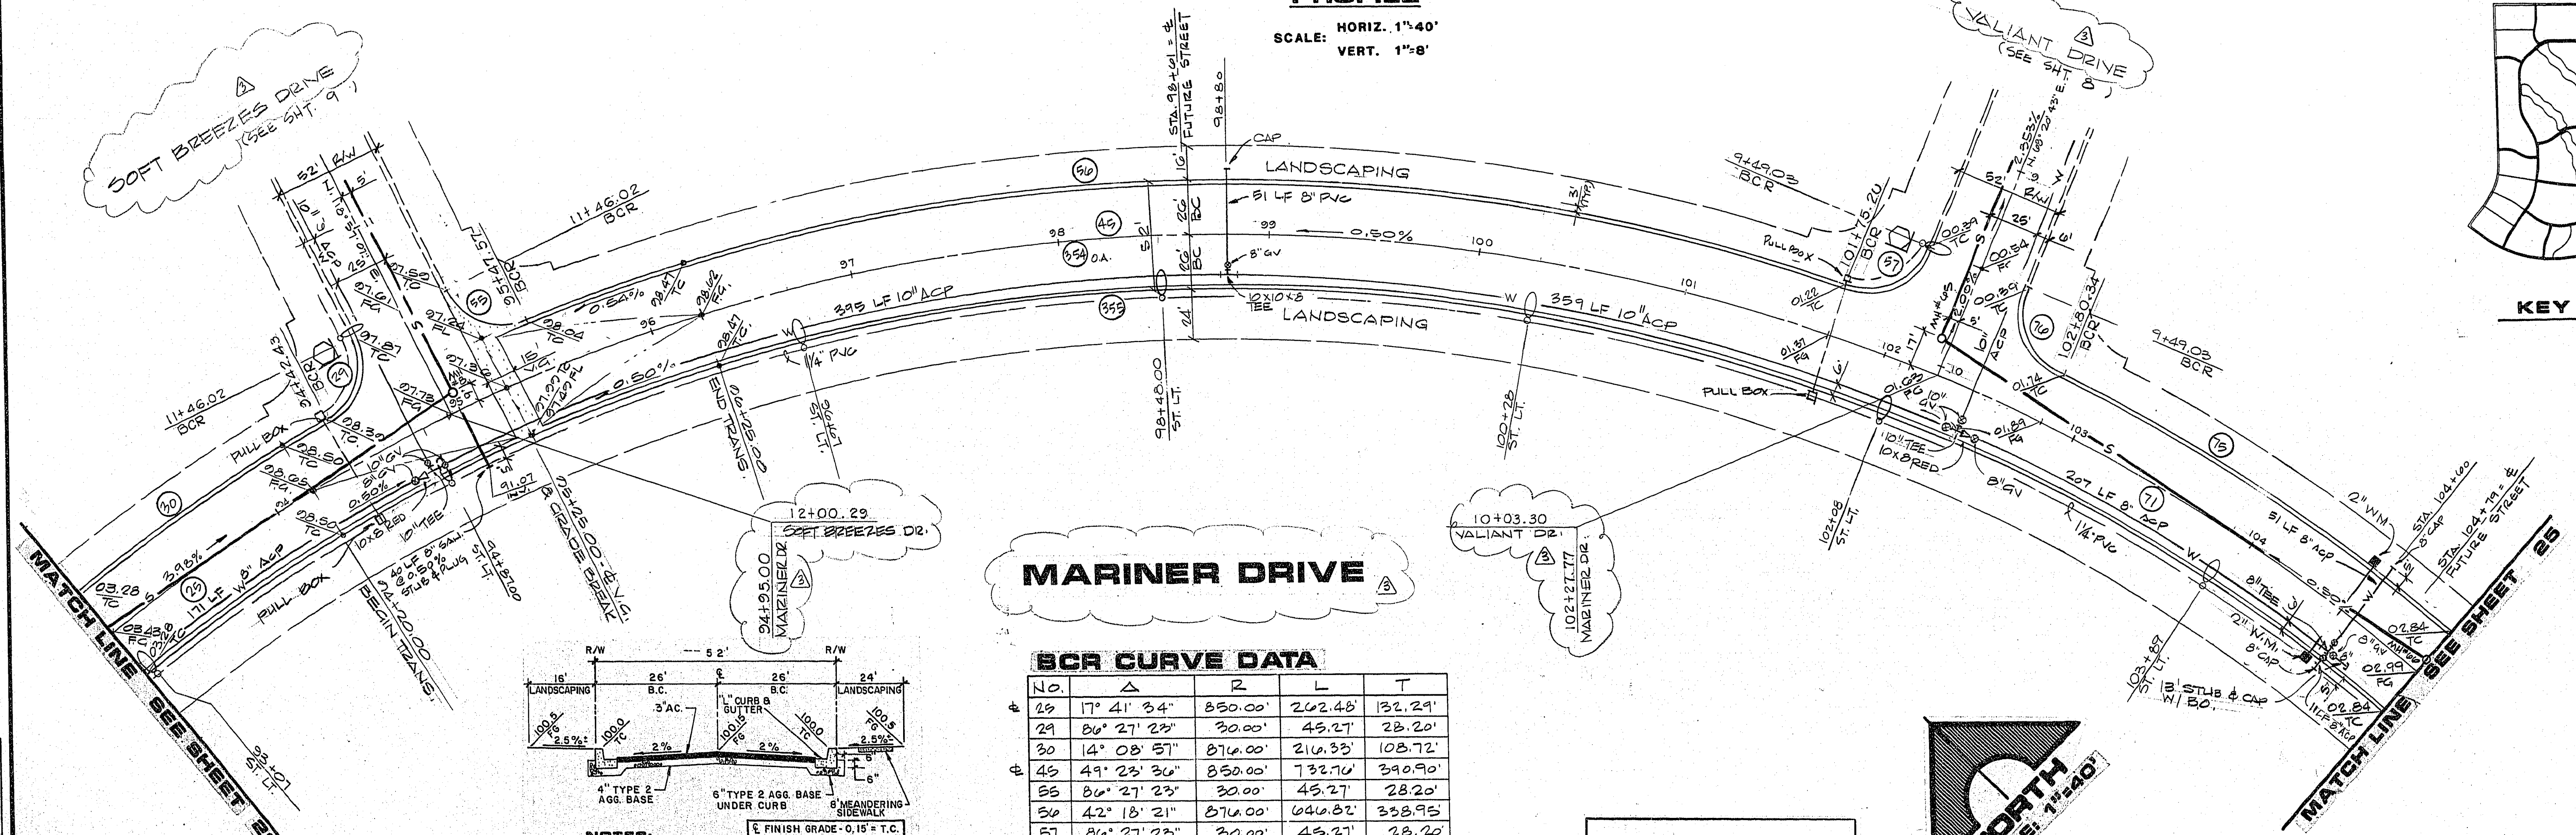

MARINER DRIVE


BCR CURVE DATA				
NO.	Δ	R	L	T
28	17° 41' 34"	850.00'	262.48'	132.29'
29	80° 27' 23"	30.00'	45.27'	28.20'
30	14° 08' 51"	876.00'	216.33'	108.72'
45	49° 23' 36"	850.00'	732.76'	390.90'
55	80° 27' 23"	30.00'	45.27'	28.20'
56	42° 18' 21"	876.00'	646.82'	338.95'
57	80° 27' 23"	30.00'	45.27'	28.20'
71	22° 00' 02"	850.00'	326.38'	165.23'
75	18° 27' 25"	876.00'	282.19'	142.33'
76	80° 27' 23"	30.00'	45.27'	28.20'
354	89° 05' 12"	850.00'	1321.63'	836.56'
355	89° 05' 12"	824.00'	1281.20'	810.97'

NOTE:
SANITARY SEWER
PIPE TO BE PVC

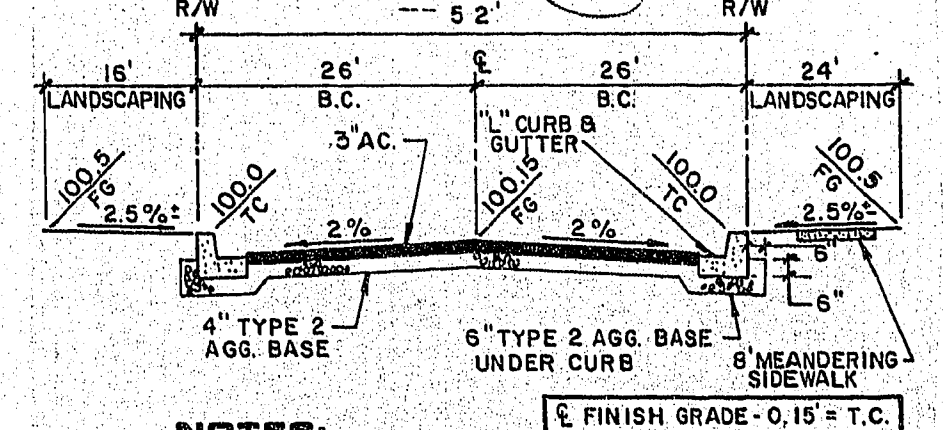

- NOTES:**
- STRUCTURAL SECTION OF STREET TO CONFORM TO C.I.V. STANDARD DRAWINGS.
 - NATIVE MATERIAL MAY BE USED IN LIEU OF TYPE 1 WHEN PROCESSED FOR APPROVAL IN ACCORDANCE WITH CITY OF LAS VEGAS STATEMENT OF POLICY DATED 7/25/86.

KEY MAP

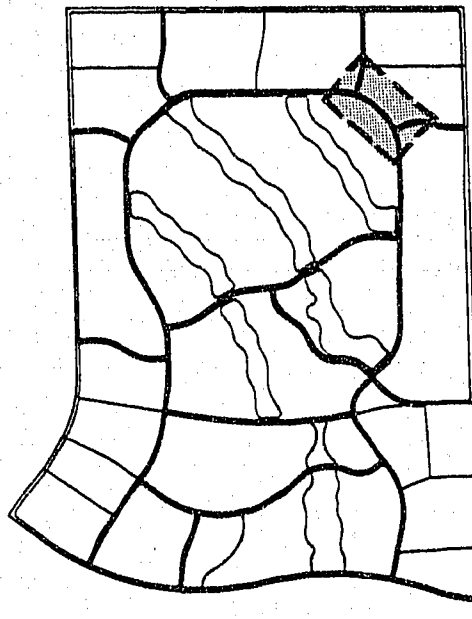

APPROVAL

CLV CHIEF LAND DEVELOPMENT

DATE

DESCRIPTION
GENERAL REVISIONS
DATE
REV
1
2
