

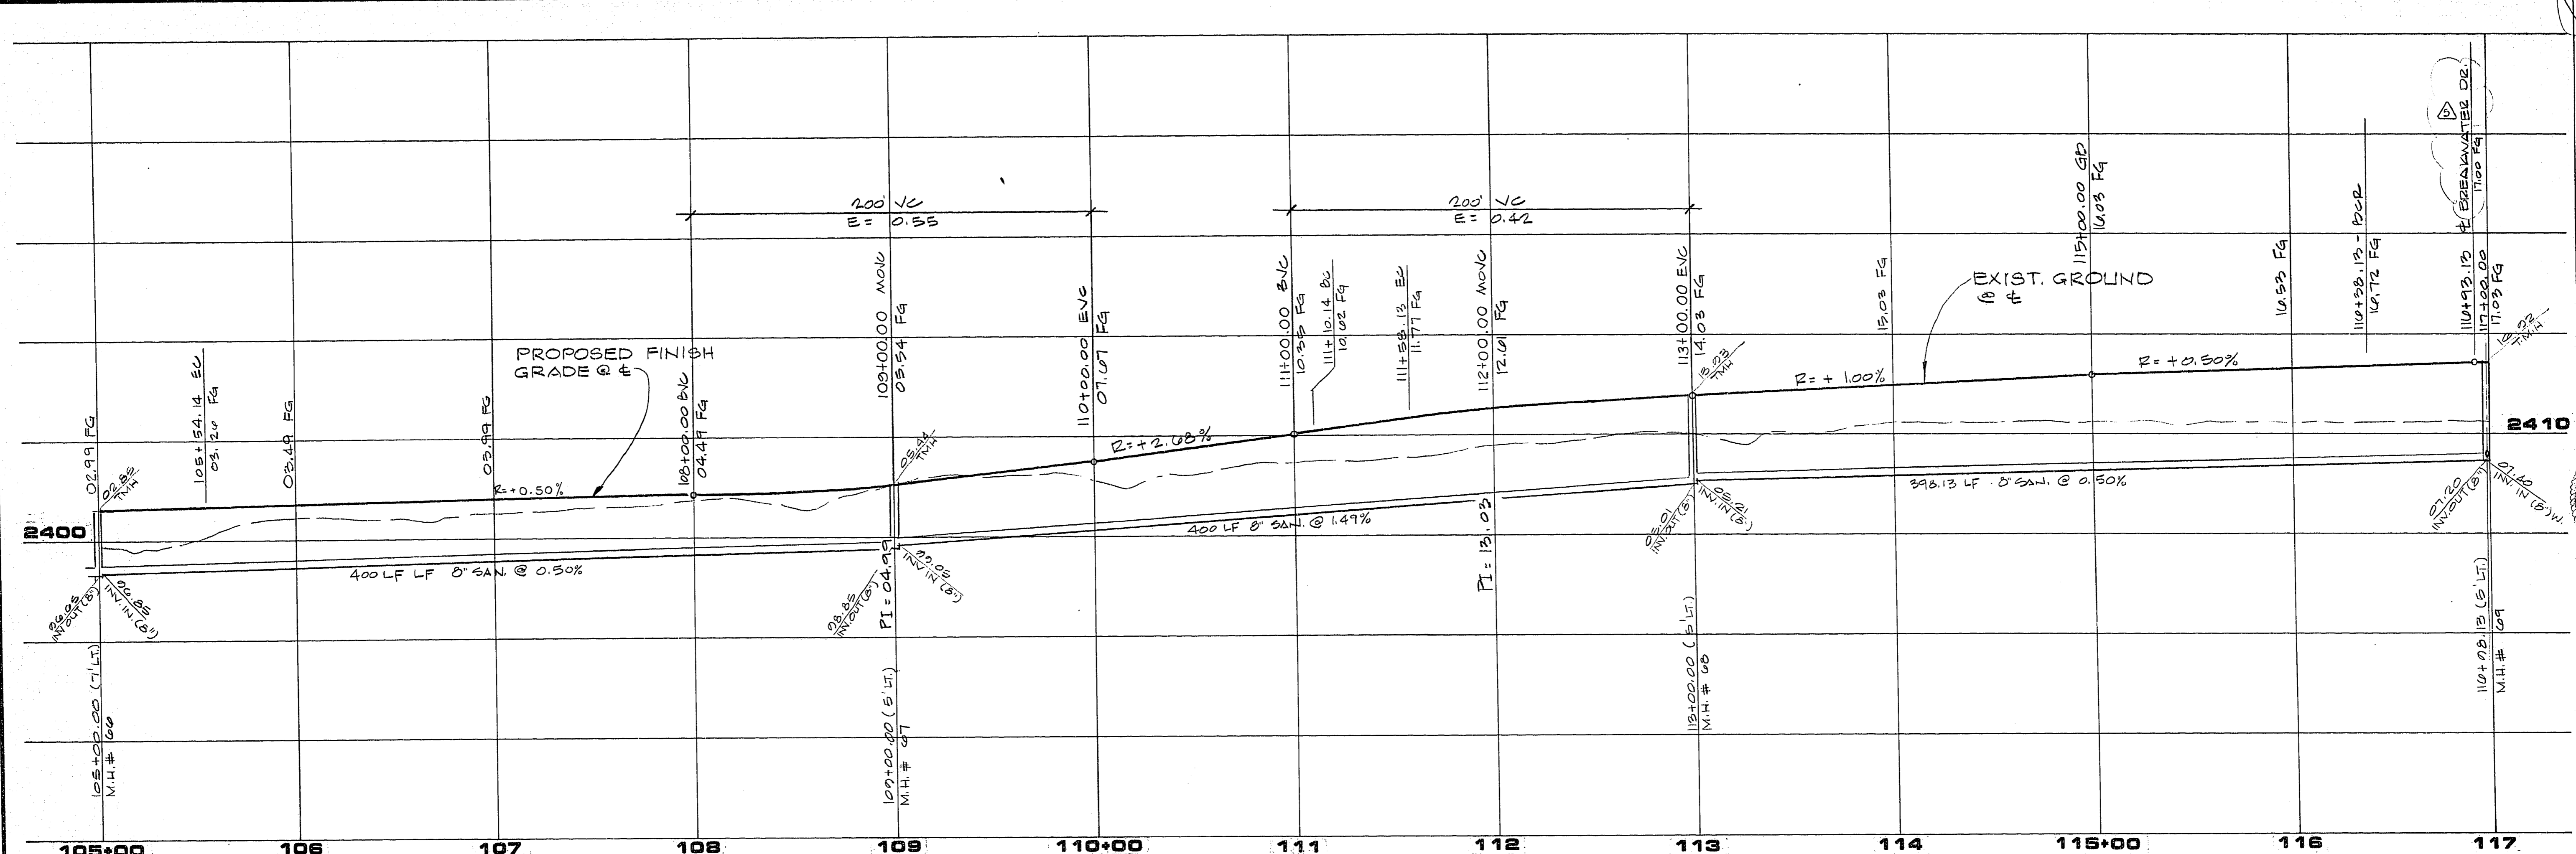


JOB NO. 660.009 7-14-87

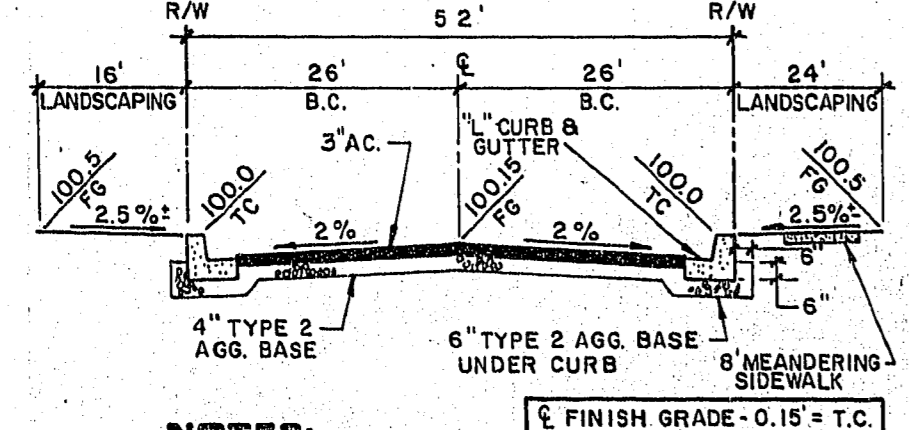

PROFILE
 HORIZ. 1"=40'
 VERT. 1"=8'

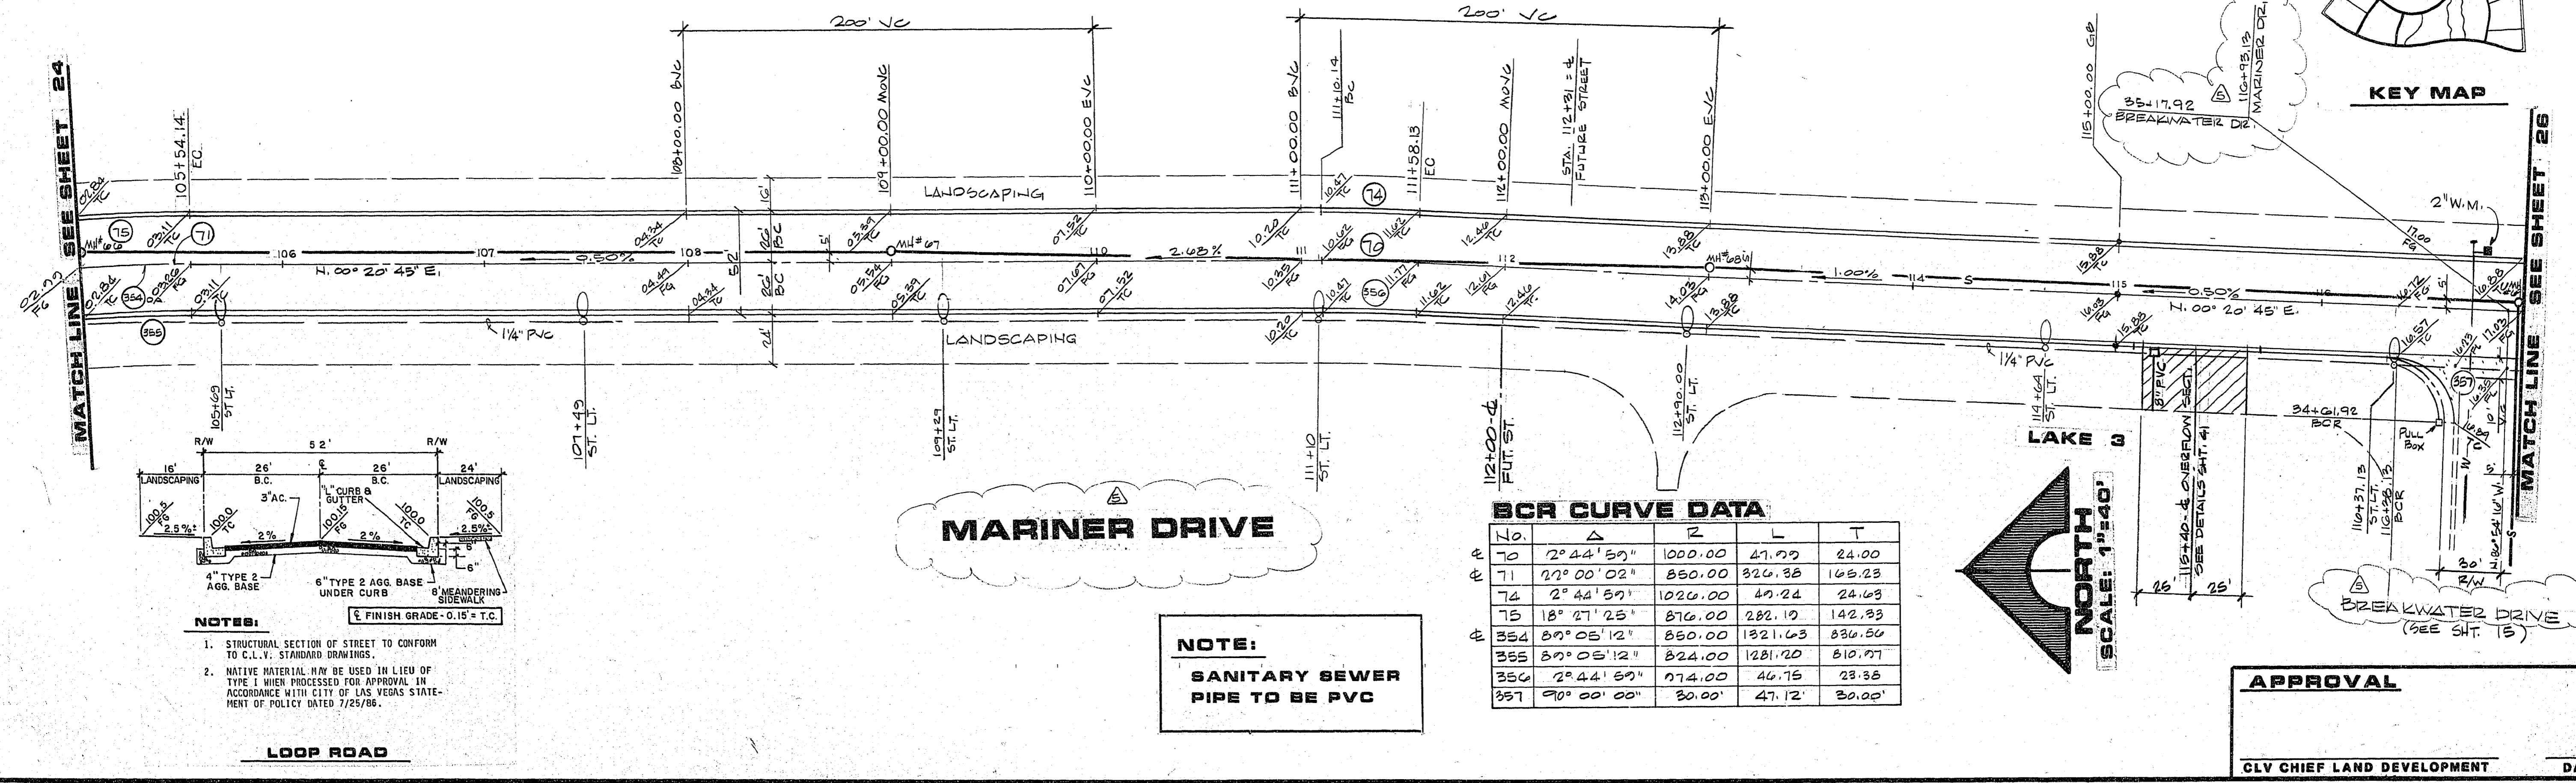


- NOTES:**
- STRUCTURAL SECTION OF STREET TO CONFORM TO C.L.V. STANDARD DRAWINGS.
 - NATIVE MATERIAL MAY BE USED IN LIEU OF TYPE I WHEN PROCESSED FOR APPROVAL IN ACCORDANCE WITH CITY OF LAS VEGAS STATEMENT OF POLICY DATED 7/25/86.

MARINER DRIVE

NOTE:
 SANITARY SEWER PIPE TO BE PVC

BCR CURVE DATA

STATION	Δ	R	L	T
70	2° 44' 59"	1000.00	47.77	24.00
75	18° 27' 25"	876.00	282.19	142.93

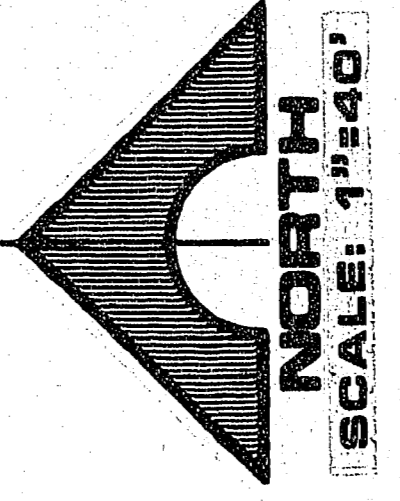

APPROVAL

CLV CHIEF LAND DEVELOPMENT DATE

REVISIONS


RECOMMENDED
 G.C. WALLACE, INC.
 Engineering/Architecture

RA HOMES
 DESERT SHORES - PHASE 1
 MARINER DRIVE
 STA. 105+00.00 TO STA. 117+00.00

SHEET
25
 OF 43 SHEETS
 107Y-1248-1