

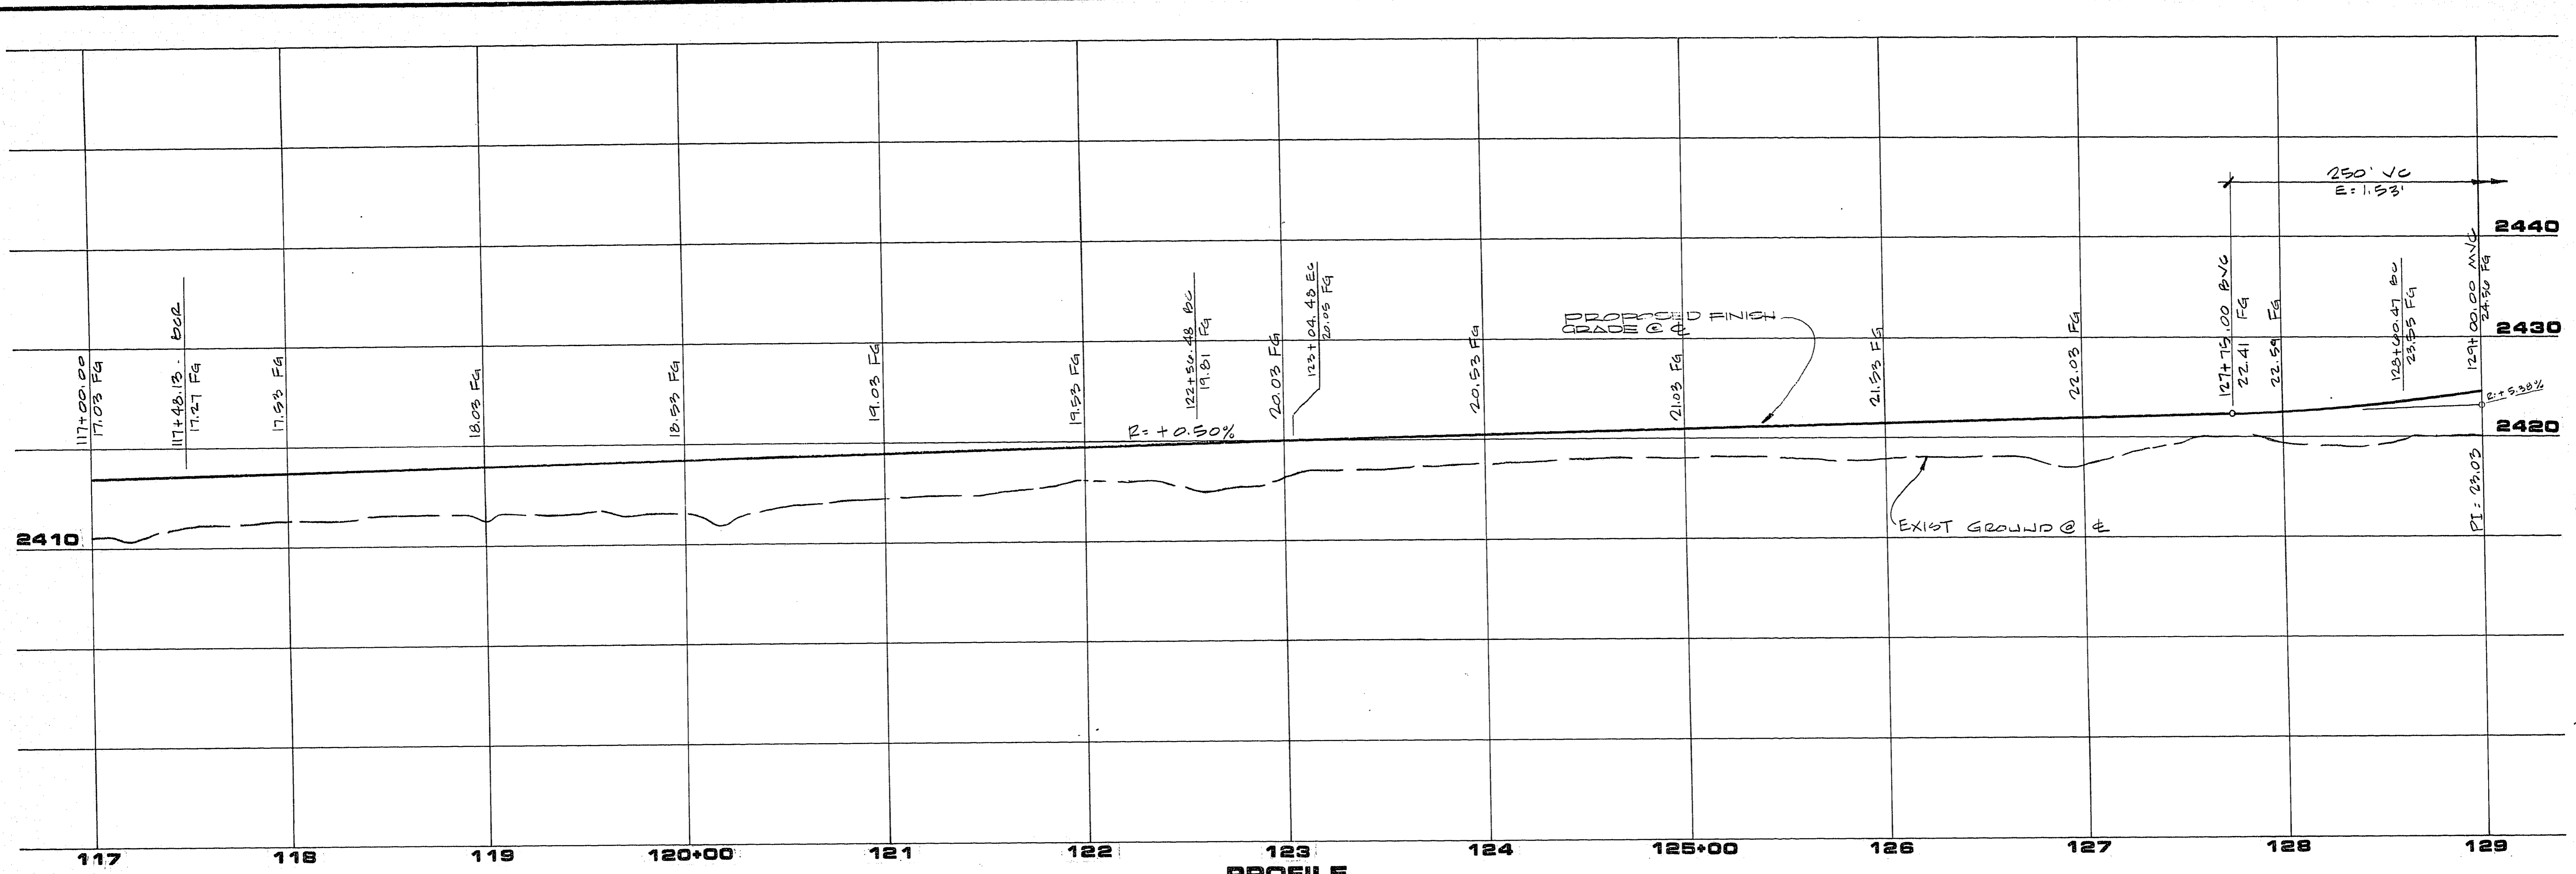


JOB NO. 660005 0-14-87

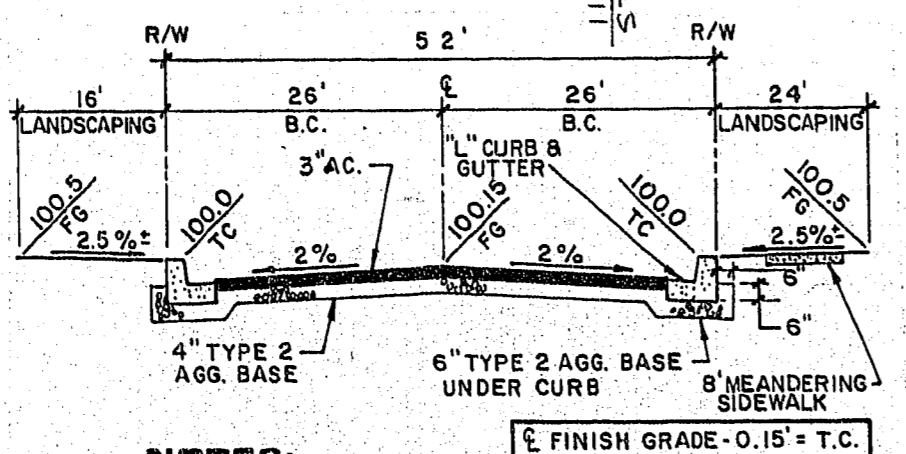

**PROFILE**  
SCALE: HORIZ. 1"=40'  
VERT. 1"=8'


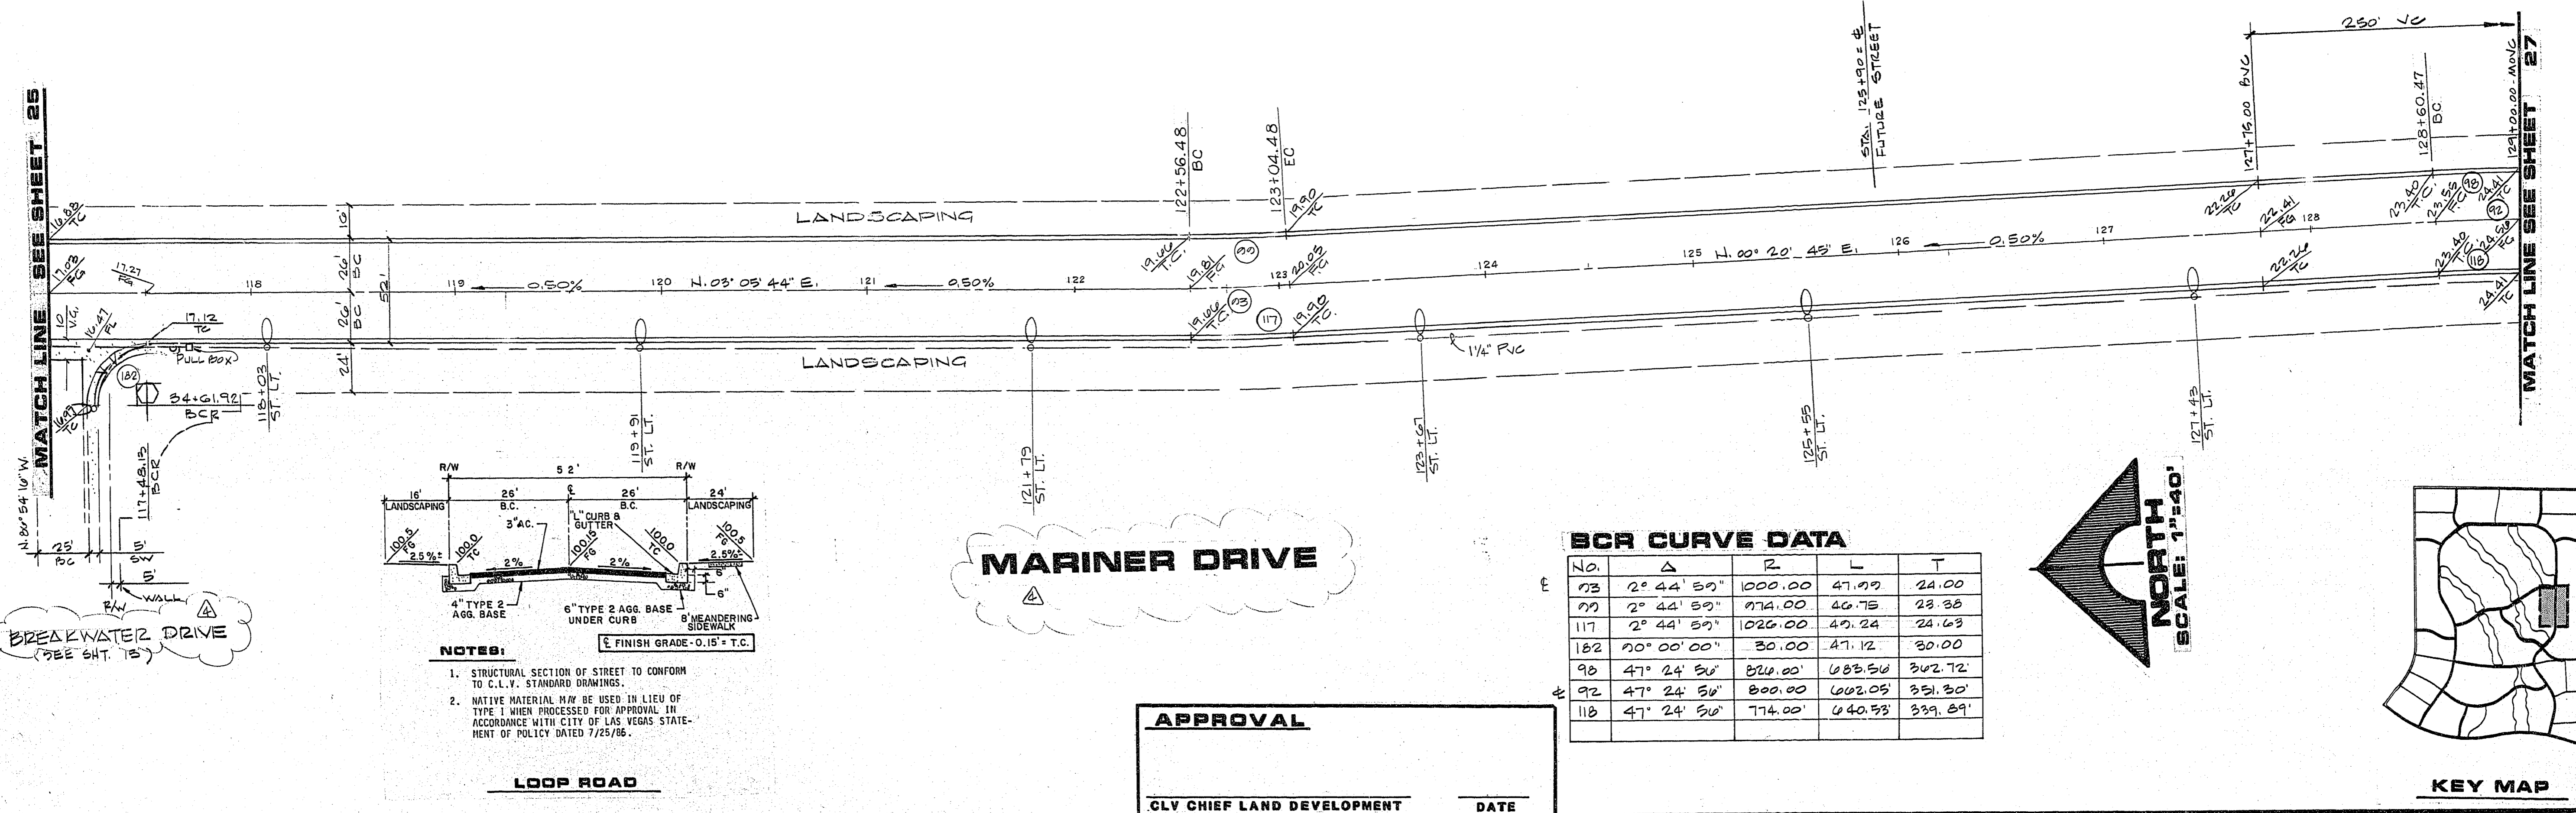


- NOTES:**
- STRUCTURAL SECTION OF STREET TO CONFORM TO C.L.V. STANDARD DRAWINGS.
  - NATIVE MATERIAL MAY BE USED IN LIEU OF TYPE 1 WHEN PROCESSED FOR APPROVAL IN ACCORDANCE WITH CITY OF LAS VEGAS STATEMENT OF POLICY DATED 7/25/86.

**BCR CURVE DATA**

No.	Δ	R	L	T

**APPROVAL**  
CLV CHIEF LAND DEVELOPMENT \_\_\_\_\_ DATE \_\_\_\_\_

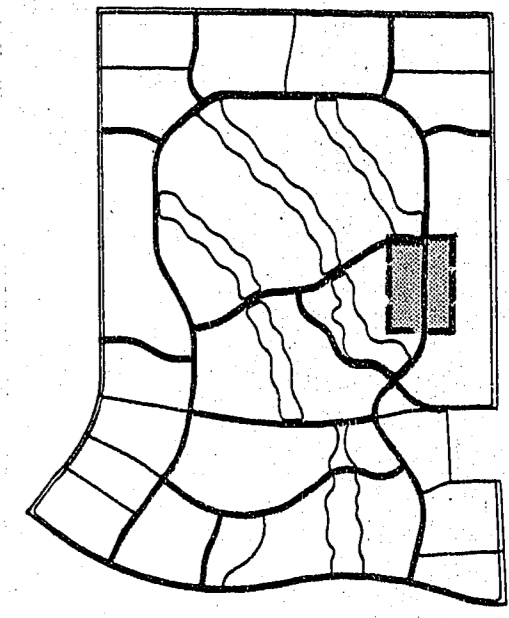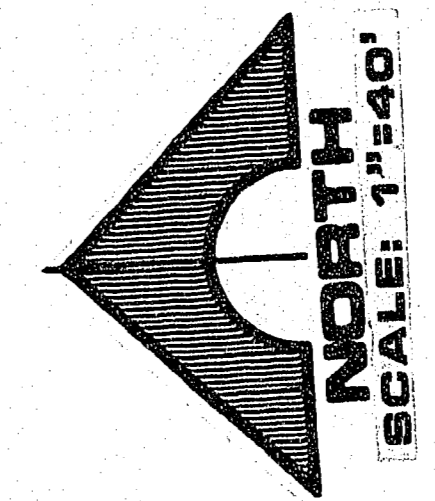

DESCRIPTION  

G.C. WALLACE, INC.  
 Engineering/Architecture  
 1555 SOUTH RAINBOW BLVD., LAS VEGAS, NEVADA 89102  
 No. 3943

RA HOMES  
 DESERT SHORES - PHASE 1  
**MARINER DRIVE**  
 STA. 117+00.00 TO STA. 129+00.00  
 SHEET **26**  
 OF 43 SHEETS