

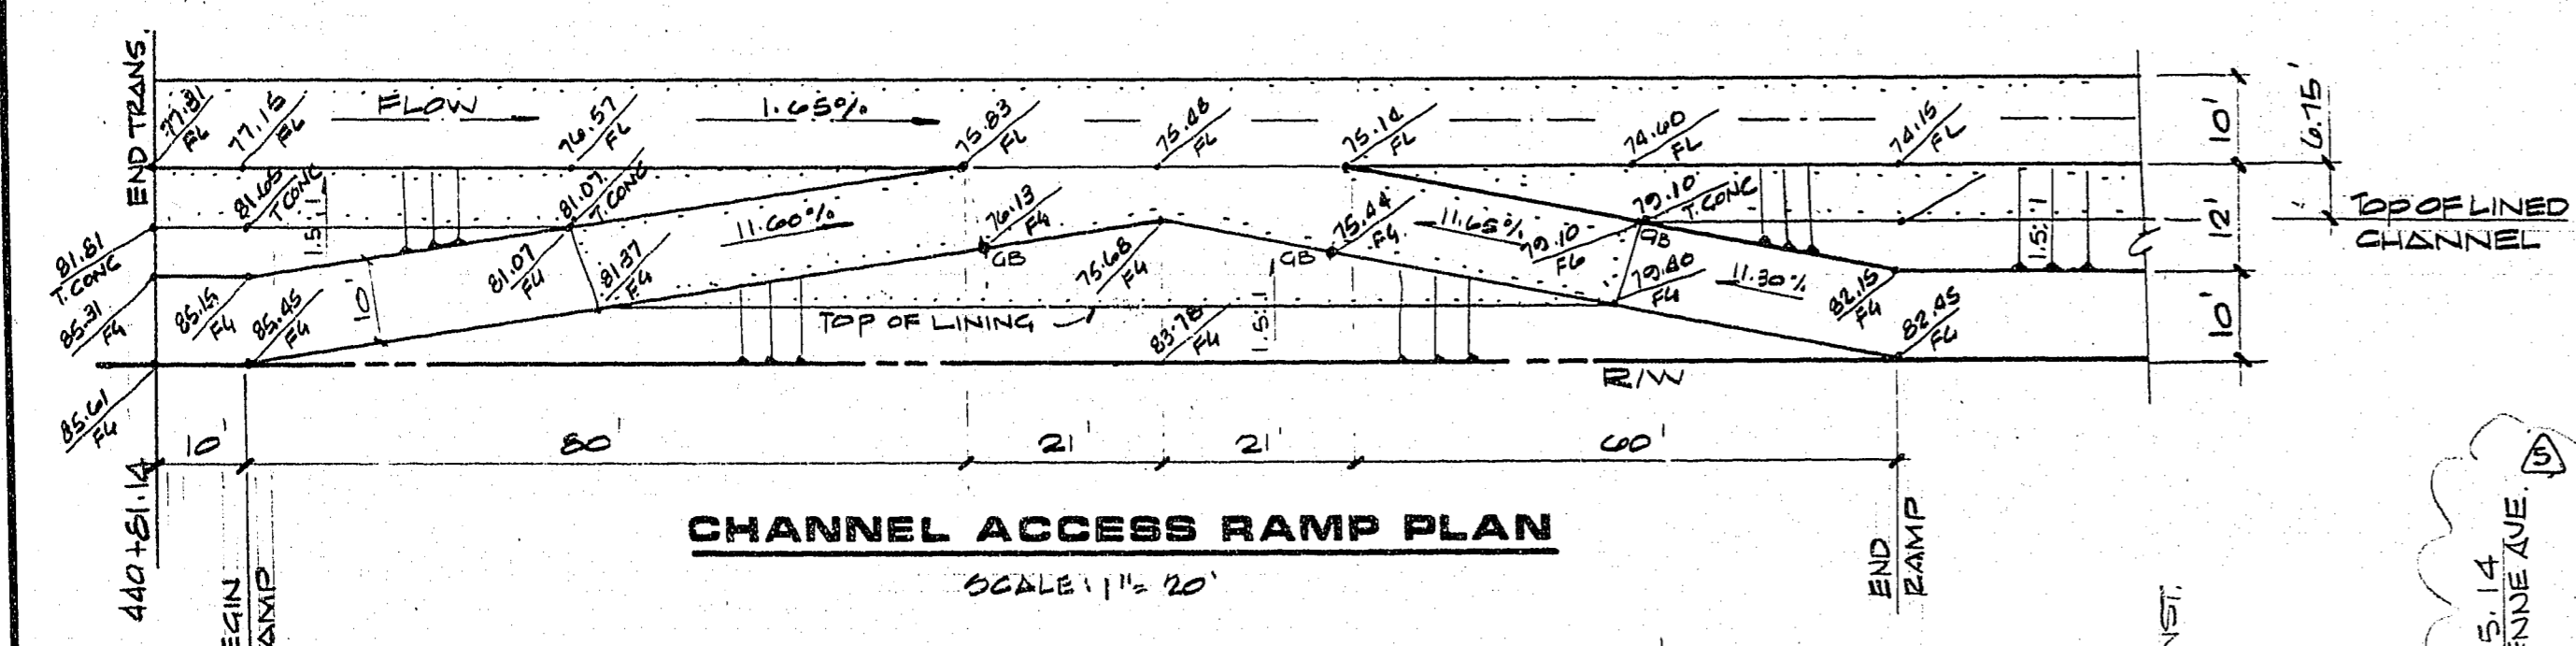


JOB NO. 660-009 2-14-87

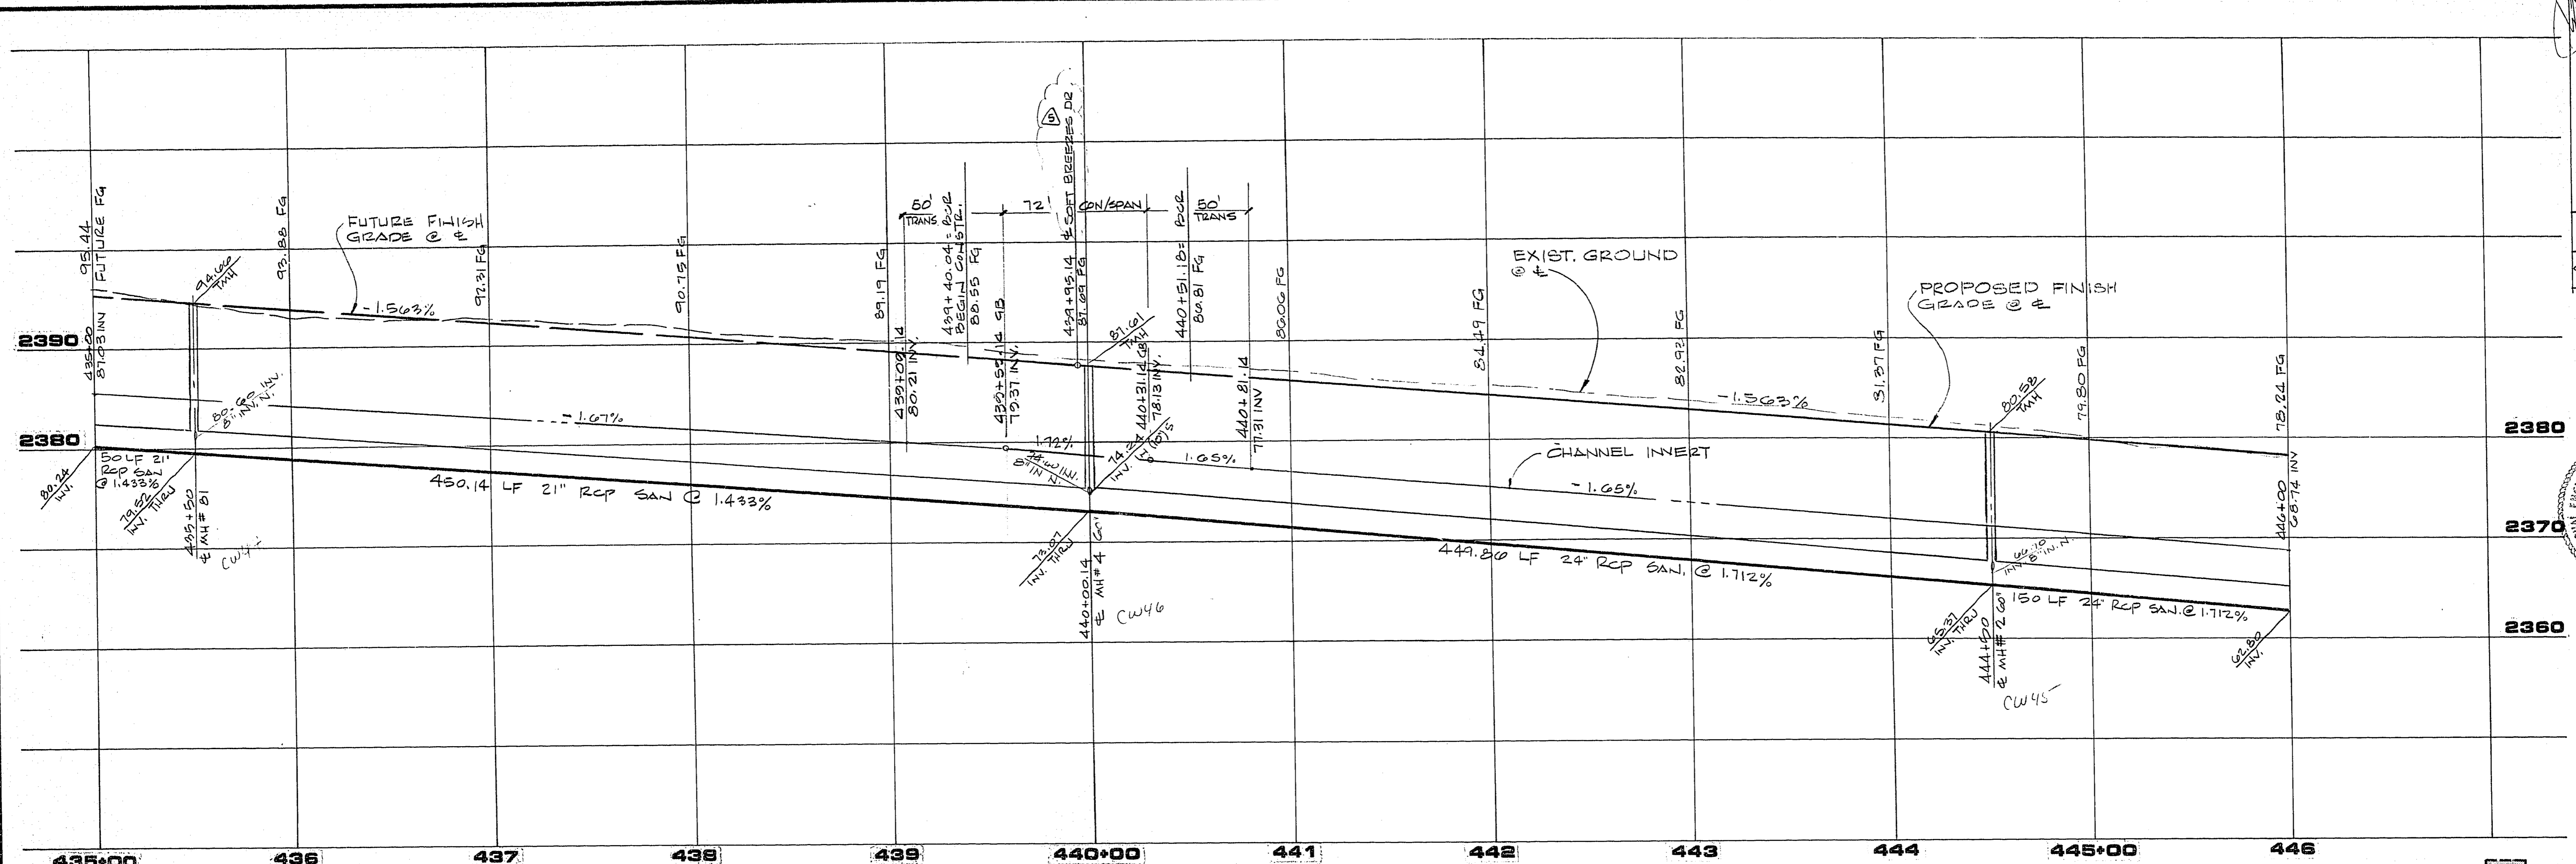




PROFILE
SCALE: HORIZ. 1" = 40'
VERT. 1" = 8'

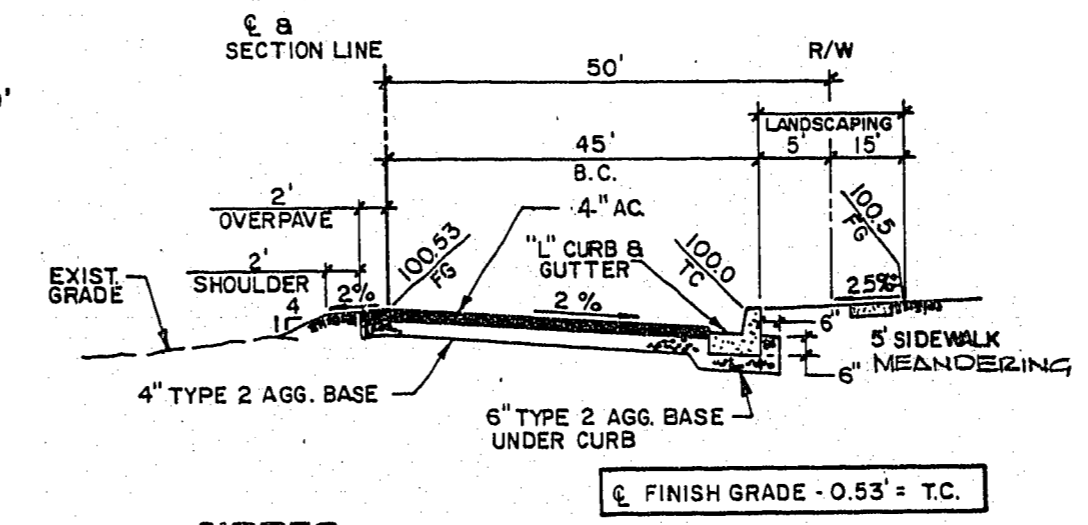

BCR CURVE DATA

NO.	Δ	R	L	T
21A	89° 59' 00"	30.00	47.12	20.99
21A	90° 01' 34"	30.00	47.12	30.01

- NOTES:**
- STRUCTURAL SECTION OF STREET TO CONFORM TO C.L.V. STANDARD DRAWINGS.
 - NATIVE MATERIAL MAY BE USED IN LIEU OF TYPE I WHEN PROCESSED FOR APPROVAL IN ACCORDANCE WITH CITY OF LAS VEGAS STATEMENT OF POLICY DATED 7/25/86.

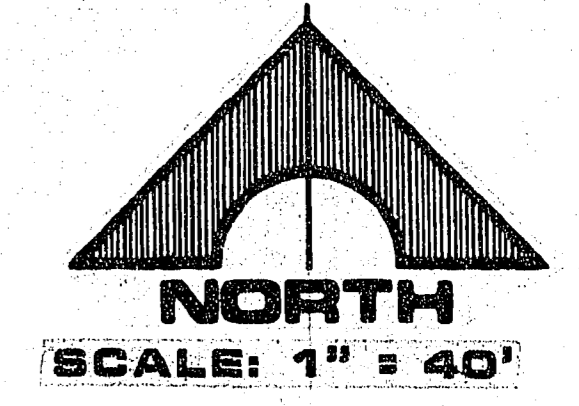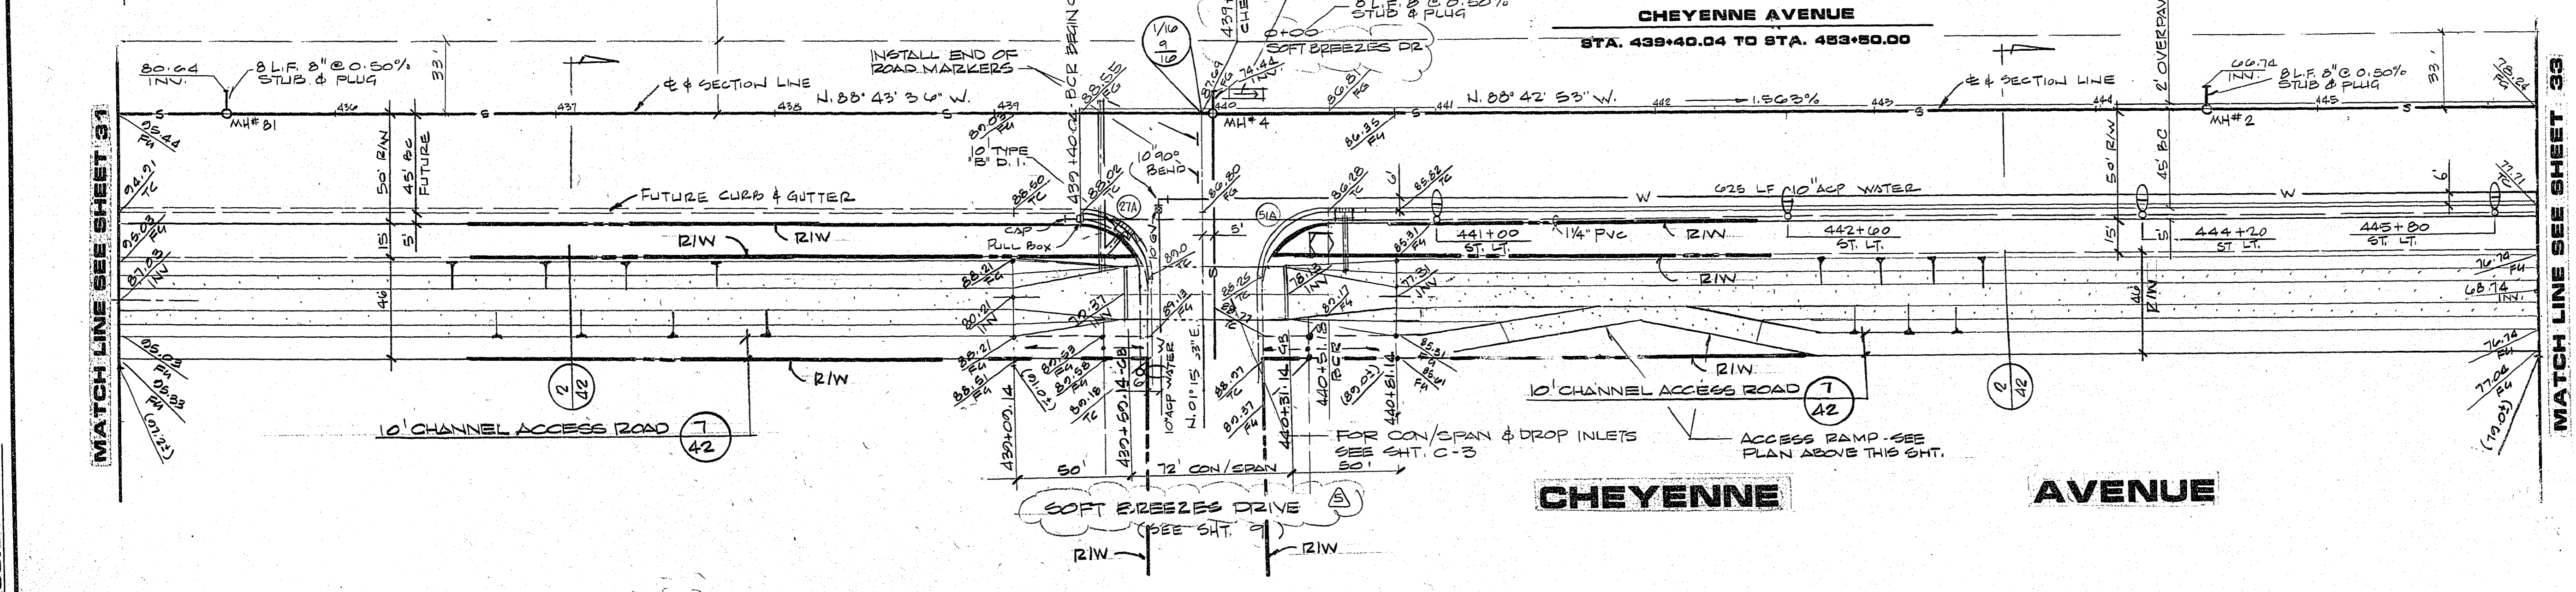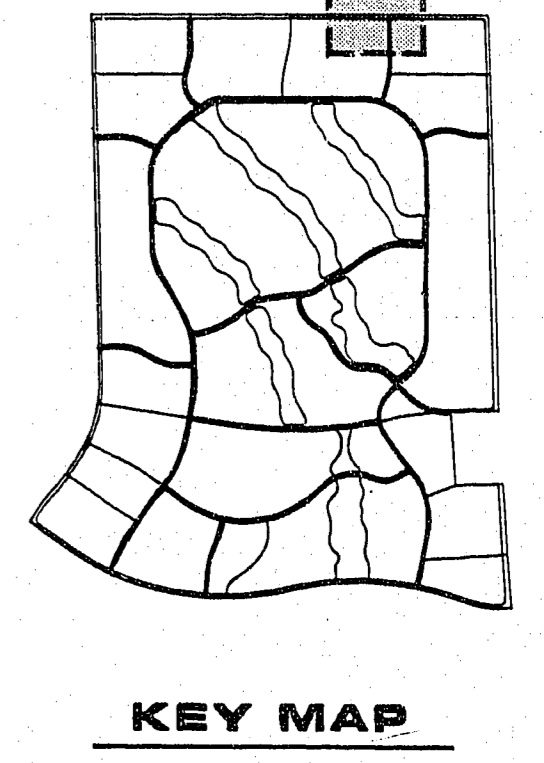

APPROVAL
CLV CHIEF LAND DEVELOPMENT
DATE

REVISIONS

REV.	DATE	DESCRIPTION
1	1-19-88	ADDED GENERAL STAGE DIMENSIONS
2	1-19-88	ADDED CHANNEL PROFILE
3	1-19-88	REVISED CHANNEL PROFILE
4	1-19-88	ADDED CHANNEL ACCESS RAMP

DESERT SHORES - PHASE 1
CHEYENNE AVENUE
STA. 435+00.00 TO STA. 446+00.00

G.C. WALLACE, INC.
Engineering/Architecture
1555 SOUTH RAINBOW BLVD., LAS VEGAS, NEVADA 89102

SHEET 32 OF 43 SHEETS

1074-1248-1