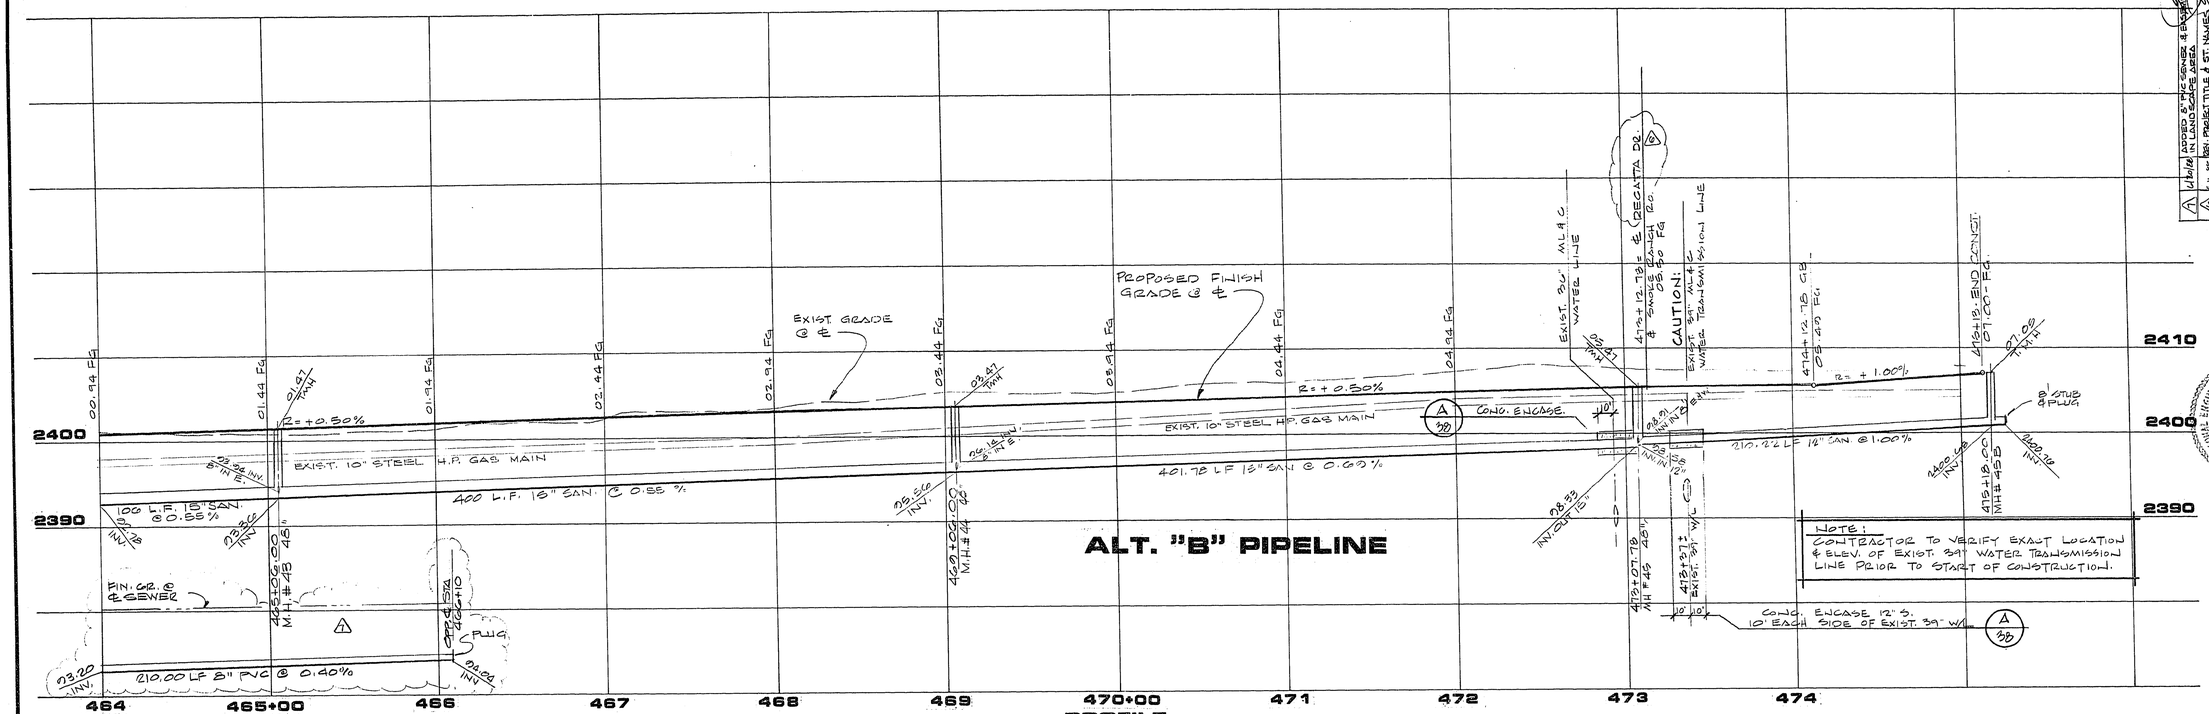

NOTES:

1. STATIONING SHOWN FOR ENCASEMENT IS NOMINAL. END ENCASEMENT WITHIN 6. INCHES OF PIPE JOINT.
2. THE CONTRACTOR MAY USE ASTM C-76, CLASS III REINFORCED CONCRETE PIPE INSTEAD OF ENCASEMENT.

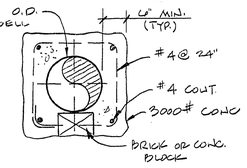

SEWER LINE ENCASEMENT

A / 38

CAUTION HIGH PRESSURE GAS MAIN. NOTIFY SOUTHWEST GAS CORP. AT 365-2296 24 HRS IN ADVANCE OF ANY CONST.

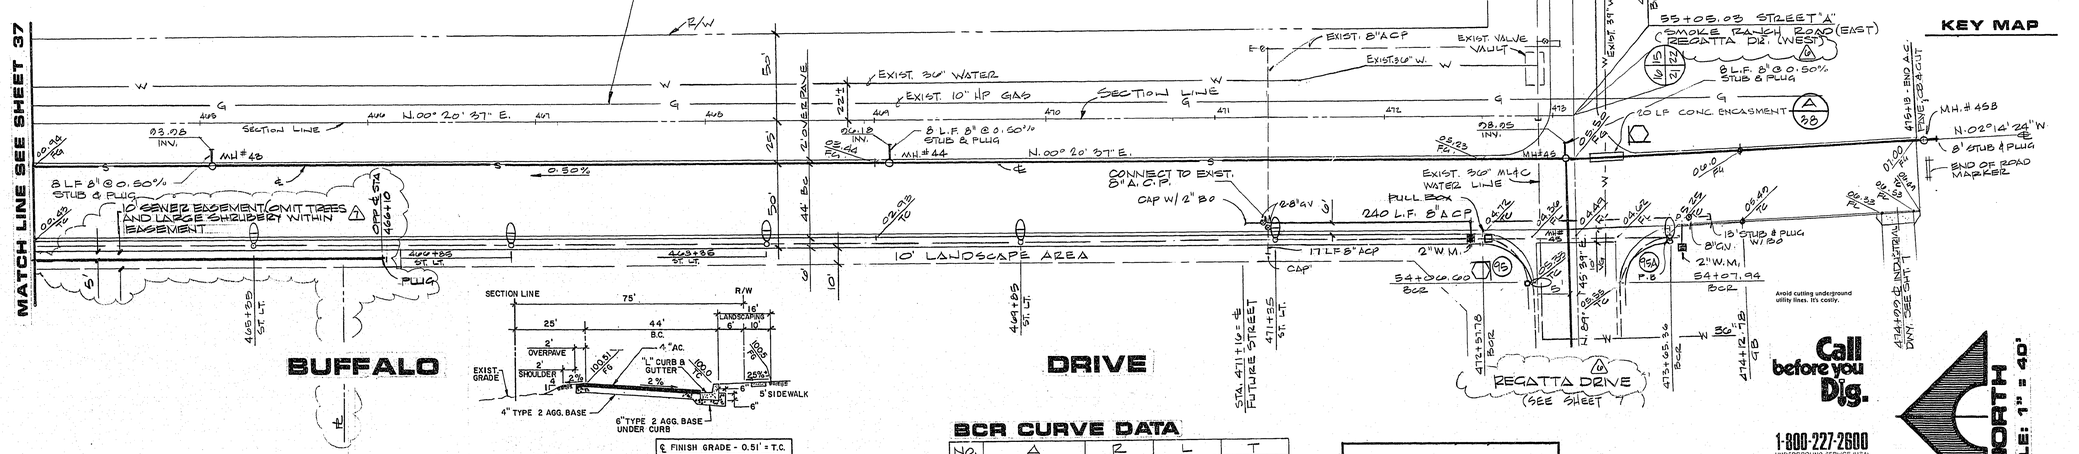

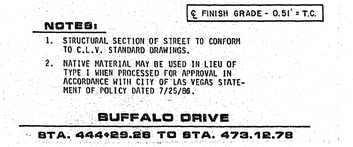

NOTES:

1. STRUCTURAL SECTION OF STREET TO CONFORM TO C.L.V. STANDARD DRAWINGS.
2. NATIVE MATERIAL MAY BE USED IN LIEU OF TYPE 1 WHEN PROCESSED FOR APPROVAL IN ACCORDANCE WITH CITY OF LAS VEGAS STATEMENT OF POLICY DATED 7/25/86.

BUFFALO DRIVE

STA. 444+29.28 TO STA. 473.12.78

BCR CURVE DATA

NO.	Δ	R	L	T
95	89° 25' 01"	30.00'	46.82'	29.70'
95A	87° 59' 57"	30.00'	46.08'	28.97'

NOTE:

SANITARY SEWER PIPE TO BE PVC

APPROVAL

CLV CHIEF LAND DEVELOPMENT — DATE 9-22-87

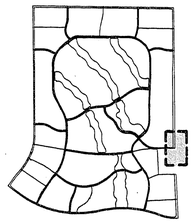

KEY MAP

REV	DATE	DESCRIPTION
1	10-29-87	REVISED SEWER INVERT ELEV'S.
2	10-5-87	ADDED SEWER STUBS & MANHOLES
3	11/16/87	CHANGED PIPE SIZE AND ADDED
4	11-18-88	SEWER & WATER ADDED
5	9-14-88	REV. 1ST PLANCHECK & DATE
6	1-4-89	ADDED 8" PVC SEWER & ENCASEMENT IN LAND SCAPE AREA.
7	1/16/90	
8	5-14-90	REV. PROJECT TITLE & ST. NAMES

RECOMMENDED: Jack D. Mitchell — DATE 1-17-88

R.E. NO. 1243

G.C. WALLACE, INC. Engineering/Architecture — 1555 SOUTH RAINBOW BLVD / LAS VEGAS, NEVADA 89102

R.A. HOMES

DESERT SHORES - PHASE 1

BUFFALO DRIVE

STA. 464+00.00 TO STA. 473+65.36

SHEET 38 OF 43 SHEETS

JOB NO. 660.009 9-14-87

8/84 DIETERICH-POST 6532B

1074-1248-1