



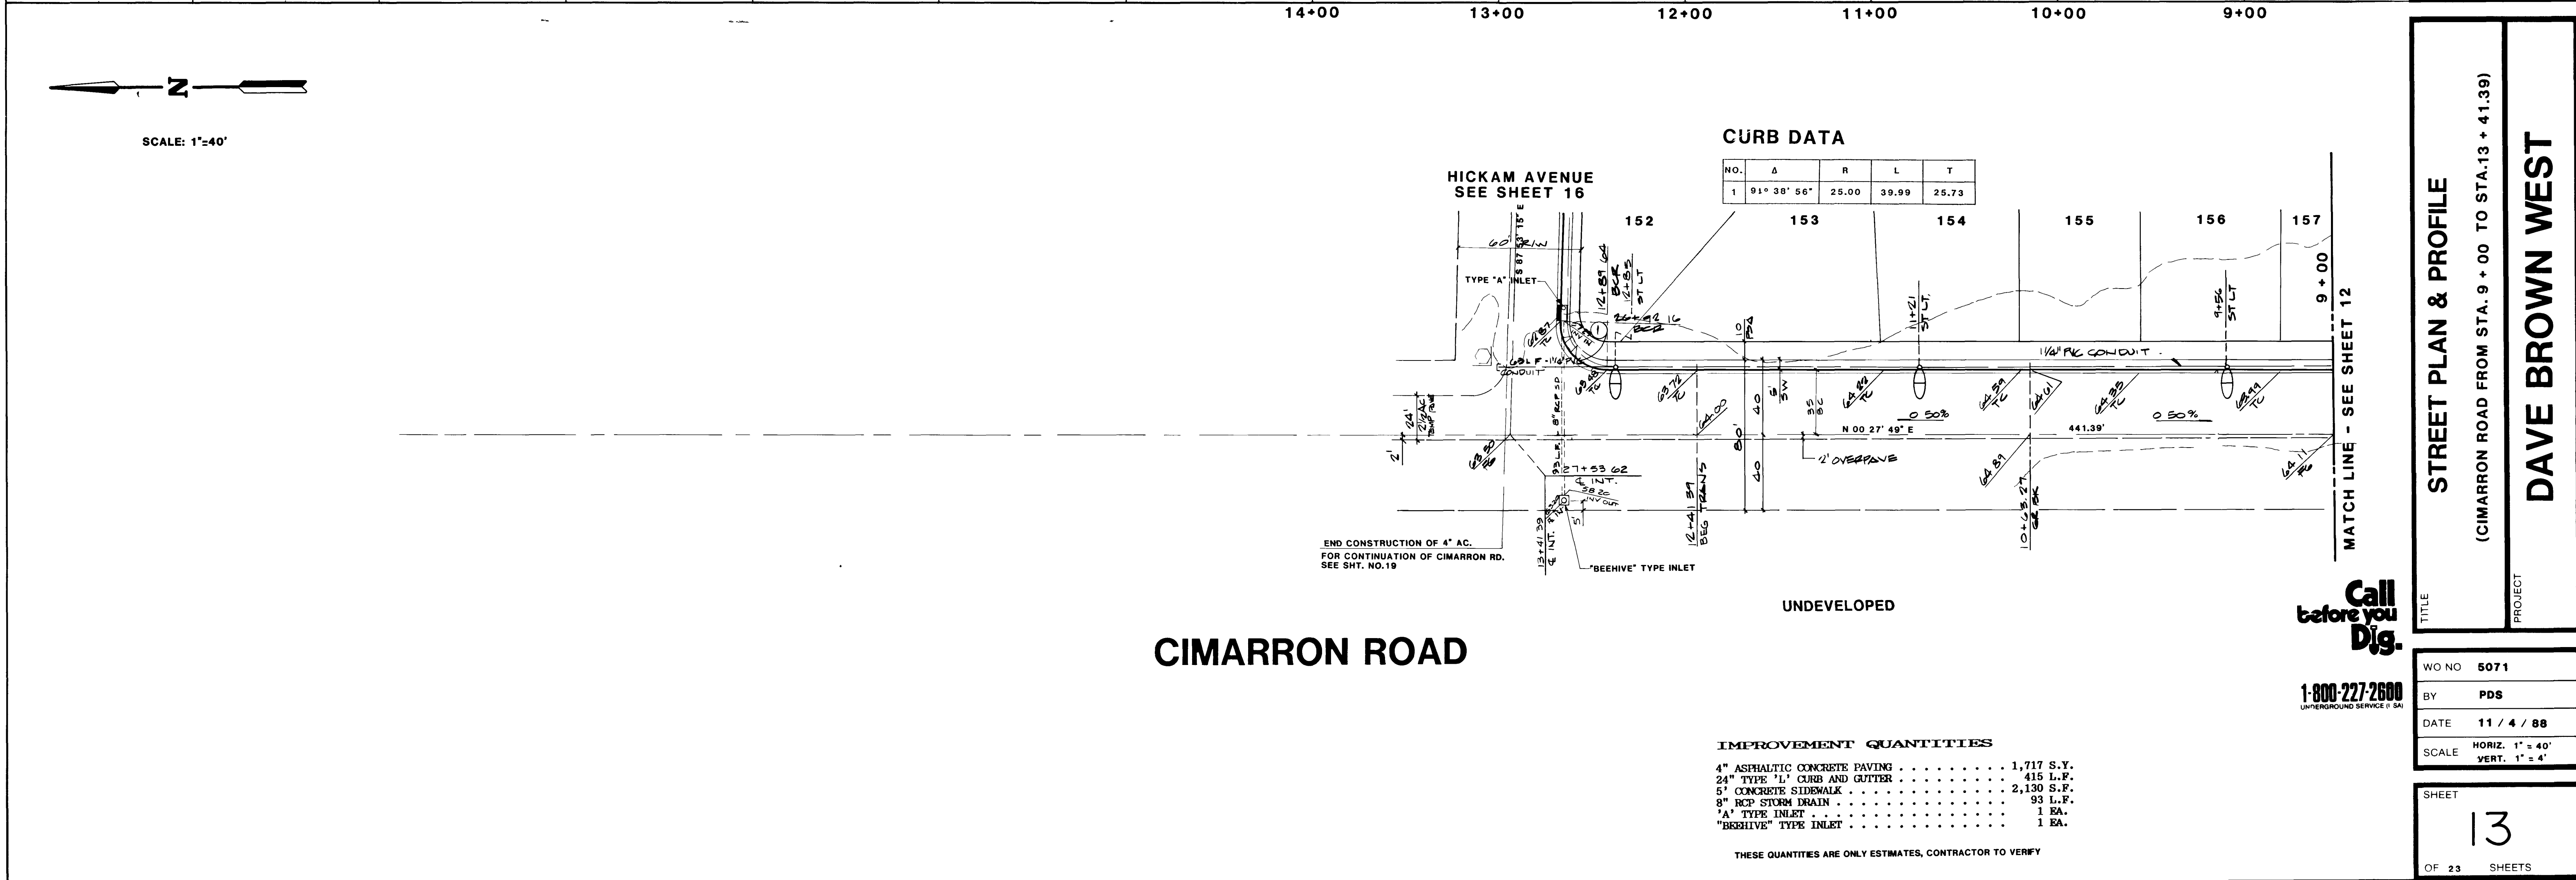

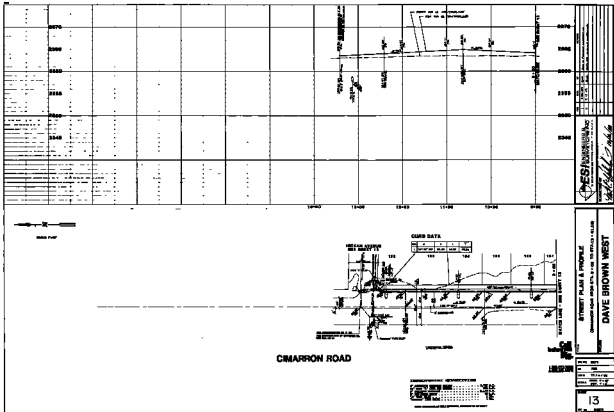

6414

1075-407