
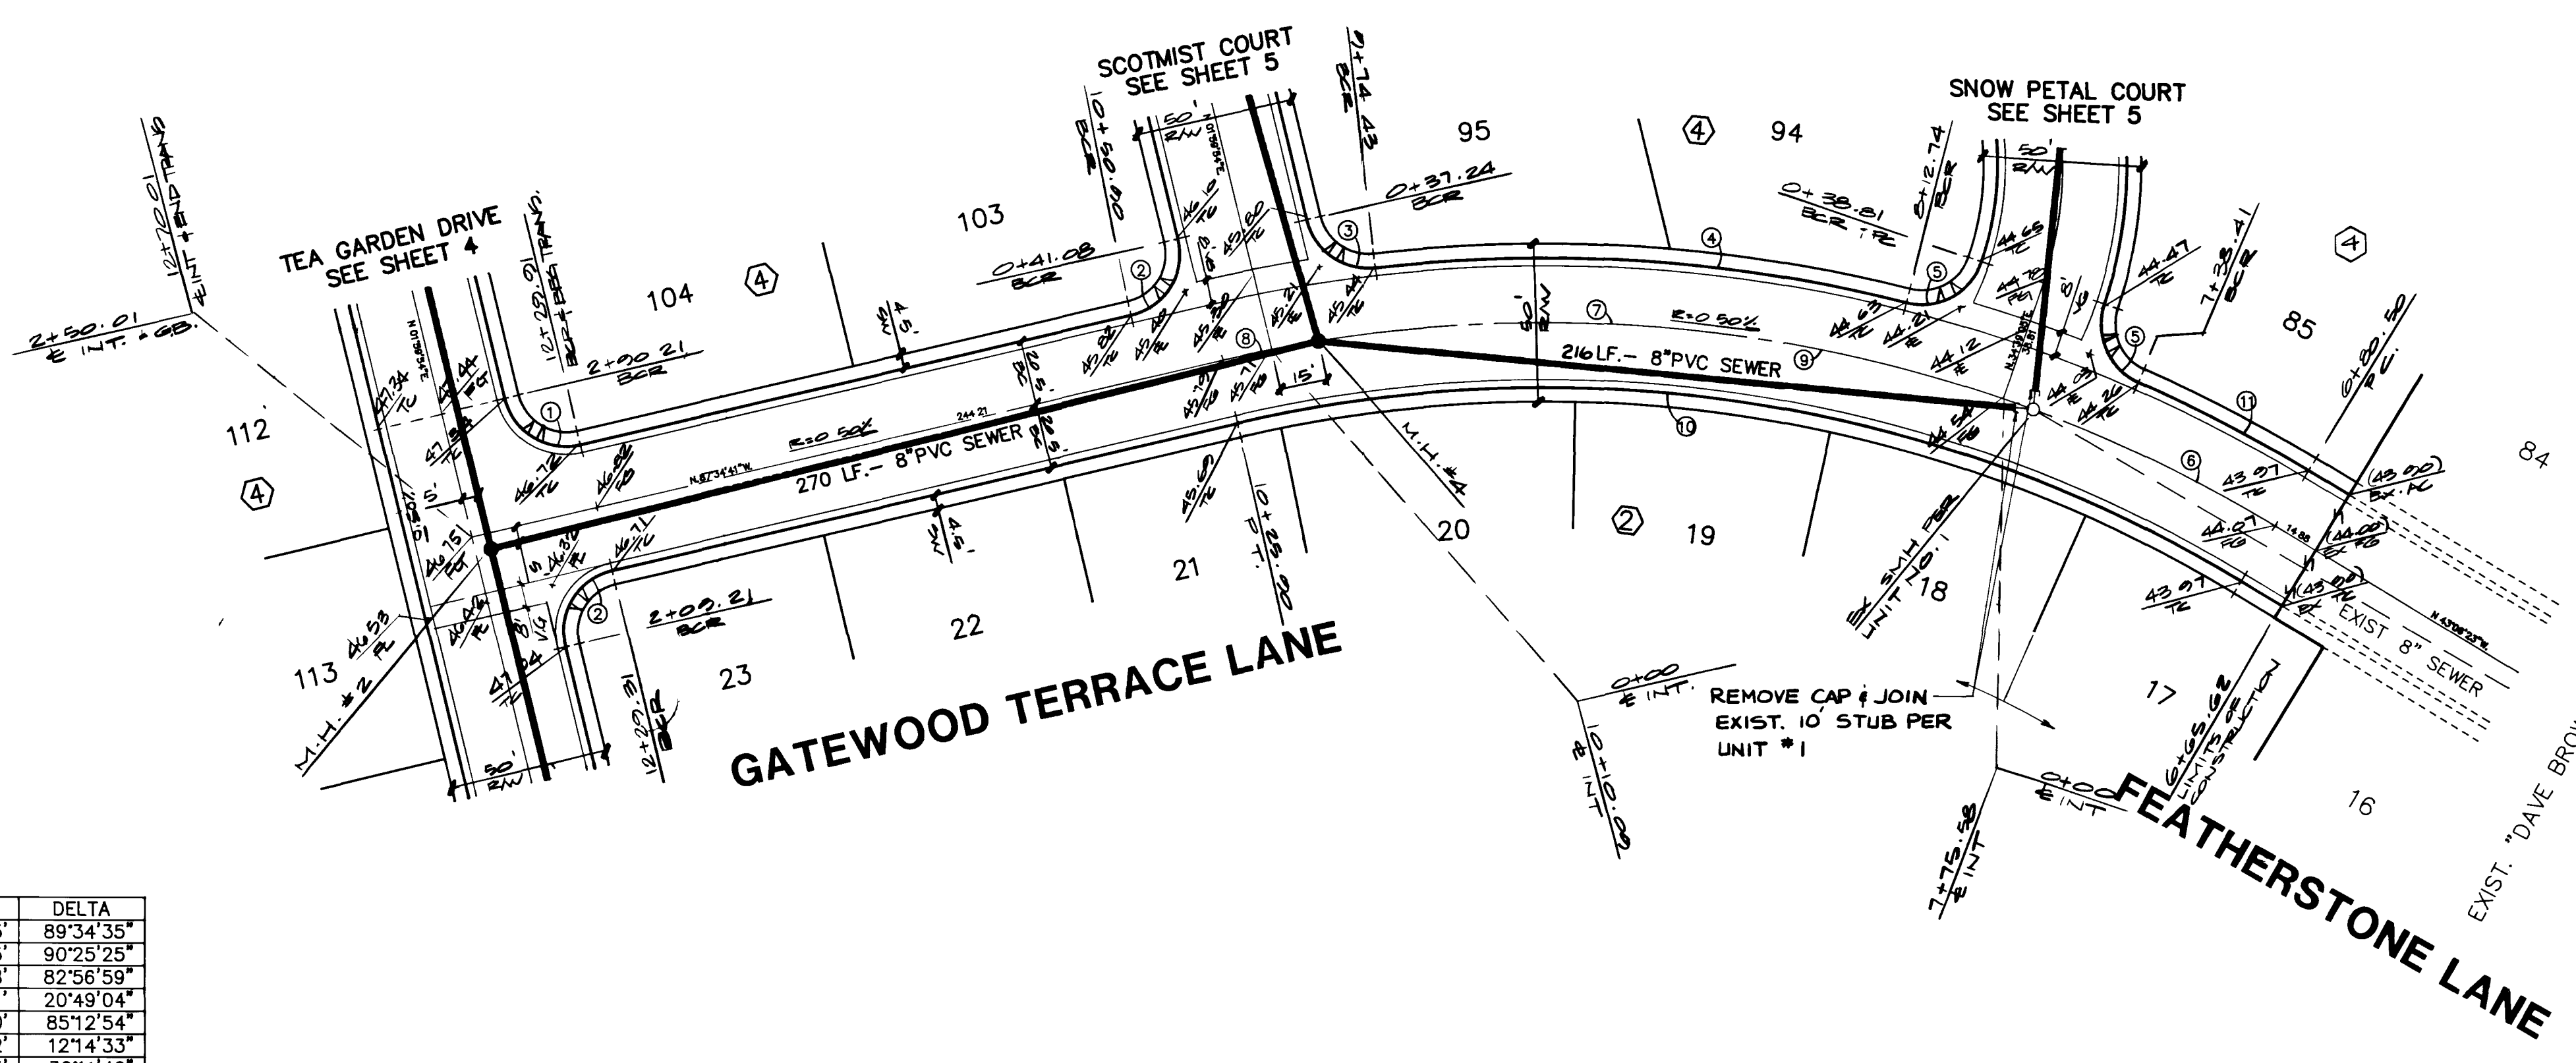


REV	DATE	BY	REVISION
1	12-28-88	CS	REV. QUANTITY ESTIMATE
2	2-15-89	CS	REV. 5\"/>
3	6-24-89	TB	REV. SEWER & STUB LENGTHS
4	12-28-90	PD	REV. STUBS AT THE GATEWOOD & ADDRESS V.G. (7-7-7)



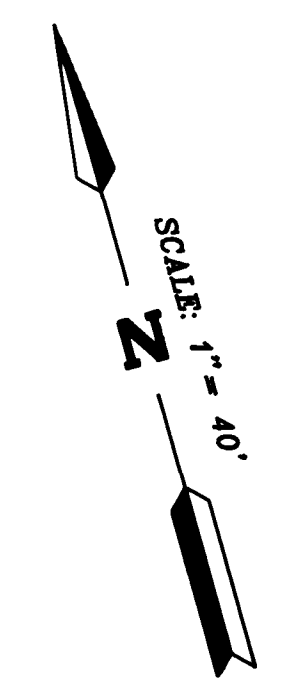

CURVE DATA TABLE

CURVE	RADIUS	LENGTH	TANGENT	DELTA
1	20.00'	31.27'	19.85'	89°34'35"
2	20.00'	31.56'	20.15'	90°25'25"
3	20.00'	28.95'	17.68'	82°56'59"
4	465.50'	169.13'	85.51'	20°43'04"
5	20.00'	29.75'	18.40'	85°12'54"
6	445.00'	95.08'	47.72'	12°14'33"
7	445.00'	234.51'	120.05'	30°11'40"
8	445.00'	15.81'	7.90'	02°02'06"
9	445.00'	345.40'	181.93'	44°28'18"
10	424.50'	329.49'	173.55'	44°28'18"
11	465.50'	60.59'	30.34'	07°27'26"

QUANTITY ESTIMATE

2.0" ASPHALTIC CONCRETE PAVING	2,382 S.Y.
30" ROLL TYPE CURB & GUTTER	1,034 L.F.
CONCRETE SIDEWALK	4,603 S.F.
SAWCUT	36 L.F.

THESE QUANTITIES ARE ONLY ESTIMATES, CONTRACTOR TO VERIFY



1-800-227-2600  
 UNDERGROUND SERVICE UTILITIES

TITLE: STREET & SEWER PLAN & PROFILE  
 (GATEWOOD TERRACE LANE & FEATHERSTONE LANE)  
 PROJECT: DAVE BROWN WEST UNIT NO. 2

WO NO	5261
BY	P. CHAO
DATE	12/88
SCALE	HORIZ. 1" = 40' VERT. 1" = 4'

SHEET **3**  
 OF 8 SHEETS

6439

1074-4077-2

