
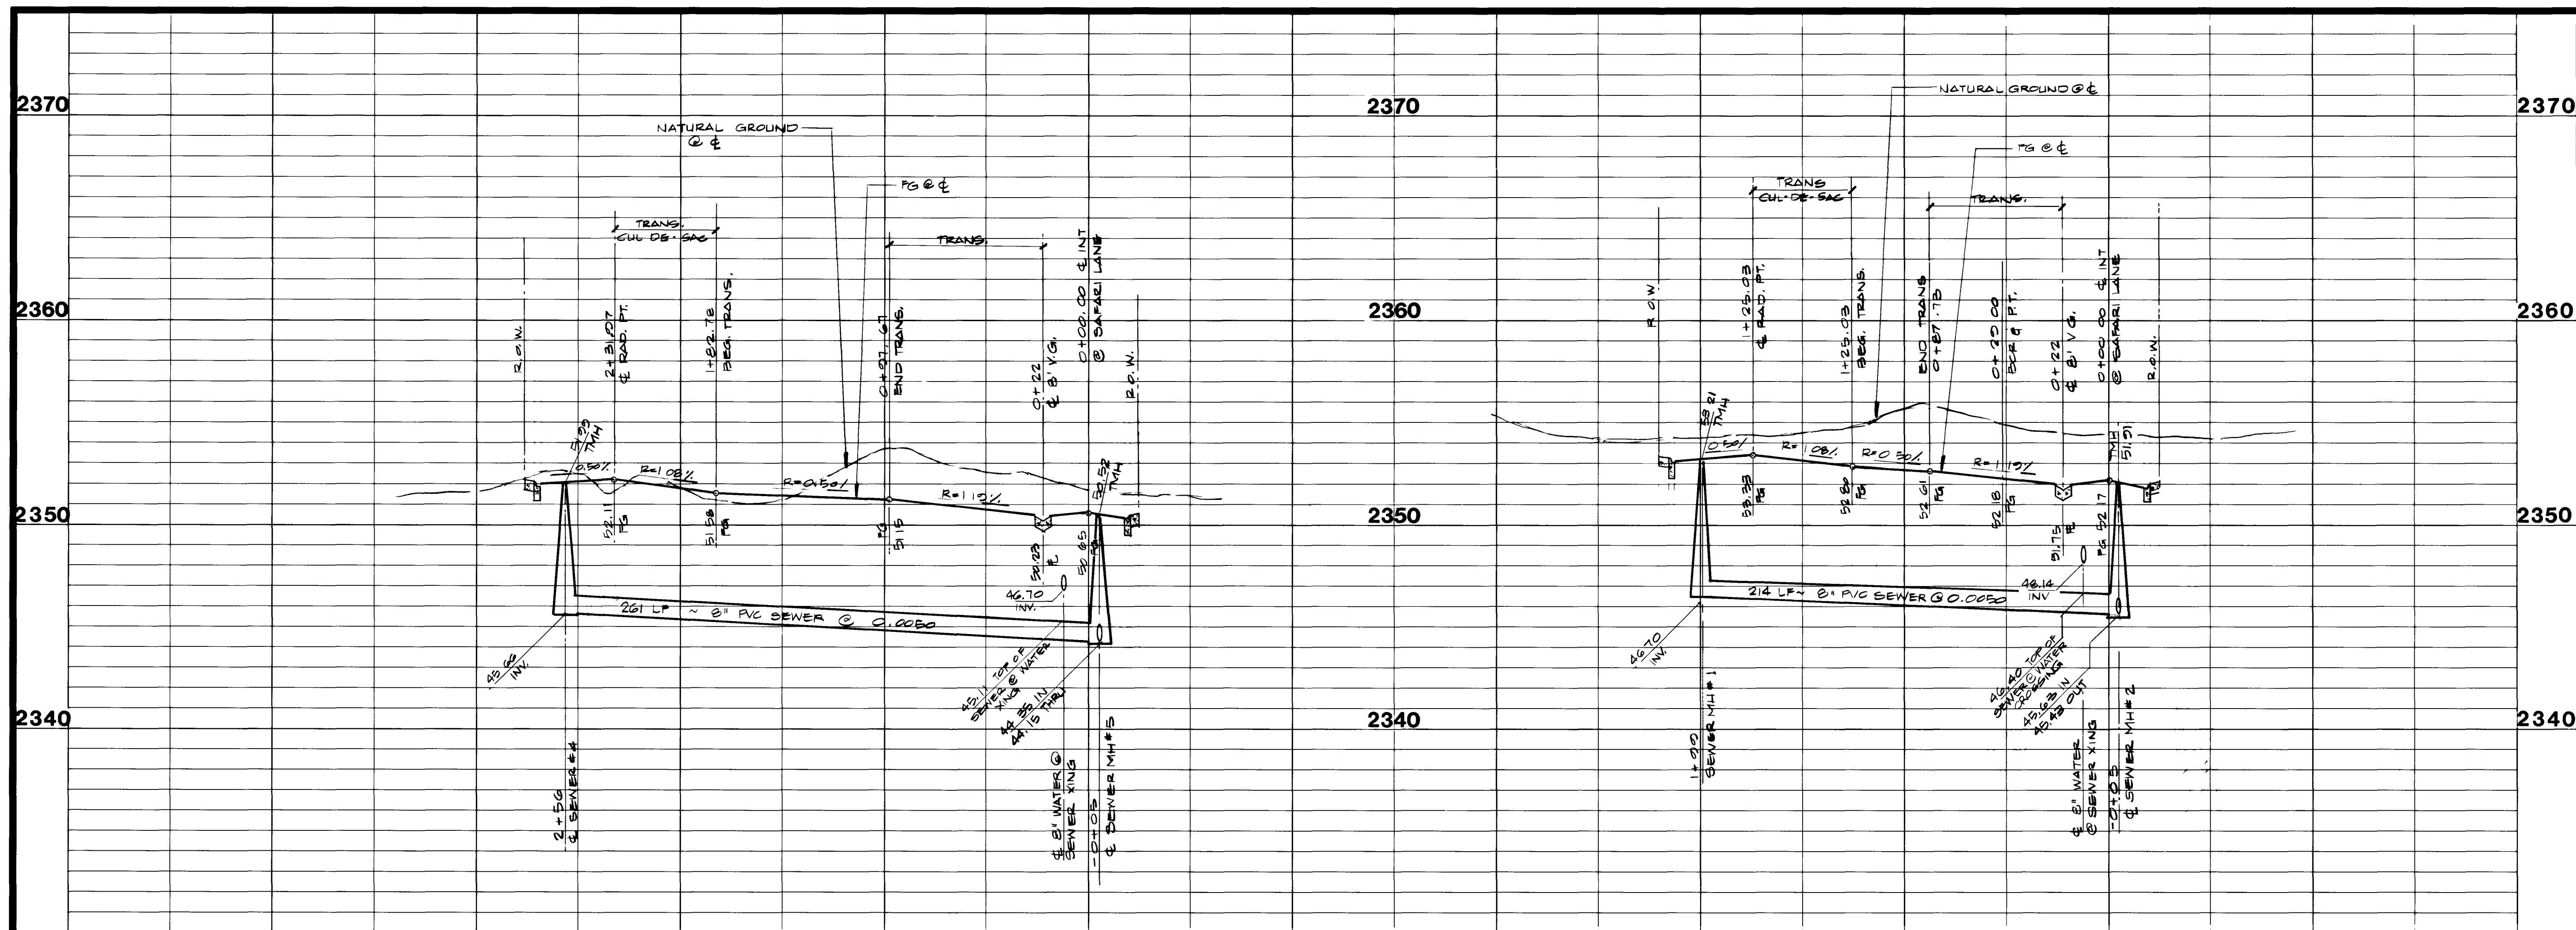


EXISTING
HICKHAM AVENUE

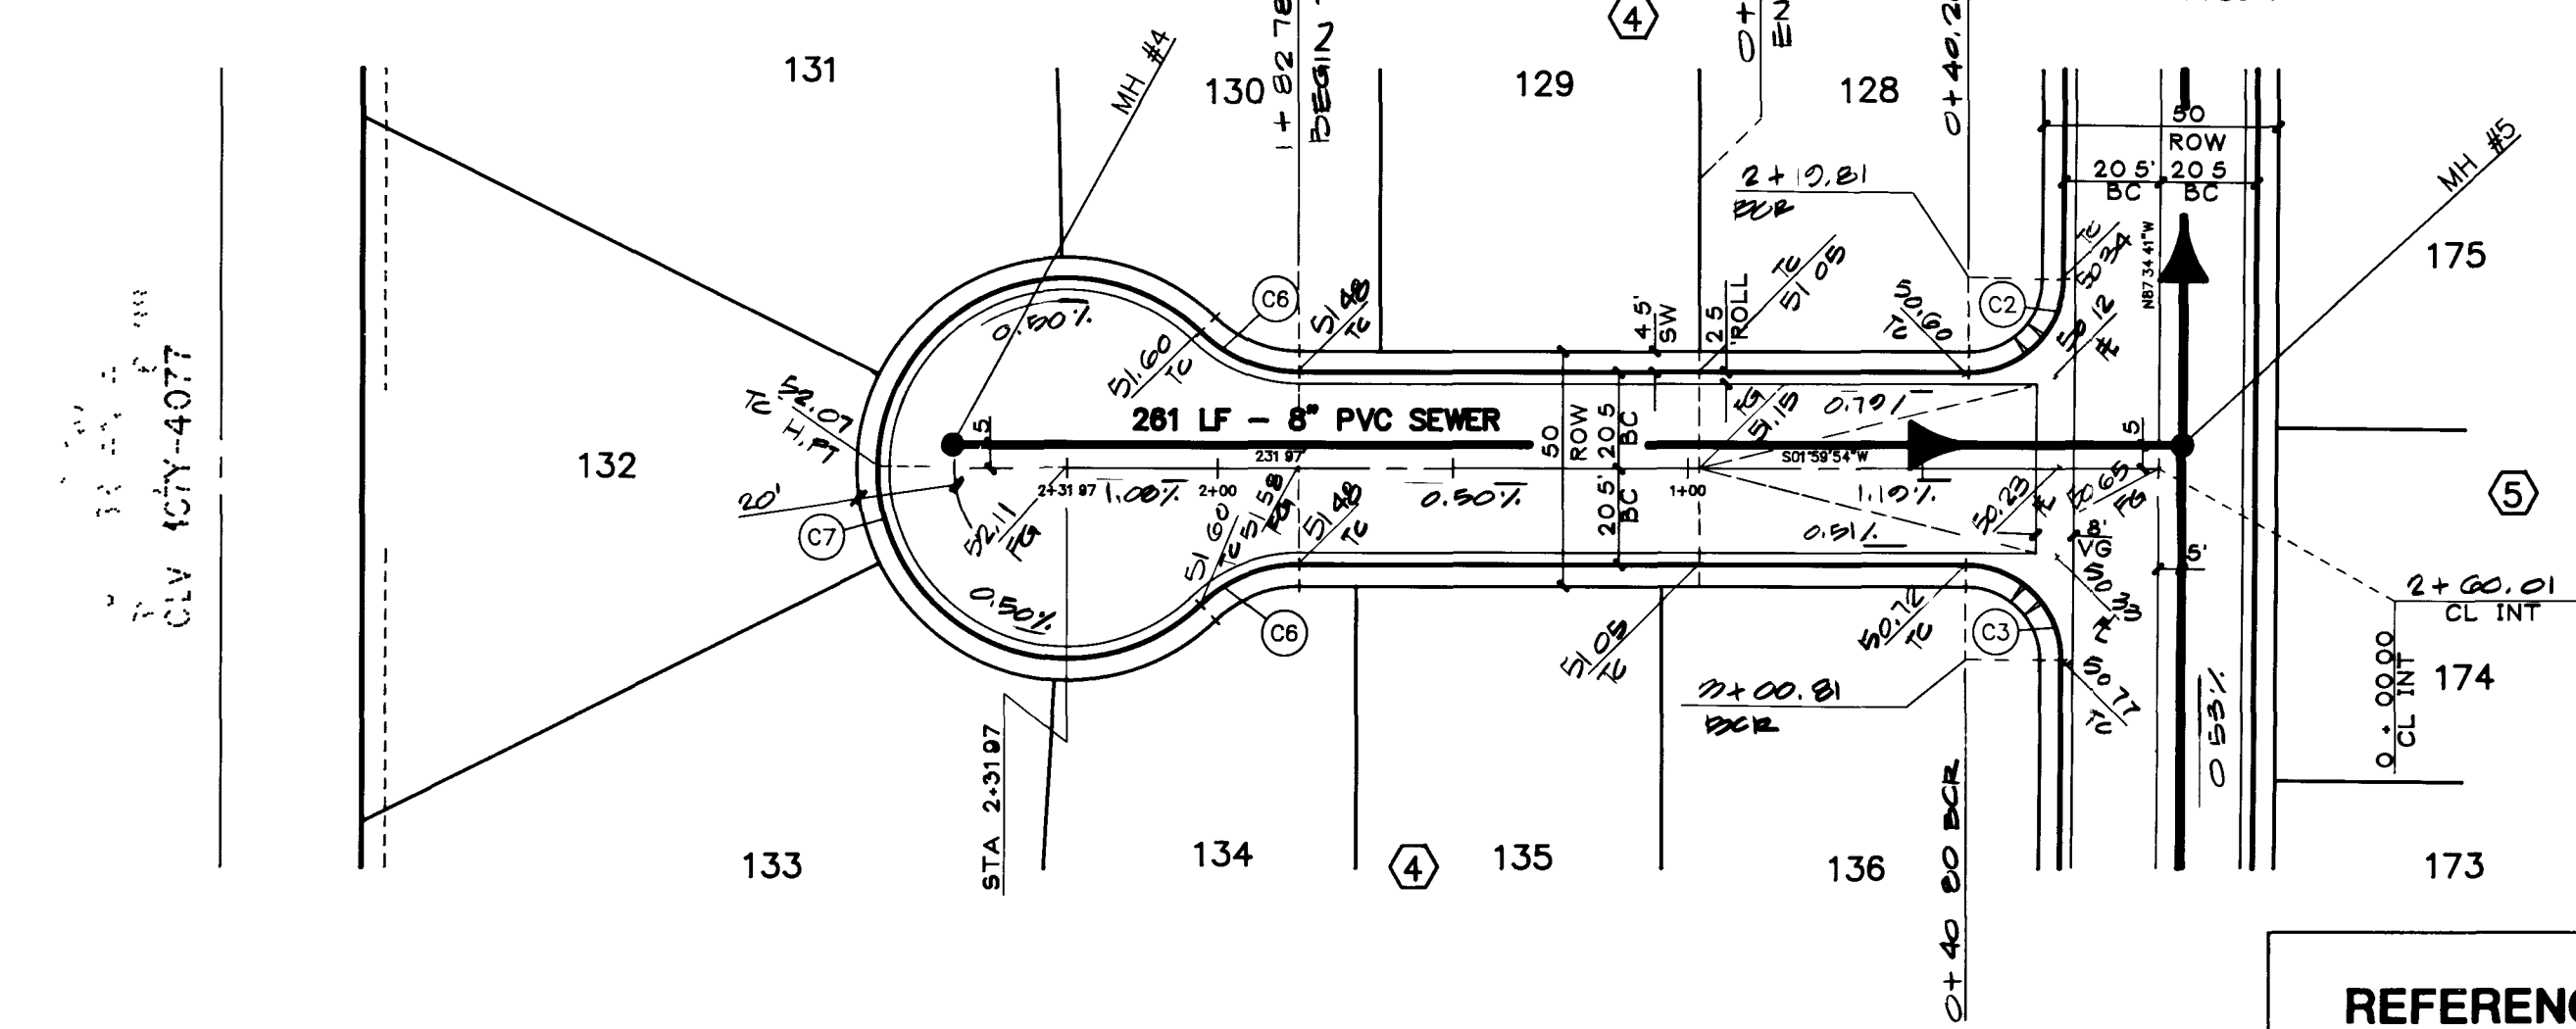

CURVE DATA TABLE

No	RADIUS	DELTA	LENGTH	TANGENT
C1	97.02'	30°25'25"	51.52'	26.38'
C2	20.00'	89°34'35"	31.27'	19.85'
C3	20.00'	90°25'25"	31.56'	20.15'
C4	20.00'	72°52'22"	25.44'	14.76'
C5	20.00'	120°25'25"	42.04'	34.94'
C6	30.00'	44°14'57"	23.17'	12.20'
C7	40.50'	268°29'54"	189.79'	---

REFERENCE NOTE


ALL IMPROVEMENTS SHOWN HEREON SHALL BE REFERENCED TO THE OVERALL ROUGH GRADING PLAN ENTITLED, "DAVE BROWN WEST", APPROVED ON 6-18-83. CLV #107Y-4077

WHEATSTONE COURT

NOTE:

EXISTING UTILITY LOCATIONS SHOWN HEREIN ARE APPROXIMATE ONLY. IT SHALL BE THE CONTRACTOR'S RESPONSIBILITY TO DETERMINE THE EXACT VERTICAL AND HORIZONTAL LOCATION OF ALL EXISTING UNDERGROUND UTILITIES PRIOR TO COMMENCING CONSTRUCTION. NO REPRESENTATION IS MADE THAT ALL EXISTING UTILITIES ARE SHOWN HEREON. THE ENGINEER ASSUMES NO RESPONSIBILITY FOR UTILITIES NOT SHOWN OR UTILITIES NOT SHOWN IN THEIR PROPER LOCATION.

EXISTING
HICKHAM AVENUE

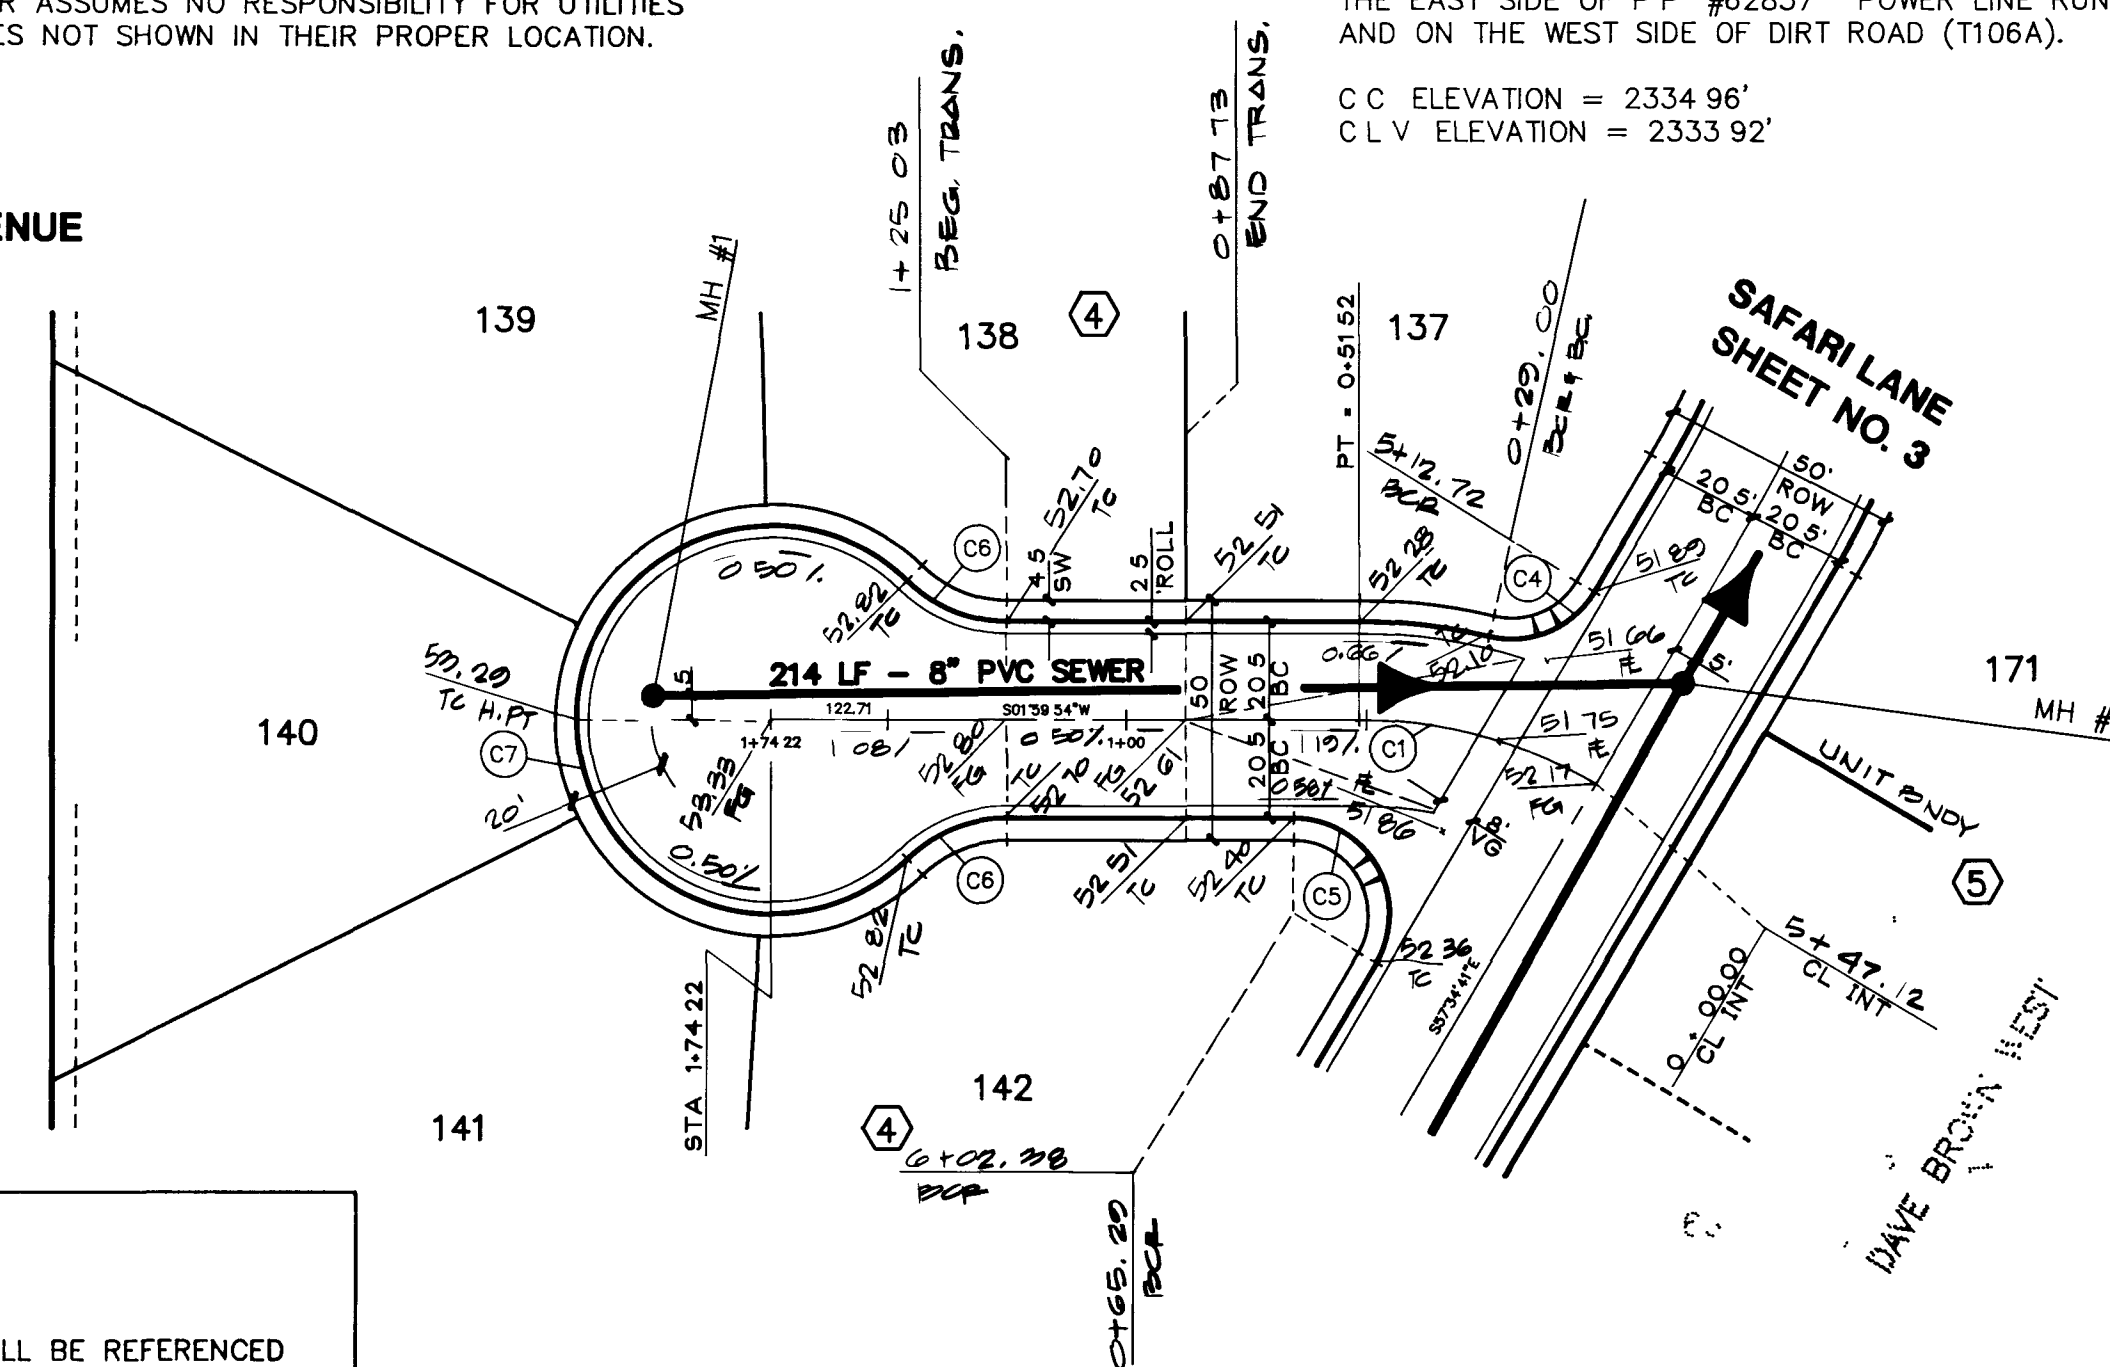

PURPLE RIDGE COURT

BENCHMARK

CLARK COUNTY BENCHMARK NO. C001001 RAILROAD SPIKE ON THE EAST SIDE OF P.P. #62837 POWER LINE RUNS NORTH/SOUTH AND ON THE WEST SIDE OF DIRT ROAD (T106A).

C.C. ELEVATION = 2334.96'
C.L.V. ELEVATION = 2333.92'

QUANTITY ESTIMATE

2" ASPHALTIC CONCRETE 2,145 SY
30" ROLL TYPE CURB & GUTTER 1,048 LF
CONCRETE VALLEY GUTTER 1,527 SF
CONCRETE SIDEWALK 4,714 SF

THESE QUANTITIES ARE ONLY ESTIMATES, CONTRACTOR TO VERIFY.

APRIL	REV	DATE	BY	REVISION
1	3-4-91	DA	NAME	REVISED TO DAVE BROWN WEST

ENGINEERS & SURVEYORS, INC.
DAVE BROWN WEST
CLV #107Y-4077
SUBMITTED BY: [Signature]
DATE: 2/91

TITLE	STREET & SEWER PLAN & PROFILE (WHEATSTONE COURT & PURPLE RIDGE COURT)
PROJECT	DAVE BROWN WEST UNIT 4 (Also Known as MOUNTAIN SHADOW ESTATES UNIT 4)

W.O. #	5263
BY	AMB
DATE	JAN 1991
SCALE	VERT. 1"=4' HORIZ. 1"=40'

SHEET	6
OF 9 SHEETS	

6450

107Y-4077-4

30

