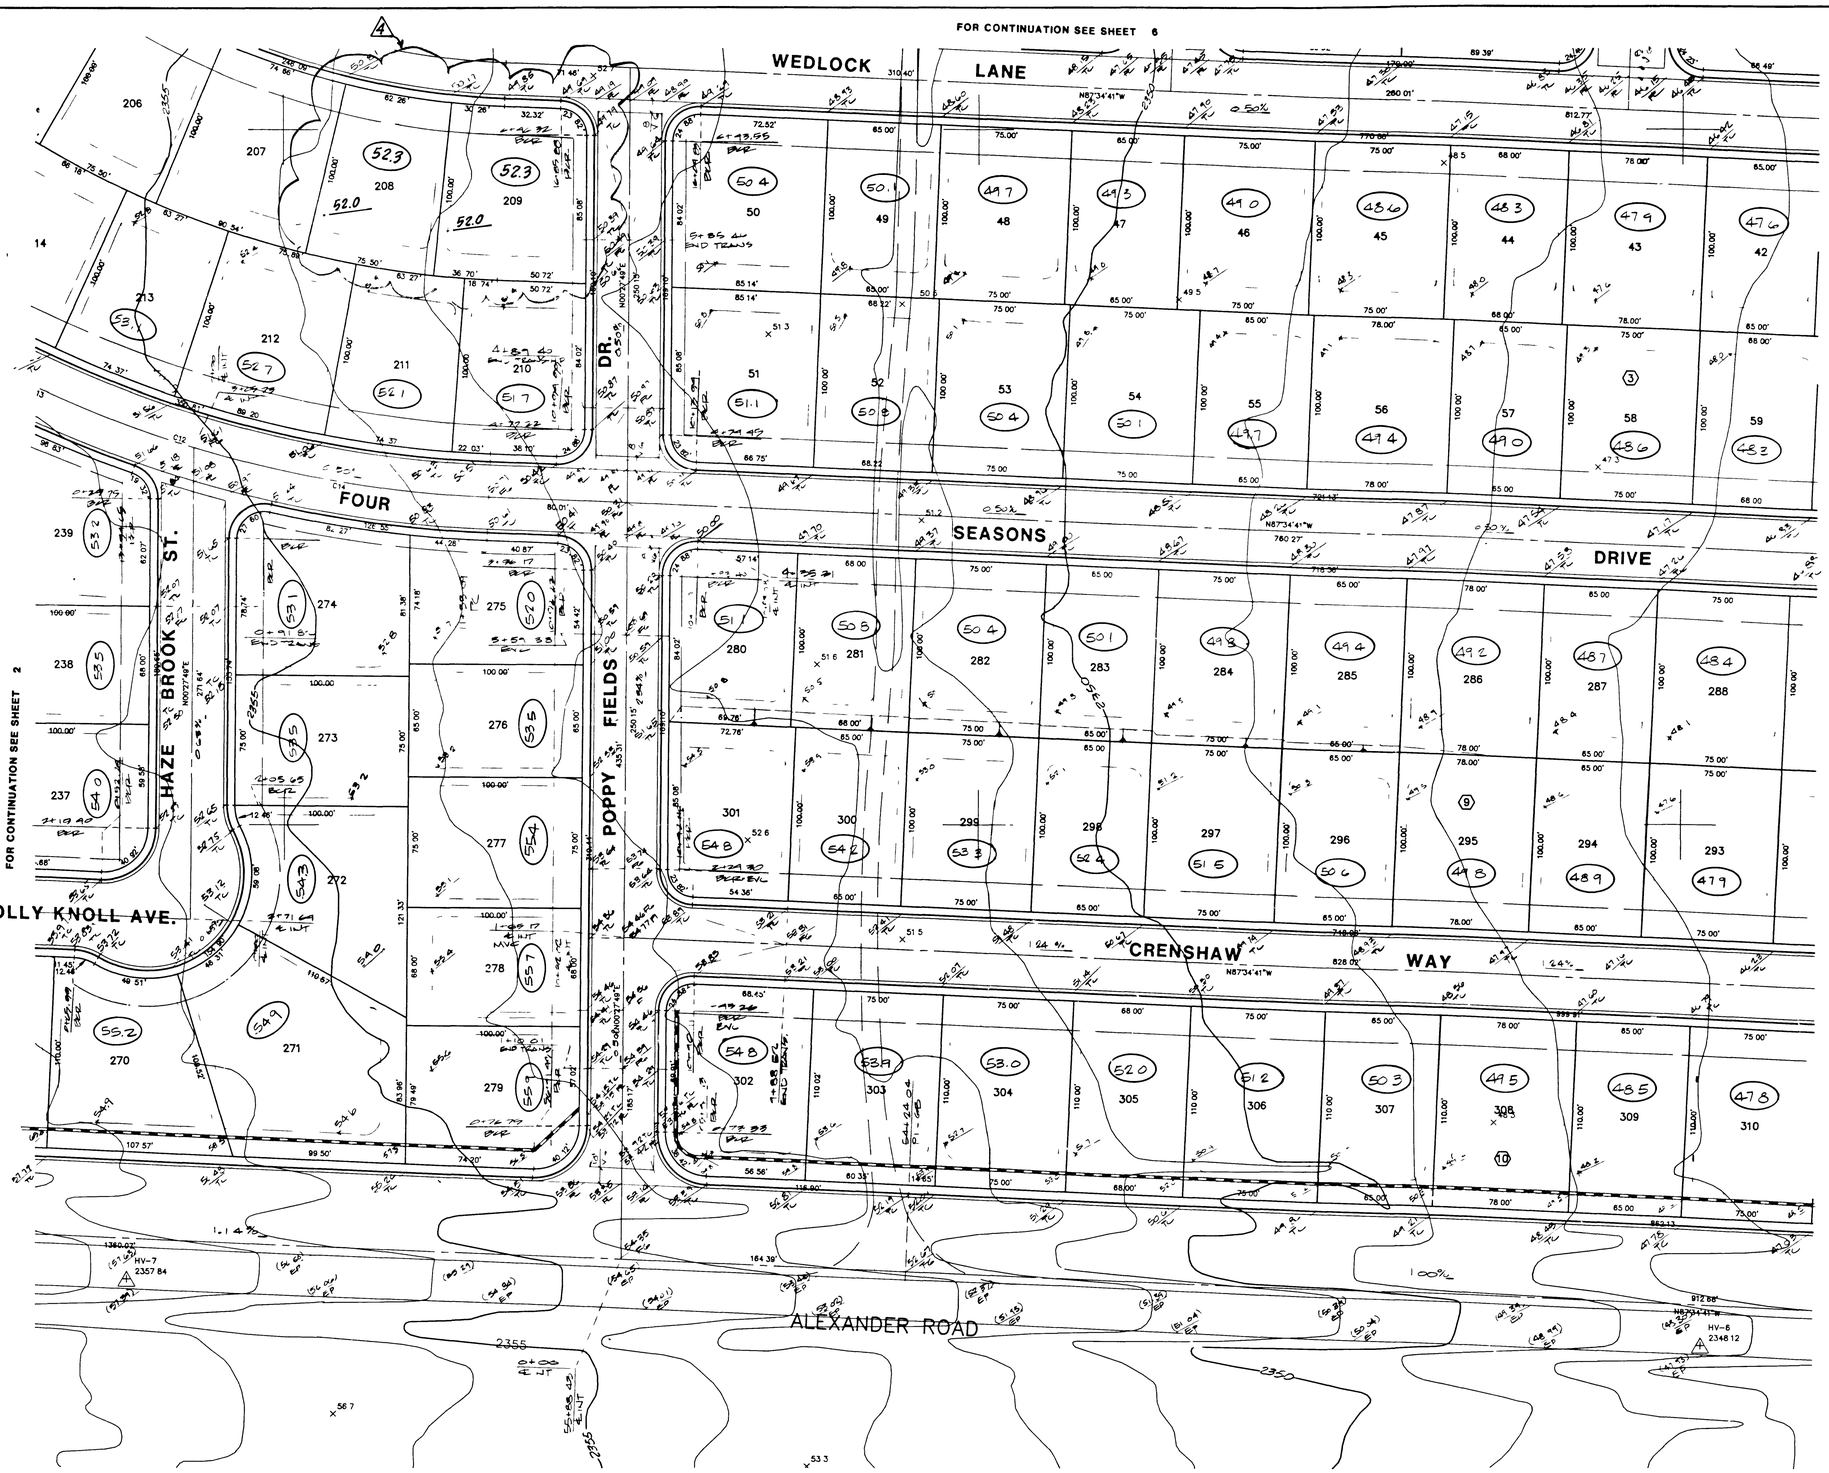

ENGINEER OF CHANGE

N

SCALE: 1"=40'

REV	DATE	BY	REVISION
1	1-7-93	G.J.	ADDED R.R. CROSSING
1	1-29-93	RDJ	REVISE ST. & PAD GRADES ON HALF BLOCK
2	2-15-93	G.J.	CHANGED R.R. CROSSING & ADDED ROAD
3	3-21-93	G.J.	REVISED ROAD AREA
4	11-15-93	RDJ	REV. GRADES LOTS 208 & 209 KN 11/17/93

SUBMITTED BY

ESI ENGINEERS & SURVEYORS, INC.

TITLE: GRADING PLAN

PROJECT: DAVE BROWN WEST

WO NO	5071
BY	J.E.L.
DATE	11-14-88
SCALE	1"=40'

SHEET 3 OF 7 SHEETS

6427

Grdg 1074-4077

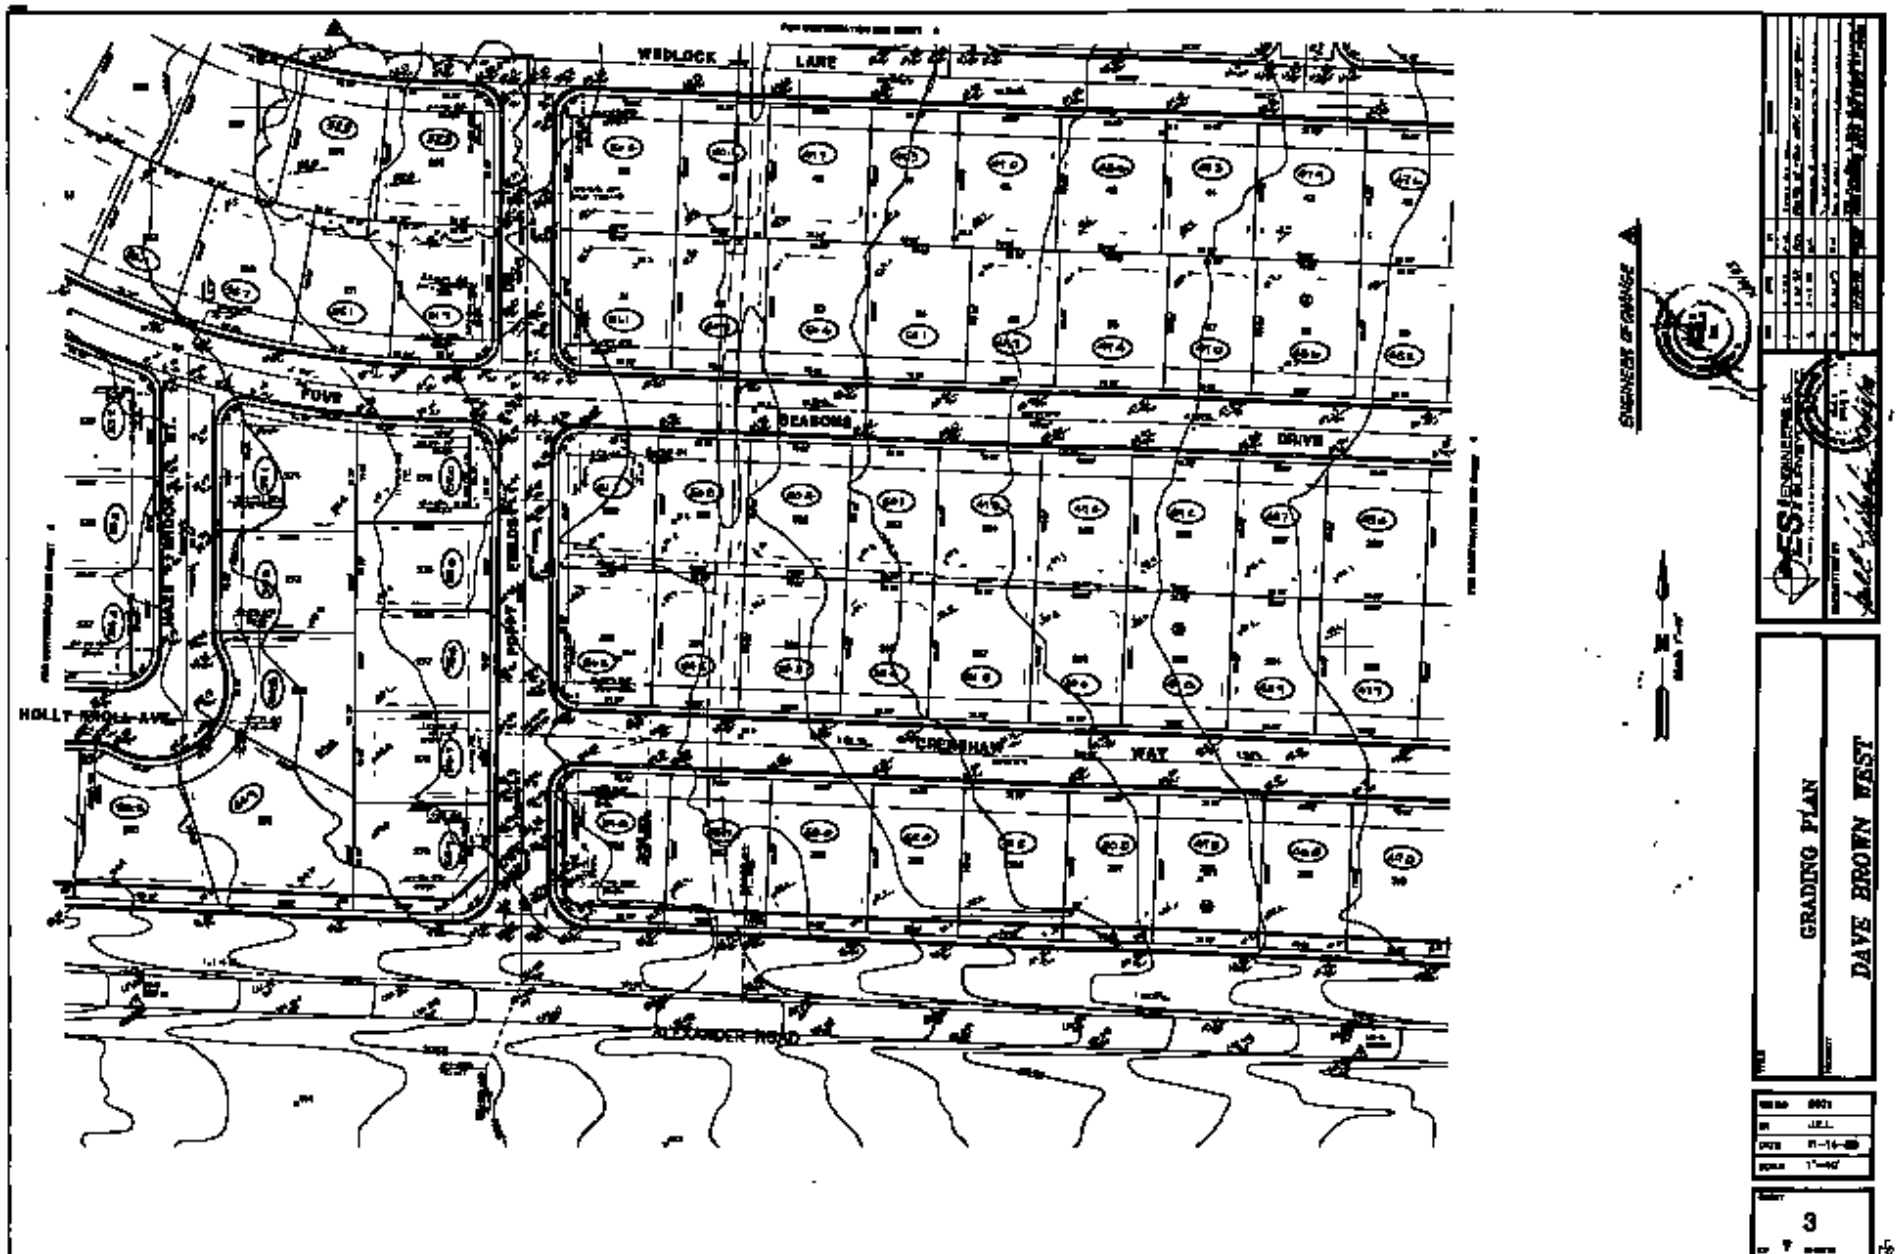
WEDLOCK LANE
FOVE
SEASONS DRIVE
CRENSHAW WAY
ALEXANDER ROAD
N
GRADING PLAN
DAVE BROWN WEST
3