
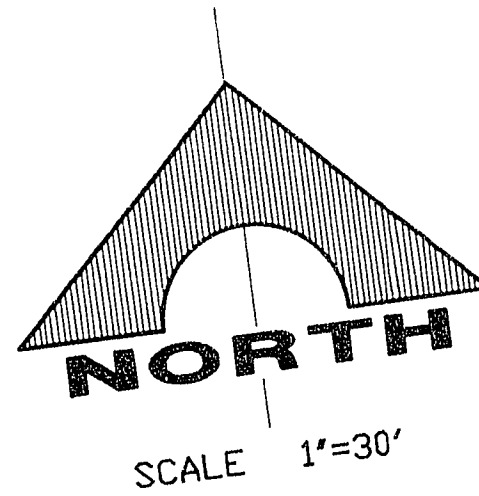


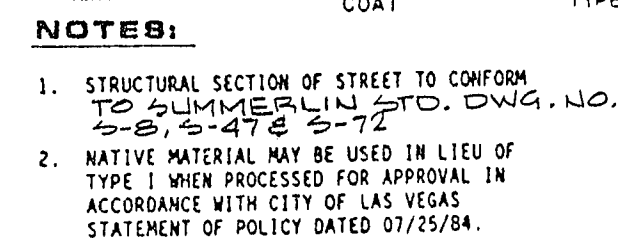

29.

074-4126

**LEWIS HOMES OF NEVADA
EVERGREEN IN THE HILLS AT SUMMIT
EVERGREEN CANYON DRIVE
STA. 6+22.95-STA. 13+04.55**

G.C. WALLACE, INC.
Engineering/Architecture

1555 SOUTH RAINBOW BLVD./LAS VEGAS, NEVADA 89102

[illegible]

REV	DATE	DESCRIPTION
-----	------	-------------