



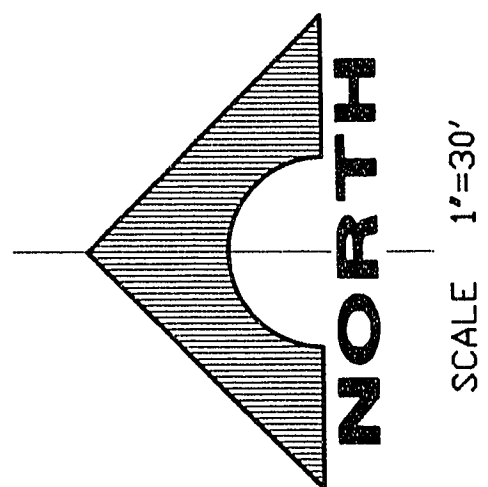


SCALE 1"=30'

EVERGREEN CANYON DRIVE SEE SHEET 6

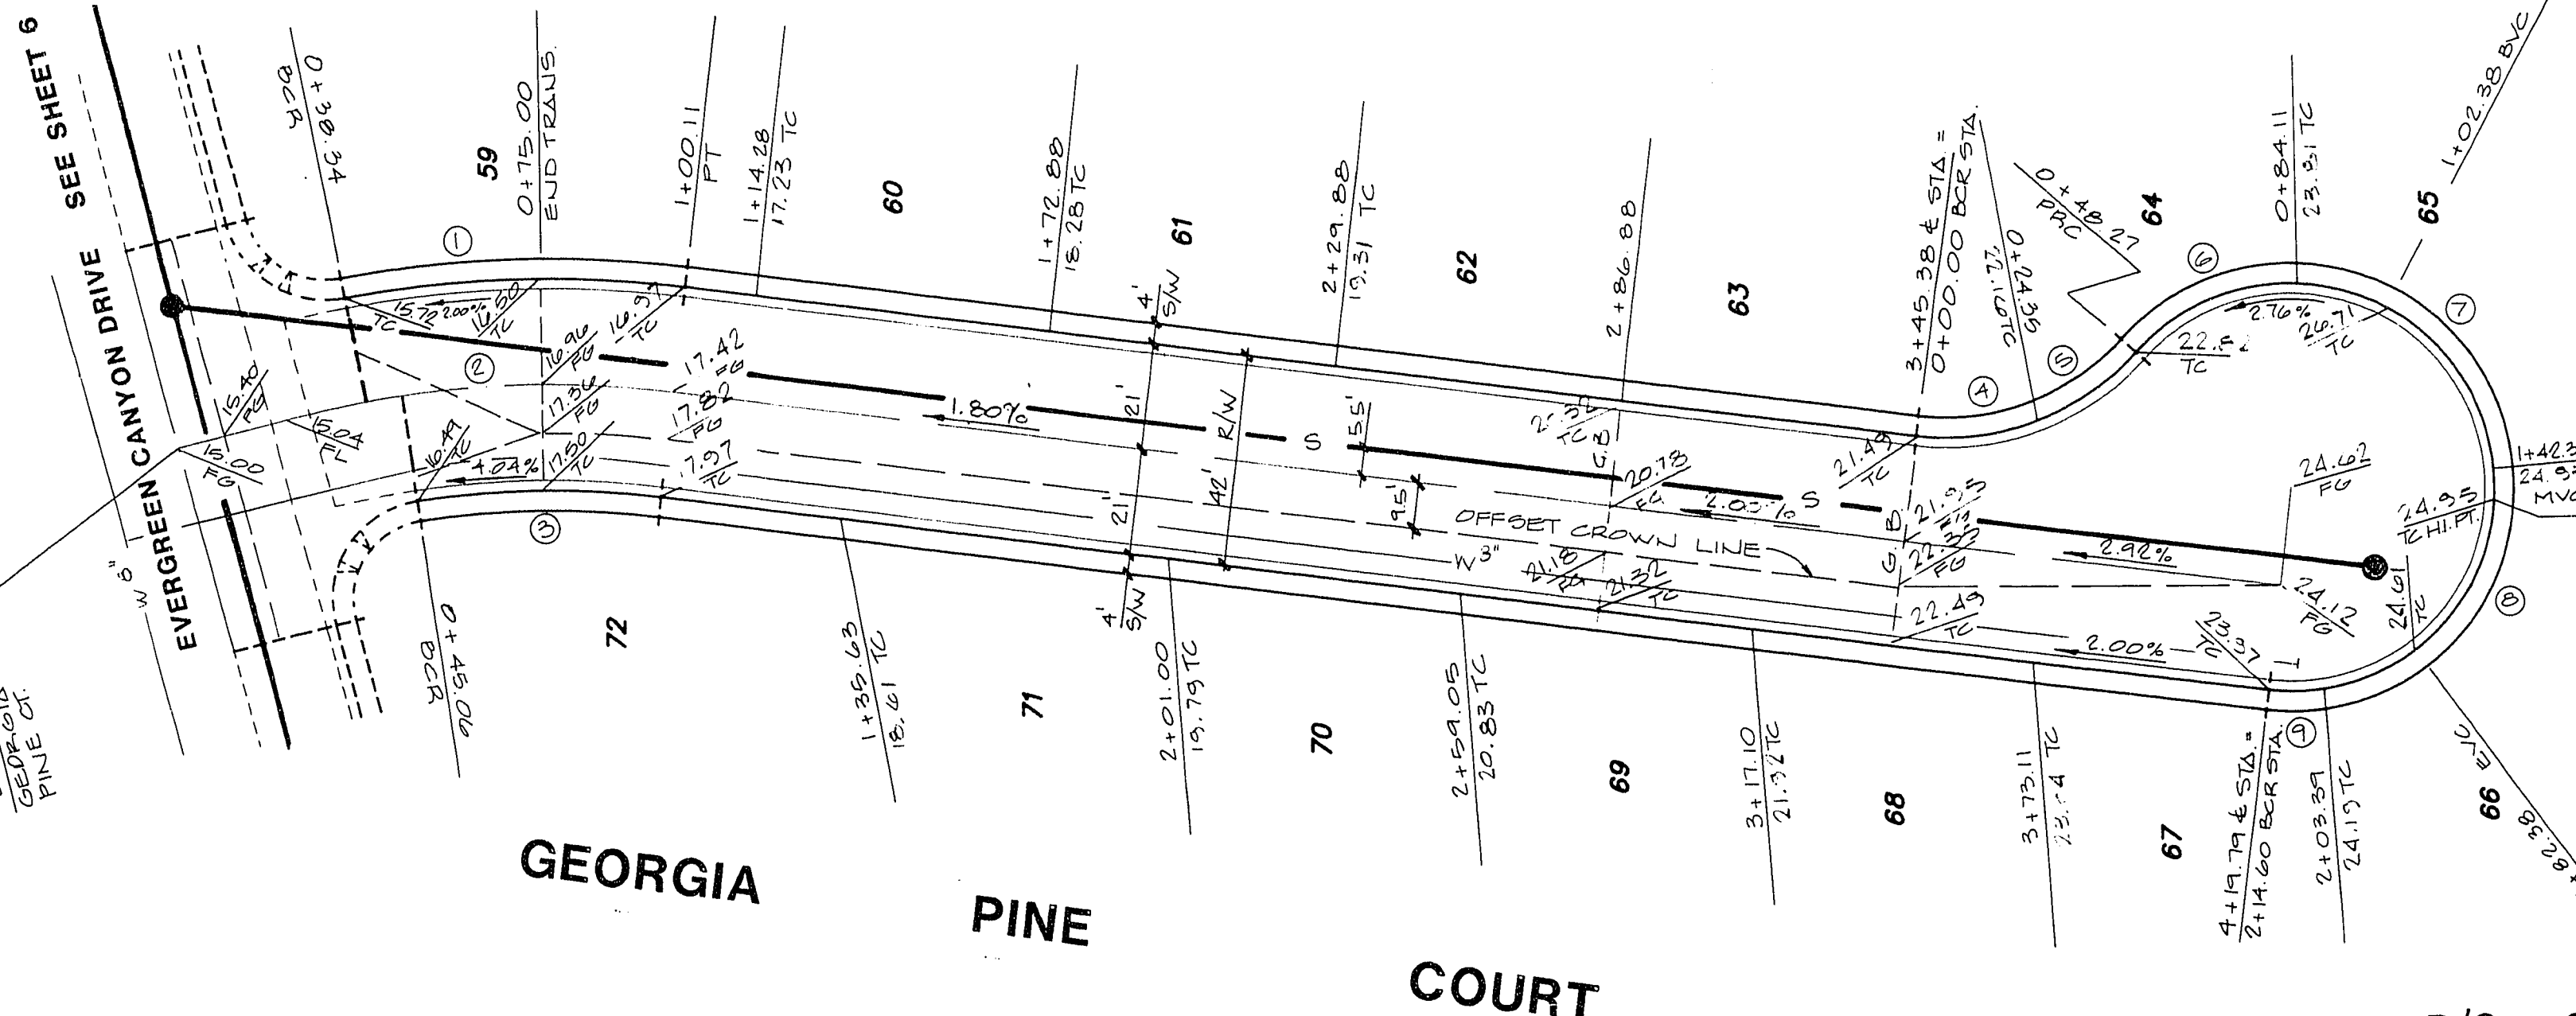


B/C CURVE DATA

NO	Δ	R	L	T
1	17°41'46"	221.00'	68.26'	34.40'
2	21°25'16"	200.00'	74.77'	37.83'
3	15°46'12"	179.00'	44.27'	24.79'
4	27°54'16"	50.00'	24.35'	12.42'
5	27°24'39"	50.00'	23.92'	12.19'
6	50°40'23"	40.50'	35.84'	19.19'
7	82°26'12"	40.50'	58.27'	35.18'
8	86°18'34"	40.50'	61.01'	37.97'
9	15°31'45"	40.50'	11.21'	5.64'

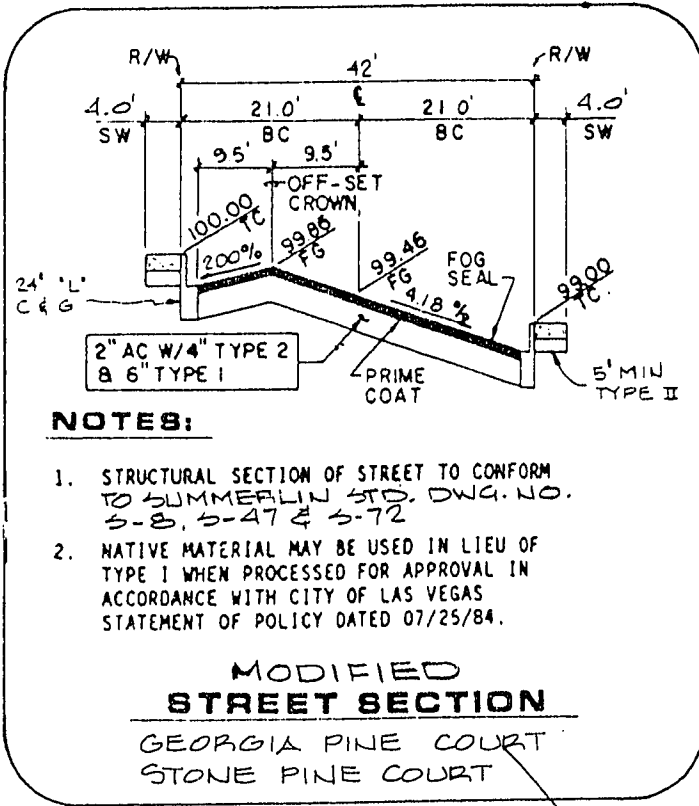


NOTES:
2. NATIVE MATERIAL MAY BE USED IN LIEU OF TYPE 1 WHEN PROCESSED FOR APPROVAL IN ACCORDANCE WITH CITY OF LAS VEGAS STATEMENT OF POLICY DATED 07/25/84.

MODIFIED STREET SECTION
GEORGIA PINE COURT
STONE PINE COURT

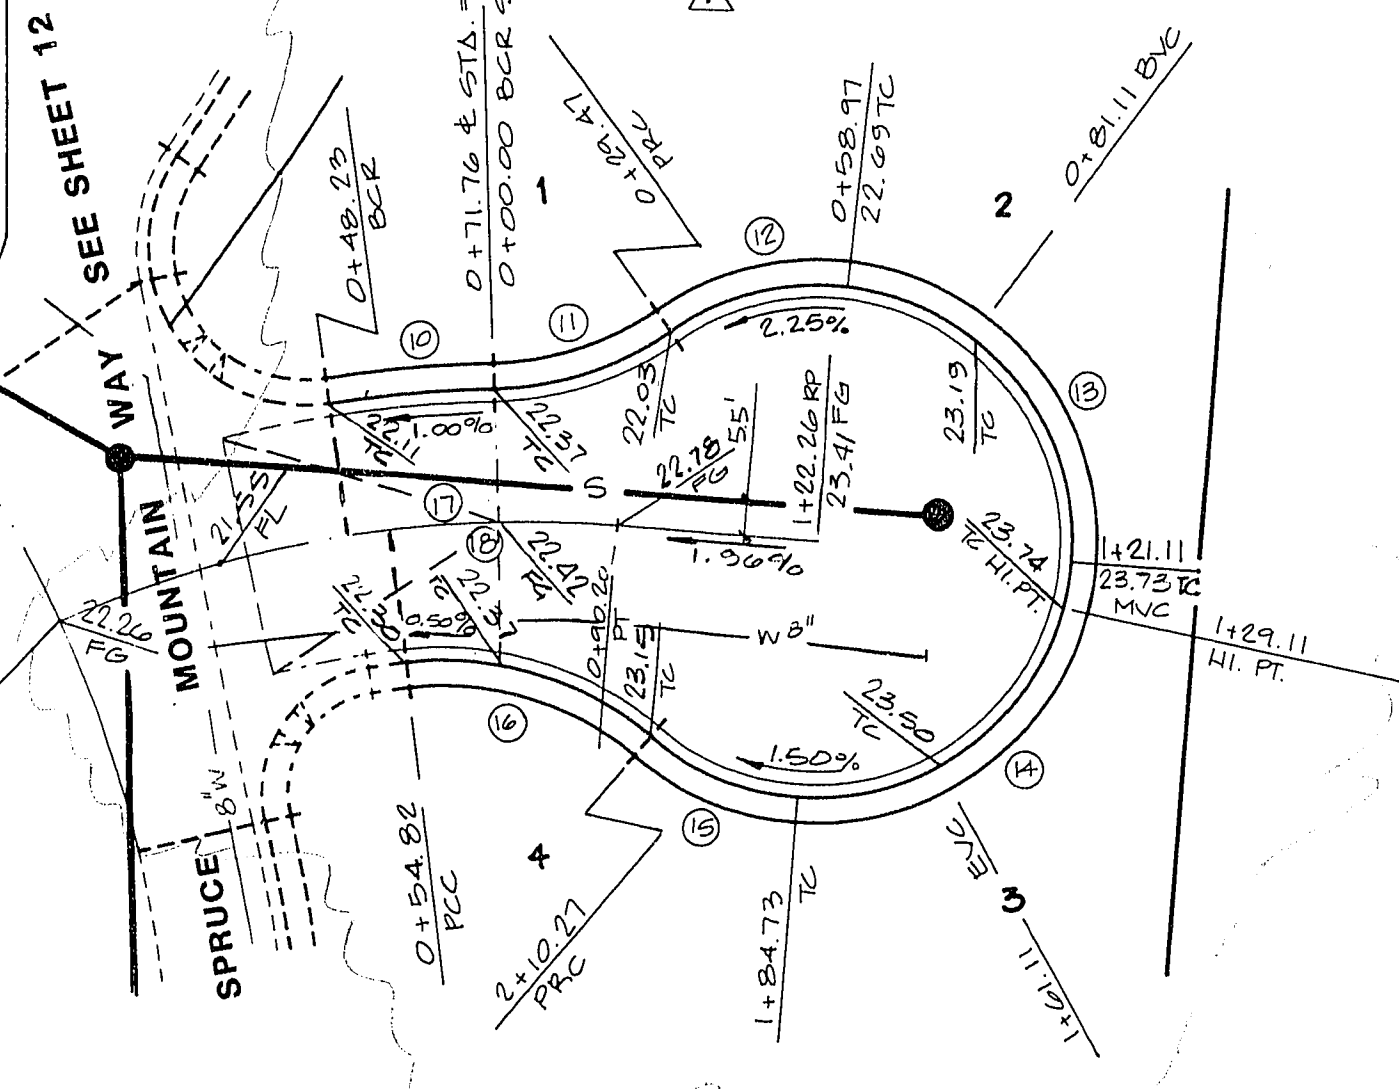

STONE PINE COURT

NO	Δ	R	L	T
10	07°29'19"	201.00'	26.27'	13.15'
11	33°46'32"	50.00'	29.47'	15.15'
12	41°43'59"	40.50'	29.80'	15.44'
13	81°54'55"	40.50'	62.14'	39.05'
14	90°00'00"	40.50'	63.62'	40.50'
15	36°07'31"	40.50'	25.54'	13.21'
16	77°23'21"	50.00'	71.85'	21.94'
17	13°21'34"	180.00'	41.97'	21.08'
18	11°15'42"	180.00'	35.35'	17.75'

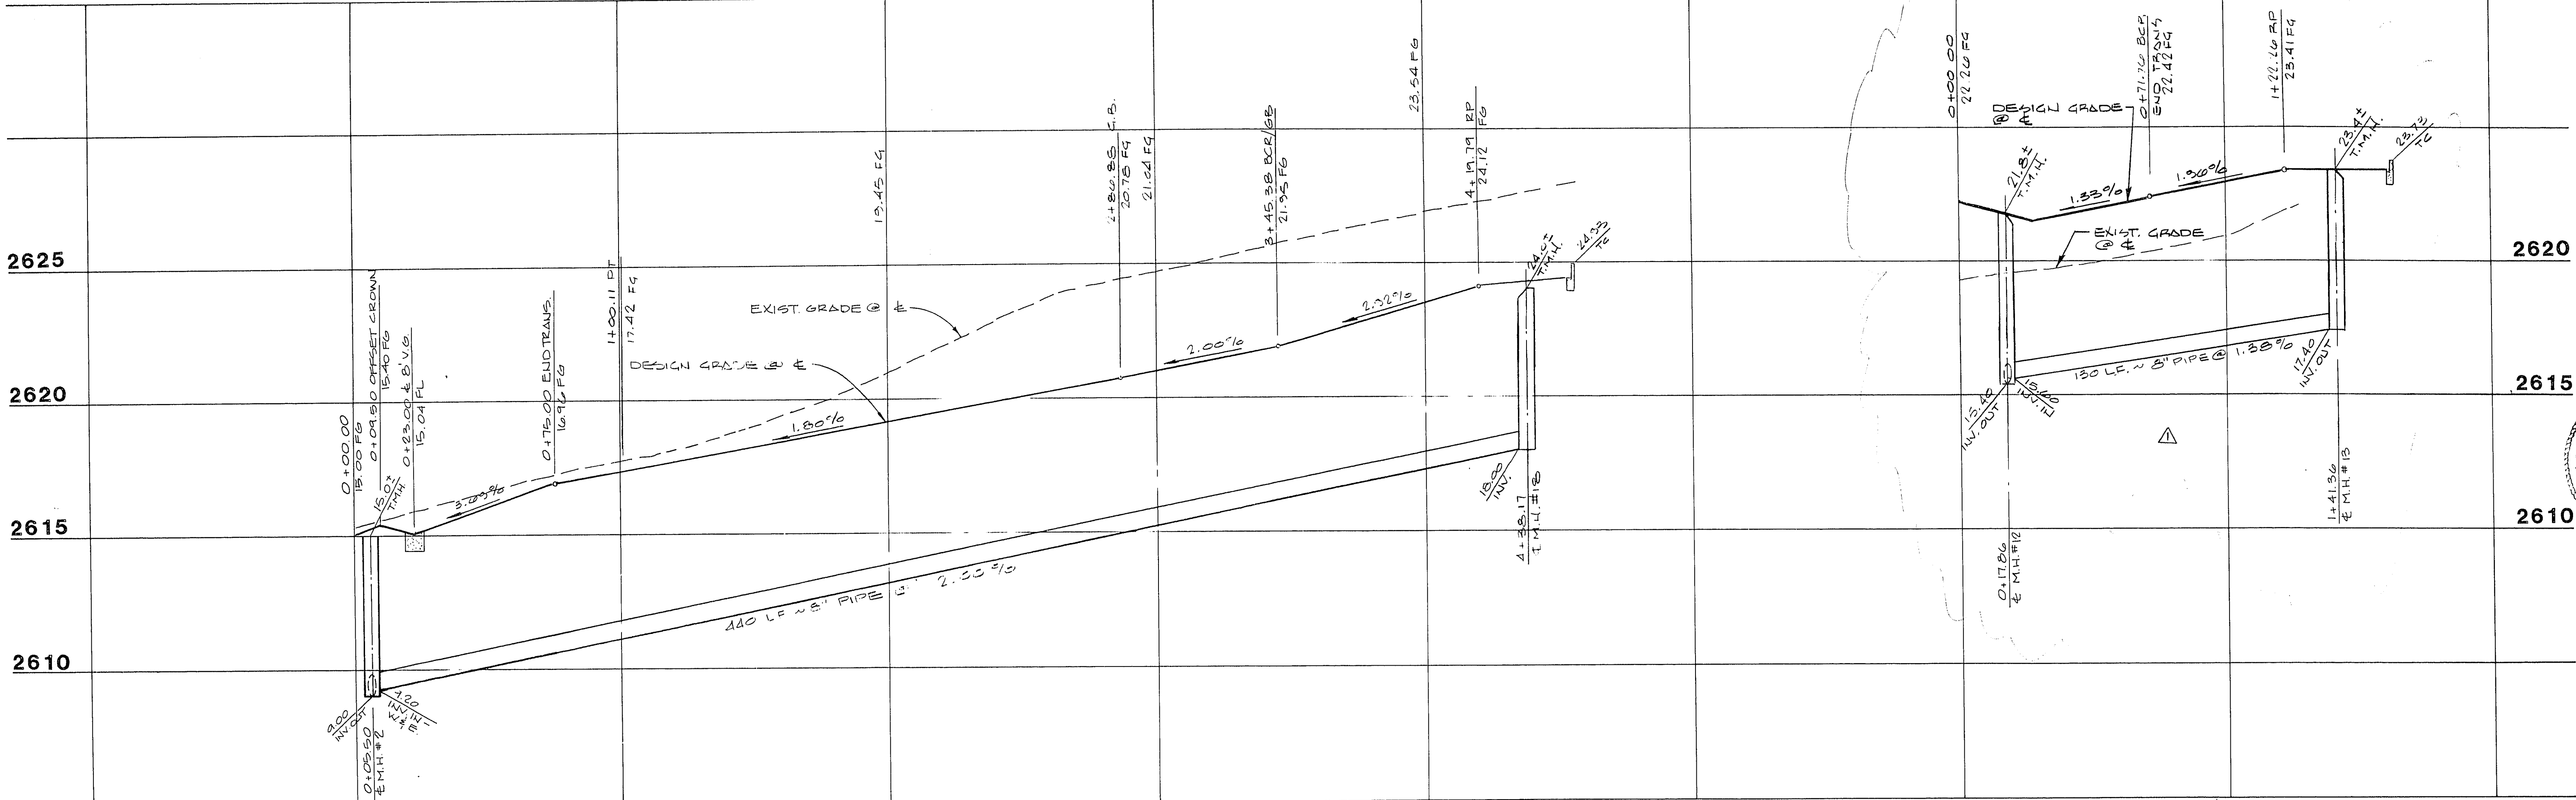

PROFILE
HORIZ. 1" = 30'
VERT. 1" = 3'

REVISIONS
REV. DATE DESCRIPTION
1 05/02 5543.5020 1074-4126
2 05/02 5543.5020 1074-4126

DESIGNED BY: JWL
CHECKED BY: JWL
IN CHARGE: JWL
DATE: 05/02/2005
PROJECT: 5543.5020
SHEET NO. 10
OF 21 SHEETS

LEWIS HOMES OF NEVADA
EVERGREEN IN THE HILLS AT SUMMERLIN
GEORGIA PINE COURT
STONE PINE COURT

G.C. WALLACE, INC.
Engineering/Architecture
1535 SOUTH RAINBOW BLVD. LAS VEGAS, NEVADA 89102