


UNIT 2 - PARCEL 1

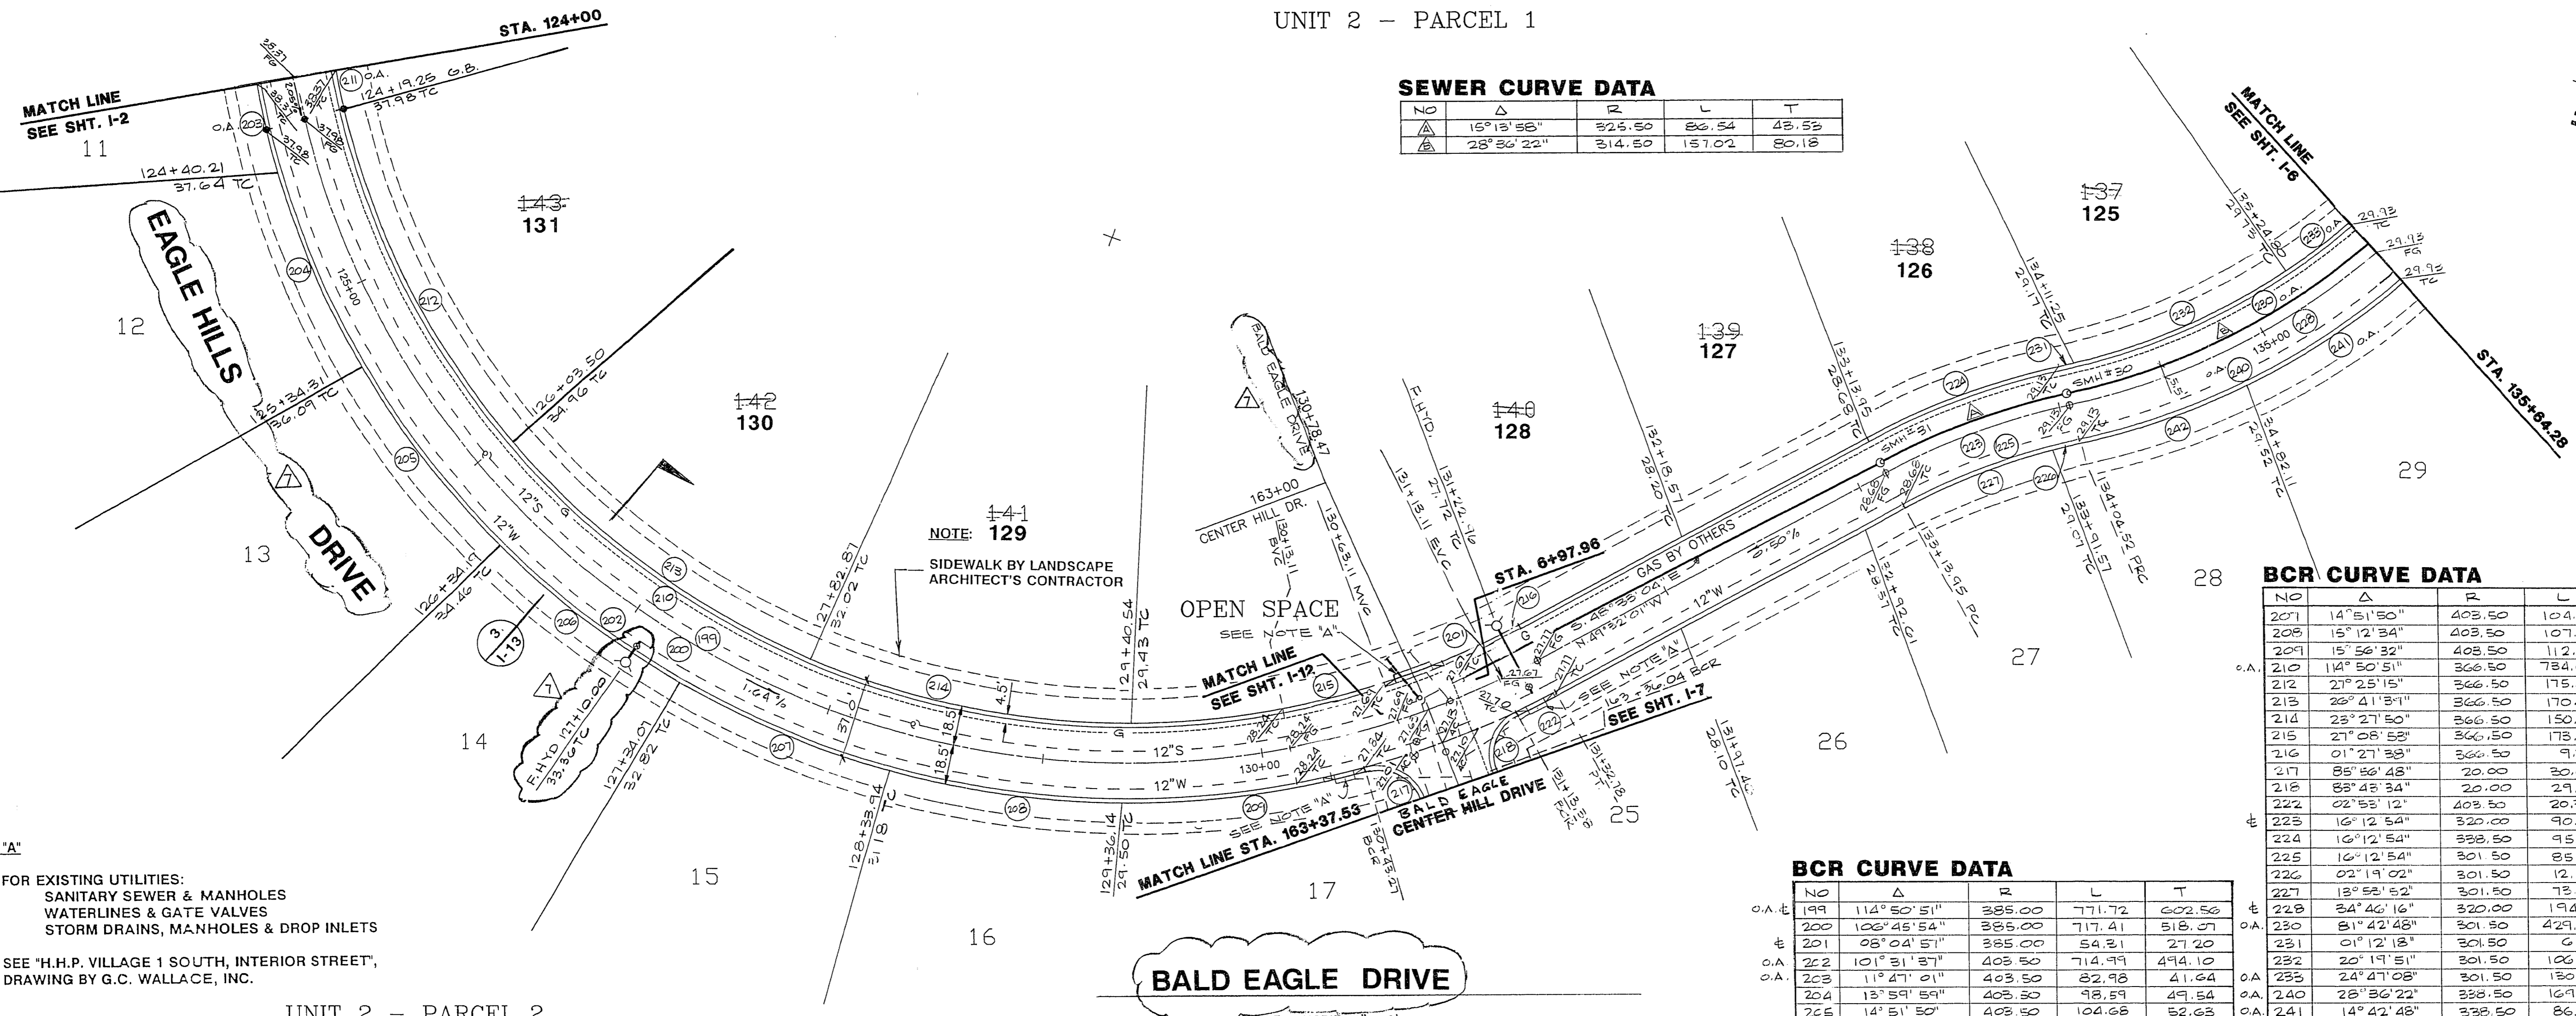

**SEWER CURVE DATA**

NO	Δ	R	L	T

**BCR CURVE DATA**



NO	Δ	R	L	T
207	14°51'50"	403.50	104.68	52.63
208	15°12'34"	403.50	107.11	53.87
209	15°56'32"	403.50	112.27	56.50
210	14°50'51"	366.50	784.64	578.60
212	27°25'15"	366.50	175.40	89.41
213	28°41'51"	366.50	170.75	86.90
214	23°27'50"	366.50	150.09	76.11
215	27°08'53"	366.50	173.66	88.49
216	01°27'53"	366.50	9.34	4.67
217	85°56'48"	20.00	20.00	18.63
218	85°48'34"	20.00	29.23	17.92
222	02°53'12"	403.50	20.33	10.17
223	16°12'54"	320.00	90.56	45.59
224	16°12'54"	338.50	95.80	48.22
225	16°12'54"	301.50	85.35	42.95
226	02°19'02"	301.50	12.19	6.10
227	13°52'52"	301.50	73.13	36.75
228	24°46'16"	320.00	194.20	100.19
230	81°42'48"	301.50	429.99	260.77
231	01°12'18"	301.50	6.34	3.17
232	20°19'51"	301.50	106.98	54.06
233	24°47'08"	301.50	130.43	66.25
240	28°36'22"	338.50	167.00	86.30
241	14°42'48"	338.50	86.73	43.70
242	13°53'34"	338.50	82.63	41.24
339	81°42'48"	320.00	456.31	278.77

**BCR CURVE DATA**

NO	Δ	R	L	T
199	114°50'51"	385.00	771.72	602.50
200	106°45'54"	385.00	717.41	518.07
201	08°04'51"	385.00	54.21	27.20
202	101°31'37"	403.50	714.99	494.10
203	11°47'01"	403.50	82.98	41.64
204	13°59'59"	403.50	98.59	49.54
205	14°51'50"	403.50	104.68	52.63
206	14°51'51"	403.50	104.68	52.64

**NOTE 'A'**  
 FOR EXISTING UTILITIES:  
 SANITARY SEWER & MANHOLES  
 WATERLINES & GATE VALVES  
 STORM DRAINS, MANHOLES & DROP INLETS  
 SEE "H.H.P. VILLAGE 1 SOUTH, INTERIOR STREET",  
 DRAWING BY G.C. WALLACE, INC.

UNIT 2 - PARCEL 2

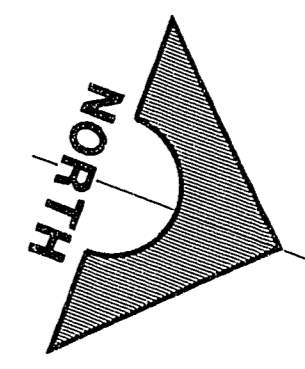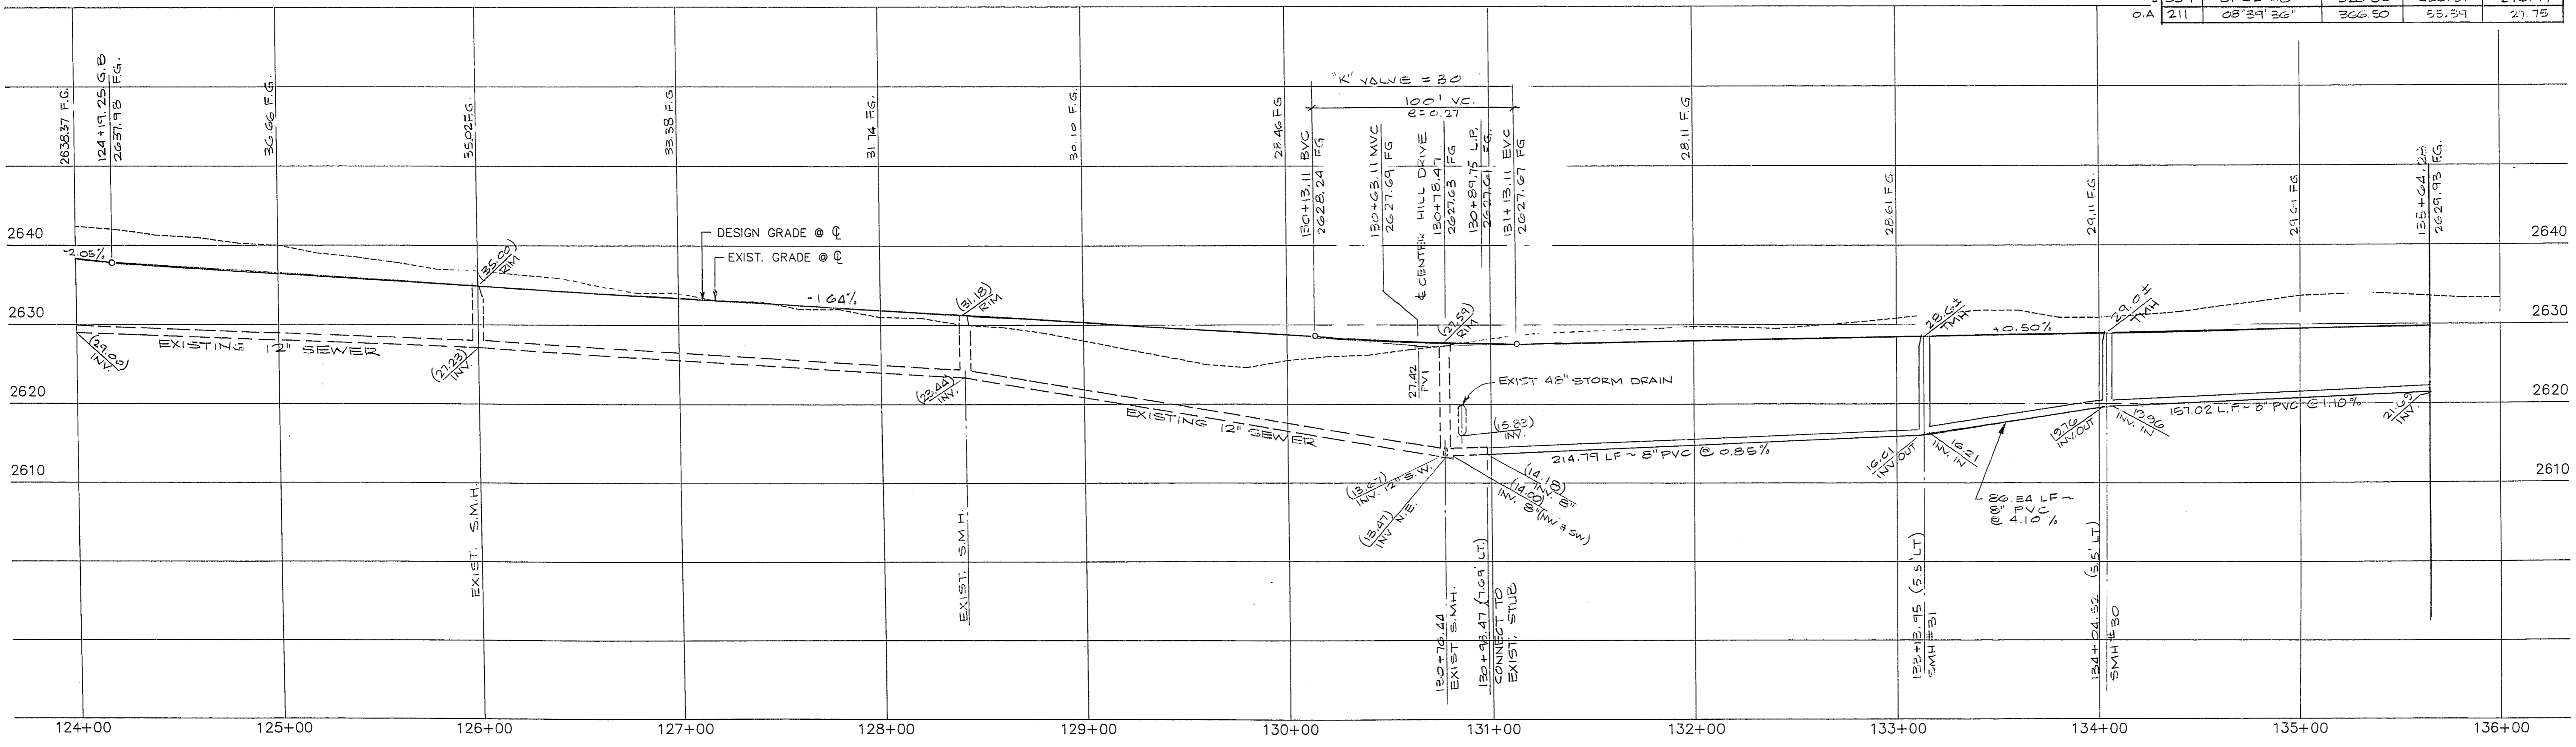

REV	DATE	DESCRIPTION	DATE APPROV
1	7/22/11	ISSUE TO CONSTRUCTION	
2	7/21/11	REVISED SHT. 1, 2, 3	
3	7/11/11	ISSUE TO BID	

RECOMMENDED BY  
 G. Wallace  
 JAMES B. WALKER  
 R.E.P. NO. DATE  
 9073  
 JOB NO. 620701ED

G.C. WALLACE, INC.  
 Engineering/Architecture  
 1555 SOUTH RAINBOW BLVD., LAS VEGAS, NEVADA 89102

SUMMERLIN - VILLAGE 1 SOUTH  
 EAGLE HILLS  
 BALD EAGLE DRIVE  
 PLAN & PROFILE  
 STA. 124+00 TO 135+64.28

SHEET  
**1-3**  
 SHT110F 21

JOB NO. 620701ED

1074-4165 81