


# SUMMERLIN

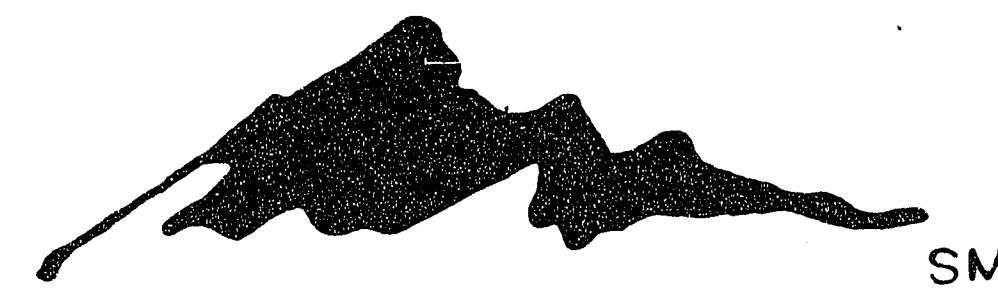

## EAGLE HILLS

## ROUGH GRADING

# Howard Hughes Properties

**G.C. WALLACE, INC.**  
 Engineering/Architecture  
 1555 SOUTH RAINBOW BLVD./LAS VEGAS, NEVADA 89102

### REVISIONS

#### EAGLE HILLS ROUGH GRADING

Sheet G-1 (3 of 11):

Change grades, change station of vertical curve at intersection of Hills Drive and Eagle Hills Circle; add vertical curve at intersection of Eagle Hills Circle and Soaring Place.

Sheet G-2 (4 of 11):

Change grades in Soaring Place cul-de-sac, on White Hawk Drive and Eagle Hills Circle.

Sheet G-3 (5 of 11):

Revise lot line between lots 58 and 59. Change grades in Grouse Street eye-brow, at intersection of Eagle Hills Circle and Peregrine Way, in Peregrine Way eye-brow and various others.

Sheet G-4 (6 of 11):

Add A.C. grades at Eagle Hills Circle eye-brow. Add T.C./F.G. at east end of Turnstone Drive.

Sheet G-5 (7 of 11):

Revise most of grades in Sanderling Place; add G.B. symbols (+) in 2 places on Eagle Hills Circle; add EVC information at west end of Eagle Hills Circle.

Sheet G-6 (8 of 11):

Revise grades in Turnstone Drive cul-de-sac; add PCC station in Turnstone Drive; revise D.G. at intersection of Turnstone Drive and Peregrine Way; add G.B. and revise grades in Eagle Hills Circle.

Sheet G-7 (9 of 11):

Change grade at intersection of Turnstone Drive and Eagle Hills Circle; change station at G.B. in Eagle Hills; revise grades in Raven Place. Revise lot line between lots 35, 34, 33.

Sheet G-8 (10 of 11):

Revise grades on Center Hill Drive.

Sheet G-9

Revise sections 4, 6, 7, 8, 10.

7-9-91 SHEET G-5  
 REVISED MEDIAN ISLANDS IN CENTER HILL DRIVE

9-11-1991  
 CHANGED STREET NAMES AND LOT NUMBERS PER C.L.V.

11-13-91 SHEET G-2  
 1. REVISED PAD GRADE & PAD LIMITS FOR LOT NO.114

12-12-91 SHT. G-6  
 REVISED GRADES AT WHITE TAIL DR. & GOLDEN EAGLE DR.

REVISION NO. 6  
 1/31/92

SHEET	DESCRIPTION
I (1 OF 11)	1. ADDED REVISION 6.
G-1 (3 OF 11)	1. ADDED PARKING SPACES AT GUARD HOUSE.

Location: Las Vegas, Nevada

NO.	DATE	DESCRIPTION
1	1/31/92	ADDED LIST OF REV. SHEET G-1 (3 OF 11) AND SHEET G-9
2	12/12/91	REVISED GRADES AT WHITE TAIL DR. & GOLDEN EAGLE DR.
3	11/13/91	REVISED PAD GRADE & PAD LIMITS FOR LOT NO.114
4	9/11/91	CHANGED STREET NAMES AND LOT NUMBERS PER C.L.V.
5	11/13/91	REVISED MEDIAN ISLANDS IN CENTER HILL DRIVE
6	11/22/91	SEE SHEETS G-1 THROUGH G-9
7	12-22-91	ISSUED FOR CONSTRUCTION

JOB NO. 620.701ED

JOB NO. 620.701

EAGLE HILLS (ROUGH GRADING)

SHEET 1 OF 11

G-4 1071-4165-6