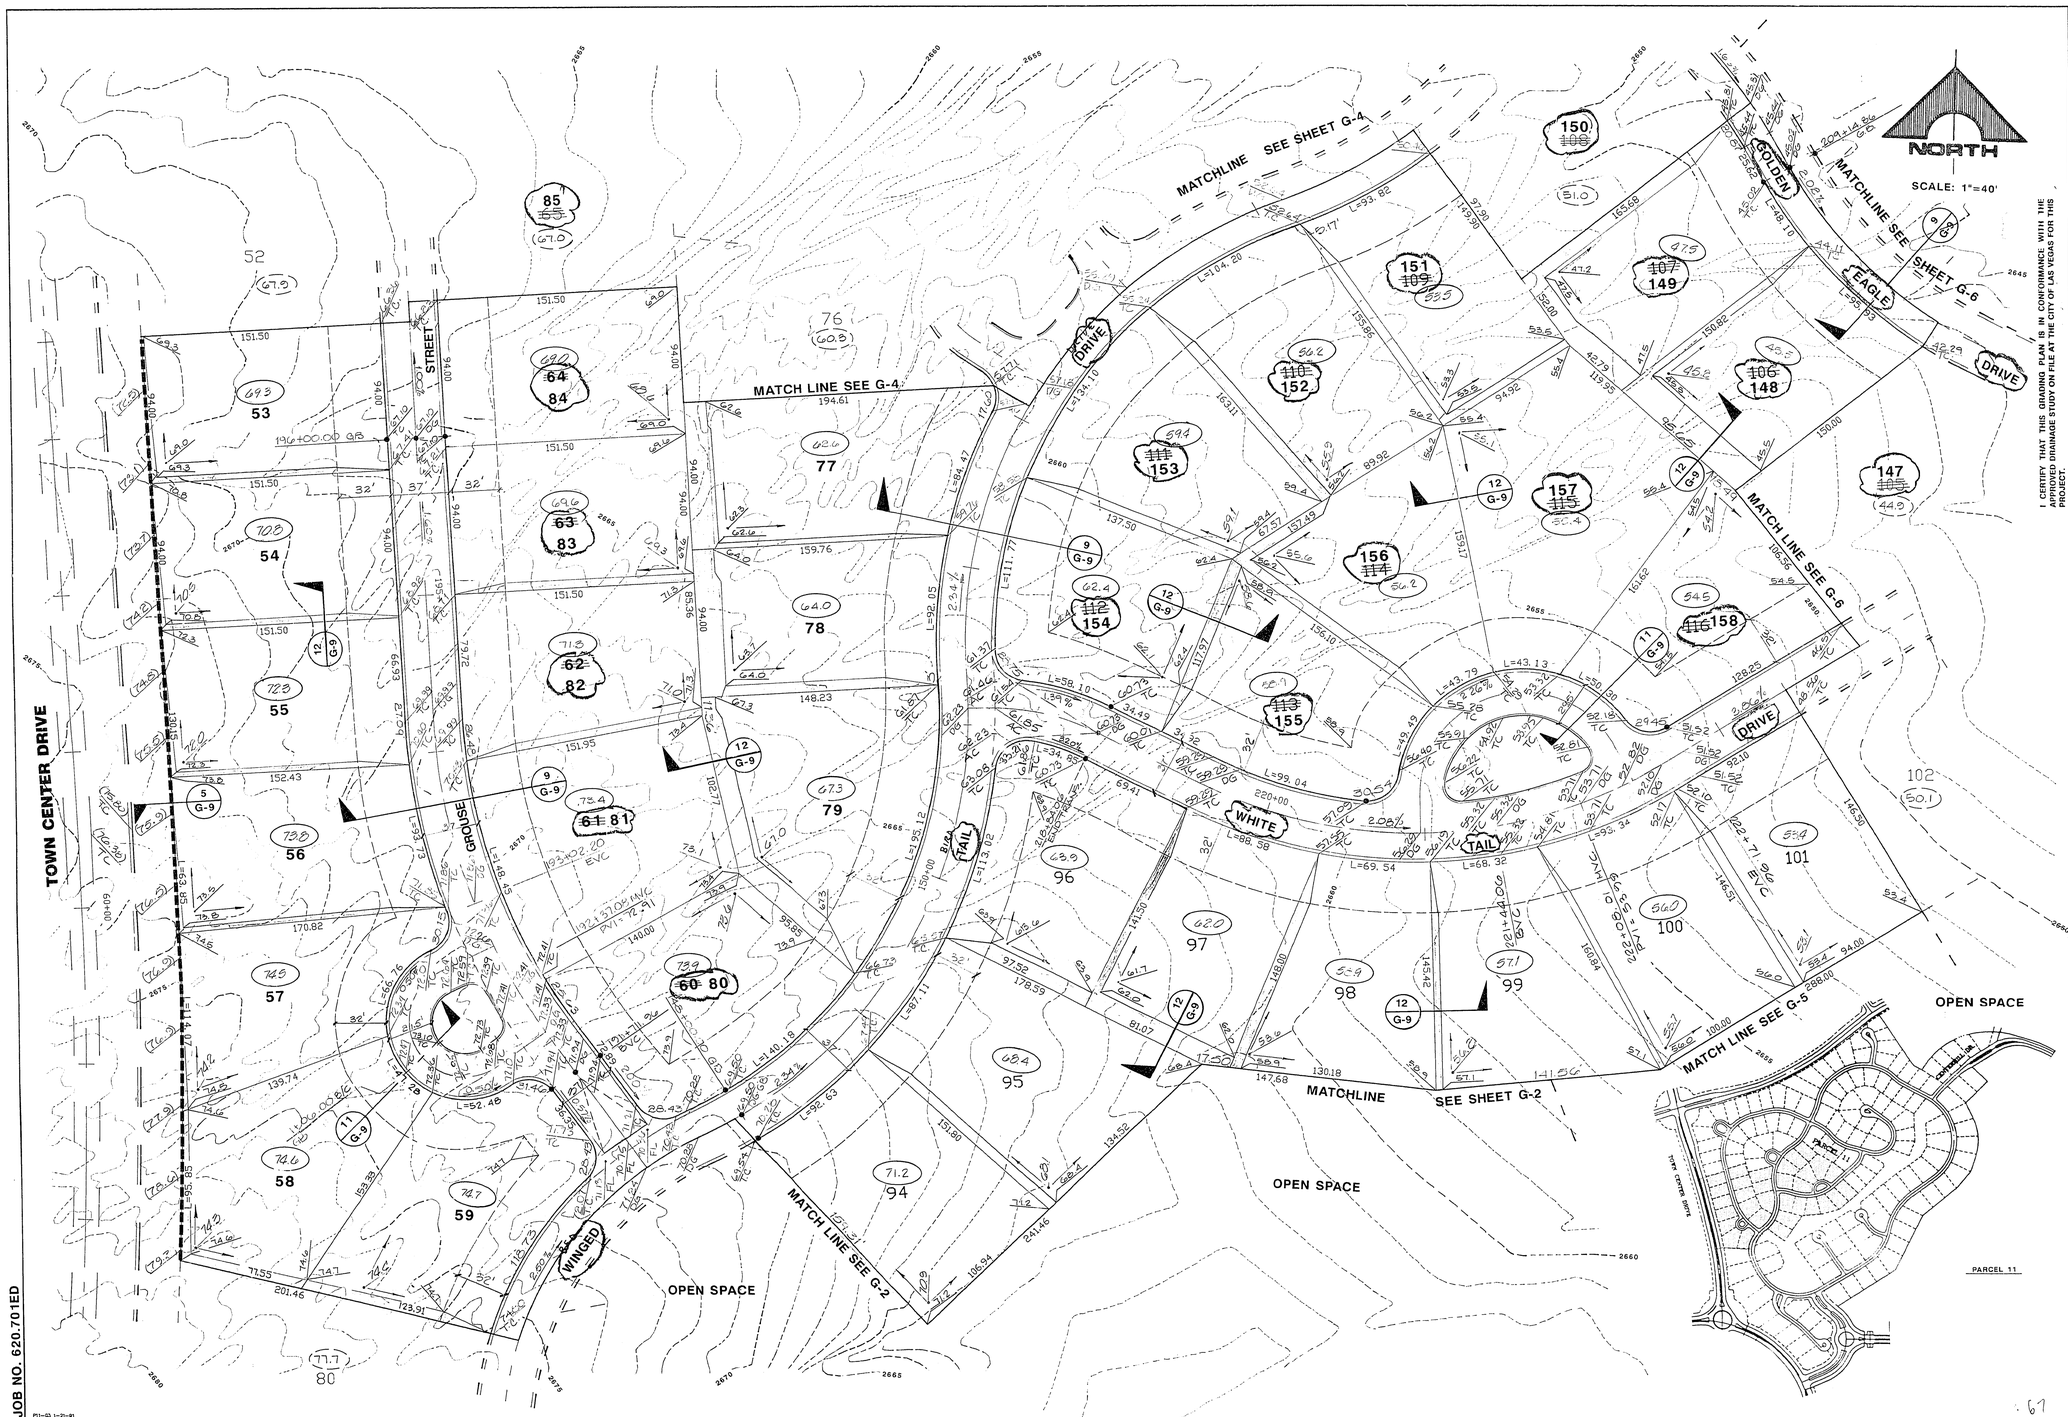


I CERTIFY THAT THIS GRADING PLAN IS IN CONFORMANCE WITH THE APPROVED DRAINAGE STUDY ON FILE AT THE CITY OF LAS VEGAS FOR THIS PROJECT.

RECOMMENDED

CHRISTOPHER J. ANDERSON — R.E. NO. 14591 — DATE 4-6-91

| REV. | DATE | DESCRIPTION | DATE APPROV. |
|---|---|---|---|
| 1 | 9/11/91 | CHANGED IN NAME & LOT NOS. PER CLV | 9-17-91 |
| 2 | 4/24/91 | GRADING PROGRESS PRINT REVISED PER CLV | 4-26-91 |
| 3 | 4/22/91 | ISSUE FOR CONSTRUCTION | 4-26-91 |
| 4 | 2/25/91 | ISSUED FOR PRICING | |

G.C. WALLACE, INC.
Engineering/Architecture 1555 SOUTH RAINBOW BLVD./LAS VEGAS, NEVADA 89102

JOB NO. 620.701

SUMMERLIN - VILLAGE 1 SOUTH

EAGLE HILLS

GRADING PLAN III

SHEET G-3

SHT 5 OF 11

JOB NO. 620.701ED

P11-03 1-21-91

Grdg 107Y-4165