
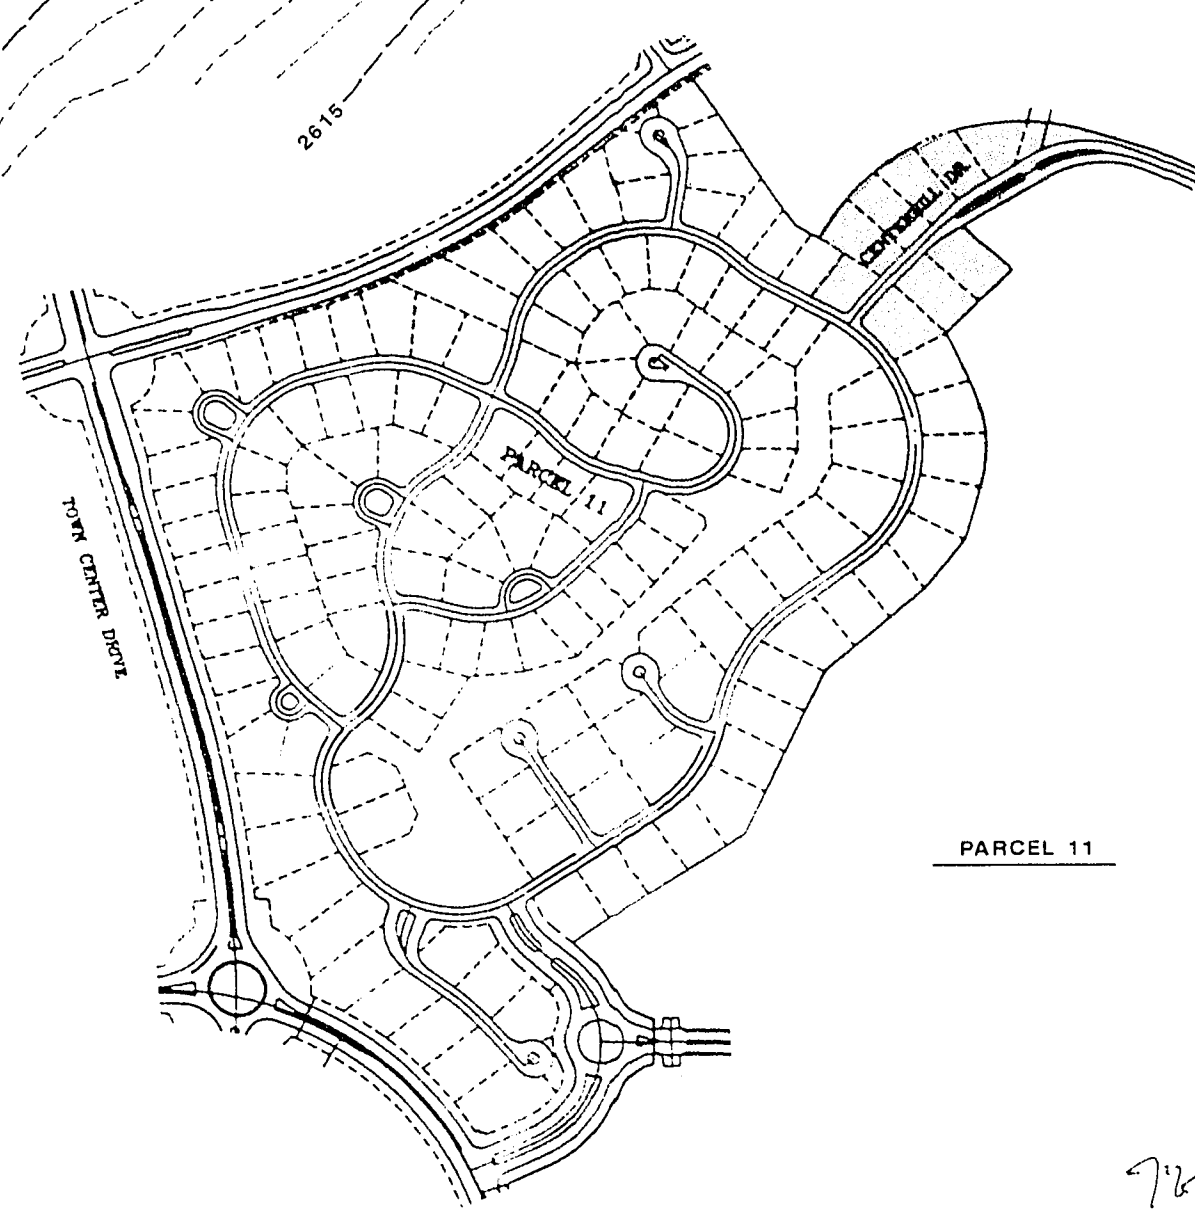


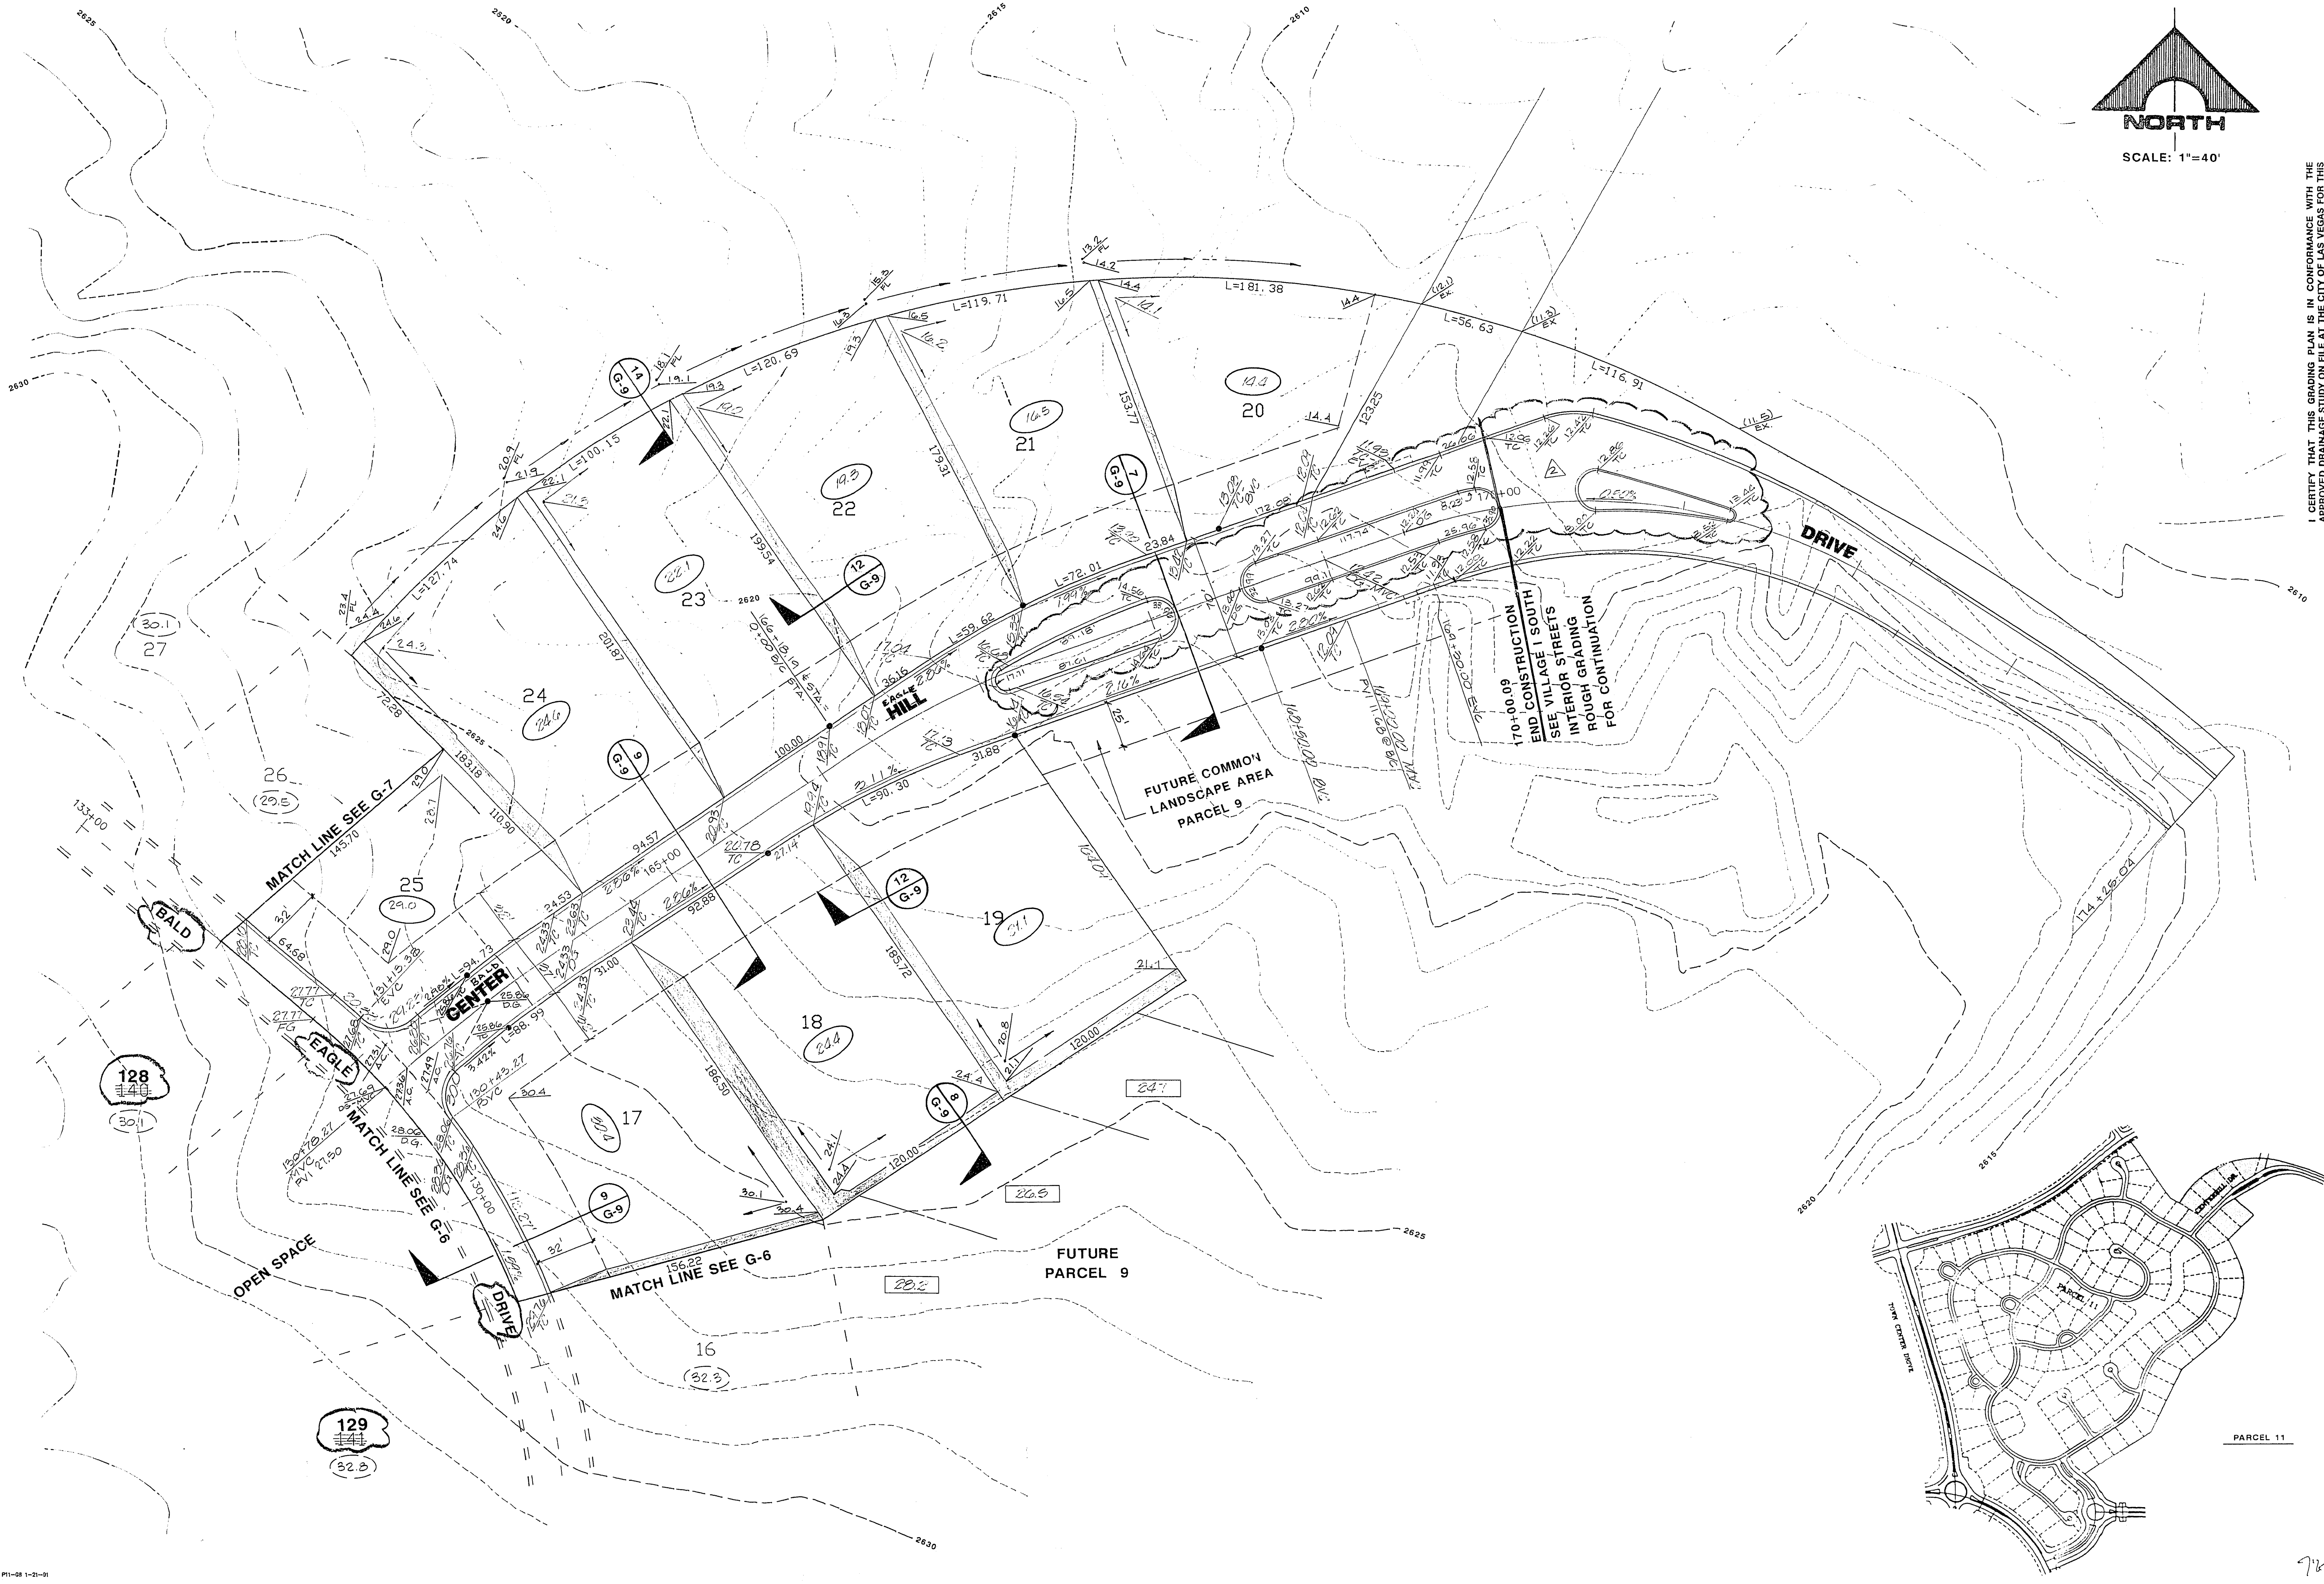

I CERTIFY THAT THIS GRADING PLAN IS IN CONFORMANCE WITH THE APPROVED DRAINAGE STUDY ON FILE AT THE CITY OF LAS VEGAS FOR THIS PROJECT.

RECOMMENDED
CHRISTOPHER ANDERSON
R.P.E., M.D.
4-6-9
JOB NO. 620.701

SUMMERLIN - VILLAGE 1 SOUTH
EAGLE HILLS
GRADING PLAN VIII

SHEET
G-8
SHT 10 OF 11

REV.	DATE	DESCRIPTION
1	11/1/91	ISSUED FOR PERMITS
2	12/1/91	REV. MEDIAN ELEVATIONS
3	12/1/91	REV. GRADES ON CENTERLINE
4	12/1/91	ISSUED FOR PERMITS
5	12/1/91	ISSUED FOR PERMITS

Grdy. 107/-4/65