

REVISIONS

4/23/91

ADD PHASE LINE 5/17/91

5/17/91

REVISED WATER PLAN, DELETED SHEETS W-1 & W-2, ADDED NEW SHEETS W-1, W-2 & W-3

6/21/91

REVISED MEDIAN ISLANDS IN CENTER HILL DRIVE AND HILLS DR.; ADDED PARKING SPACES; REVISED SEWER AND WATER SERVICE POINTS, FIRE HYDRANT, STORM DRAIN AND STREET LIGHT LOCATIONS; ADDED SPECIAL PAVING.

6/25/91

L.V.V.W.D. COMMENTS

7-23-91

ISSUE TO CONSTRUCT

8-14-91

ADDED 6" IRRIGATION SLEEVES TO SHEET SD-1

8-15-91

ISSUE TO BID IRRIGATION SLEEVES ONLY

9-3-91

SHEET CALLOUT

DESCRIPTION

1.	1. ADDED DELTA 7 REVISION
2.	1. CHANGED STREET NAMES & LOT NUMBERS PER CLV
W-1	1. CHANGED STREET NAMES & LOT NUMBERS PER CLV 2. ADDED METER & METER BOX FOR GUARD HOUSE TO QUANTITIES 3. REVISED 6" A.C.P. QUANTITY 4. REVISED LOTS UNDER DETAIL A AND DETAIL B
W-2	1. CHANGED STREET NAMES & LOT NUMBERS PER CLV 2. REVISED WATER LINE LENGTH TO 150.05 FT. FROM 128.05 FT.
W-3	1. CHANGED STREET NAMES & LOT NUMBERS PER CLV 2. ADDED SEWER & WATER SERVICES TO GUARD HOUSE 3. ADDED CLEANOUTS AND INVERT ELEVATIONS ON SEWER LATERAL TO RECREATION AREA RESTROOMS
S-1	1. CHANGED STREET NAMES & LOT NUMBERS PER CLV 2. ADDED SEWER LATERAL TO GUARD HOUSE
ST-1	1. CHANGED STREET NAMES AND LOT NUMBERS 2. RELOCATED STREET LIGHT ON LOT 29 FROM STATION 135+85 TO STATION 135+63
SD-1	1. CHANGED STREET NAMES & LOT NUMBERS PER CLV
I-1	1. CHANGED STREET NAMES & LOT NUMBERS PER CLV
I-2	1. CHANGED STREET NAMES & LOT NUMBERS PER CLV
I-3	1. CHANGED STREET NAMES & LOT NUMBERS PER CLV 2. REVISED FIRE HYDRANT LOCATION, LOT 14 FROM STATION 127+34.87 TO STATION 127+00
I-4	1. CHANGED STREET NAMES & LOT NUMBERS PER CLV
I-5	1. CHANGED STREET NAMES & LOT NUMBERS PER CLV
I-6	1. CHANGED STREET NAMES & LOT NUMBERS PER CLV
I-7	1. CHANGED STREET NAMES & LOT NUMBERS PER CLV
I-8	1. CHANGED STREET NAMES & LOT NUMBERS PER CLV
I-9	1. CHANGED STREET NAMES & LOT NUMBERS PER CLV
I-10	1. CHANGED STREET NAMES & LOT NUMBERS PER CLV
I-11	1. CHANGED STREET NAMES AND LOT NUMBER PER CLV
I-12	1. CHANGED STREET NAMES & LOT NUMBERS PER CLV
I-13	1. NO REVISIONS


10-10-91

ADDED STREET LIGHT CIRCUIT, SHT. ST-1

12-12-91

REVISED GRADES AT WHITE TAIL DR. & GOLDEN EAGLE DR. SHTS. I-9 & I-10

SUMMERLIN

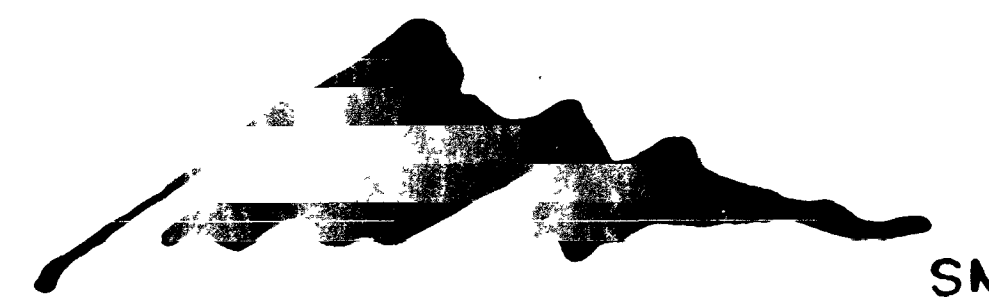

EAGLE HILLS

IMPROVEMENTS

PAVEMENT, CURB, GUTTER, WATER, SEWER, STORM DRAIN, AND STREET LIGHTS

Howard Hughes Properties

G.C. WALLACE, INC.
Engineering/Architecture

1555 SOUTH RAINBOW BLVD./LAS VEGAS, NEVADA 89102

REVISION NO. 10
1/31/92

SHEET	DESCRIPTION
I-1 (1 OF 21)	1. ADDED LIST OF REVISIONS PER SHEET.
W-3 (5 OF 21)	1. ADDED PARKING SPACES AT GUARD HOUSE. 2. REMOVE AND RELOCATE 5/8" METER BOX AT GUARD HOUSE.
S-1 (6 OF 21)	1. ADDED PARKING SPACES AT GUARD HOUSE.
ST-1 (7 OF 21)	1. ADDED PARKING SPACES AT GUARD HOUSE.
SD-1 (8 OF 21)	1. ADDED PARKING SPACES AT GUARD HOUSE.
I-1 (9 OF 21)	1. ADDED PARKING SPACES AT GUARD HOUSE IN PLAIN VIEW. 2. REVISED BACK-OF-CURB STATION IN PROFILE. 3. ADDED CURVE X AND Y IN BCK CURVE DATA. 4. ADDED DETAIL PARKING SPACES AT GUARD HOUSE.

REVISION 11
2/21/92

Sheet No.	Description
1 (1 OF 21)	1. Added List of Revisions per sheet.
ST-1 (7 OF 21)	1. Revised panel chart. 2. Revised legend. 3. Added new street light foundation, pole and fixture detail. 4. Added street light location detail. 5. Revised service point detail. 6. Revised street light tap pull box detail. 7. Revised plan view to match increased wattage.

REVISION 12
3/13/92

Sheet No.	Description
1 (1 OF 21)	1. Added List of Revisions per sheet.
ST-1 (7 OF 21)	1. Noted color for street light pole and fixture.

3/13/92 REVISION 12 OF 12
2/21/92 REVISION 11 OF 11
1/31/92 REVISION 10 OF 10
10/14/91 REV. GRADES AT WHITE TAIL DR. & GOLDEN EAGLE DR.
9/14/91 ADDED ST. LIGHT CIRCUIT SHT. ST-1
8/14/91 REV. STREET NAMES & LOT NUMBERS PER CLV
8/14/91 WATER TO GUARD HOUSE ADDED
8/14/91 SEWER TO GUARD HOUSE ADDED
8/14/91 IRRIGATION SLEEVES ONLY
8/14/91 ADDED IRRIGATION SLEEVES TO SHEET SD-1
7-23-91 ISSUE TO CONSTRUCT
6-25-91 L.V.V.D. COMMENTS
6-21-91 REVISED WATER PLAN, DELETED SHEETS W-1 & W-2, ADDED NEW SHEETS W-1, W-2 & W-3
6-21-91 REVISED MEDIAN ISLANDS IN CENTER HILL DRIVE AND HILLS DR.; ADDED PARKING SPACES; REVISED SEWER AND WATER SERVICE POINTS, FIRE HYDRANT, STORM DRAIN AND STREET LIGHT LOCATIONS; ADDED SPECIAL PAVING.
6-21-91 L.V.V.W.D. COMMENTS
5-17-91 ADD PHASE LINE 5/17/91
4-23-91

PLANS LIBRARY
LOGGED OUT TO:
FIRM: G.C.W.
PERSON: Ed Z.
DATE: 11-9-92

SHEET 1 OF 21

JOB NO. 620.701ED

JOB NO. 620.701

EAGLE HILLS IMPROVEMENTS

SUMMERLIN



EAGLE HILLS

IMPROVEMENTS

MOVEMENT, CURB, GUTTER, WATER, SEWER, STORM DRAIN, AND STREET LIGHTS

Howard Hughes Properties


G.C. WALLACE, INC.
 Engineering/Architecture

