


CLV BENCHMARK # ILV9026SES, RIVET & PLATE
IN CONCRETE MONUMENT AT NW RETURN OF
ANN ROAD AND JONES BLVD.
ELEVATION PER CITY OF LAS VEGAS DATUM
2297.75



No.	RADIUS	DELTA	LENGTH	TANGENT
C1	30.00'	82°08'04"	43.01'	26.14'
C2	30.00'	97°51'56"	51.24'	34.43'
C3	20.00'	82°08'04"	28.67'	17.43'
C4	19.50'	97°51'56"	33.31'	22.38'
C5	55.50'	131°05'13"	126.98'	122.03'
C6	54.50'	24°37'12"	23.42'	11.89'
C7	34.50'	81°50'49"	49.78'	29.91'

Call
before you
Dig
1-800-227-2600

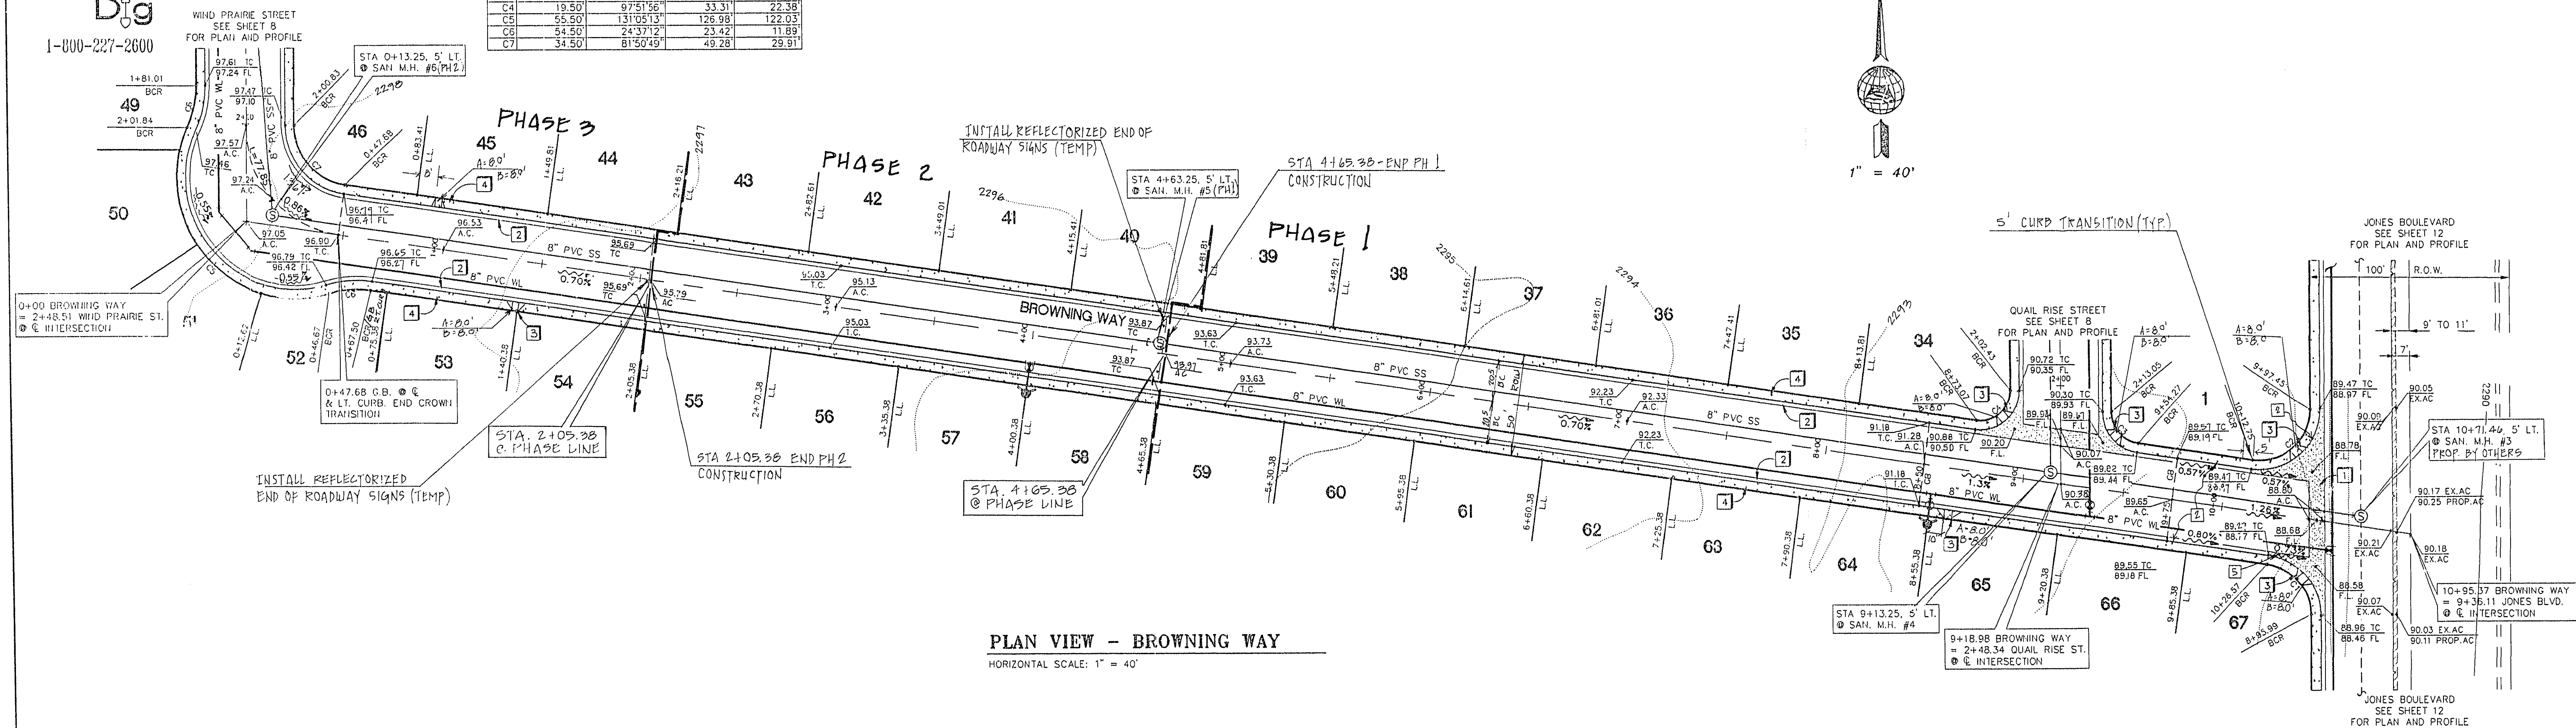

1. CONSTRUCT CONCRETE CROSS GUTTER PER DWG NO 220
UNIFORM STANDARD DRAWINGS FOR PUBLIC WORKS
CONSTRUCTION OFF-SITE IMPROVEMENTS
2. CONSTRUCT 90 CONCRETE ROLL TYPE CURB & GUTTER
PER DETAIL, SHEET 16.
3. CONSTRUCT SIDEWALK RAMP PER DRAWING NO. 235 (CASE 1)
UNIFORM STANDARD DRAWINGS FOR PUBLIC WORKS
CONSTRUCTION OFF-SITE IMPROVEMENTS, A=8.0, B=6.0
4. CONSTRUCT 45" WIDE CONCRETE SIDEWALK AS PER DETAIL
SHEET 16.
5. CONSTRUCT 24" "L" TYPE C&G PER DETAIL, SHEET 16

1. ADD 2200' TO PLAN VIEW ELEVATIONS.
2. REFERENCE SHEET 16 FOR TYPICAL STREET SECTIONS.

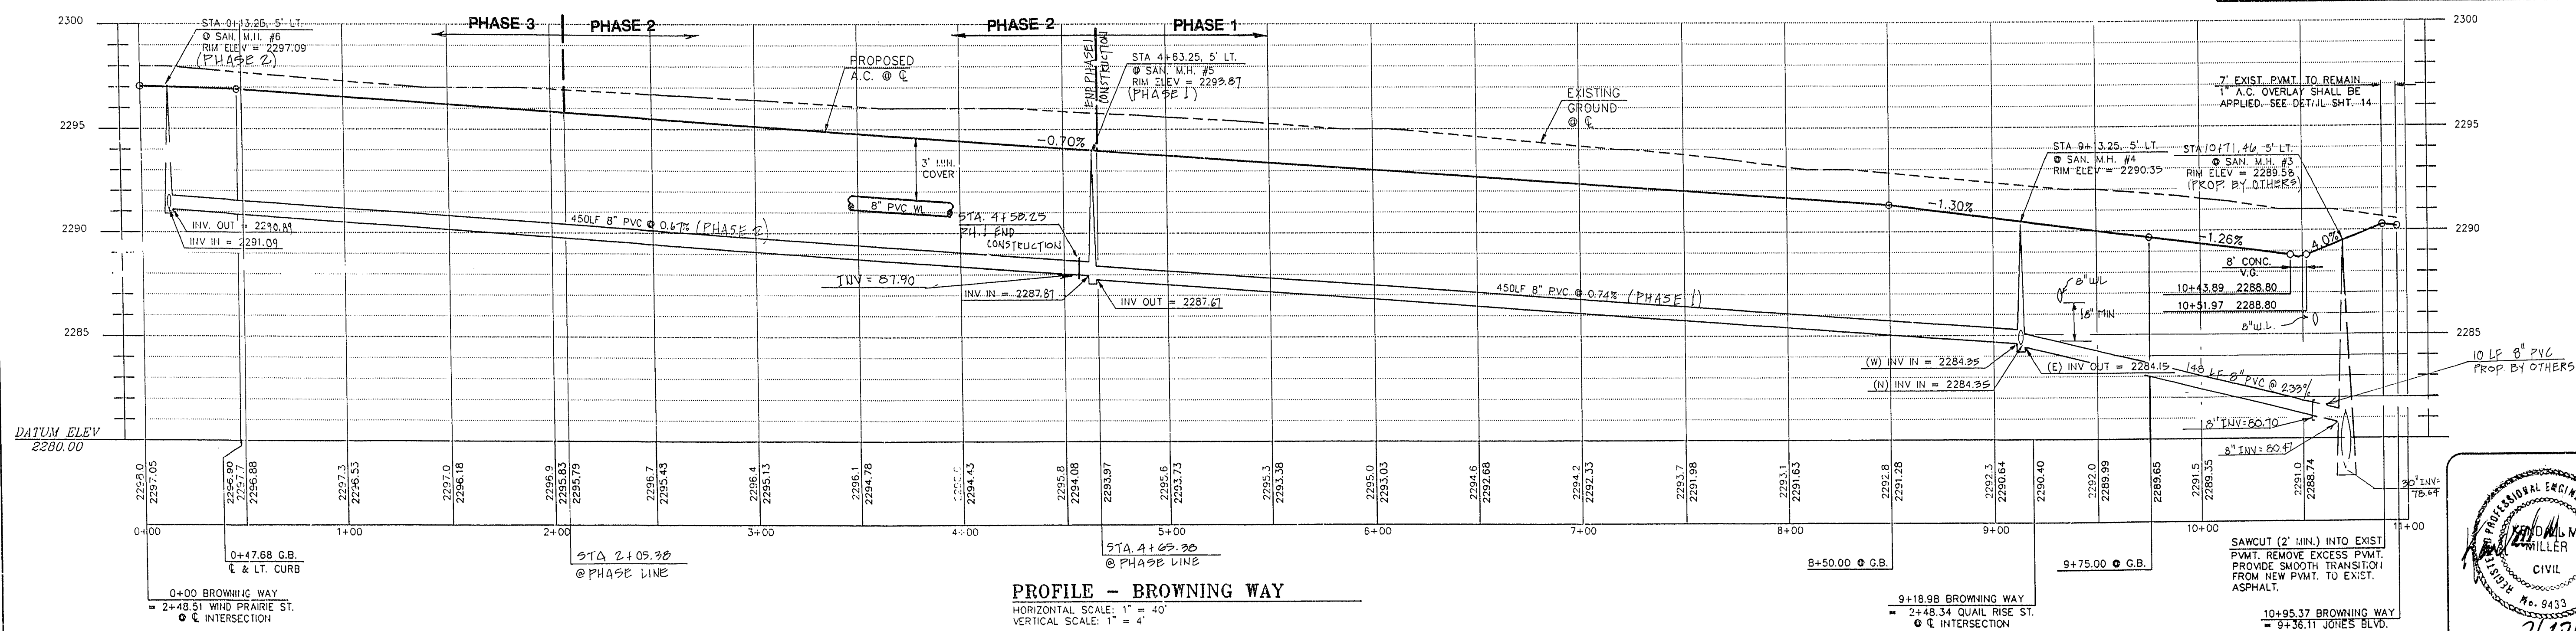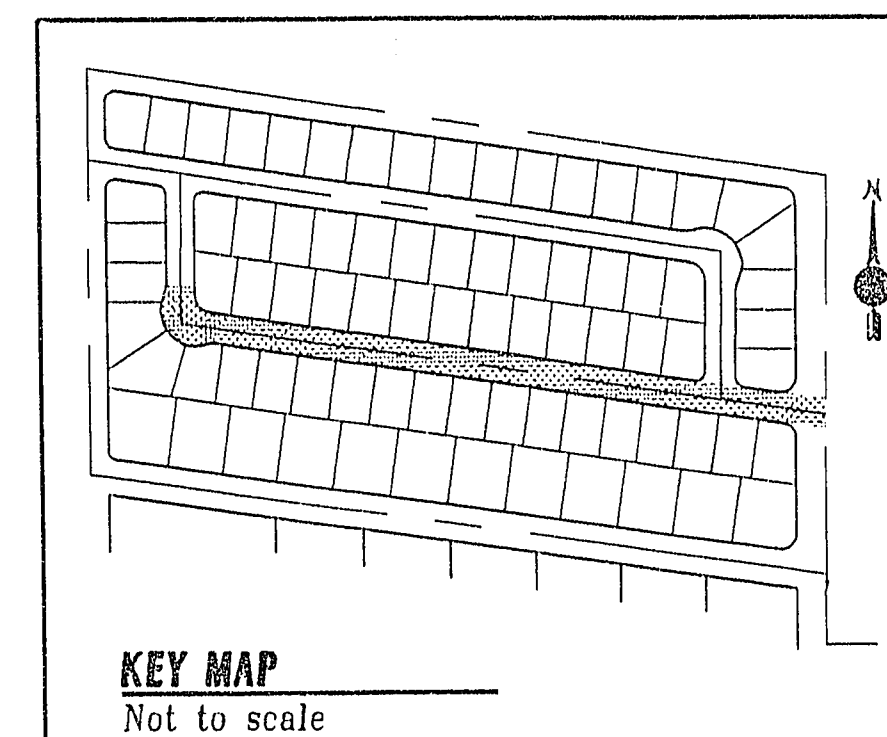

Professional Engineer
CIVIL
No. 9433
STATE OF NEVADA

[illegible]

11-3-129 107Y-4273-1