

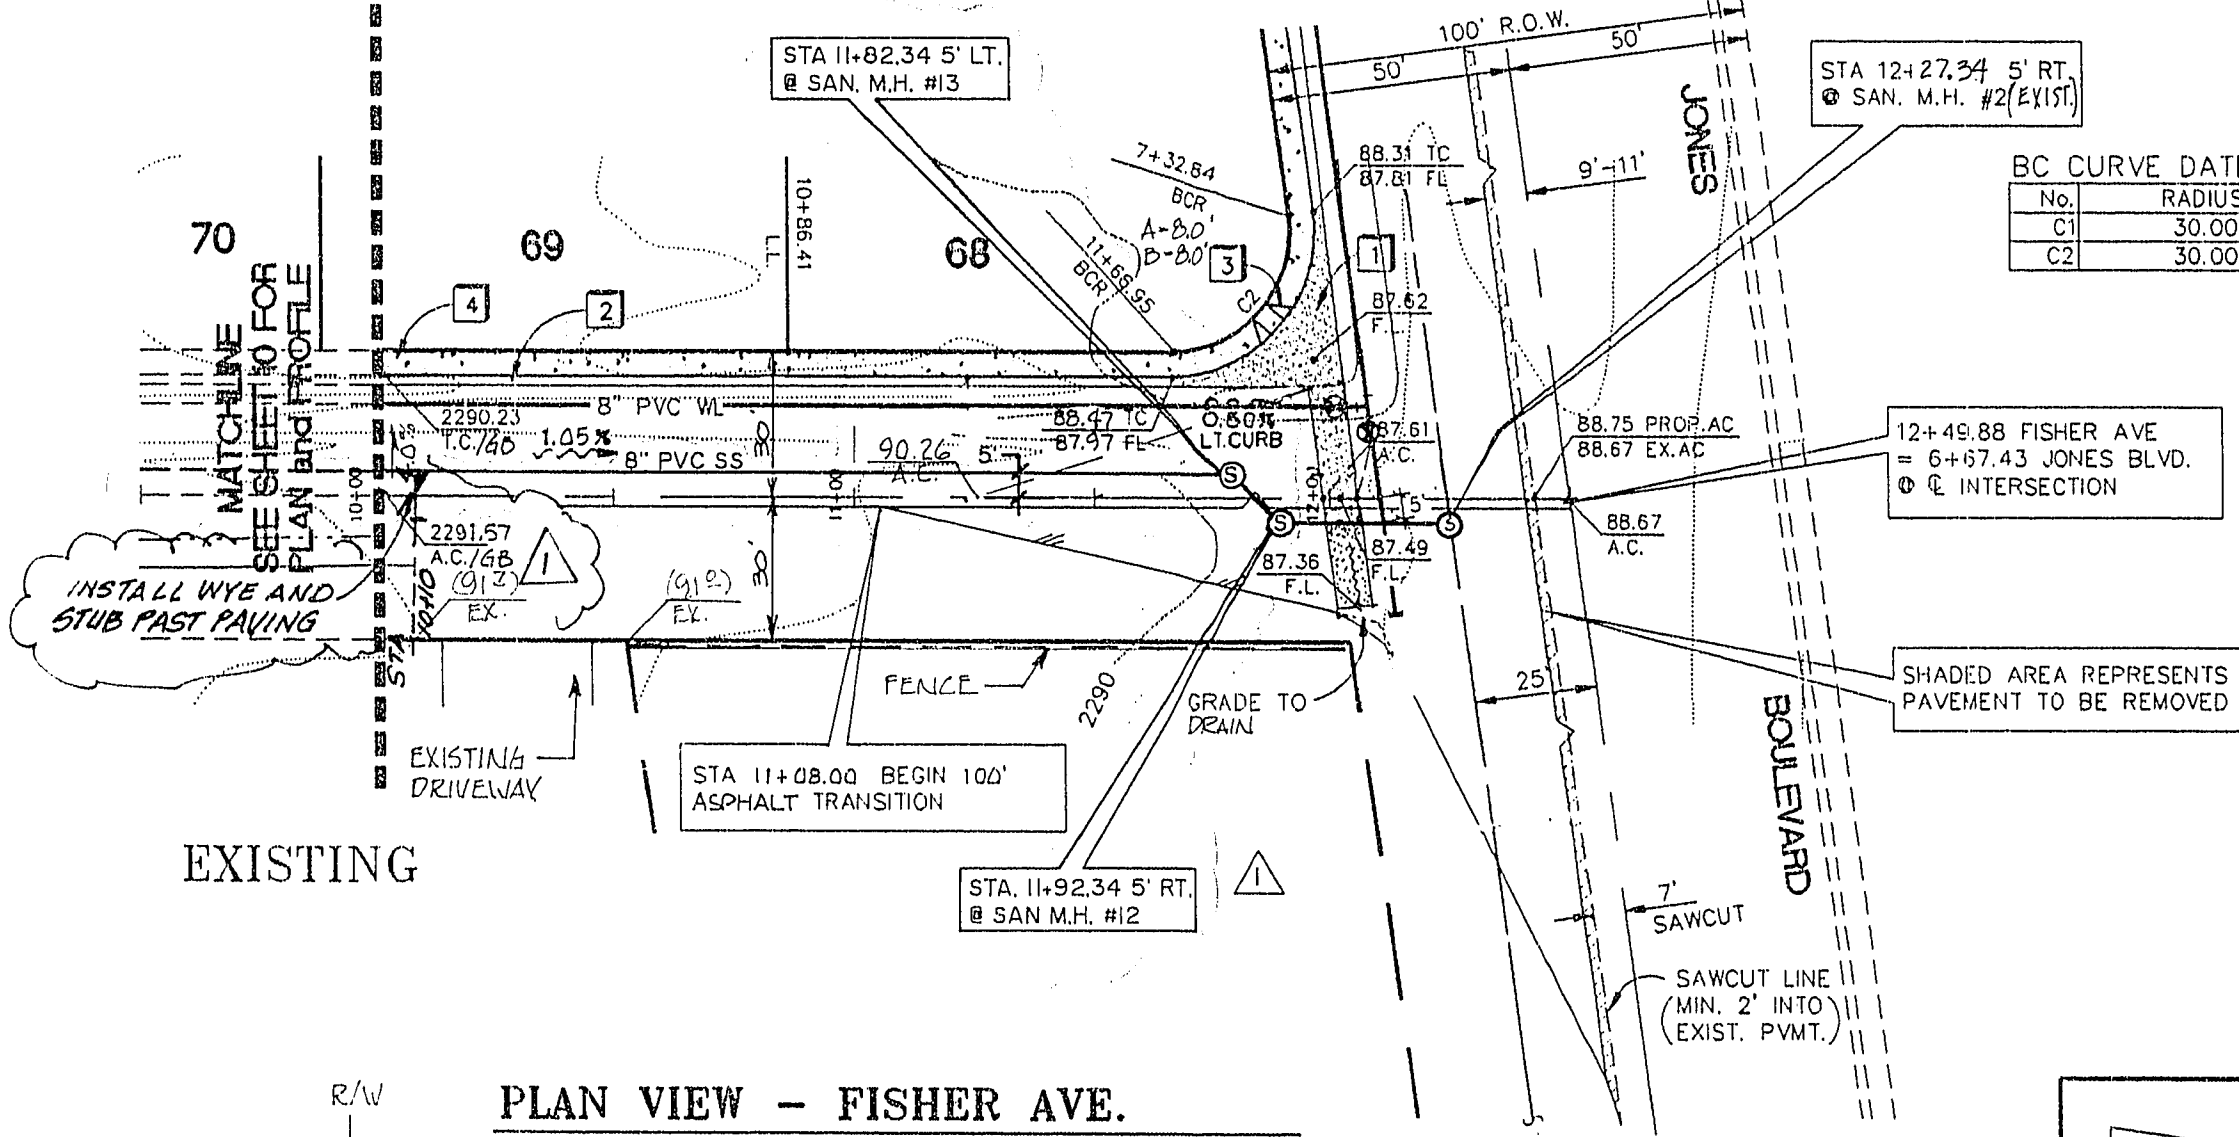



Call before you Dig
1-800-227-2600

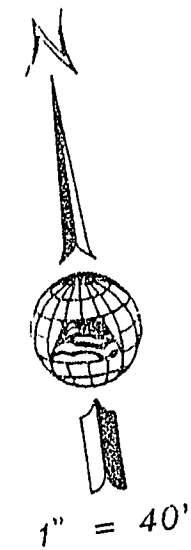


PLAN VIEW - FISHER AVE.
HORIZONTAL SCALE: 1" = 40'

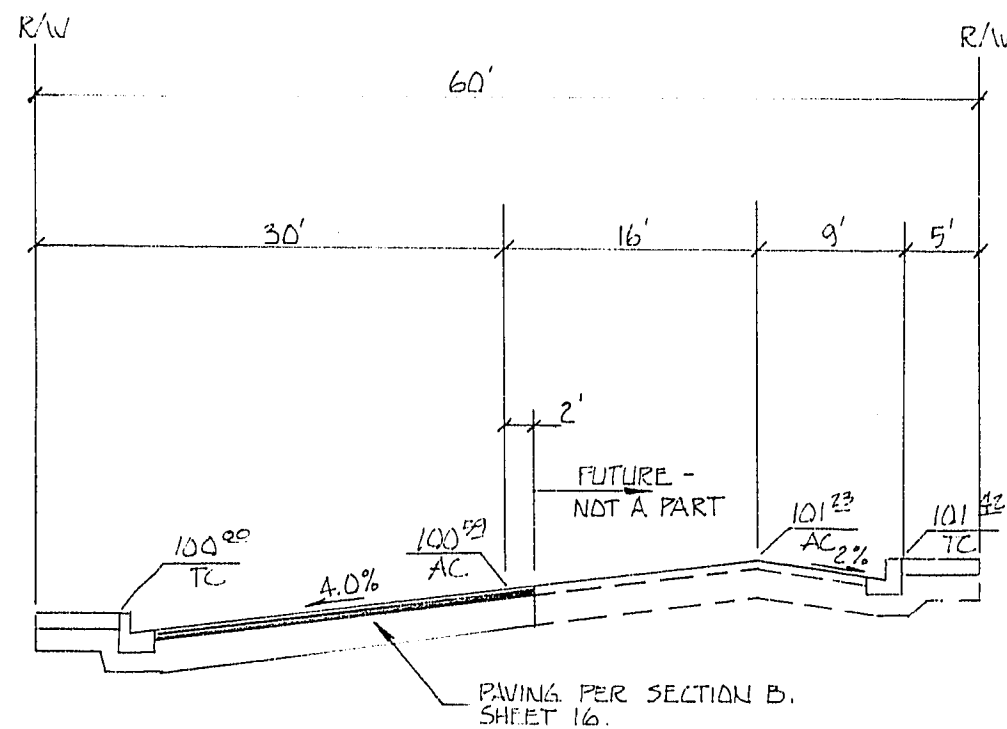

FISHER AVE. - OFFSET CROWN DETAIL - STA 10+00
N.T.S.

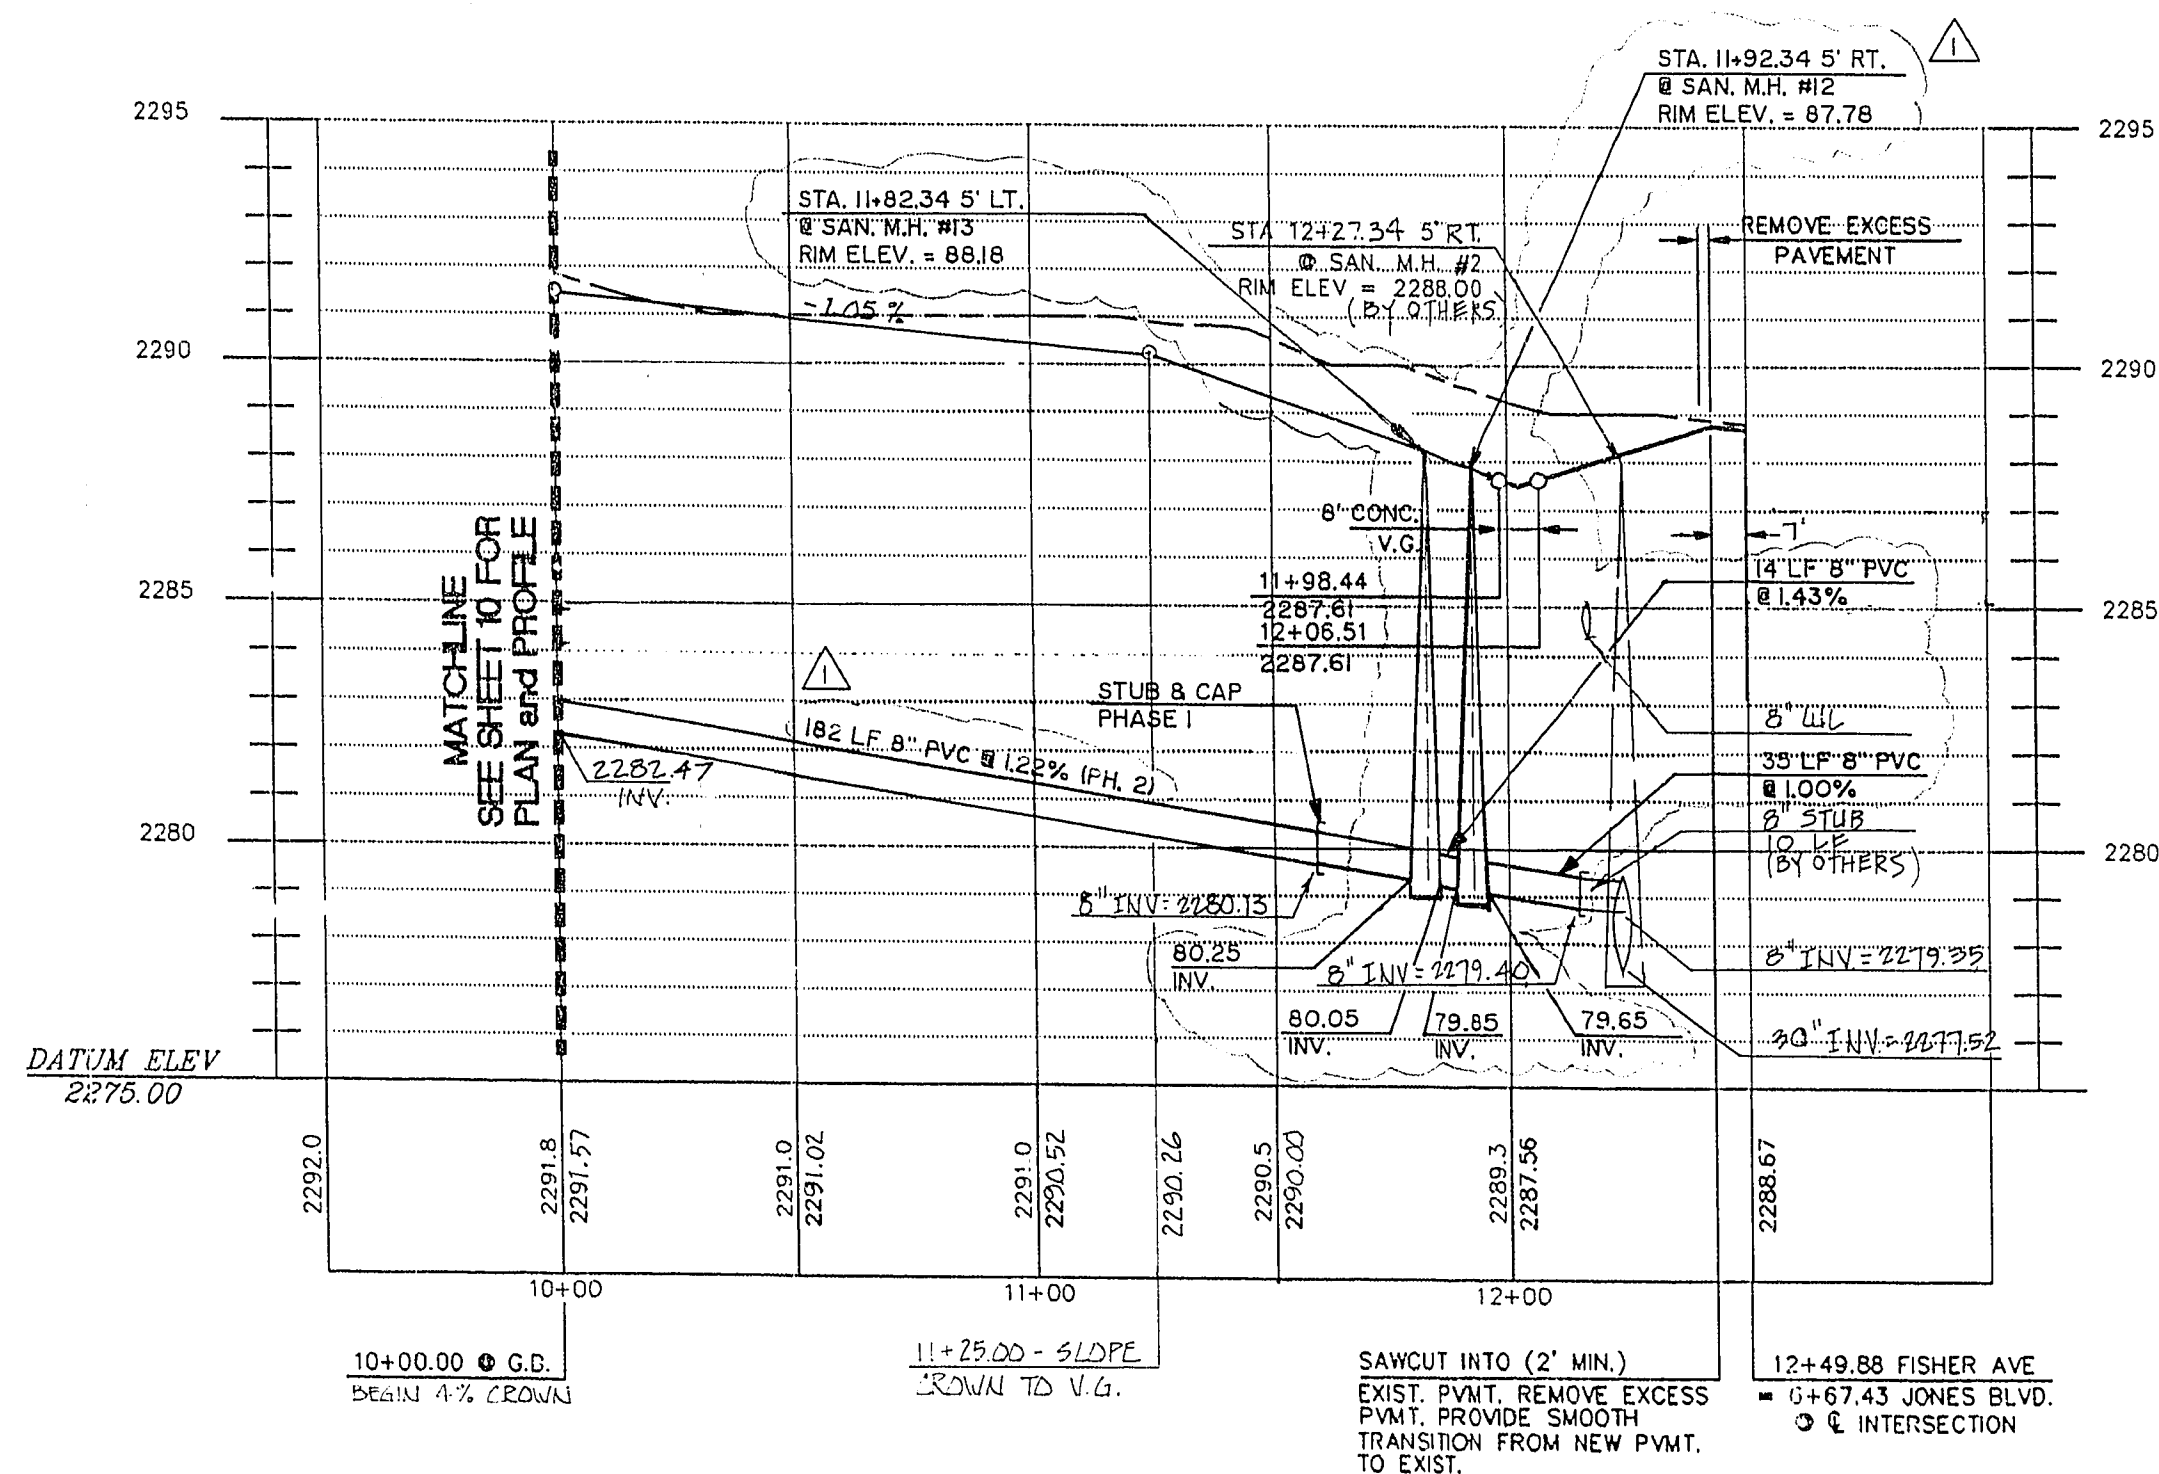


PROFILE - FISHER AVE.
HORIZONTAL SCALE: 1" = 40'
VERTICAL SCALE: 1" = 4'

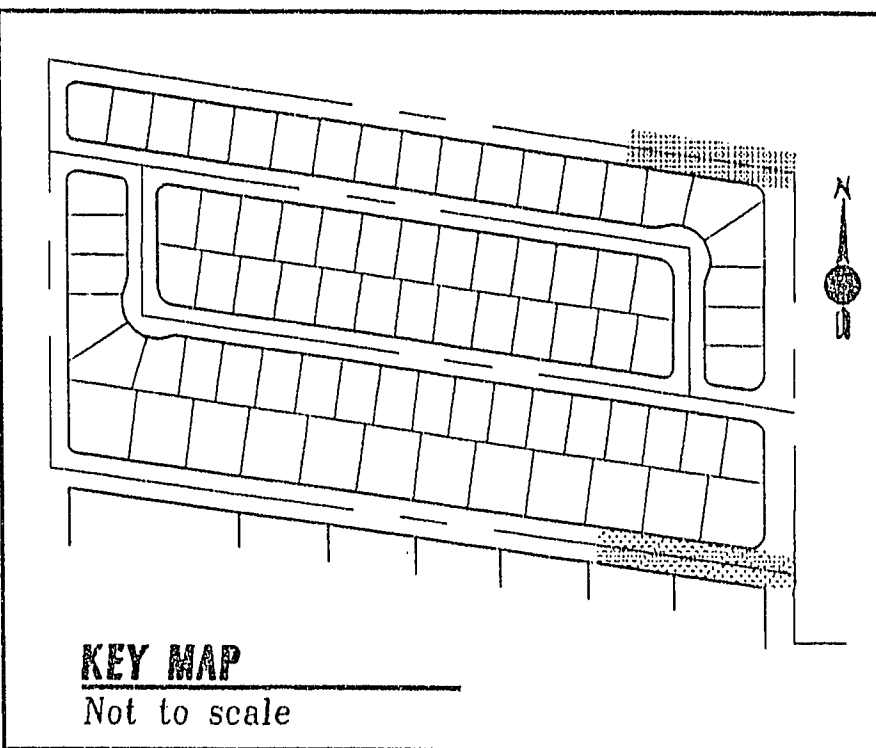

KEY MAP
Not to scale



PROPOSED MOUNTAIN MEADOWS
SUBDIVISION

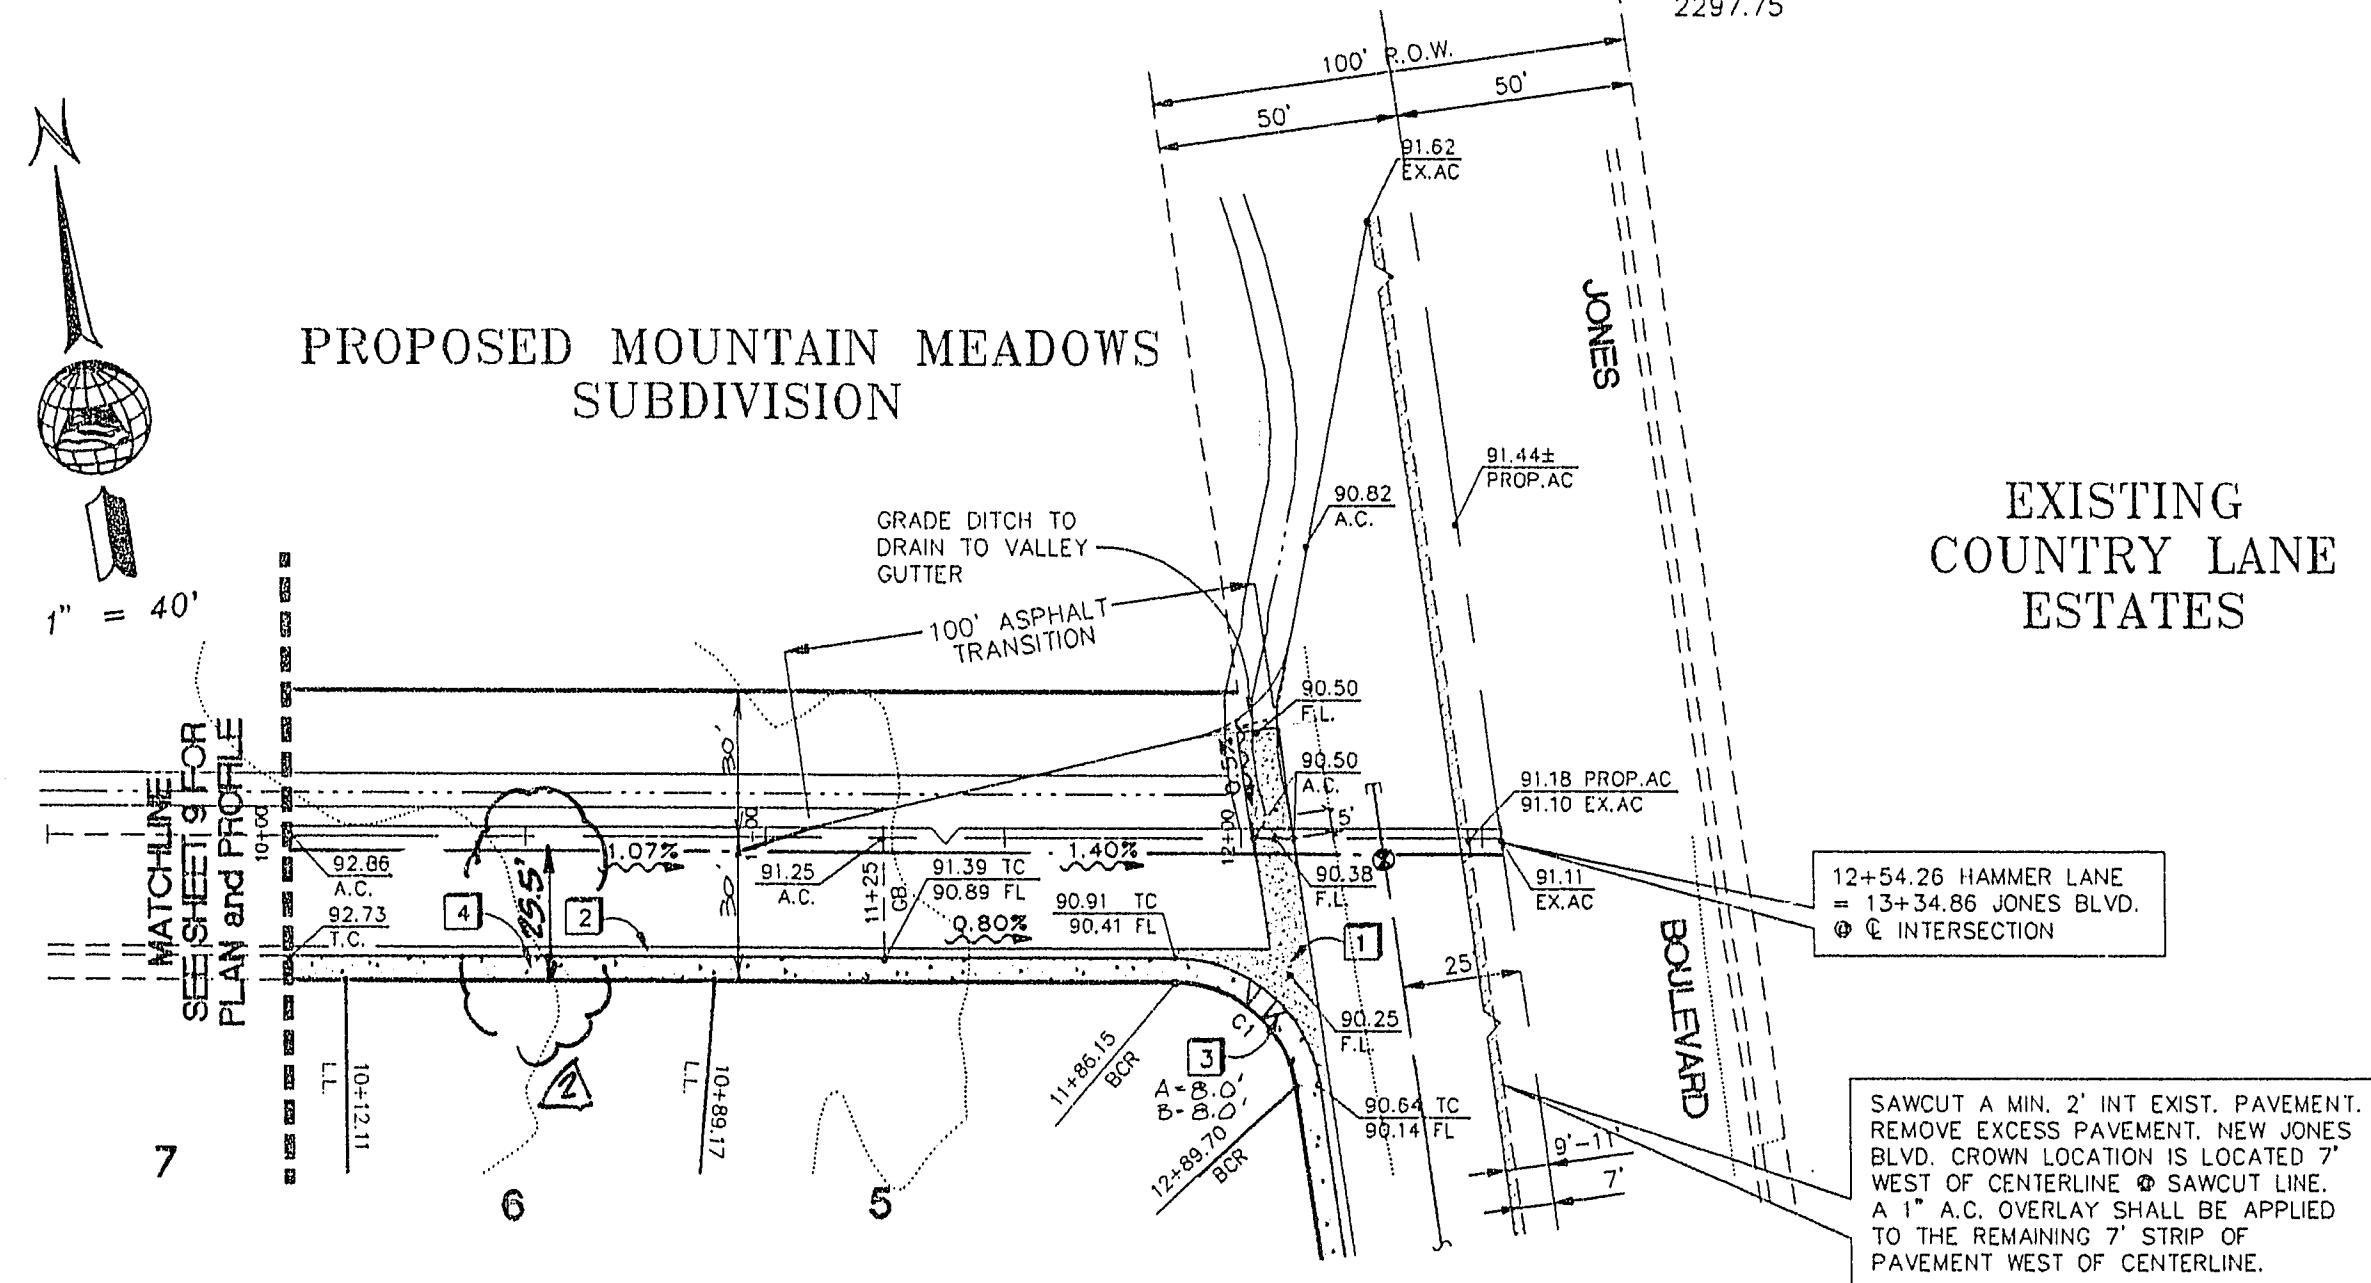


PLAN VIEW - HAMMER LANE
HORIZONTAL SCALE: 1" = 40'

CONSTRUCTION NOTES


1. CONSTRUCT CONCRETE CROSS GUTTER PER DWG. NO. 229, UNIFORM STANDARD DRAWINGS FOR PUBLIC WORKS.
2. CONSTRUCT OFF-SITE IMPROVEMENTS: CONSTRUCT 24" CONCRETE "L" CURB & GUTTER PER DETAIL SHEET 16.
3. CONSTRUCT SIDEWALK RAMP PER DWG. NO. 235 (CASE 1) UNIFORM STANDARD DRAWINGS FOR PUBLIC WORKS.
4. CONSTRUCT 5' WIDE CONCRETE SIDEWALK AS PER DETAIL SHEET 16.

GENERAL NOTES

1. ADD 2.00' TO PLAN VIEW ELEVATIONS.
2. REFERENCE SHEET 16 FOR TYPICAL STREET SECTIONS.

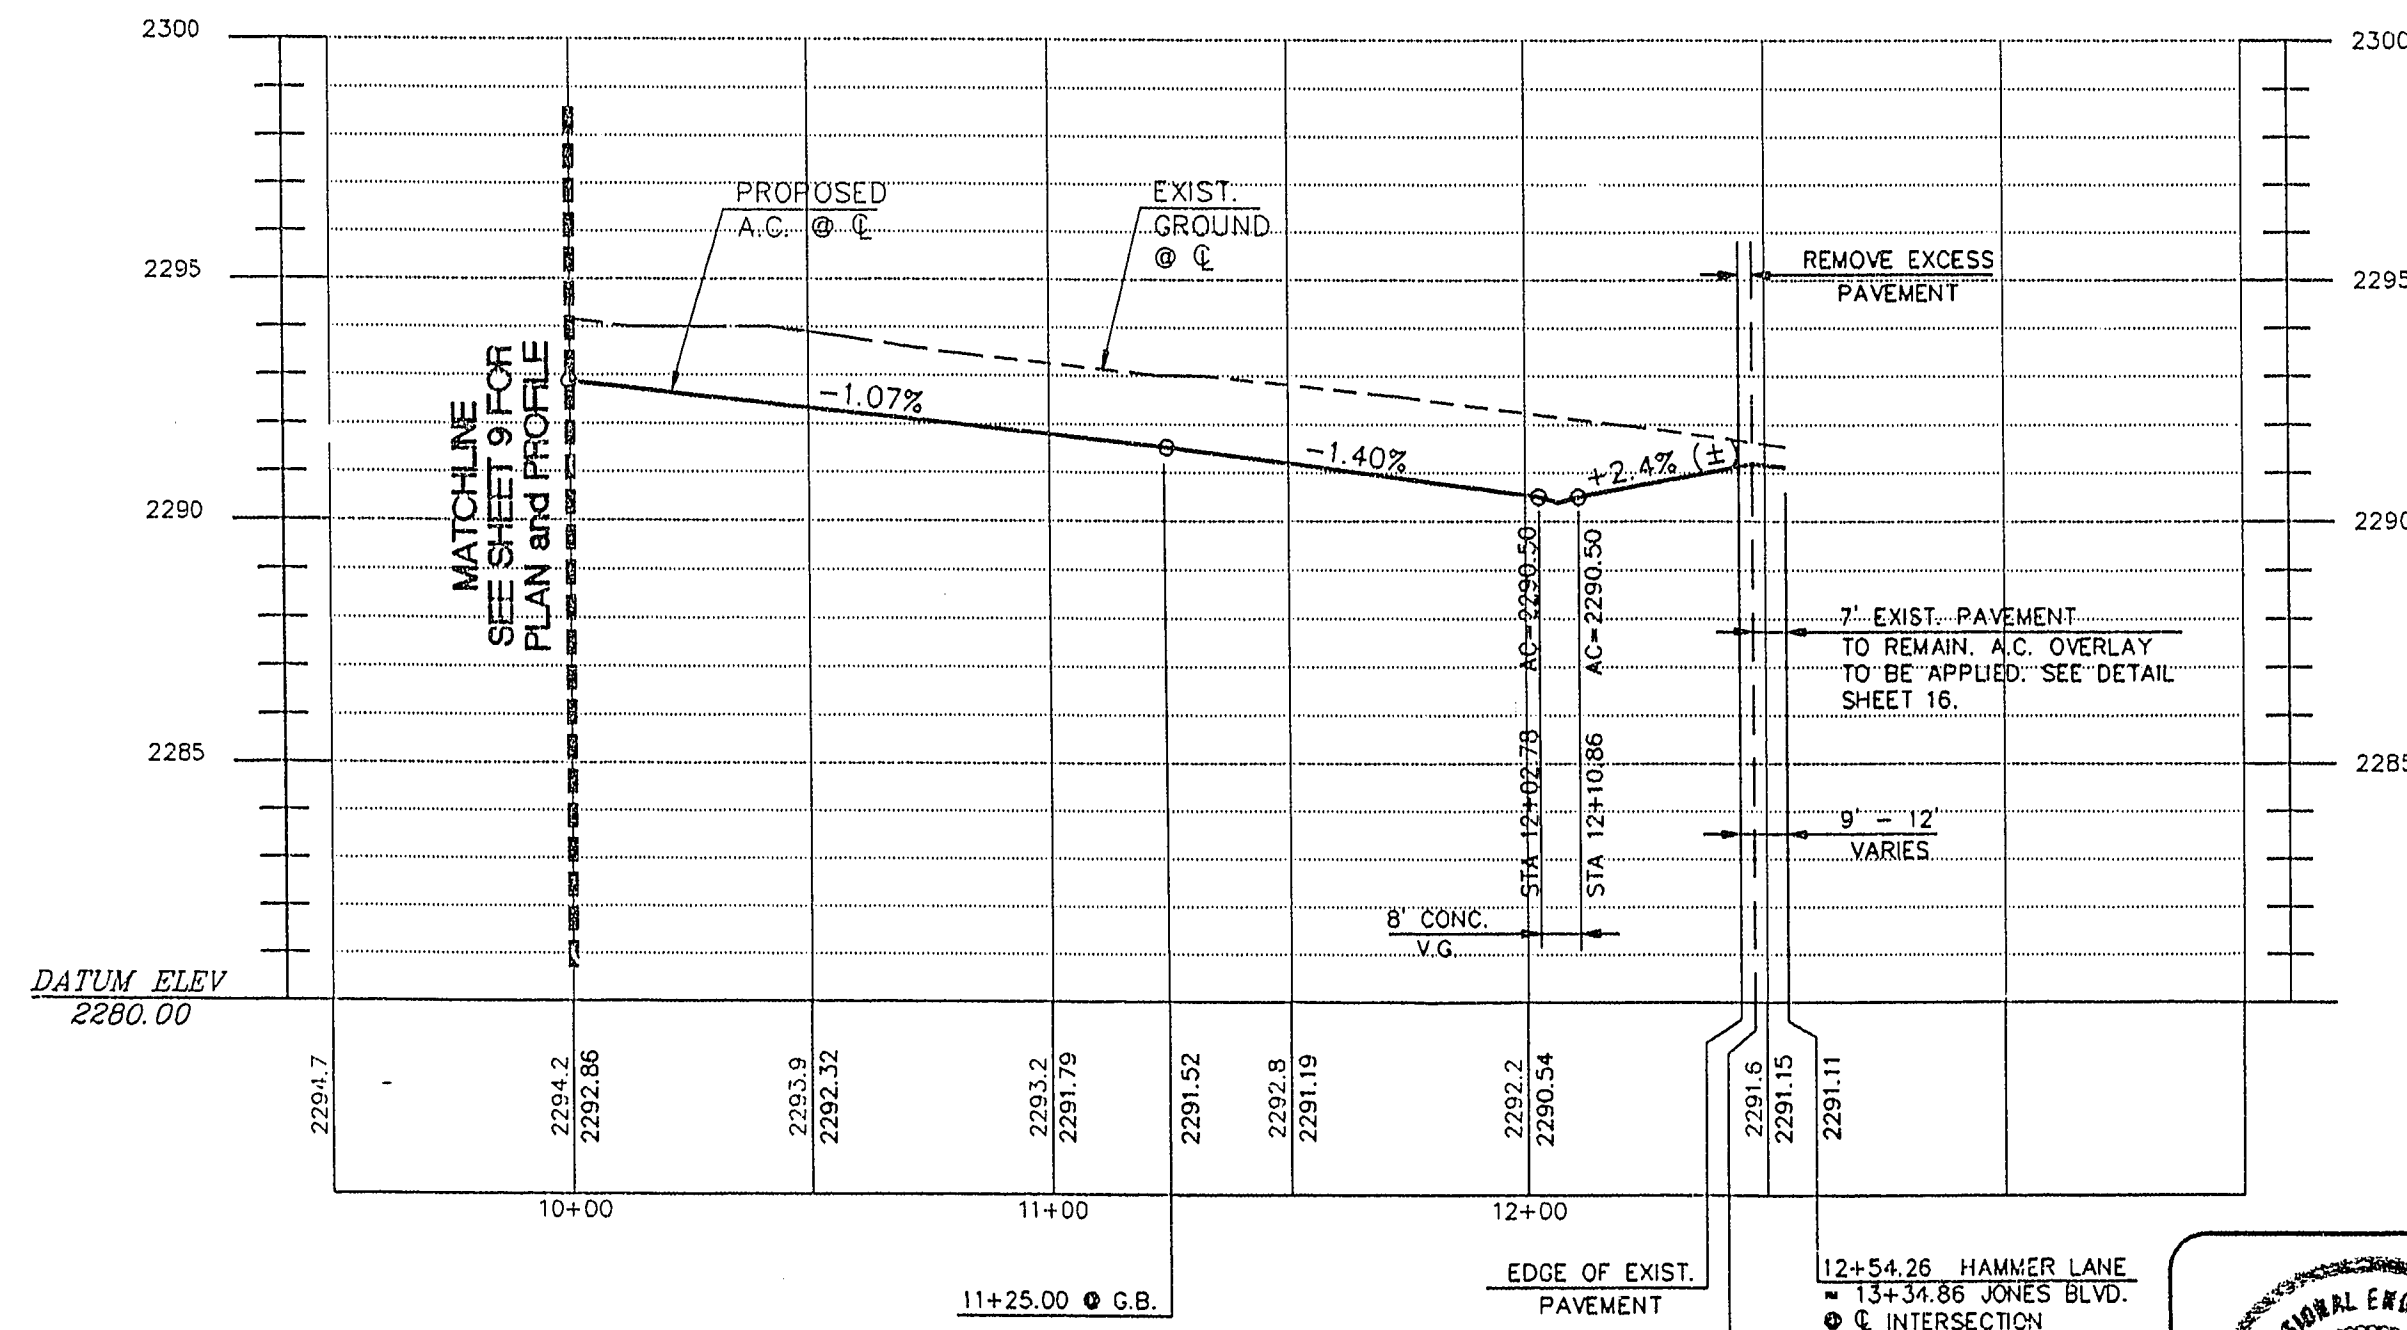

PROFILE - HAMMER LANE
HORIZONTAL SCALE: 1" = 40'
VERTICAL SCALE: 1" = 4'

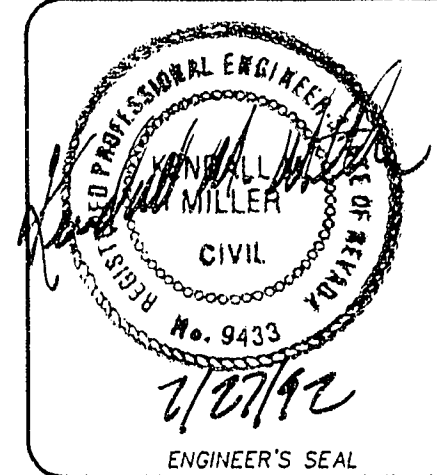

BENCHMARK
CLV BENCHMARK # ILV9026SES, RIVET & PLATE
IN CONCRETE MONUMENT AT NW RETURN OF
ANN ROAD AND JONES BLVD.
ELEVATION PER CITY OF LAS VEGAS DATUM
2287.75

Job Number	Sheet Number	Drawn by	Checked by	Date	Scale	File No.	Job Title	Project Name	Client Name	Contract No.	Revision No.	Revision Description	Date	Appr.	Date
7121.455	11 OF 16	MM	MM	7/24/92	1" = 40'	455IMP	DESERT ROSE SUBDIVISION	PLAN AND PROFILES HAMMER LANE 10+00.00 THRU FISHER AVE 10+00.00 THRU	Church Engineering of Nevada, Inc.	6600 W. Charleston Blvd. Suite 140 Las Vegas, NV 89102 (702) 878-6244	1	ADDED 2.00' TO PLAN VIEW ELEVATIONS.	7/10/92	MM	7/10/92