


Call before you Dig
1-800-227-2600

BENCHMARK
CLV BENCHMARK # ILY90285ES, RIVET & PLATE
IN CONCRETE MONUMENT AT NW RETURN OF
ANN ROAD AND JONES BLVD.
ELEVATION PER CITY OF LAS VEGAS DATUM
2297.75

BC CURVE DATA TABLE			
No.	RADIUS	DELTA	LENGTH
C1	30.00'	82°08'04"	43.01'
C2	30.00'	97°51'56"	51.24'
C3	30.00'	97°32'27"	51.07'



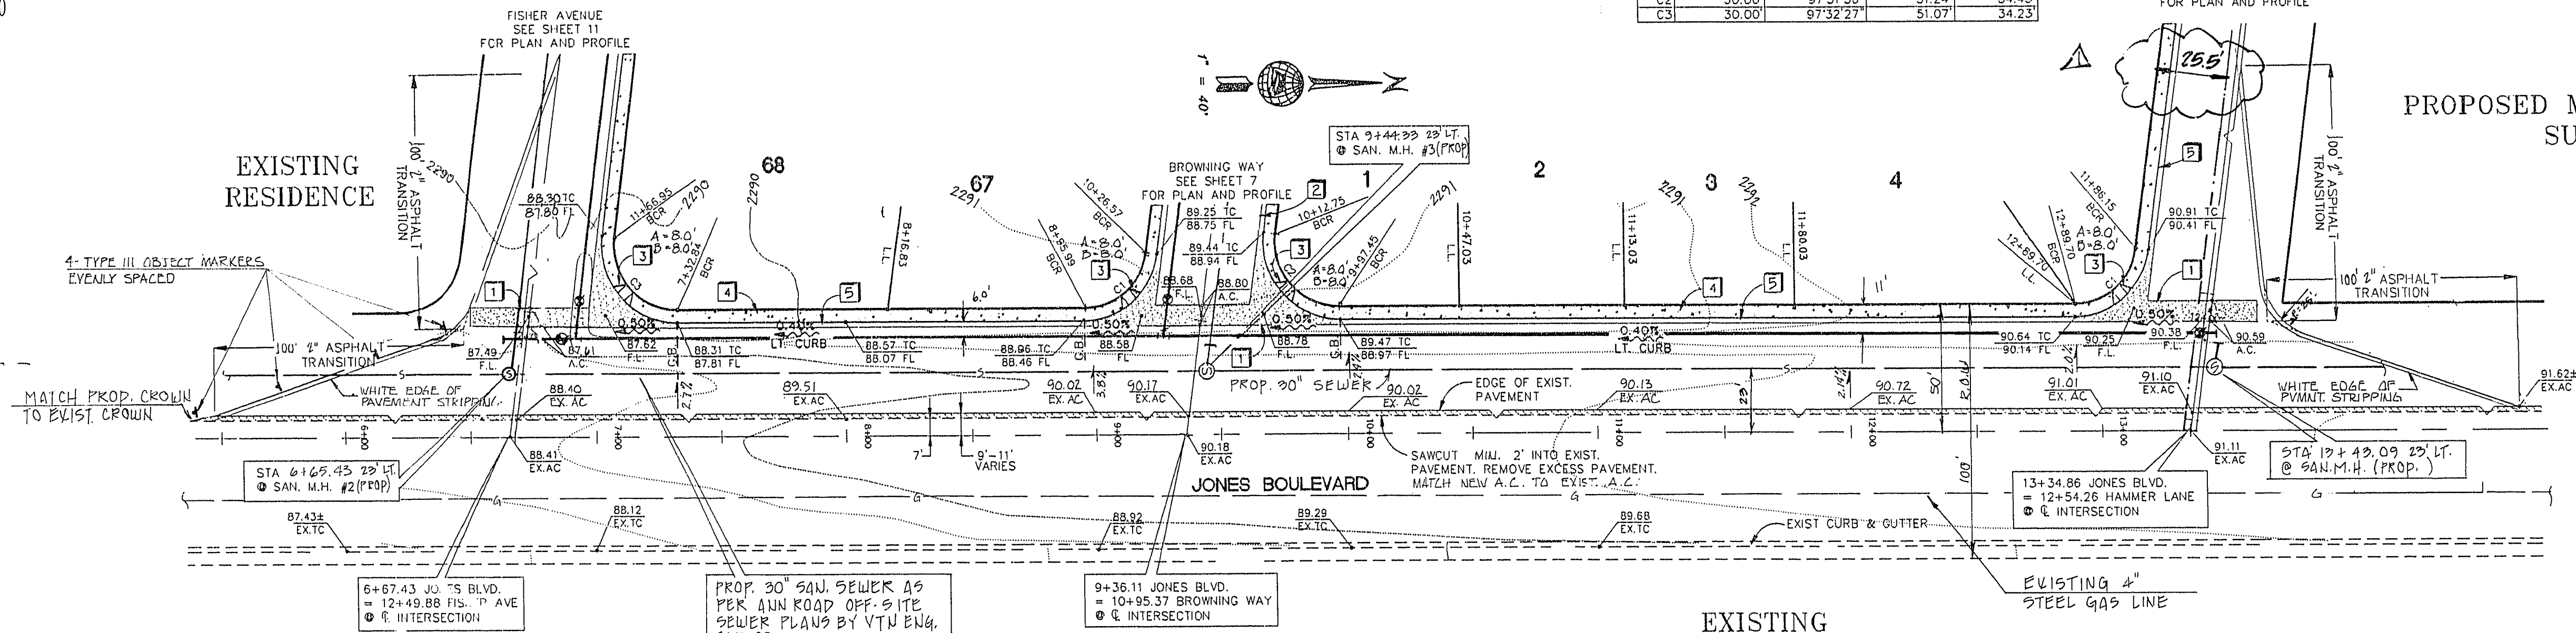


CONSTRUCTION NOTES

1. CONSTRUCT CONCRETE CROSS GUTTER PER DWG. NO. 226 AND DWG. NO. 229 UNIFORM STANDARD DRAWINGS FOR PUBLIC WORKS CONSTRUCTION OFF-SITE IMPROVEMENTS.
2. CONSTRUCT 30" CONCRETE GULLY CURB & GUTTER PER DETAIL SHEET 16.
3. CONSTRUCT SIDEWALK RAMP PER DWG. NO. 225 (CASE 1) UNIFORM STANDARD DRAWINGS FOR PUBLIC WORKS CONSTRUCTION OFF-SITE IMPROVEMENTS.
4. CONSTRUCT 5' WIDE CONCRETE SIDEWALK AS PER DETAIL SHEET 16.
5. CONSTRUCT 24" "L-TYPE" CURB AND GUTTER PER DETAIL SHEET 16.

GENERAL NOTES

1. ADD 2100' TO PLAN VIEW ELEVATIONS.
2. REFERENCE SHEET 16 FOR TYPICAL STREET SECTIONS.

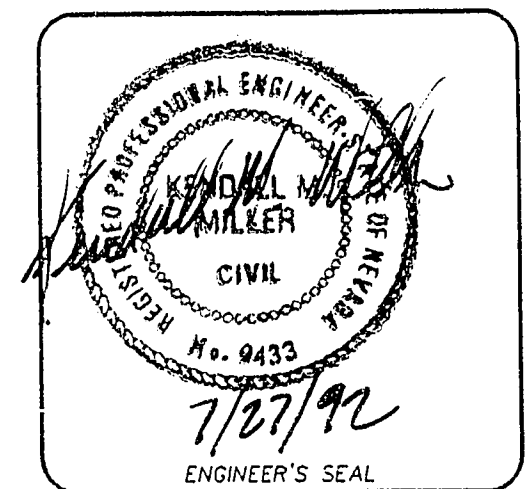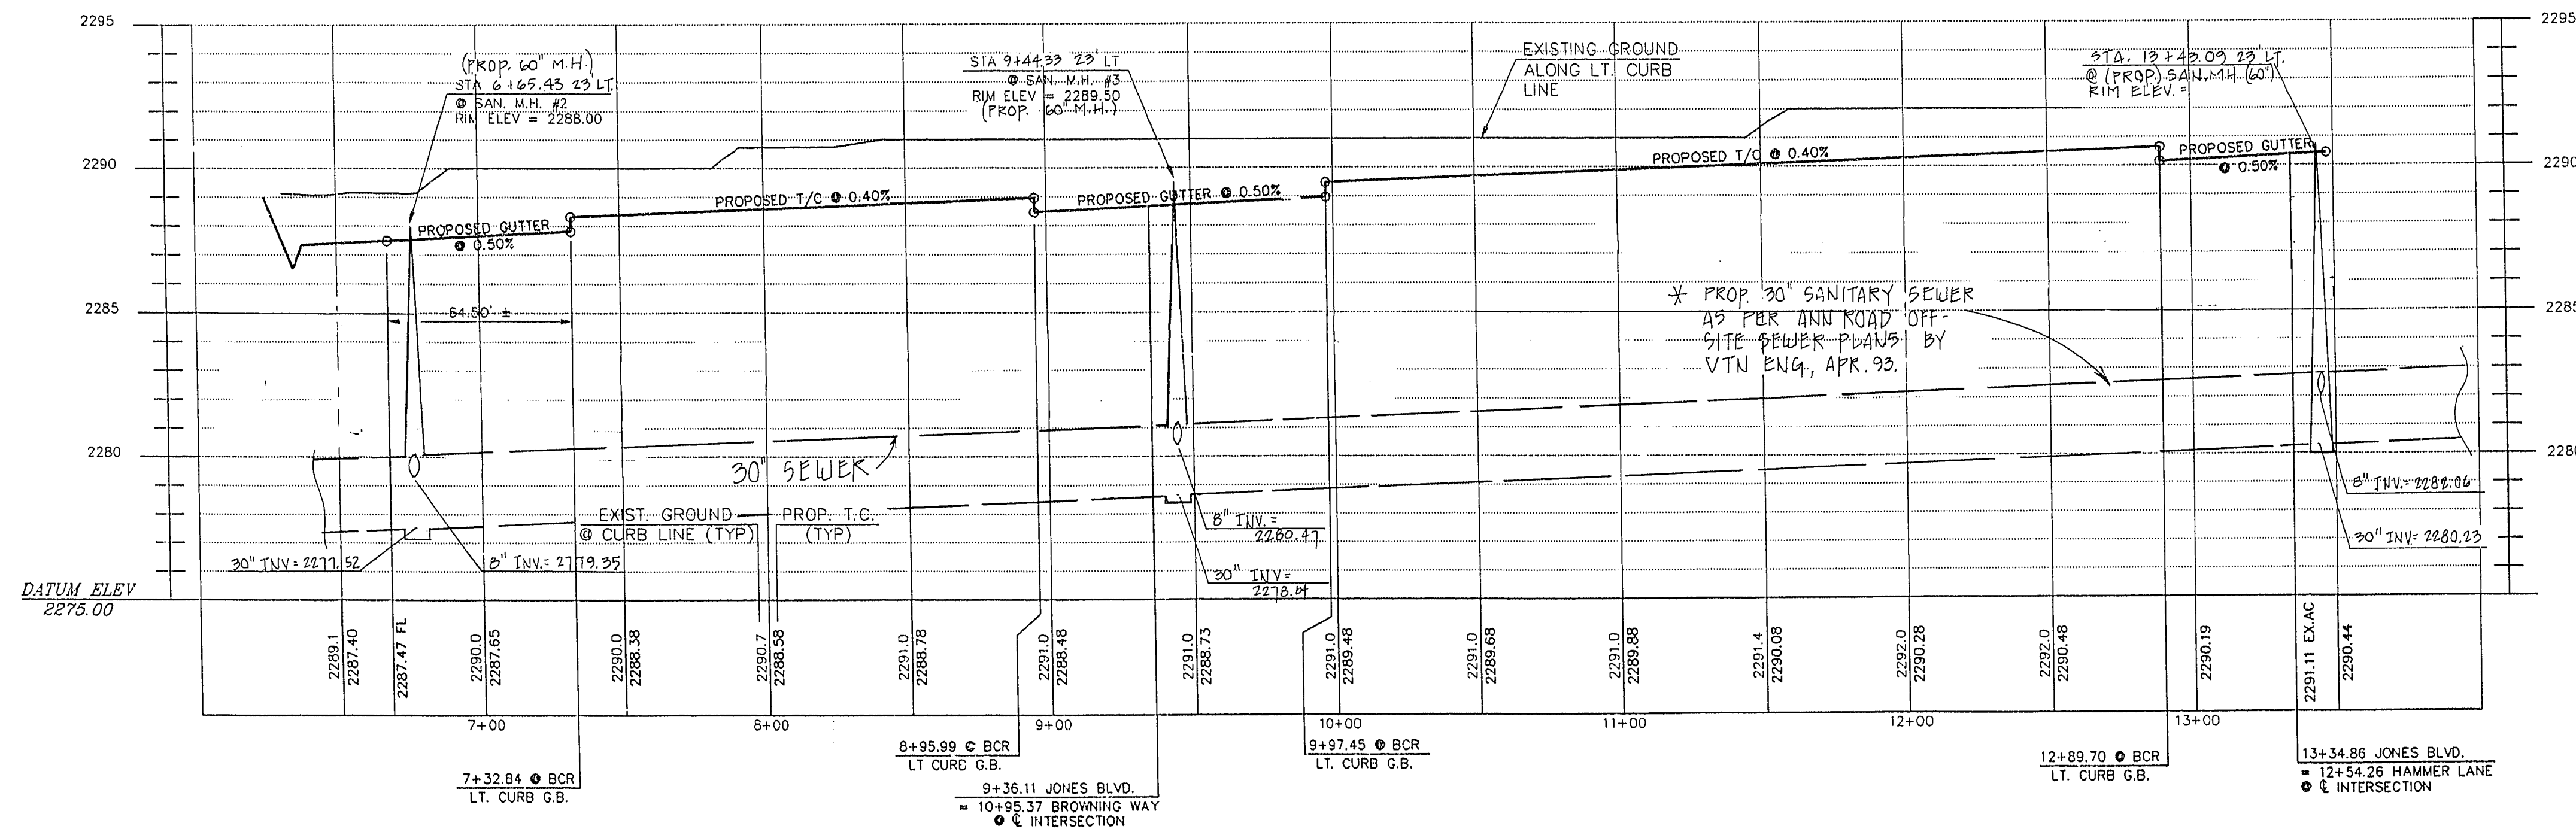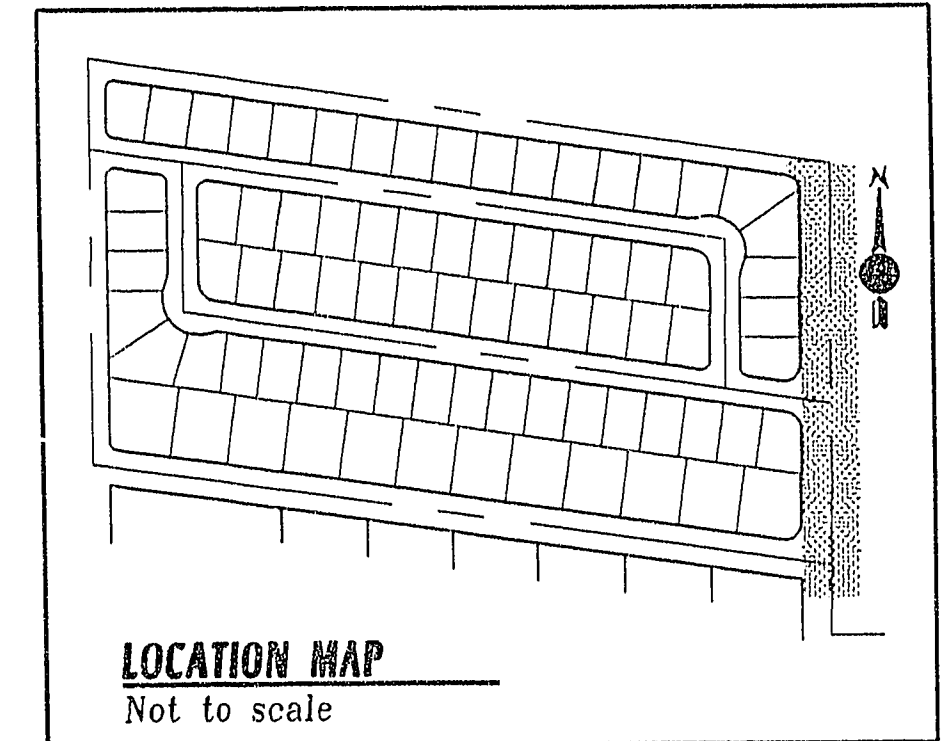

REVISIONS		No.	Date	Appr.	By
1		1	7/27/92	REUSE	HAMMER L.N.

Church Engineering of Nevada, Inc.	Scale	Drawn by	Job Number
Consulting Engineers Planners Surveyors	1" = 40'	MM	7121.455
6600 W. Charleston Blvd. Suite 140 Las Vegas, NV 89102 (702) 878-6244	File No.	Checked by	Sheet Number
	455IMP	MM	12 OF 16
DESERT ROSE	Date		
	JULY 24, 1992		
PLAN AND PROFILE JONES BLVD.			

11-3-134

107Y-4273-1