

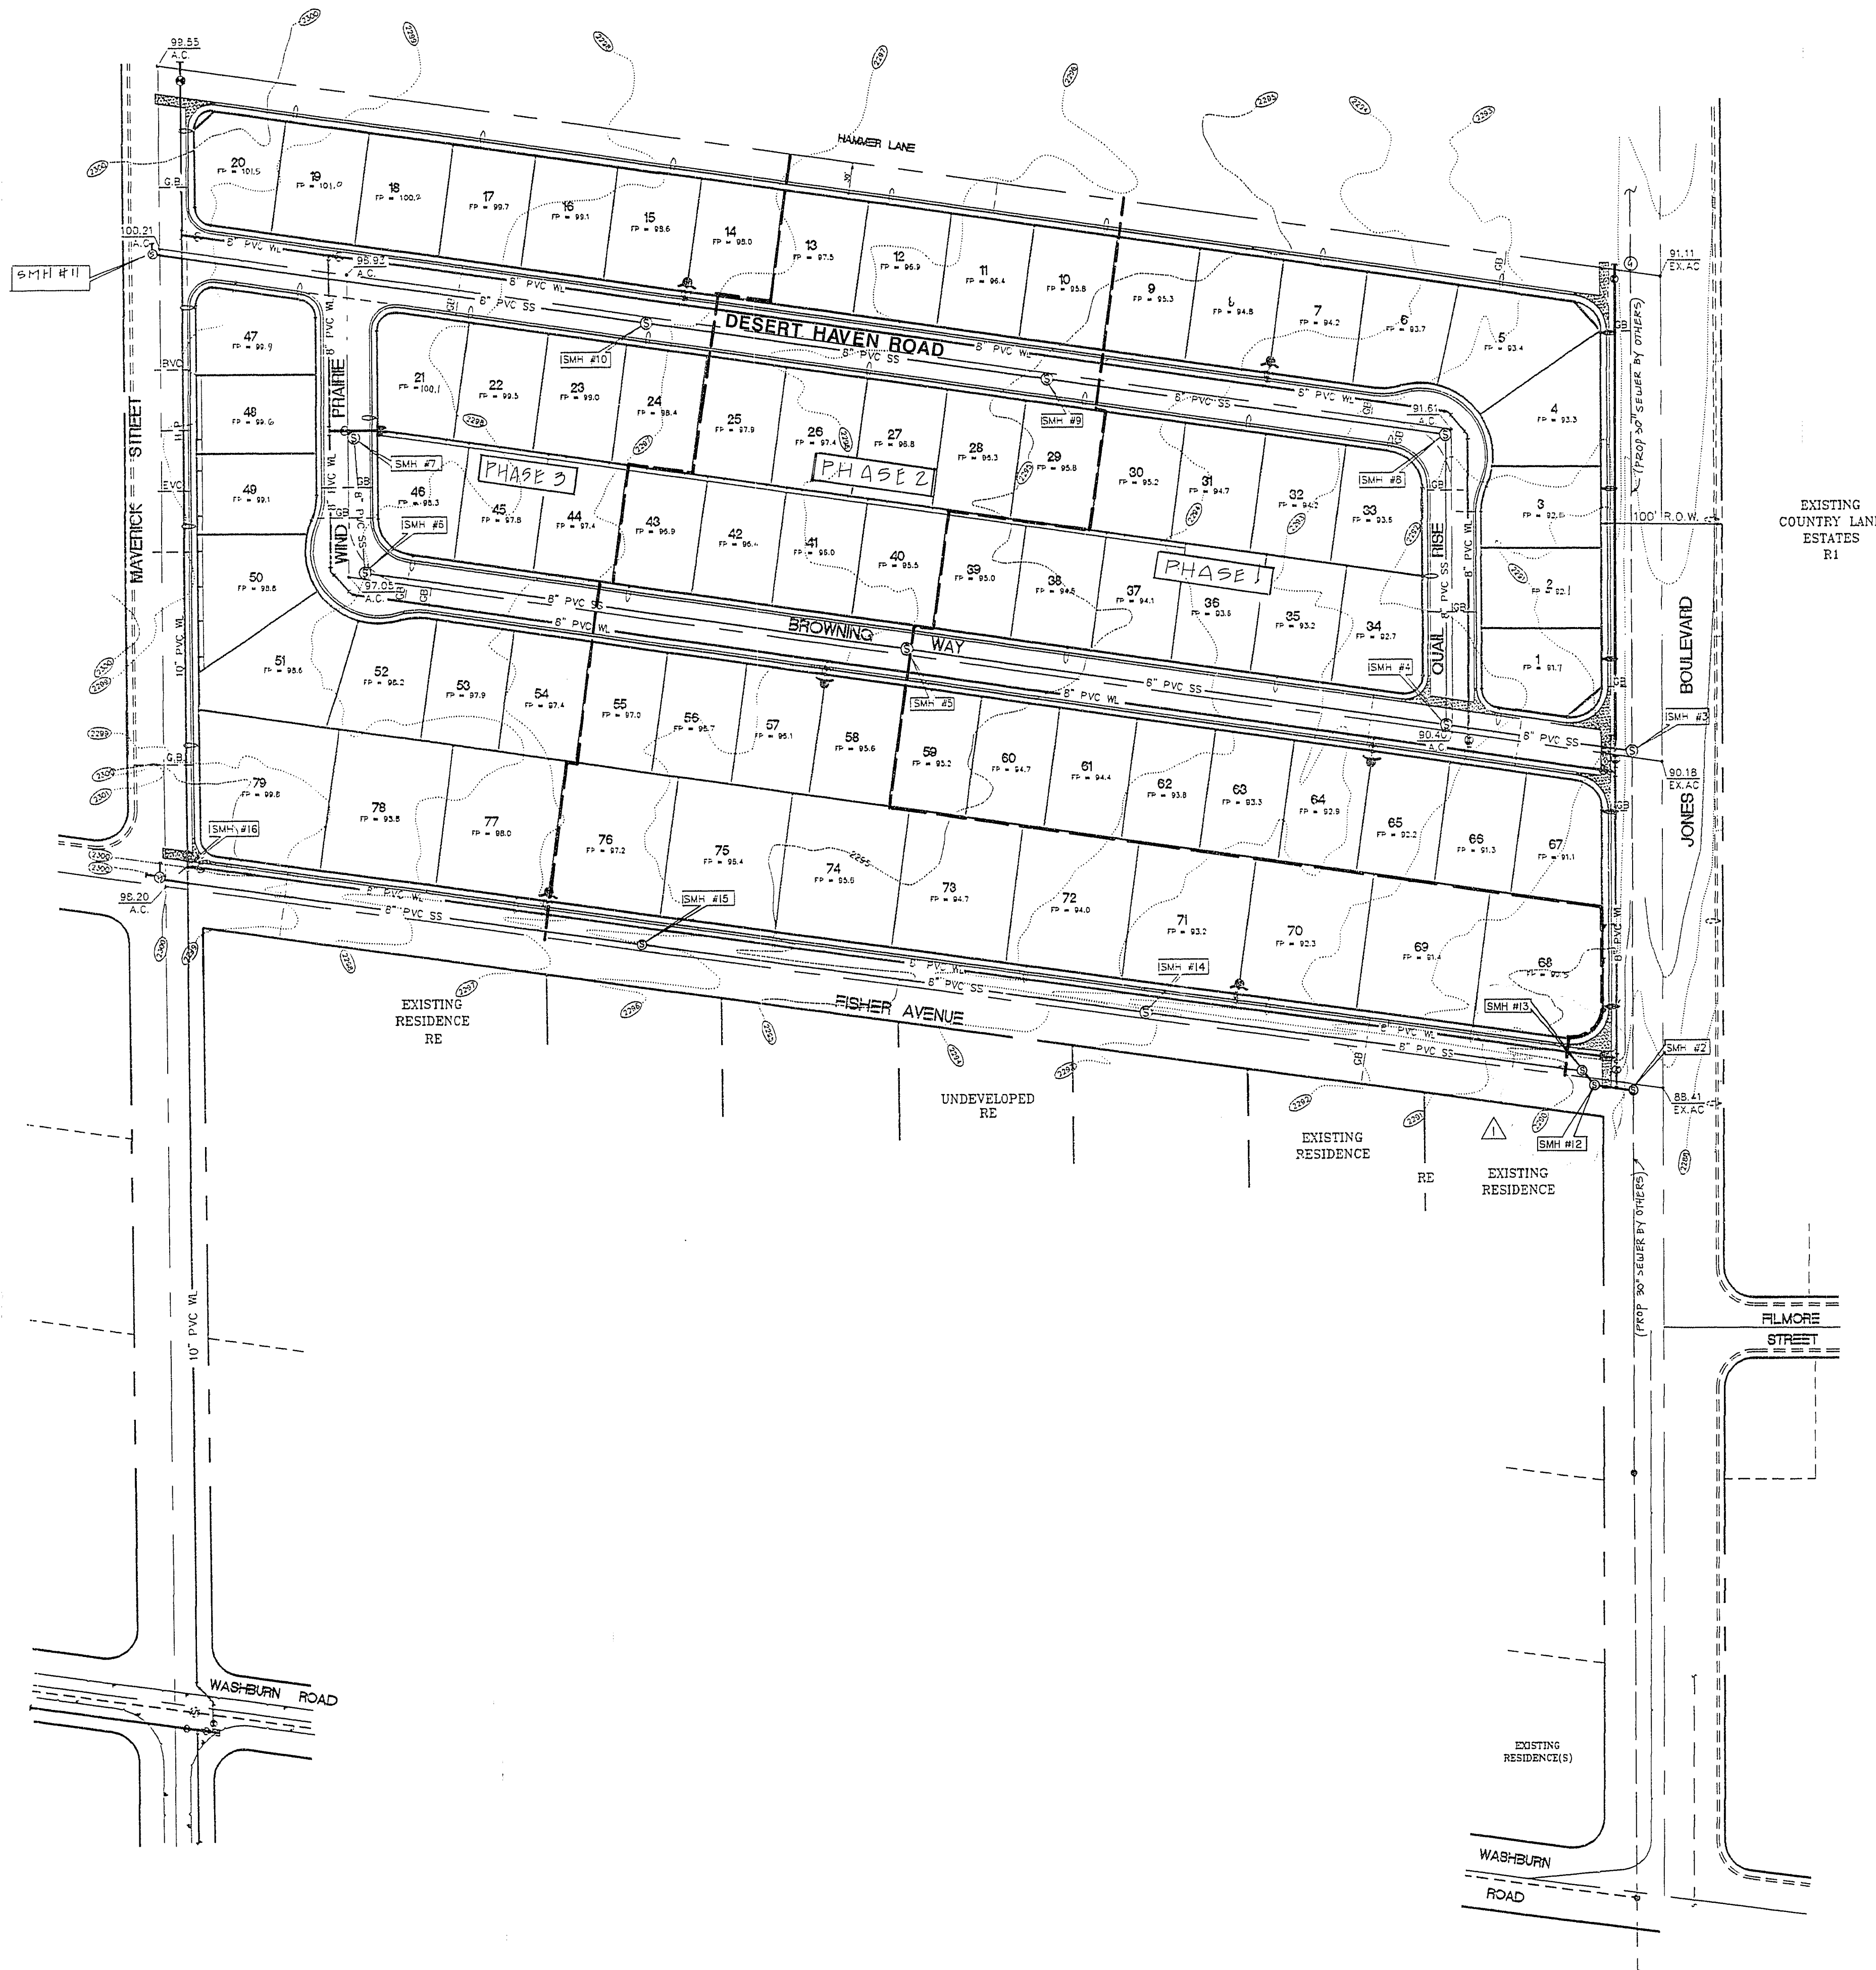
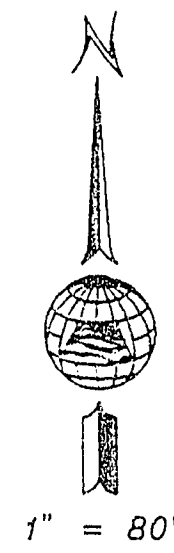


Call
before you
Dig
1-800-227-2600

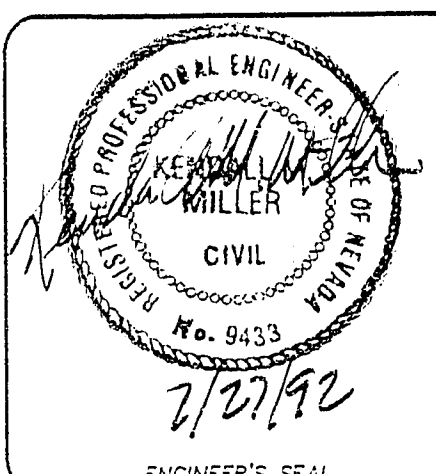

BENCHMARK
CLV BENCHMARK # ILV9026SES, RIVET & PLATE
IN CONCRETE MONUMENT AT NW RETURN OF
ANN ROAD AND JONES BLVD.
ELEVATION PER CITY OF LAS VEGAS DATUM
2297.75

EXISTING
COUNTRY LANE
ESTATES
R1

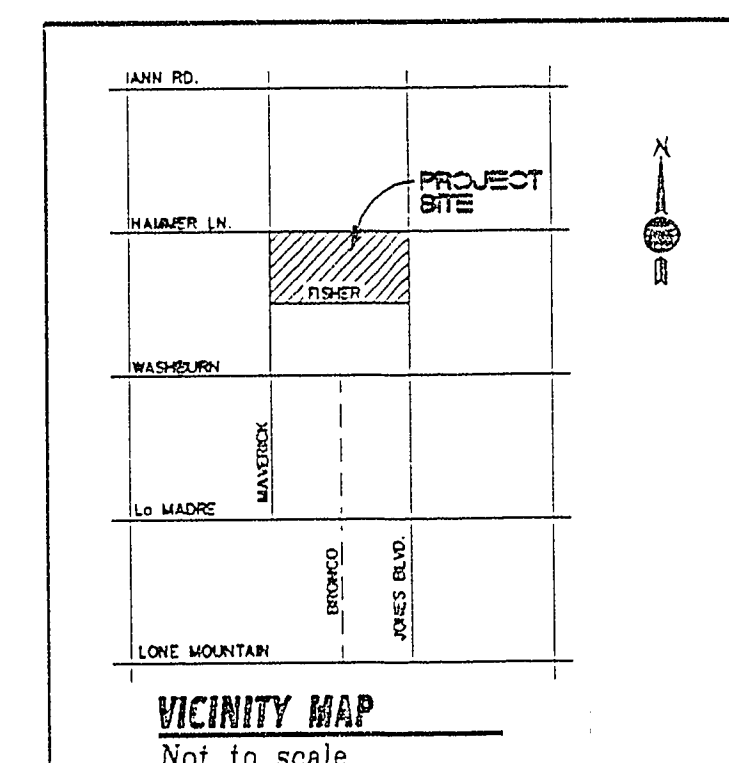

57

Job Number 7121.455		Drawn by mm	Scale 1" = 80'	MASTER SITE PLAN		DESERT ROSE SUBDIVISION				Church Engineering of Nevada, Inc. Consulting Engineers Planners Surveyors  6000 W. Charleston Blvd. Suite 140 Las Vegas, Nv. 89102 (702) 978-6244				REVISIONS				Appr		Date	
Sheet Number 2 OF 16		Checked by abc	Date JULY 24, 1992	File No. 455MP					No. A	Added 2 MINHOLES MAY 20 25 4 12 4 13	Init	3/7/94	Appr CH	3/10/94							