



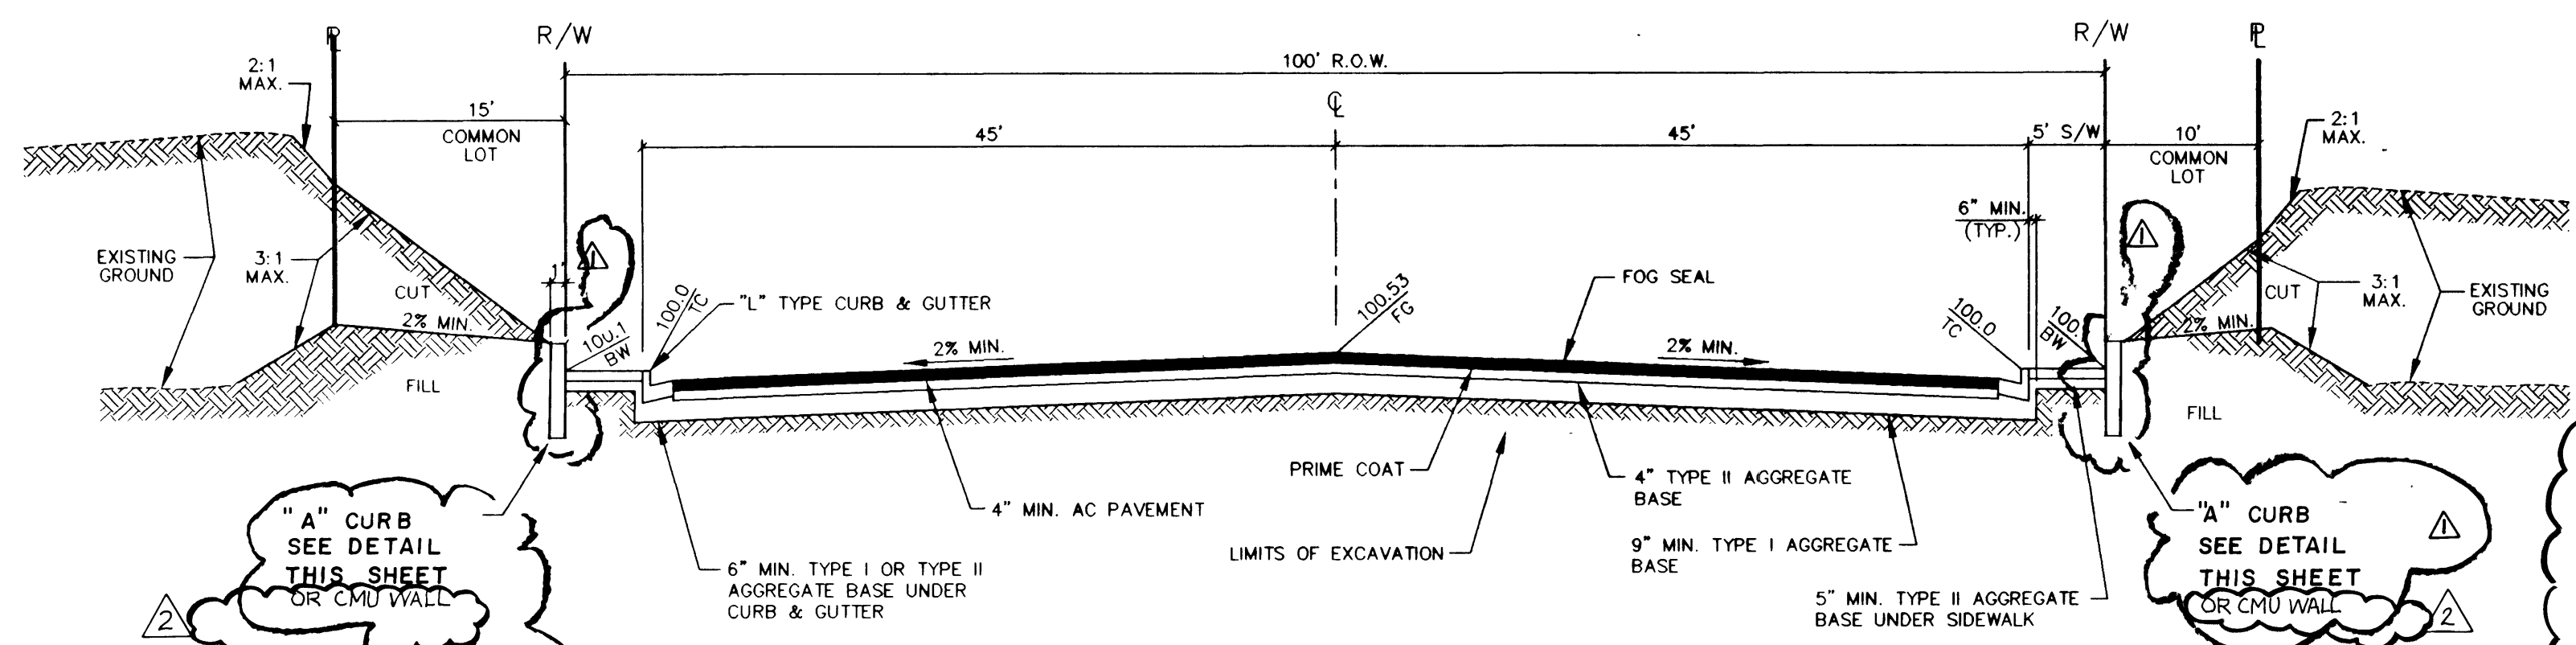


BUFFALO DRIVE
STA. 10+74.95 TO STA. 36+86.85

1" = 10' HORIZ.
1" = 5' VERT.

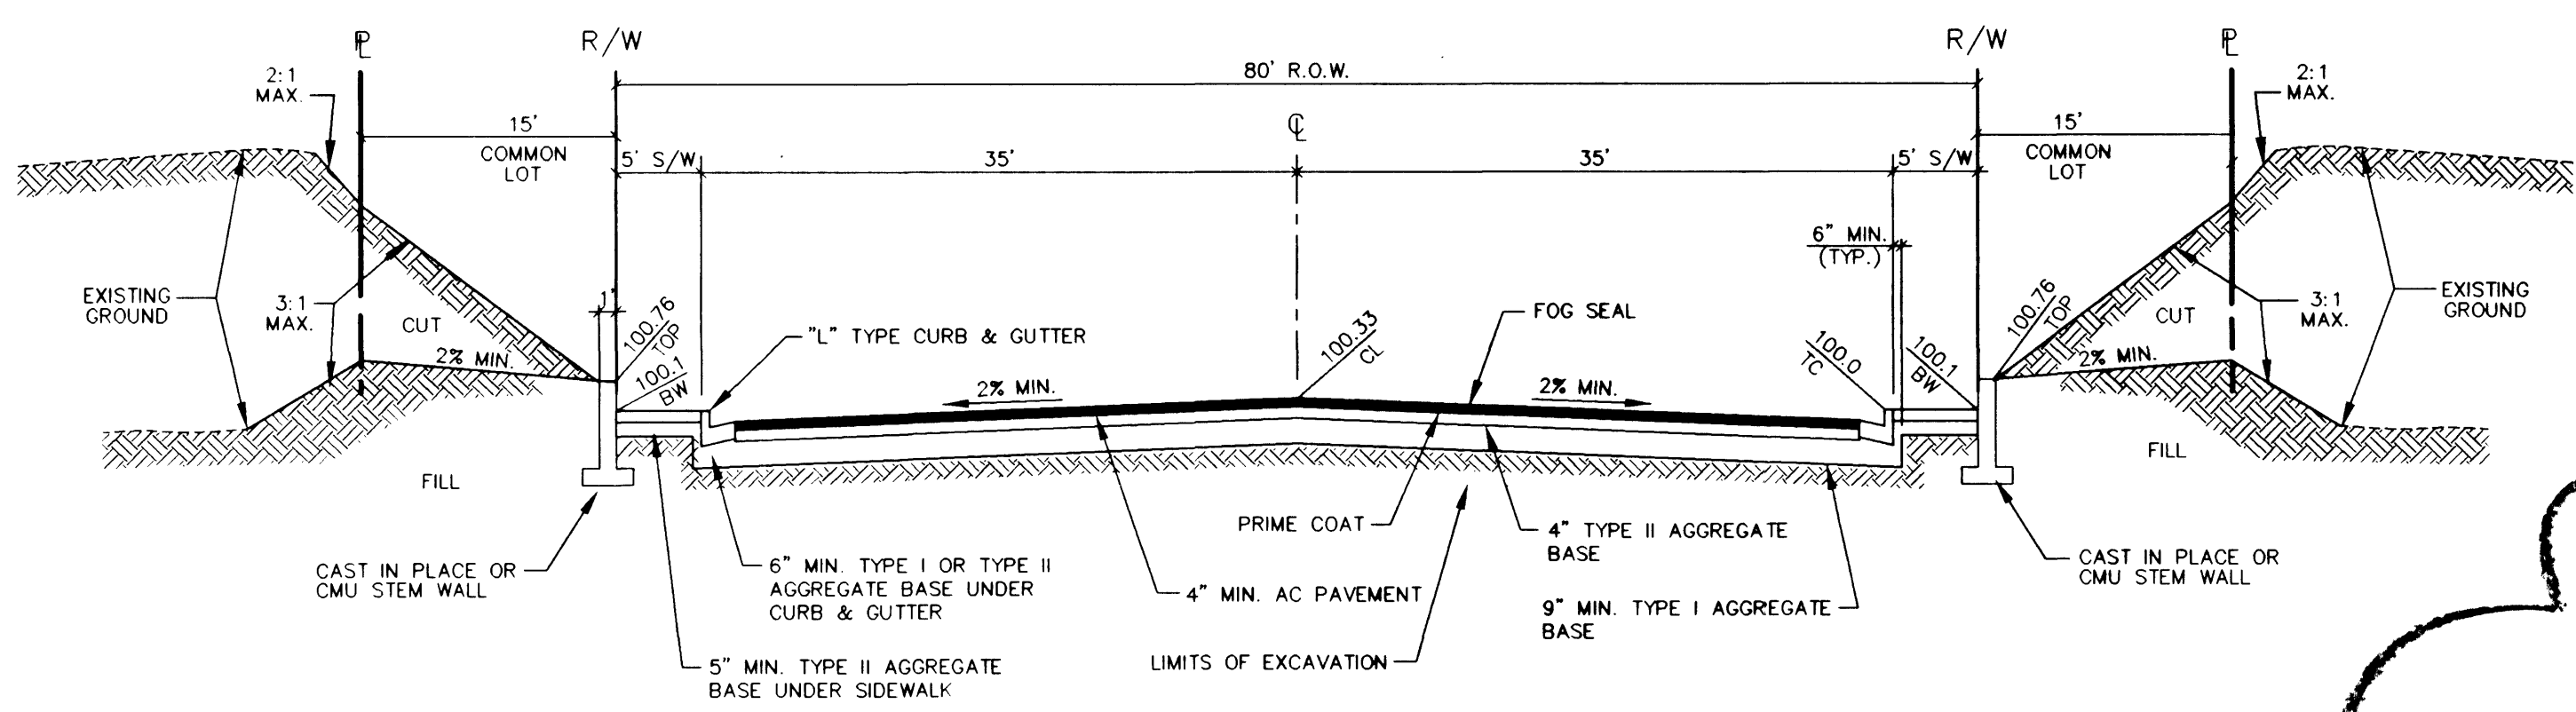


SUNNY SPRINGS LANE
STA. 41+86.00 TO STA. 66+46.85

1" = 10' HORIZ.
1" = 5' VERT.

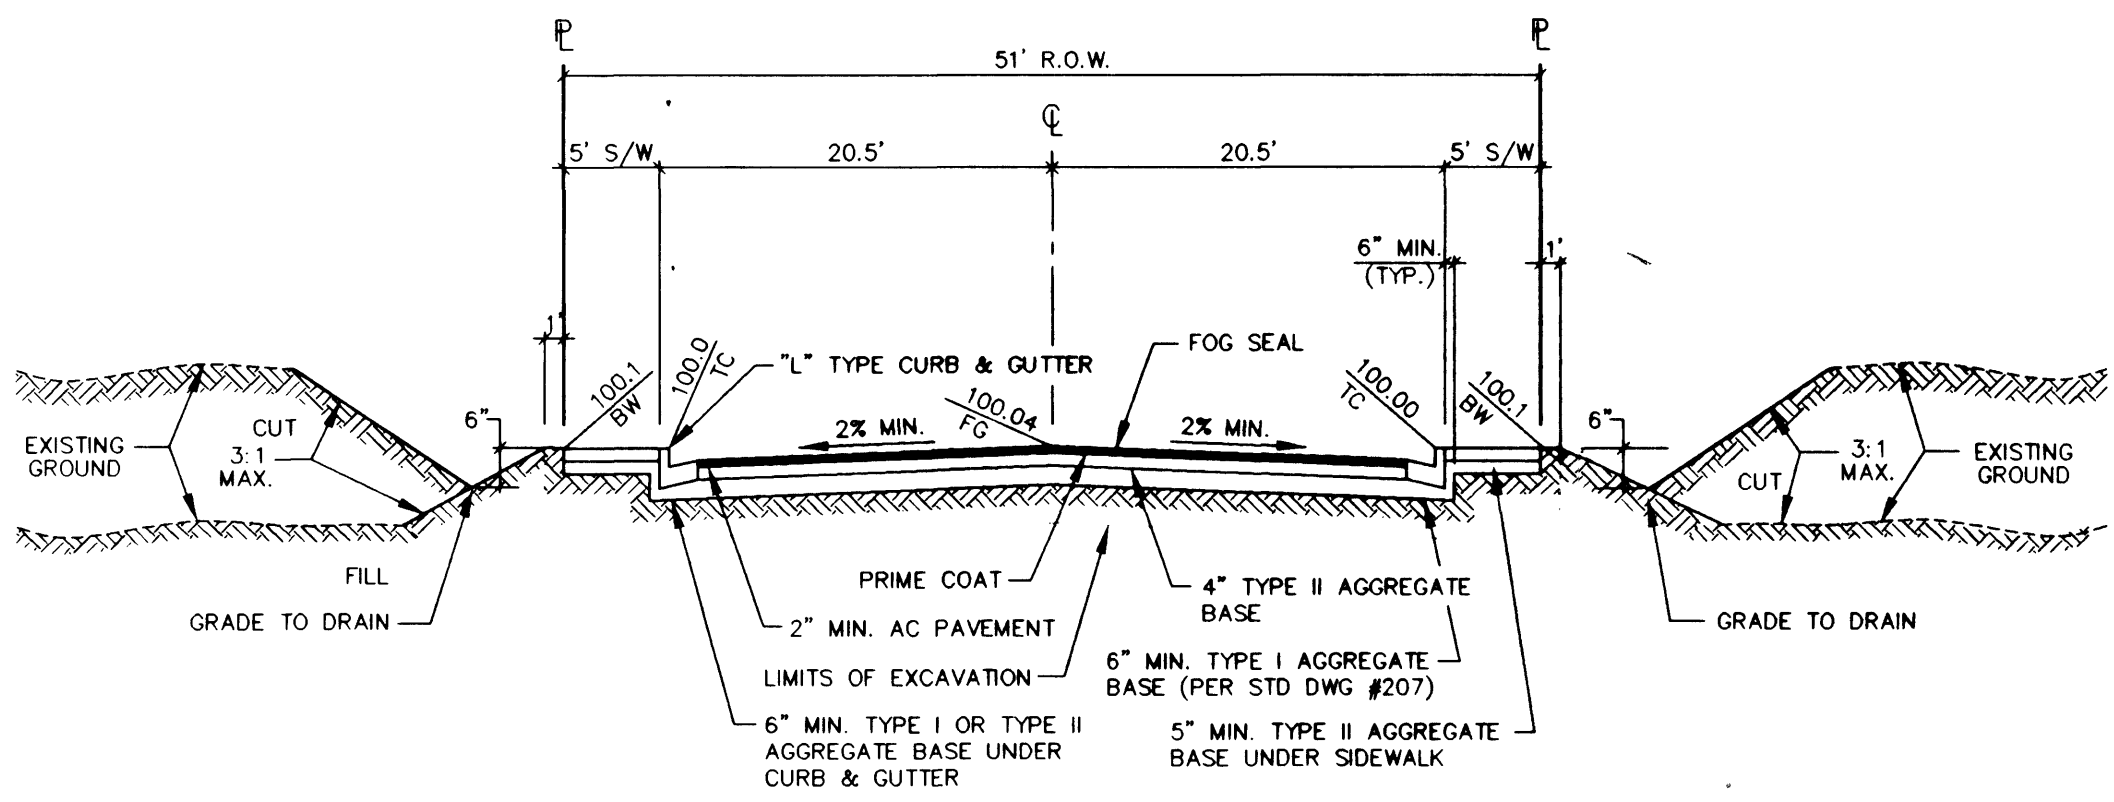


EAGLE TALON WAY
STA. 19+53.35 TO STA. 28+51.12

1" = 10' HORIZ.
1" = 5' VERT.

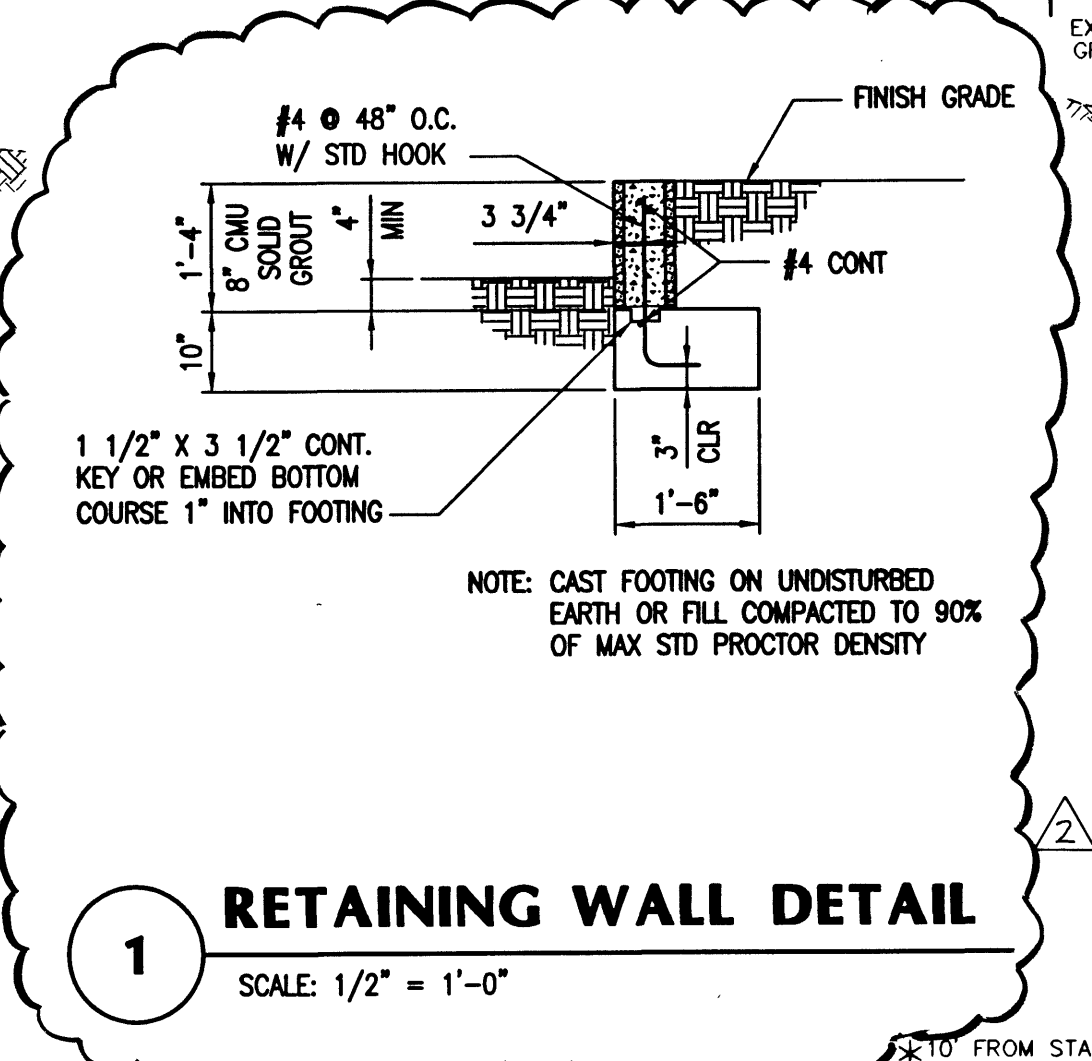


RETAINING WALL DETAIL

SCALE: 1/2" = 1'-0"

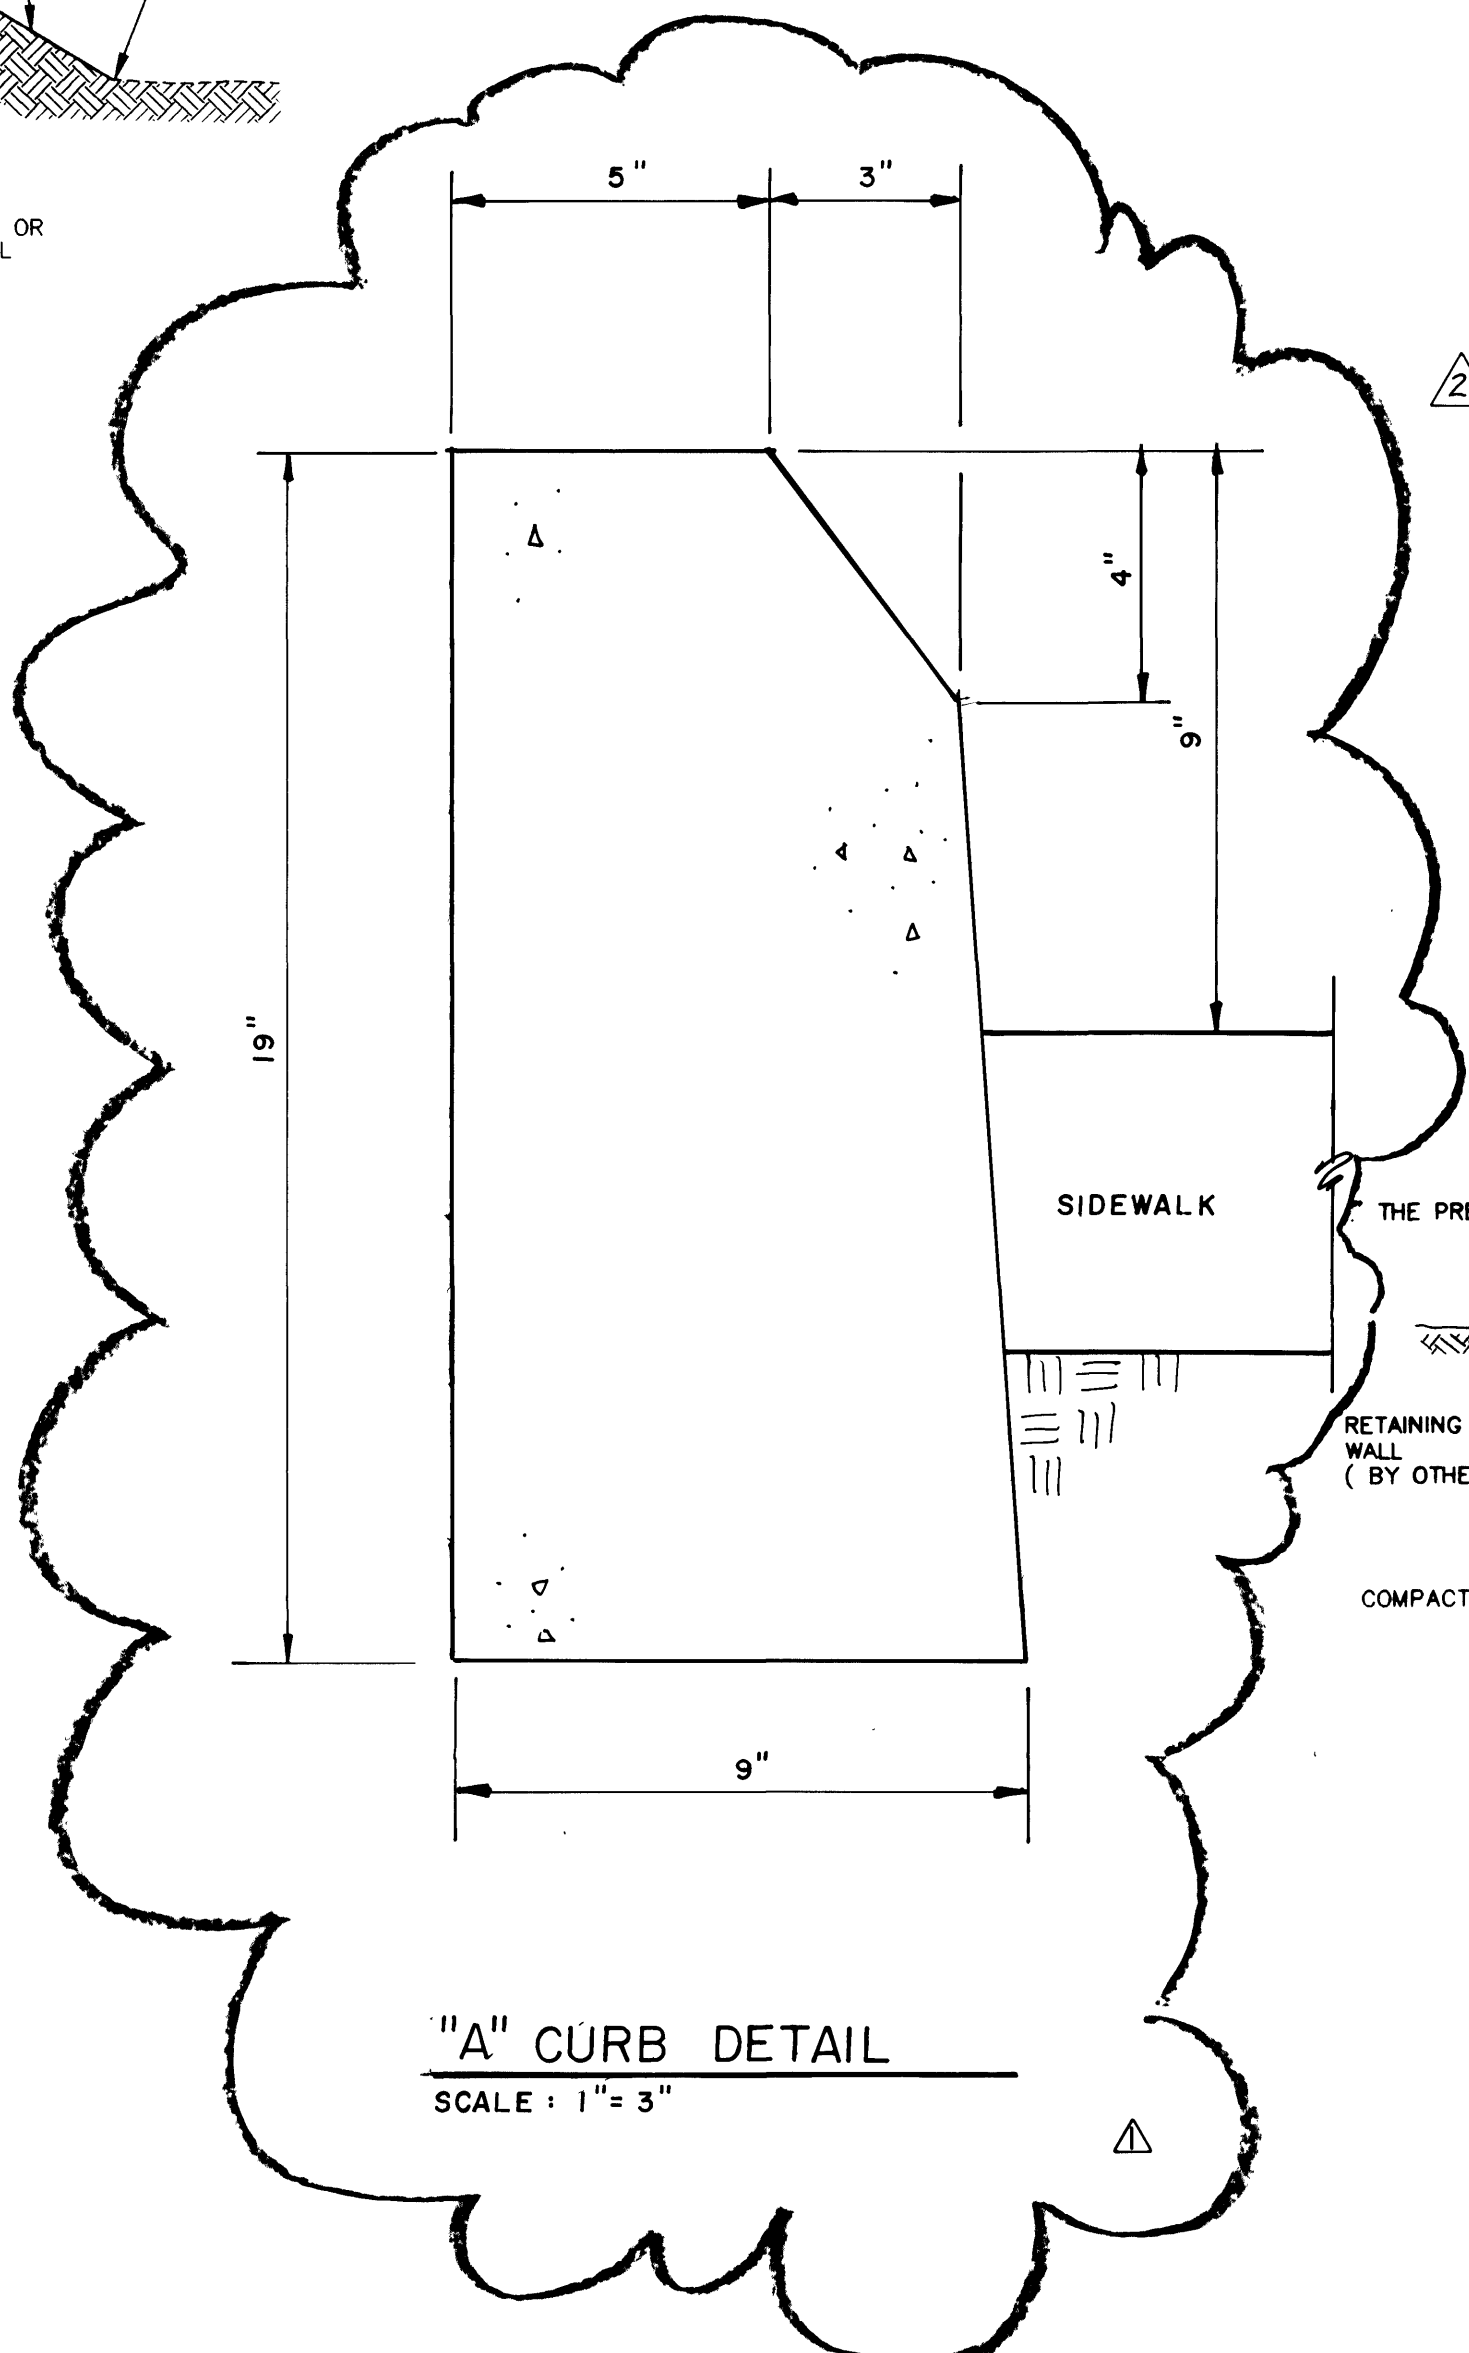


"A" CURB DETAIL

SCALE: 1" = 3"

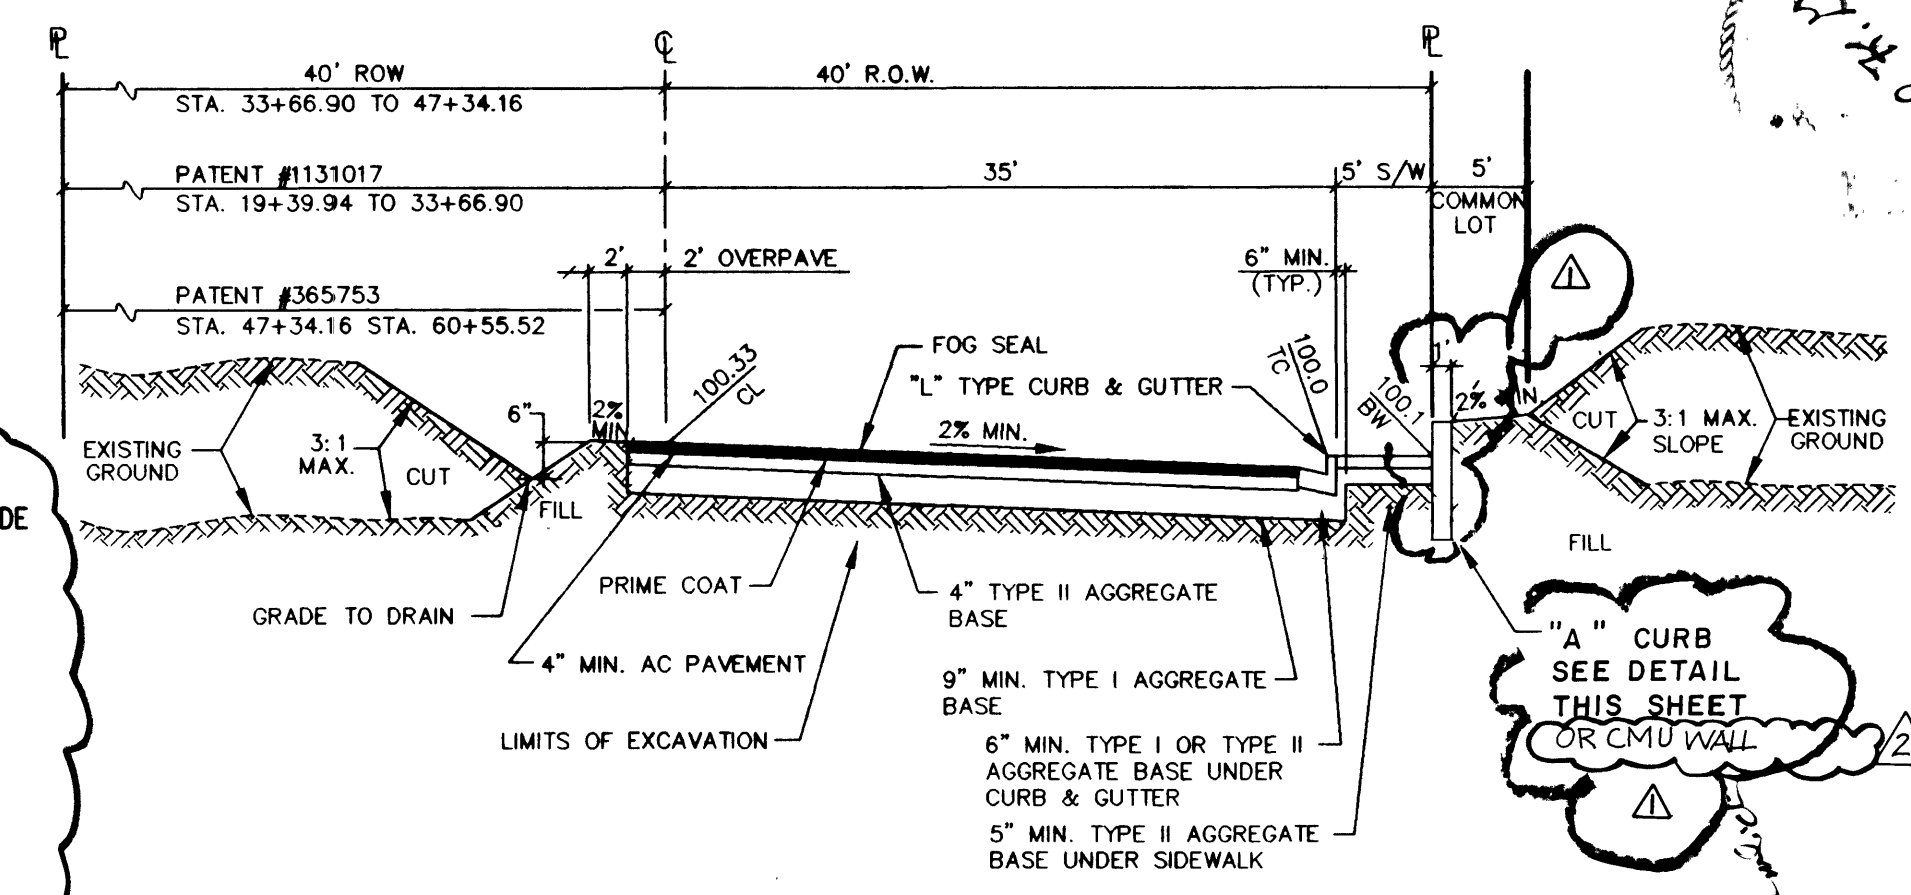


FARM ROAD
STA. 19+39.94 TO STA. 60+55.52

1" = 10' HORIZ.
1" = 5' VERT.

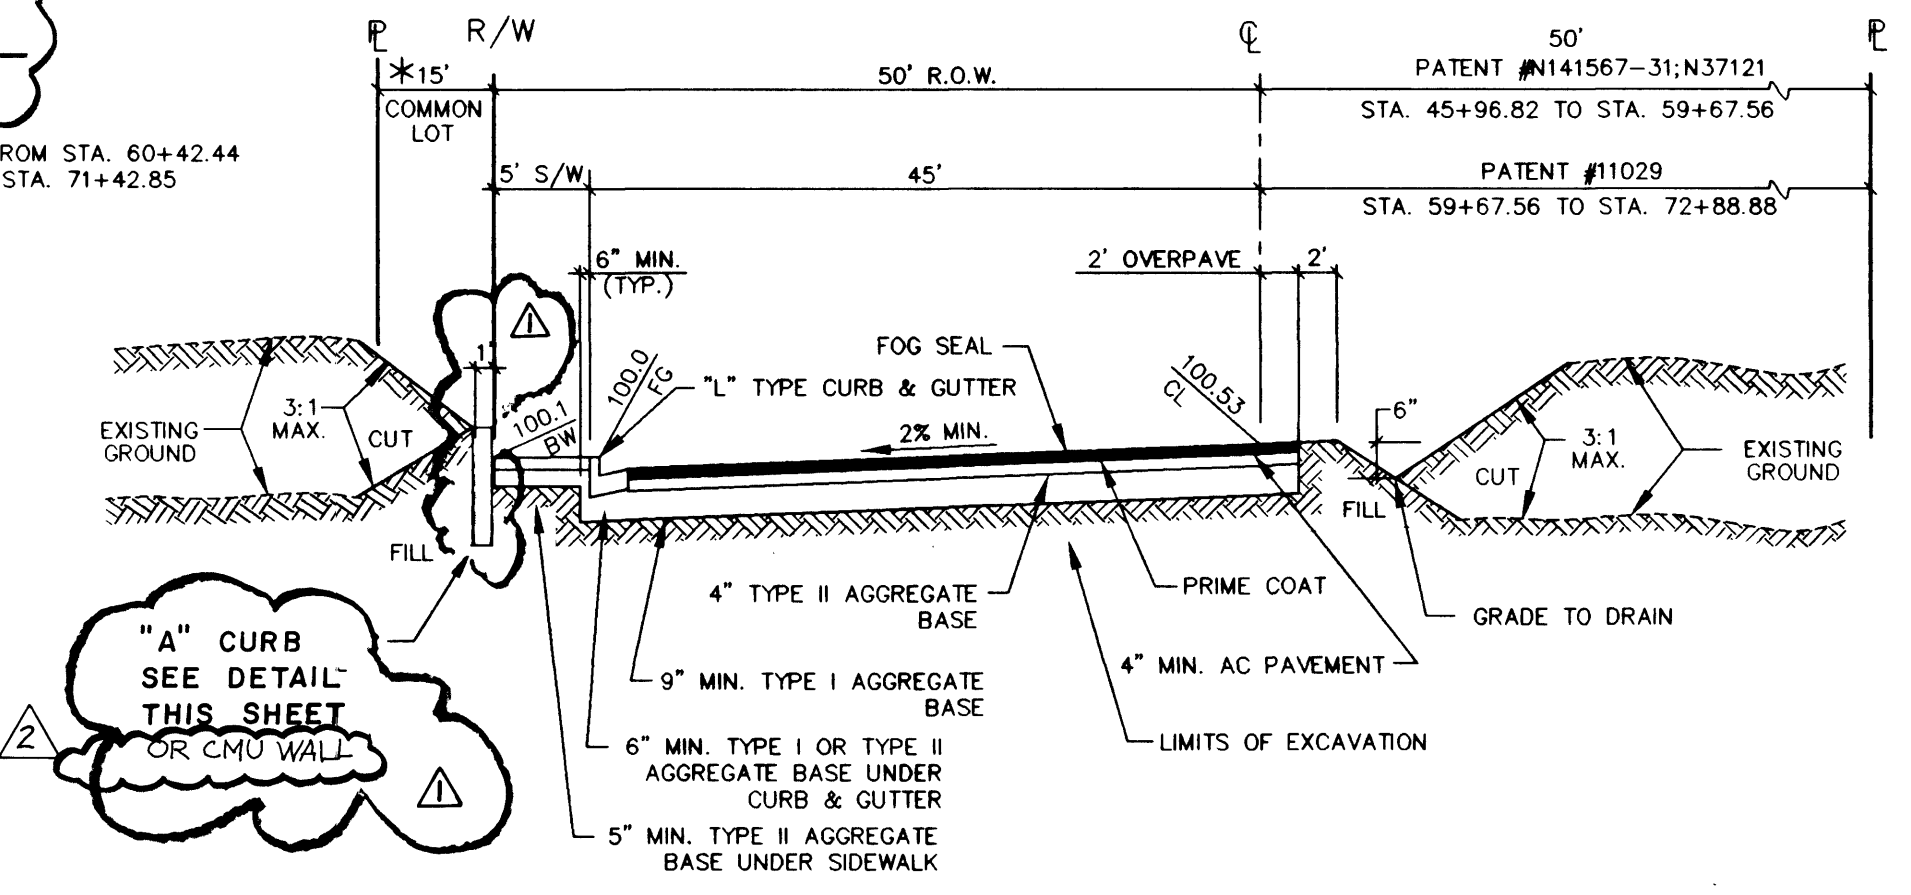

ELKHORN ROAD
STA. 45+96.82 TO STA. 73+92.51

1" = 10' HORIZ.
1" = 5' VERT.

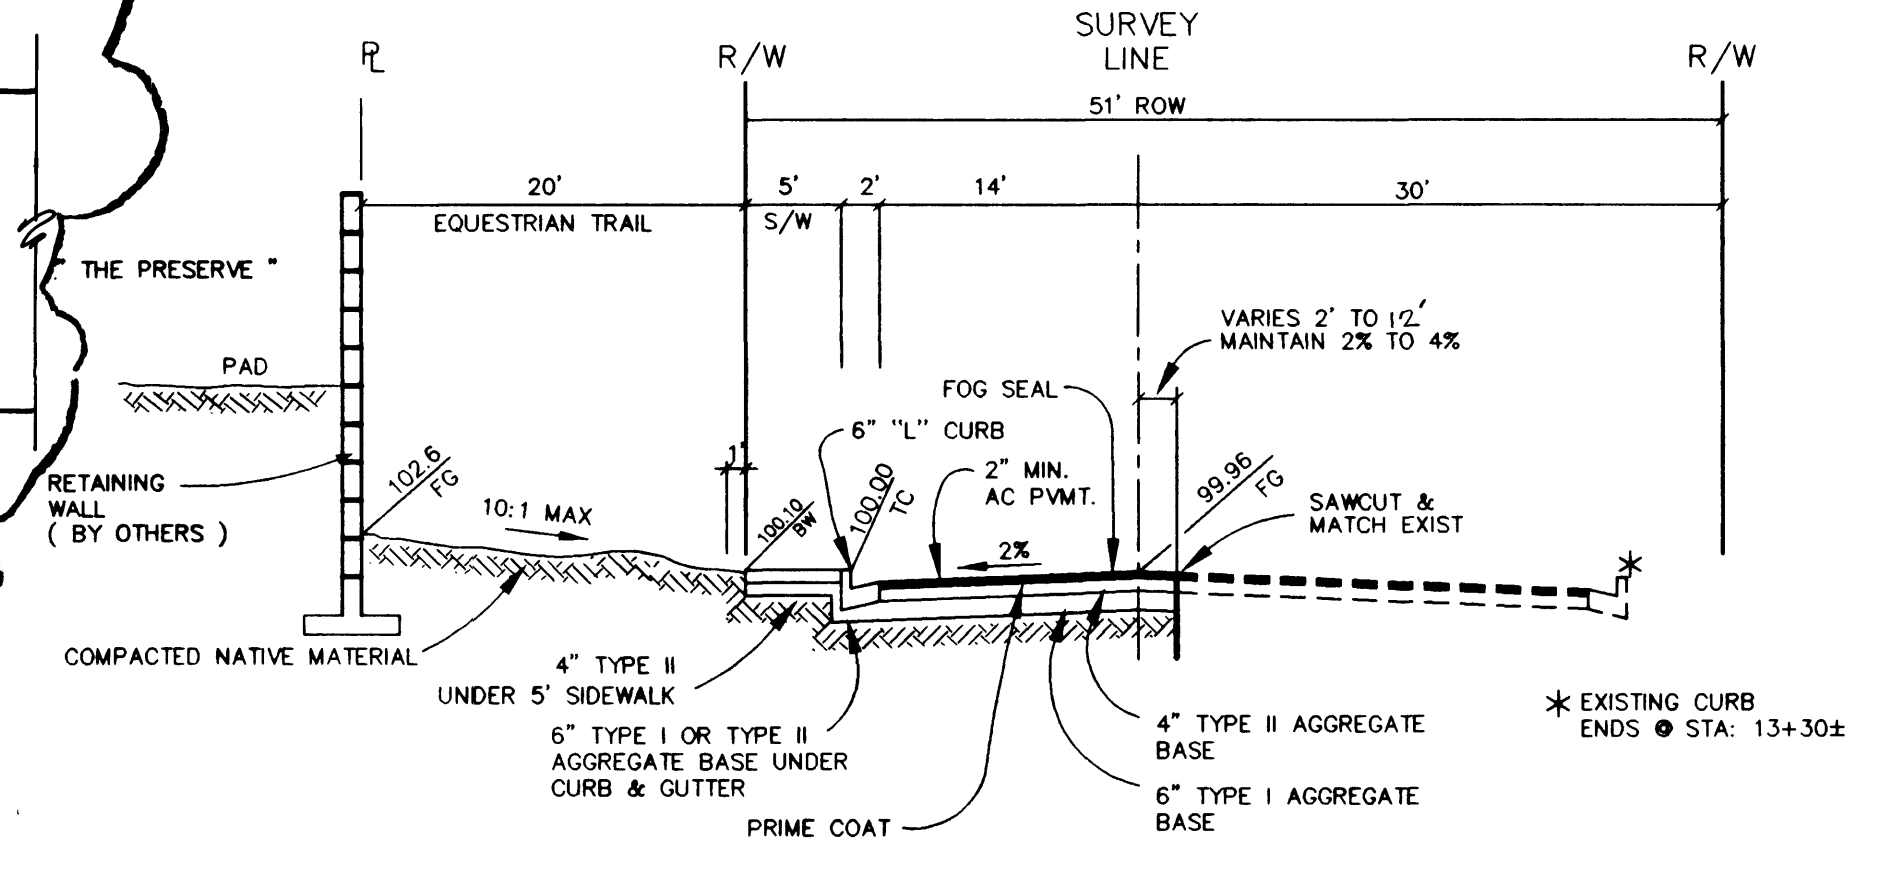

PIONEER WAY
STA. 10+73.45 TO STA. 22+38.33

1" = 10' HORIZ.
1" = 5' VERT.

BENCHMARK

PROJECT DATUM=NGVD29
NO.14, STATION 1LV9021N6 3" BRASS CAP USC & GS BM
#113 3/4 MILE NORTH OF 1LV9028NNE6, 50' (FT.) EAST
OF OLD RAILROAD BED
ELEVATION = 2452.515

EQUATION ELEVATION = 2452.515 + 2.401' = 2454.916
(TO NAVD88) (747.5266m + 0.7318m = 748.2584m)

APPROVED FOR CONSTRUCTION
DATE 5/12/96
LWWB

NOTICE TO CONTRACTOR !
EXISTING UTILITY LOCATIONS SHOWN HEREON ARE APPROXIMATE ONLY. IT SHALL BE THE CONTRACTOR'S RESPONSIBILITY TO DETERMINE THE EXACT VERTICAL AND HORIZONTAL LOCATION OF ALL EXISTING UNDERGROUND UTILITIES PRIOR TO COMMENCING CONSTRUCTION. NO REPRESENTATION IS MADE THAT ALL EXISTING UTILITIES ARE SHOWN HEREON. THE ENGINEER ASSUMES NO RESPONSIBILITY FOR UTILITIES NOT SHOWN OR UTILITIES NOT SHOWN IN THEIR PROPER LOCATION.

AVOID CUTTING UNDERGROUND UTILITIES. IT'S COSTLY.
CALL before you Dig
1-800-227-2600
UNDERGROUND SERVICE (USA)

REVISION DESCRIPTION	NO.	DATE	BY	APPROVED
STEM WALL CHANGED TO 1/4" A" CURB (ALTERNATE ADDED)	1	4/10/02	RG	
	2	4/30/02	RG	

For Review Only

PROFESSIONAL ENGINEER
MARK E. JONES
CIVIL
STATE OF NEVADA
EXPIRATION DATE 12/31/06
STAMP DATE 4/30/02

SOUTHWEST ENGINEERING
LAND PLANNING • MAPING • DEVELOPMENT
5425 W. VEGAS DRIVE
LAS VEGAS, NEVADA 89108
(702) 448-9700

STREET SECTIONS

ELKHORN SPRINGS PHASE II

TITLE PROJECT

WORK ORDER NO. 950925

DESIGN BY: MJ & EV

DATE: 1/4/96

SCALE: AS NOTED

CADRE: ELKDETLS.DWG

SHEET 2 OF 21 SHEETS