


EASTERN AVE.

49+00 W.V., 27.5' LT., T&A.

49+01 N.V., 26.7' LT., T&A.
 49+19.7 W.V., 31.7' LT., T&A.
 49+21.4 W.V., 25.3' LT., T&A.

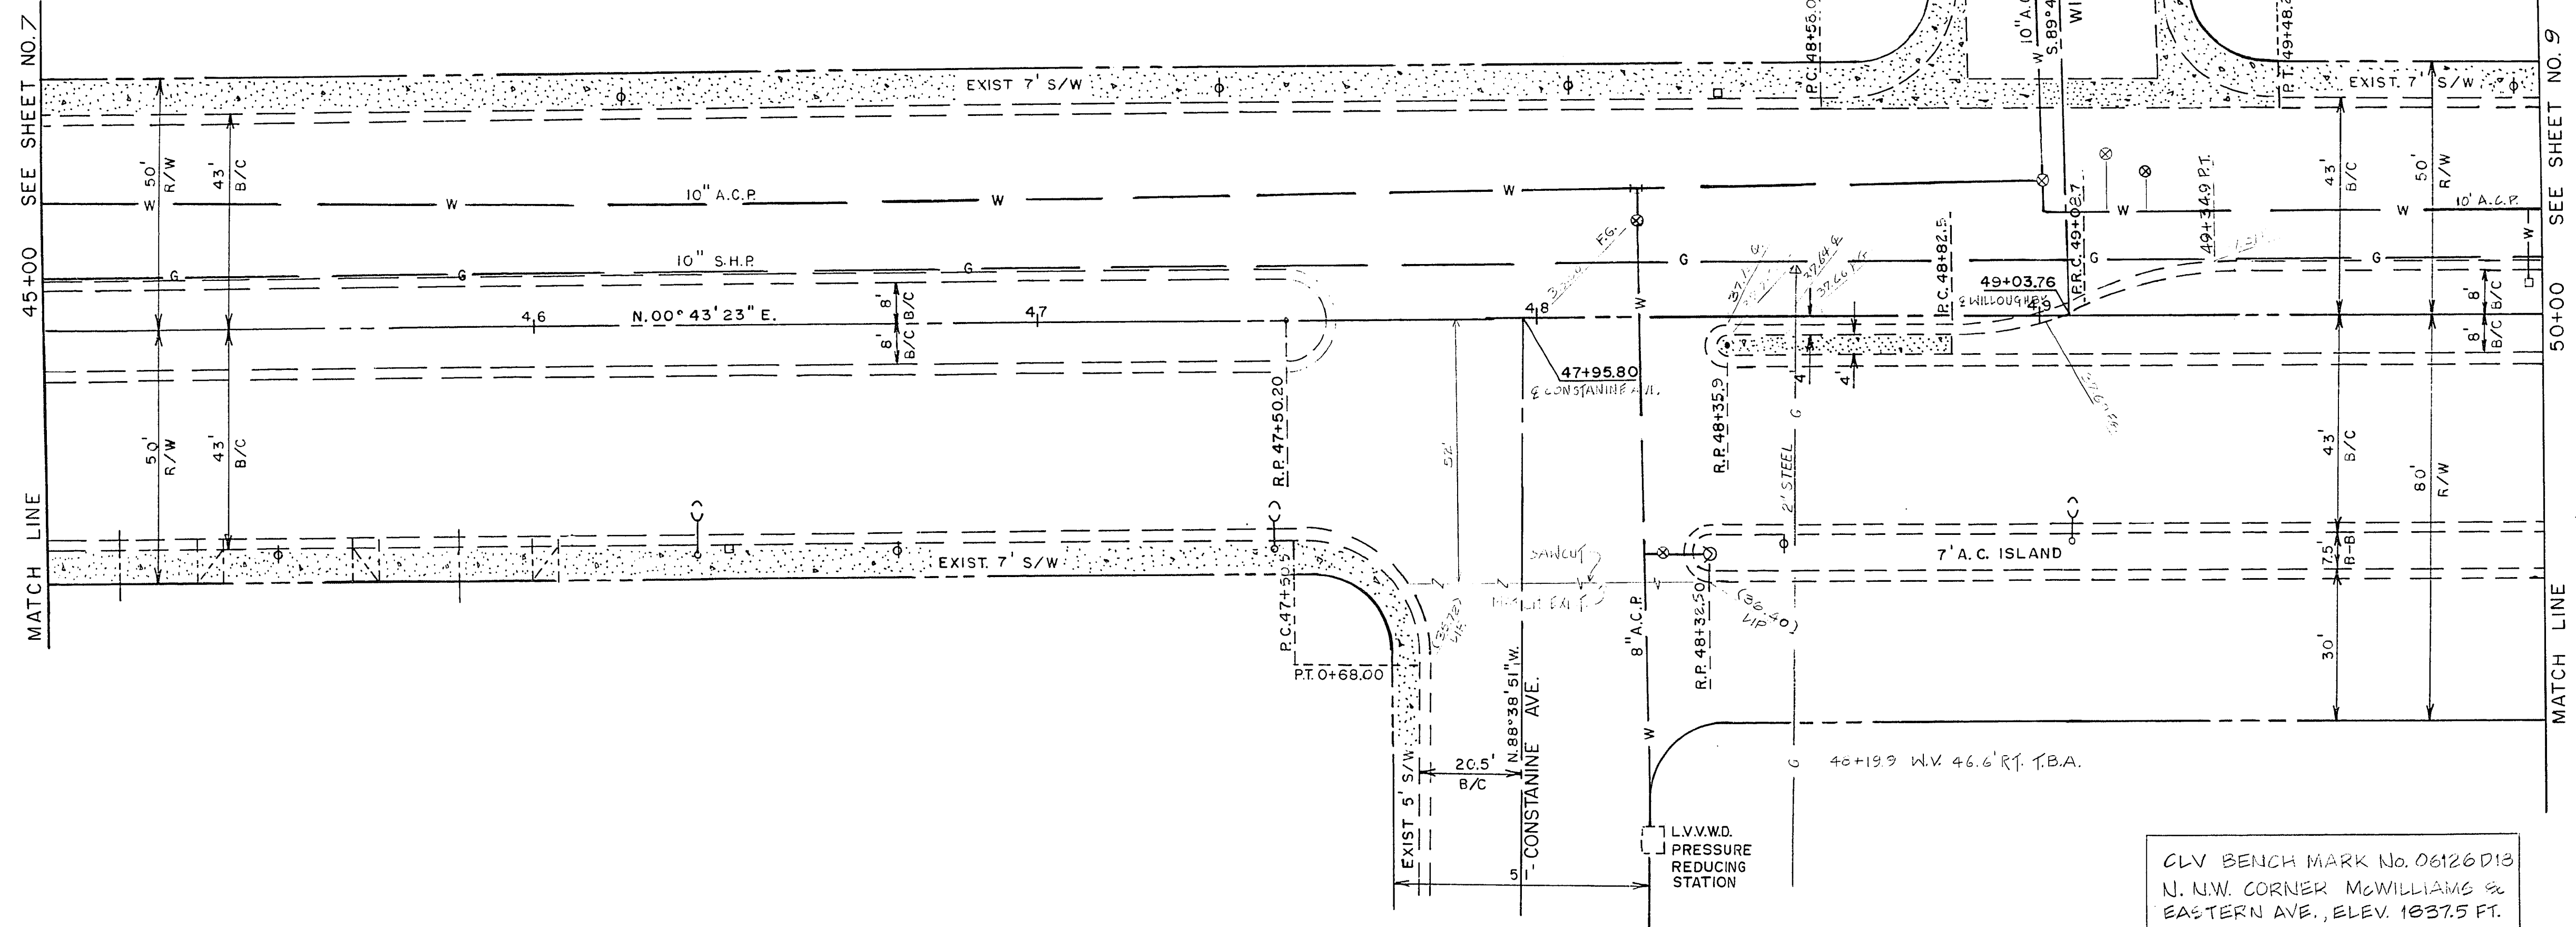

GLV BENCH MARK No. 06126D13
 N. W. CORNER McWILLIAMS &
 EASTERN AVE., ELEV. 1837.5 FT.

1838	37.55 F.G. (37.18) E.	37.58 F.G. (37.35) E.	37.72 F.G. (37.55) E.	37.96 F.G. (37.75) E.	37.97 F.G. (37.70) E.	38.62 F.G. (37.45) E.	37.44 F.G. (37.27) E.	37.32 F.G. (37.15) E.	37.03 F.G. (36.86) E.	36.79 F.G. (36.62) E.	1838
Department of Public Services Engineering Design Division

EASTERN AVE.
 BONANZA ROAD TO OWENS AVE.

PLAN & PROFILE

Scale (h) 1" = 20' Scale (v) 1" = 1'
 Fid. bk. no. 81-6x Date
 Design by C. KREHN/NOV M.A. Drawn by P.S. / N. GOMEZ, J.J.E.

W.U. 2134

Revisions

Date

107-V1211 8/28

19.4.171