

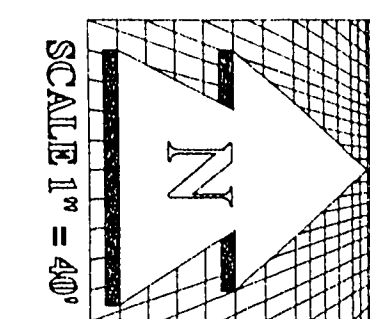


BRIGHT SUN LANE
(PRIVATE)

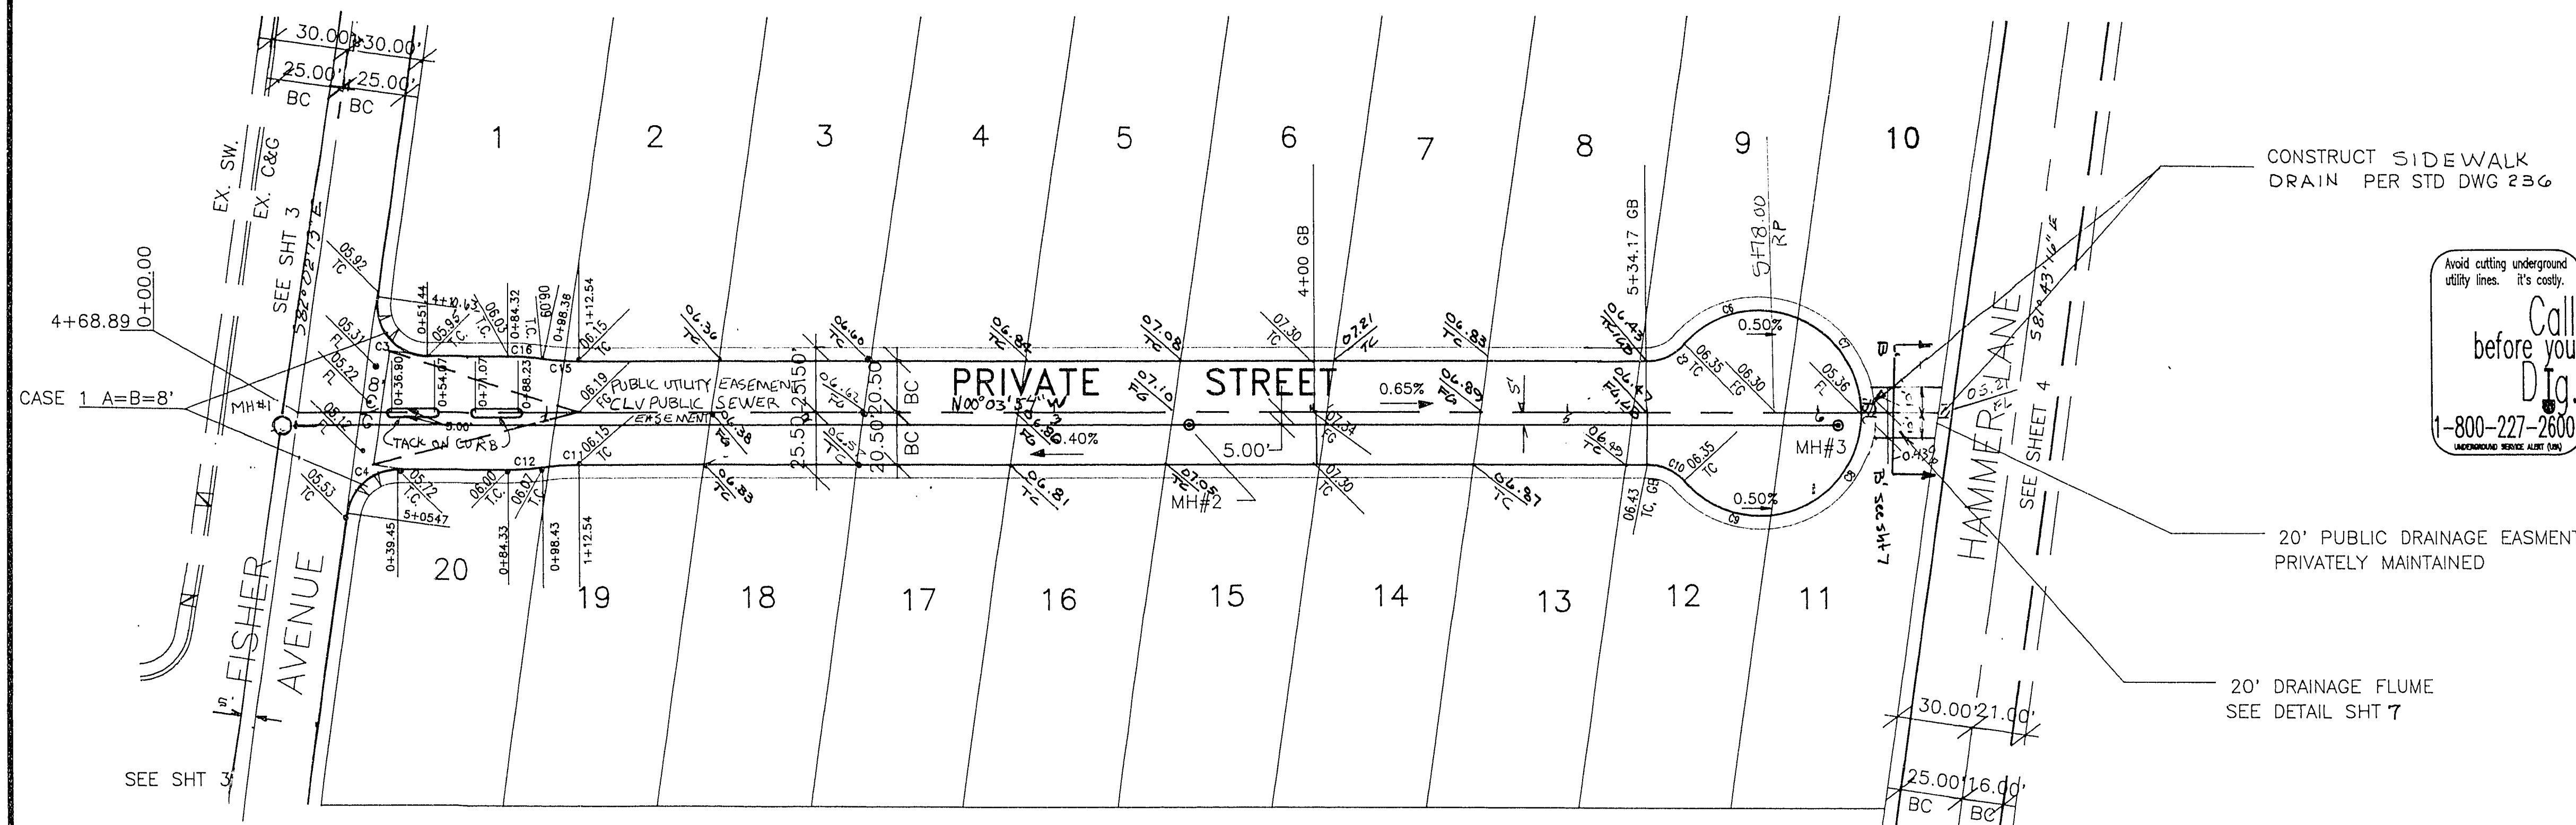



DESIGN WTC
C - 0.04=WTC
WTC = ETC

SCALES:
1" = 40' HOR
1" = 4' VERT

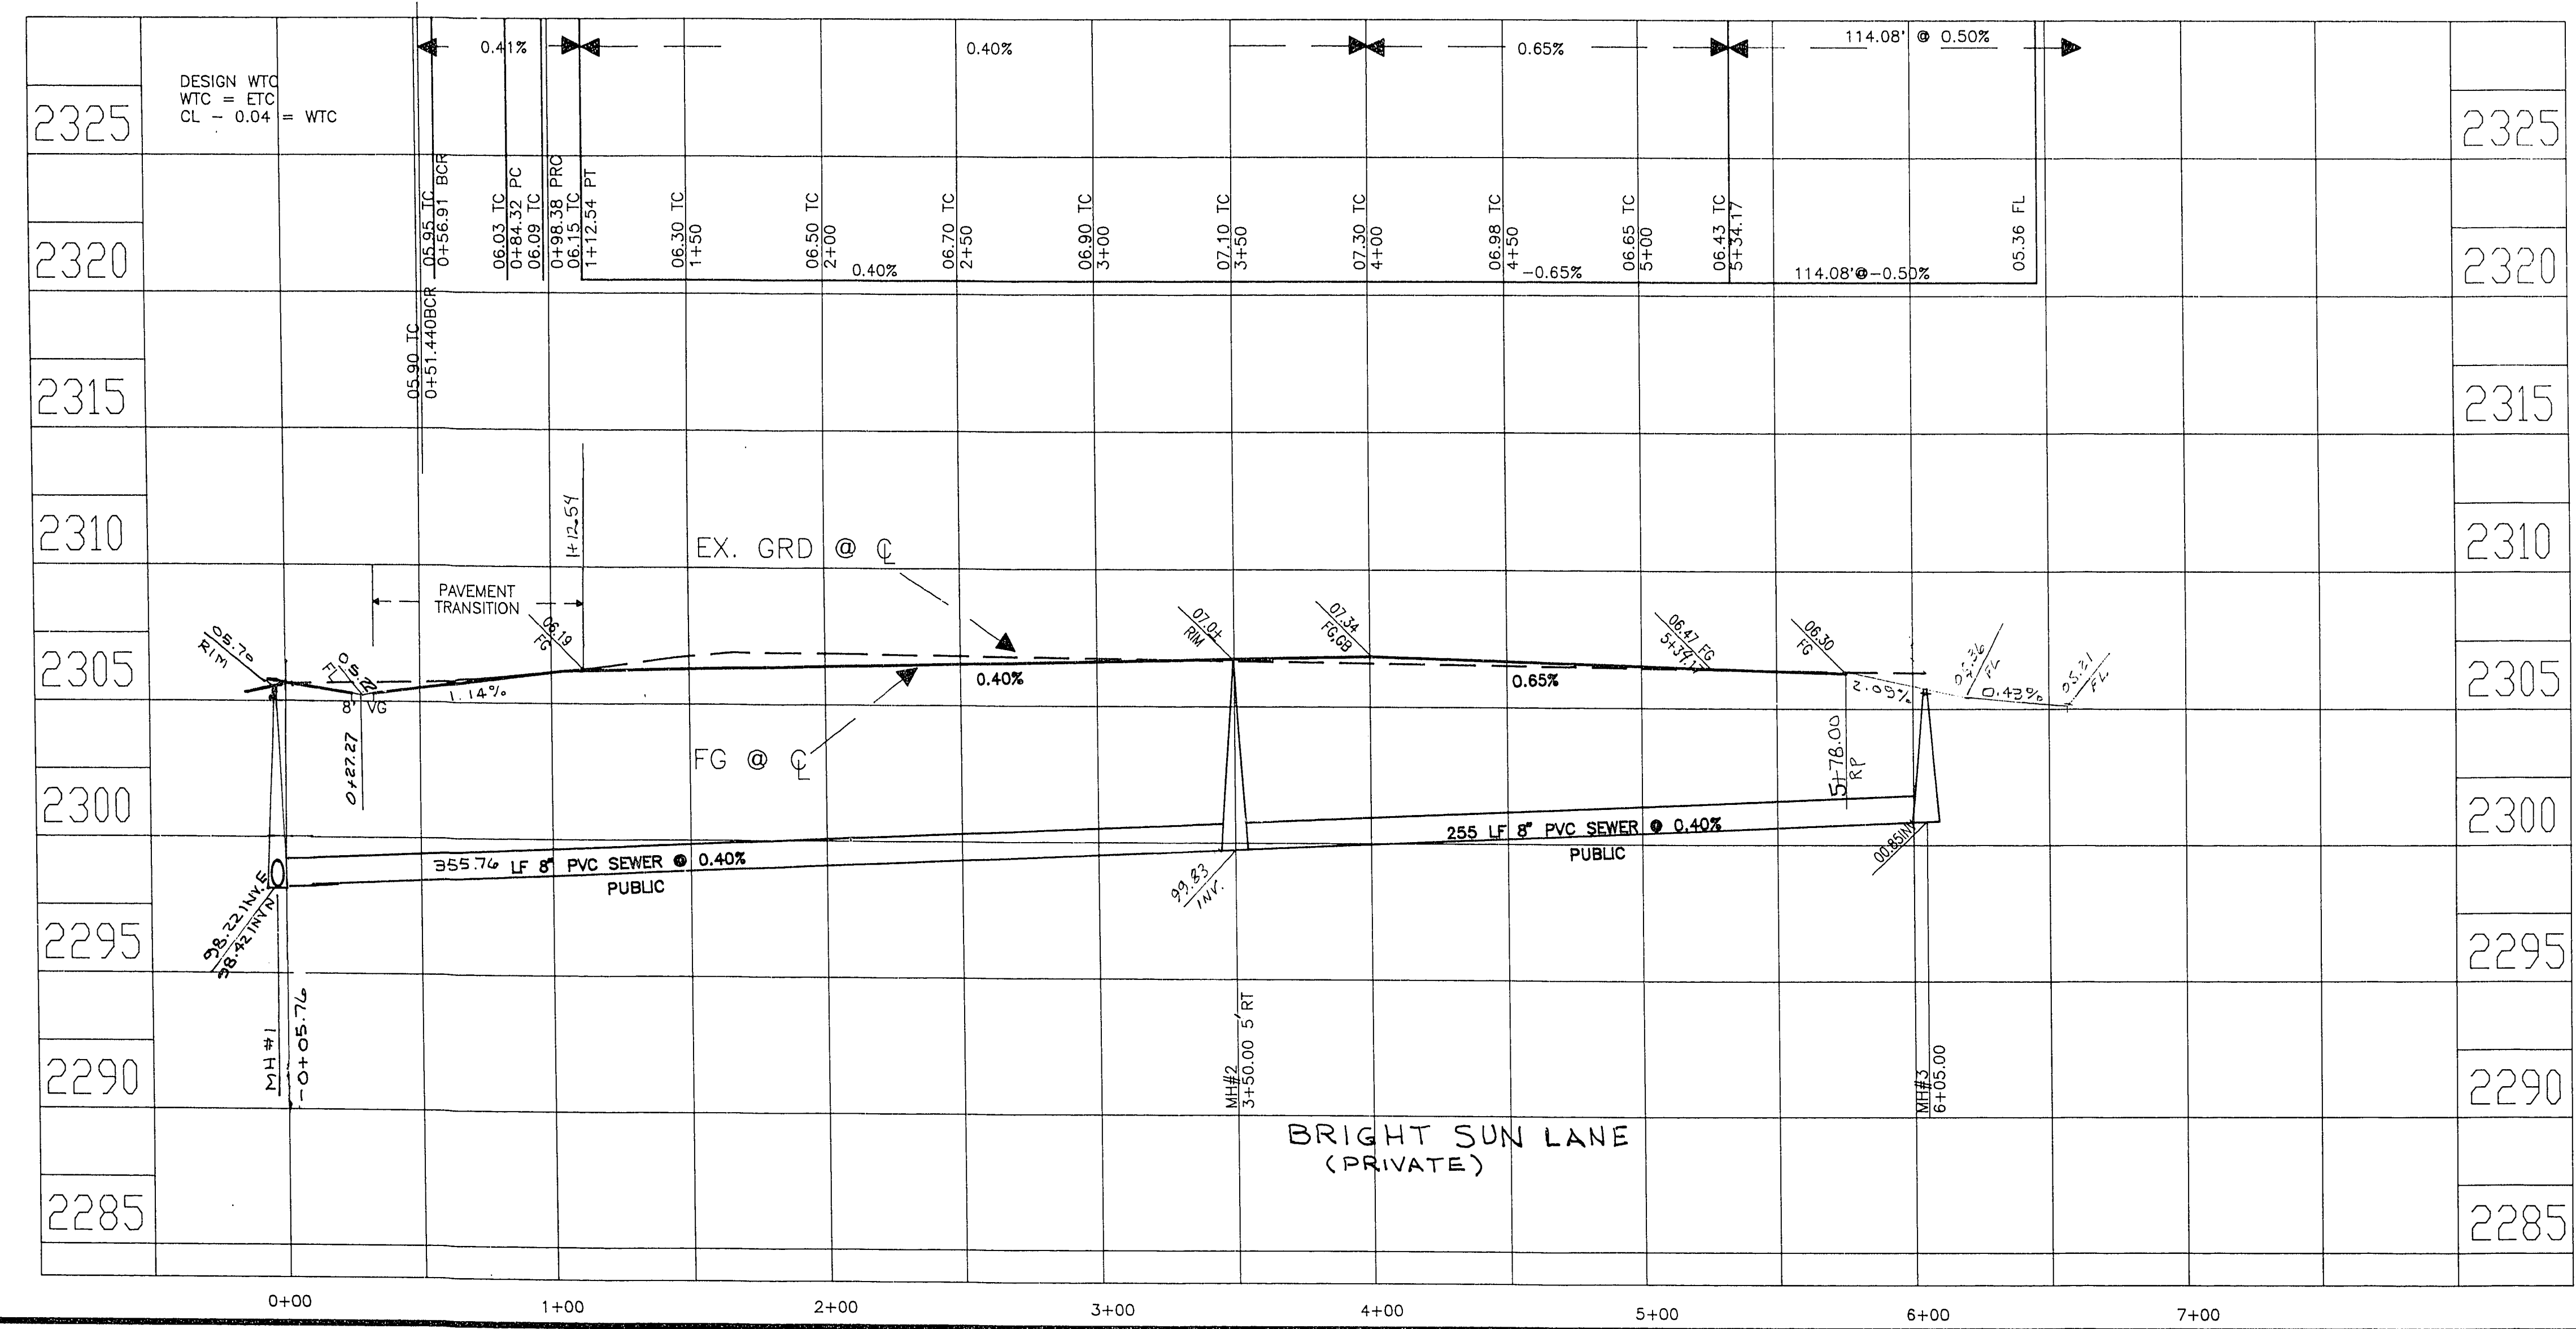

BCR CURVE DATA

CURVE	LENGTH	DELTA	RADIUS	TANGENT
C3	34.22'	98°01'41"	20.00'	23.02'
C4	28.61'	81°58'19"	20.00'	17.38'
C5	16.40'	48°11'23"	19.50'	8.72'
C6	50.07'	70°49'43"	40.50'	28.80'
C7	47.61'	67°21'40"	40.50'	26.99'
C8	59.41'	84°02'57"	40.50'	36.50'
C9	38.27'	54°08'26"	40.50'	20.70'
C10	16.40'	48°11'23"	19.50'	8.72'
C11	14.15'	08°06'35"	100.00'	7.09'
C12	14.15'	08°06'35"	100.00'	7.09'
C13	14.15'	08°06'35"	100.00'	7.09'
C14	10.73'	06°08'55"	100.00'	5.37'
C15	14.15'	08°06'35"	100.00'	7.09'
C16	14.15'	08°06'35"	100.00'	7.09'
C17	10.27'	05°53'00"	100.00'	5.14'

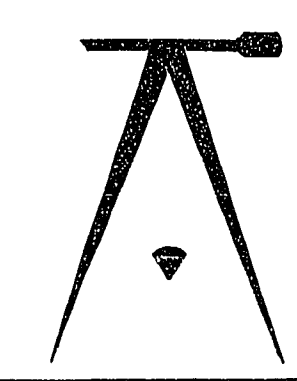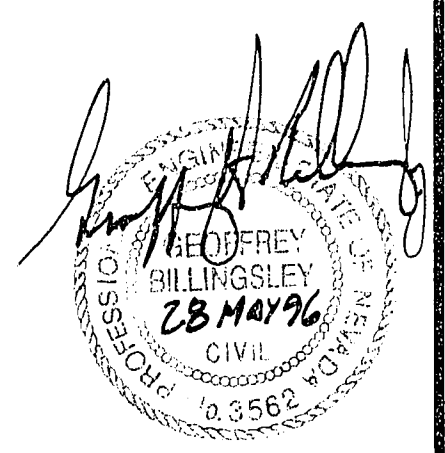

JT STOVALL AND ASSOC.
LAND SURVEYING
2912 LEO STREET
KINGMAN, ARIZONA
86401
520-718-0057

REV	DATE	BY	REVISION	APPROVAL

AZIMUTH
ENGINEERING & SURVEYING INC.
300 W. BASIN ROAD
SUITE 100
LAS VEGAS, NV 89105
(702) 556-6766

DESERT SOL
PLAN AND PROFILE

JOB NO. 95-028
DESIGNED: G.H.B.
DRAWN:
CHECKED:

SHEET
5
OF 7 SHEETS

11-29-79

1074-4456