
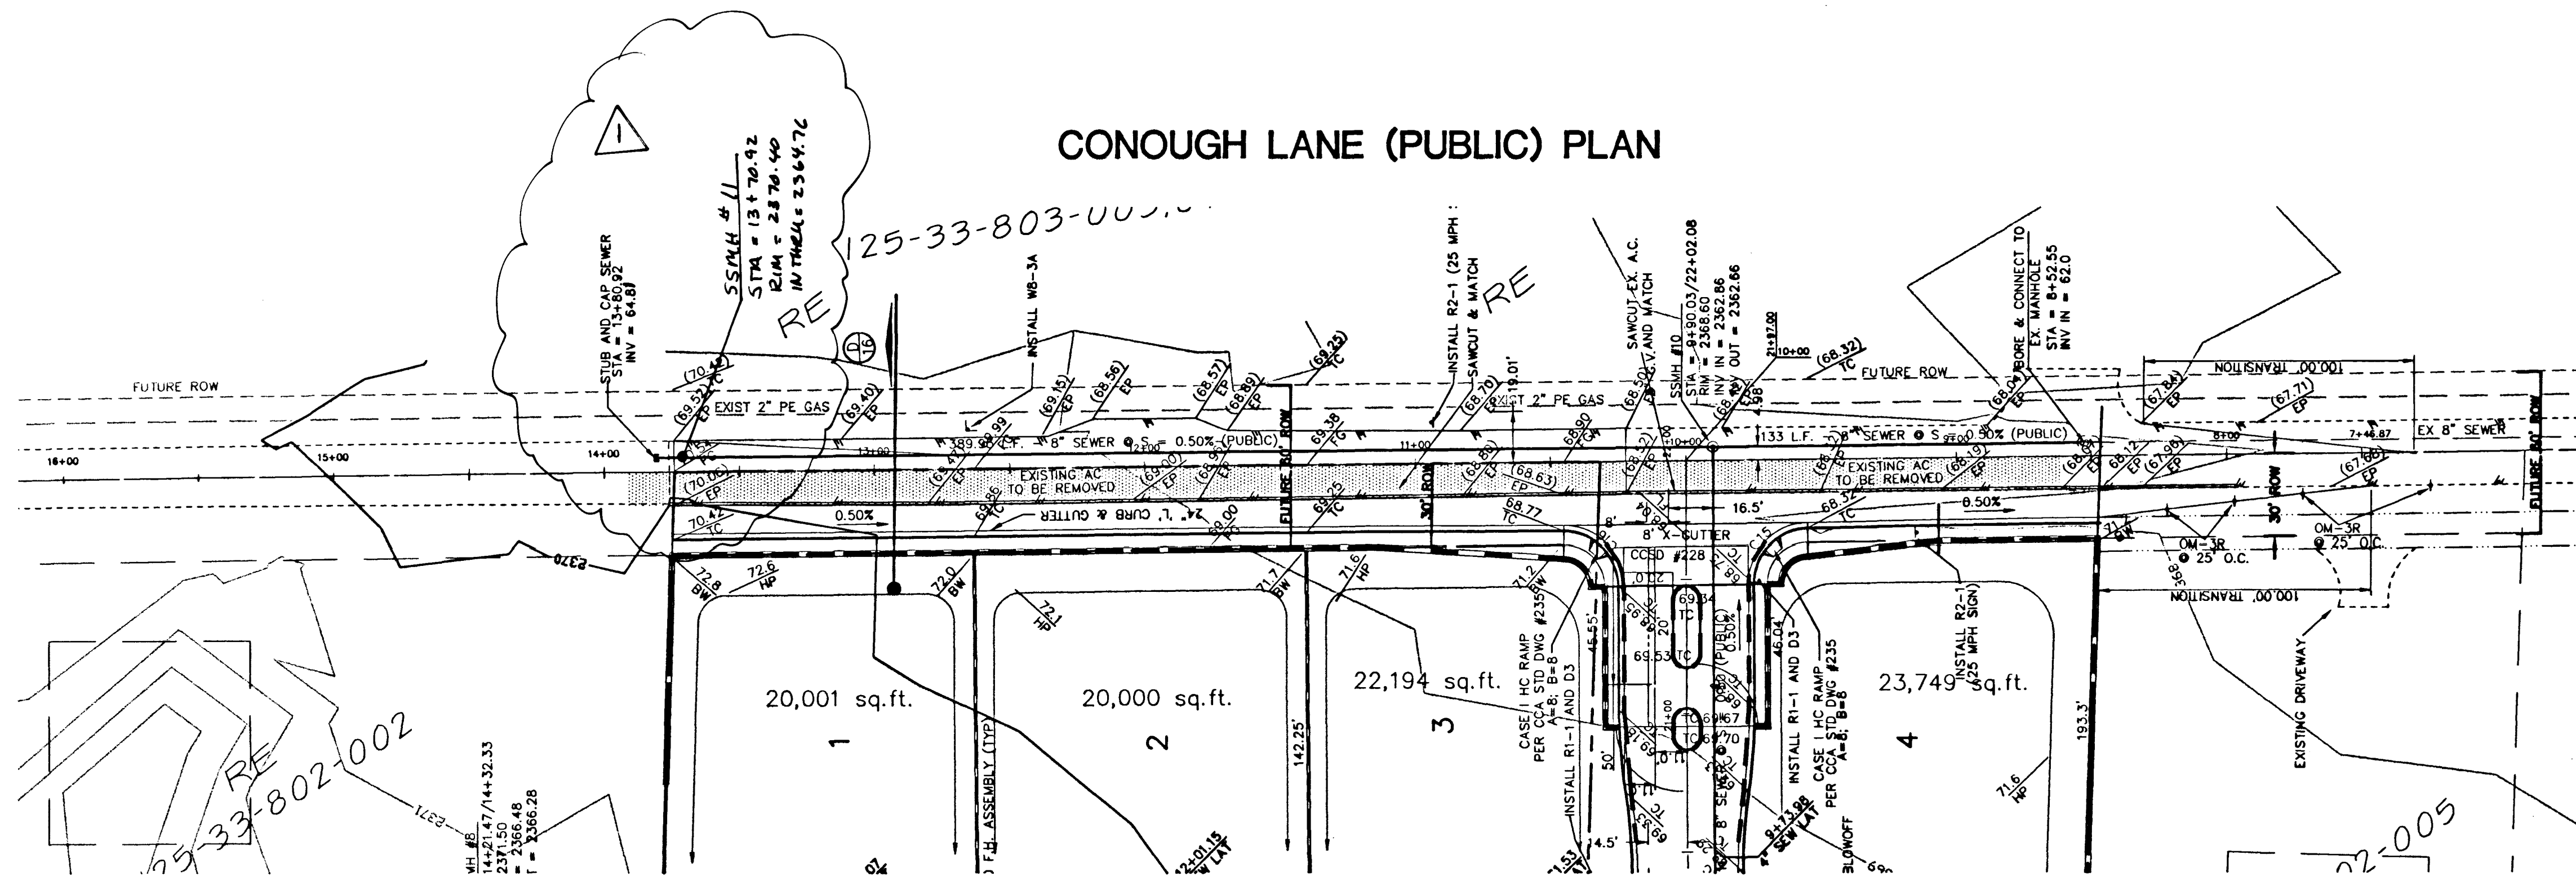


PUBLIC PAVING AND GRADING QUANTITIES

2" TEMP AC PAVEMENT	70 SY
3" AC PAVEMENT	661 SY
TYPE II BASE	192 CY
CROSS GUTTER	584 SF
24" "L" TYPE CURB AND GUTTER	509 LF
SIDEWALK	274 SF
SIDEWALK RAMP	2 EA

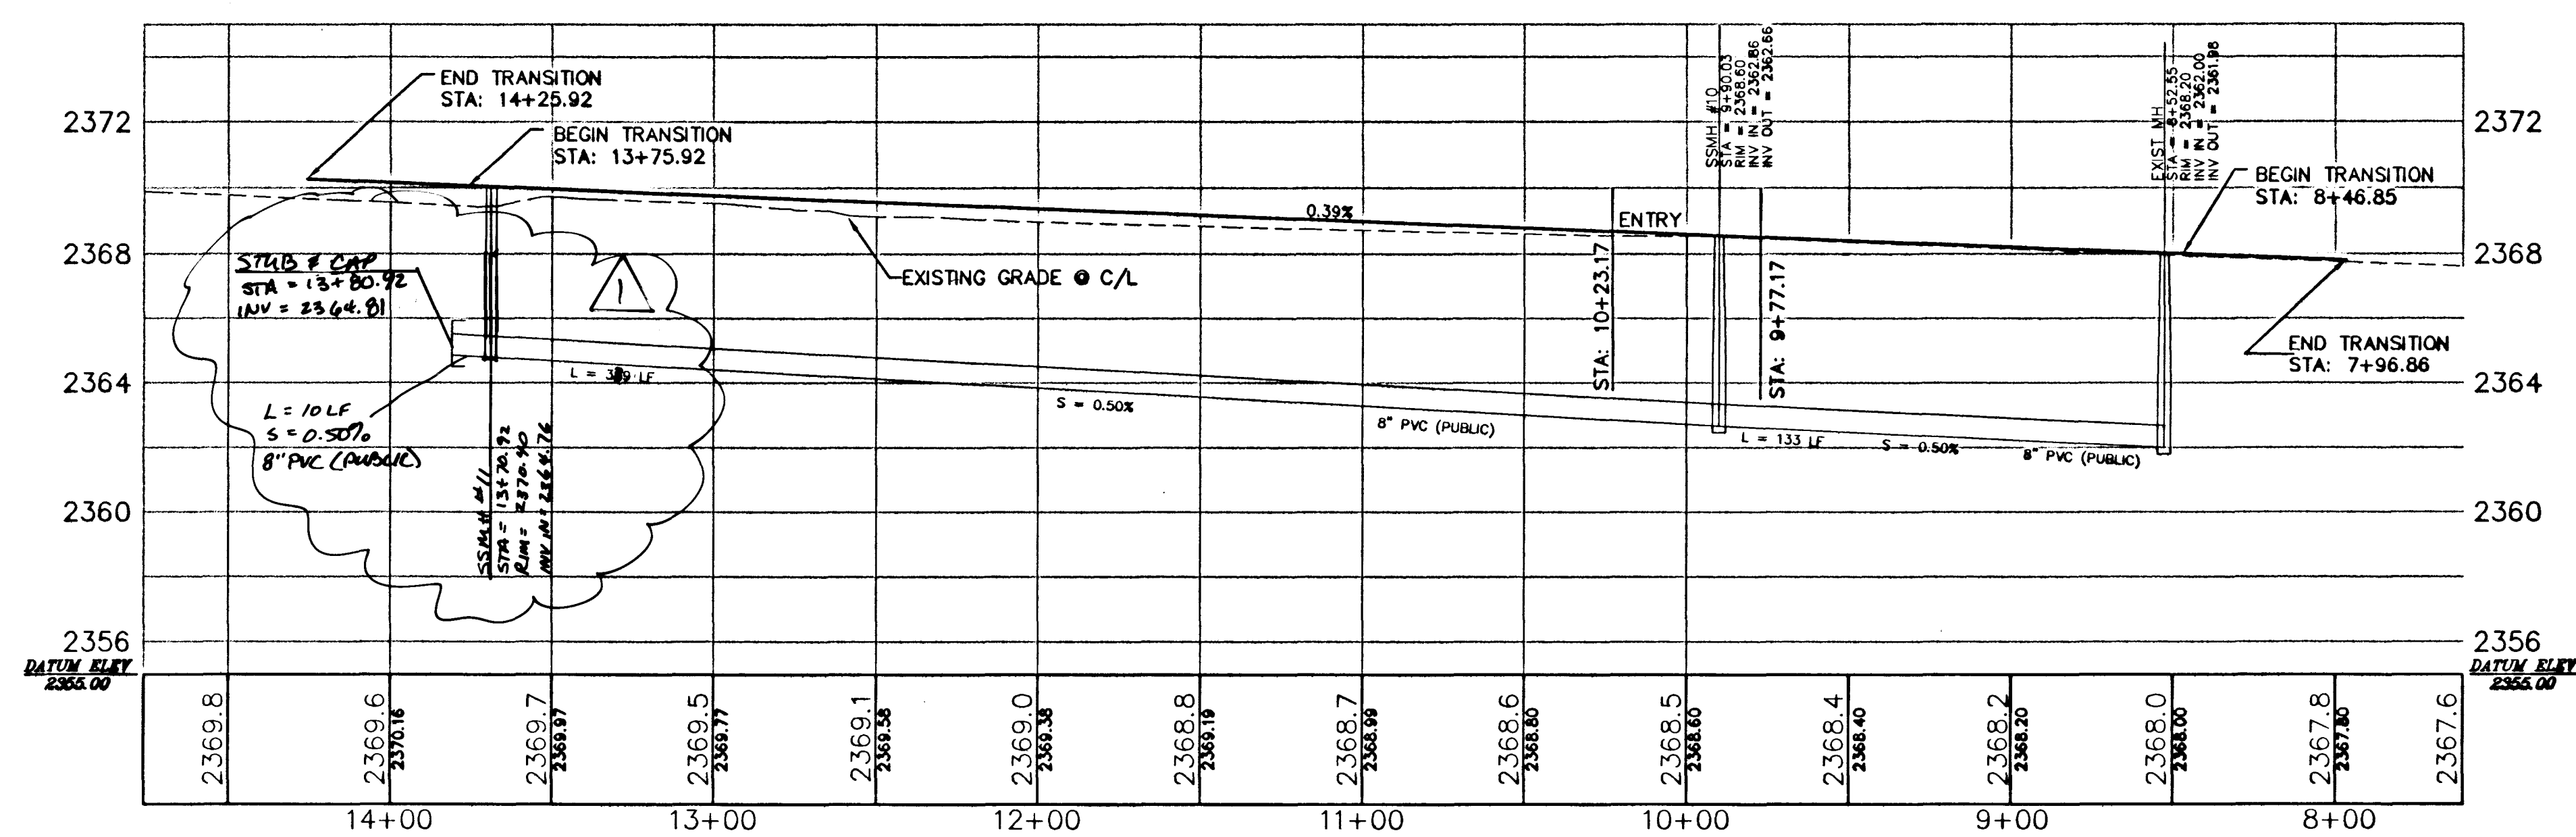

BASIS OF BEARING

THE BASIS OF BEARINGS FOR THIS SURVEY IS THE WEST LINE OF THE SOUTHEAST ONE-QUARTER OF SECTION 33, TOWNSHIP 19 SOUTH, RANGE 60 EAST, W.D.M. WHICH BEARS NORTH 00° 05' 41" EAST AS SHOWN IN THE OFFICE OF THE CLARK COUNTY, NEVADA RECORDER IN FILE 4 OF PARCEL MAPS ON PAGE 28.

BENCHMARK

CITY OF LAS VEGAS BENCHMARK #1LV9033E6, RIVET & PLATE IN NORTH TOP OF CURB AT WASHBURN ROAD AND CONOUGH LANE.
723.9992M (2375.32FT) NAVD 1988 DATUM

CONOUGH LANE (PUBLIC) PROFILE

Southwest Homes
3140 S. RAINBOW BLVD #401
LAS VEGAS, NEVADA 89146
(702) 597-3233

ENGINEERING COMPANY
50 So. Jones #202, Las Vegas, NV 89107
Telephone: (702) 877-1500

ALPHA &

EAGLE DANCER

STREET PLAN & PROFILE
CONOUGH LANE

NOTICE
DRAWN BY: 9.24.99
DESIGNED BY: 3.2.98
CHECKED BY: 9.27.99
PROJECT NO: 705104
SCALE: 1"=40'

PROFESSIONAL ENGINEER
EDWARD TANY
CIVIL
9903 MONS. EXPIRY

SHEET
SP5
12 OF 18 SHEETS
DRAWING NO.
1074-4620

