
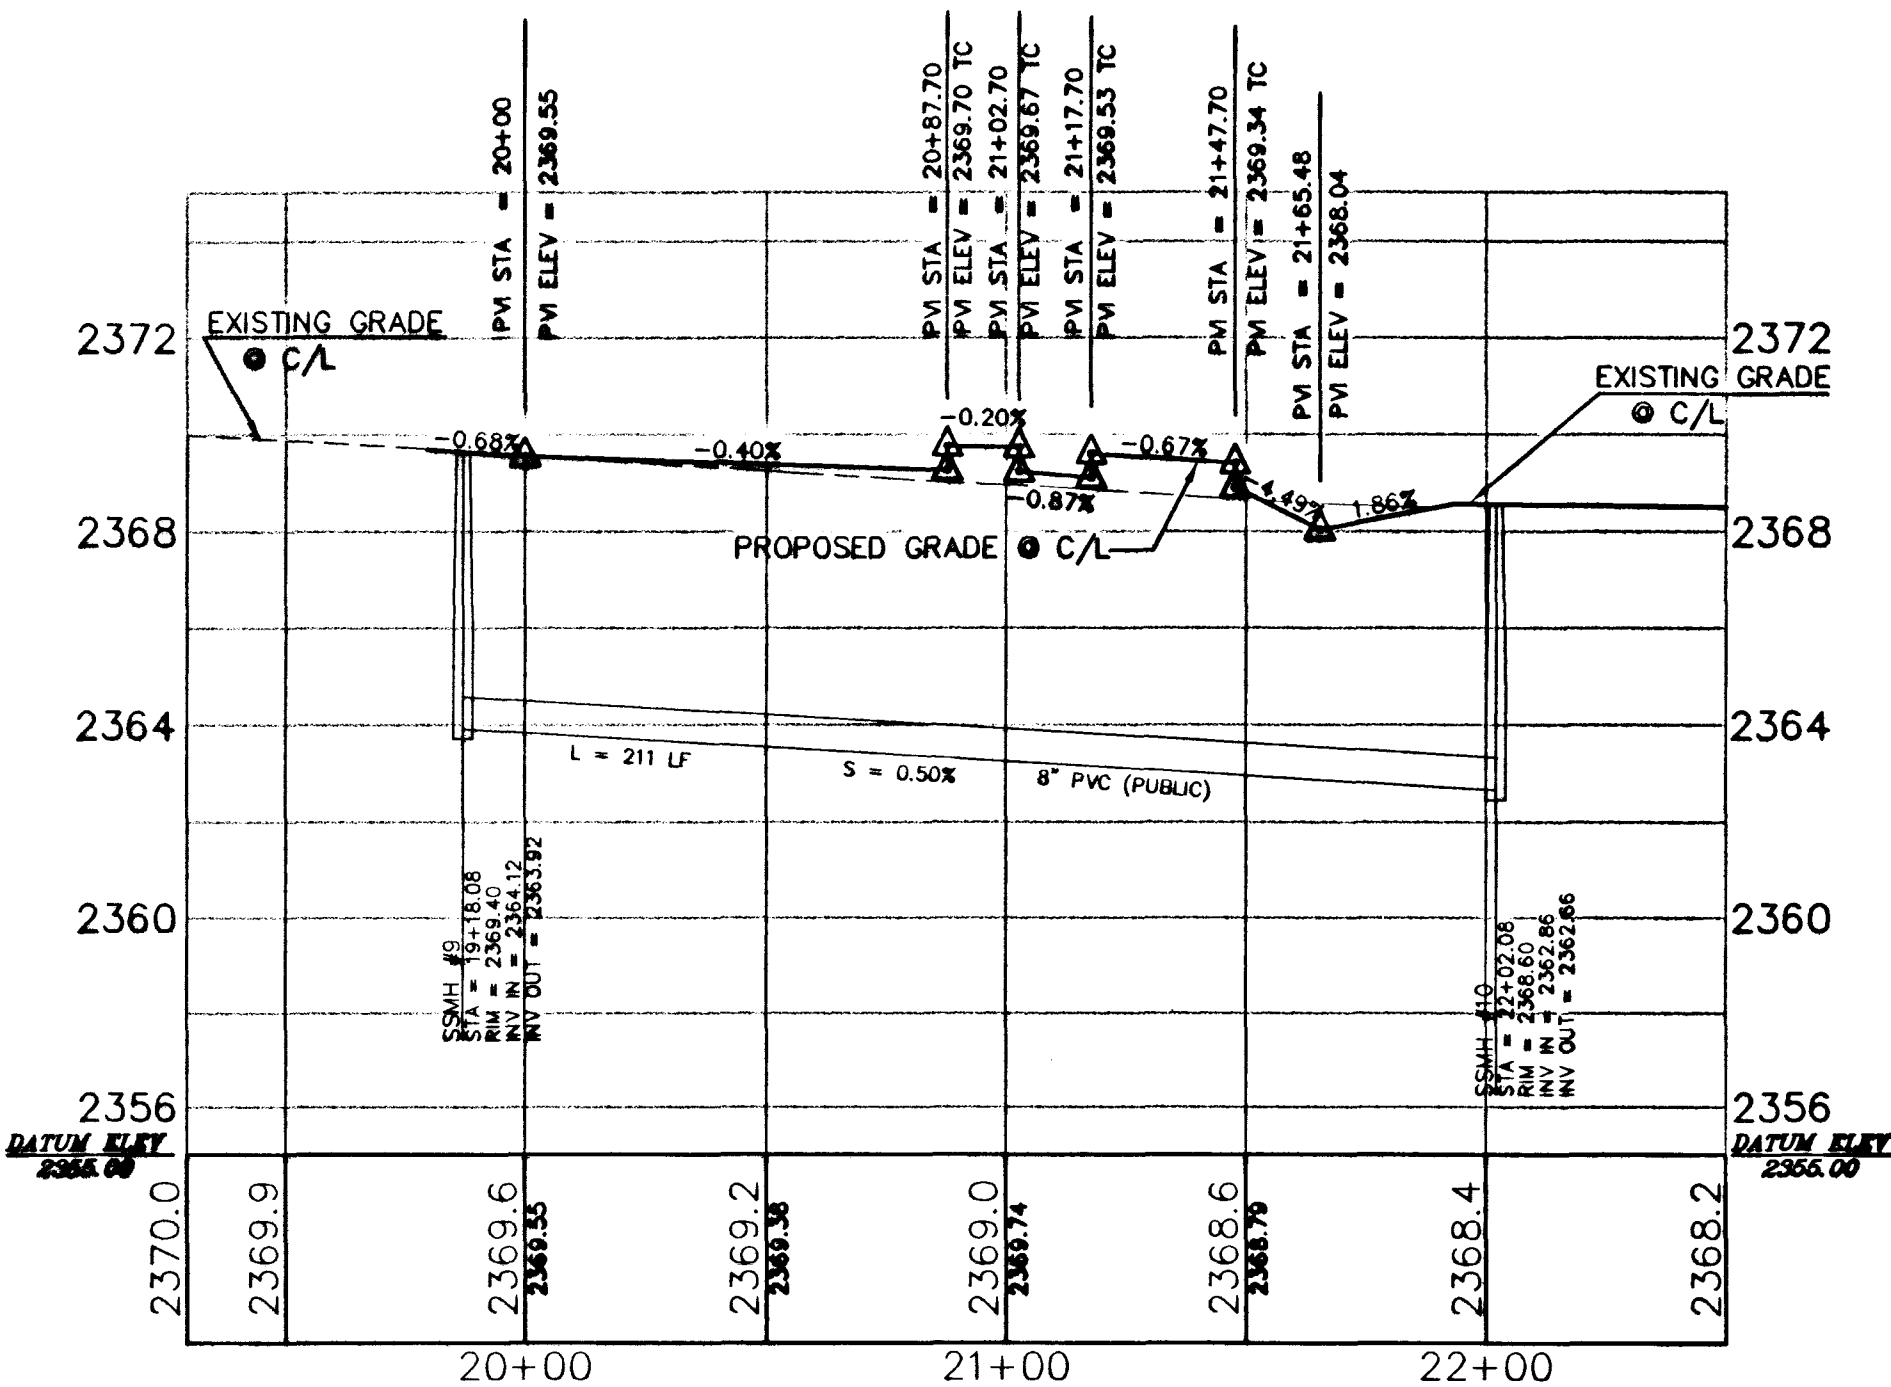


VIEW NAME: SITE



FILE NAME: 5104AMP

SPOTTED HORSE WAY PLAN (PRIVATE)

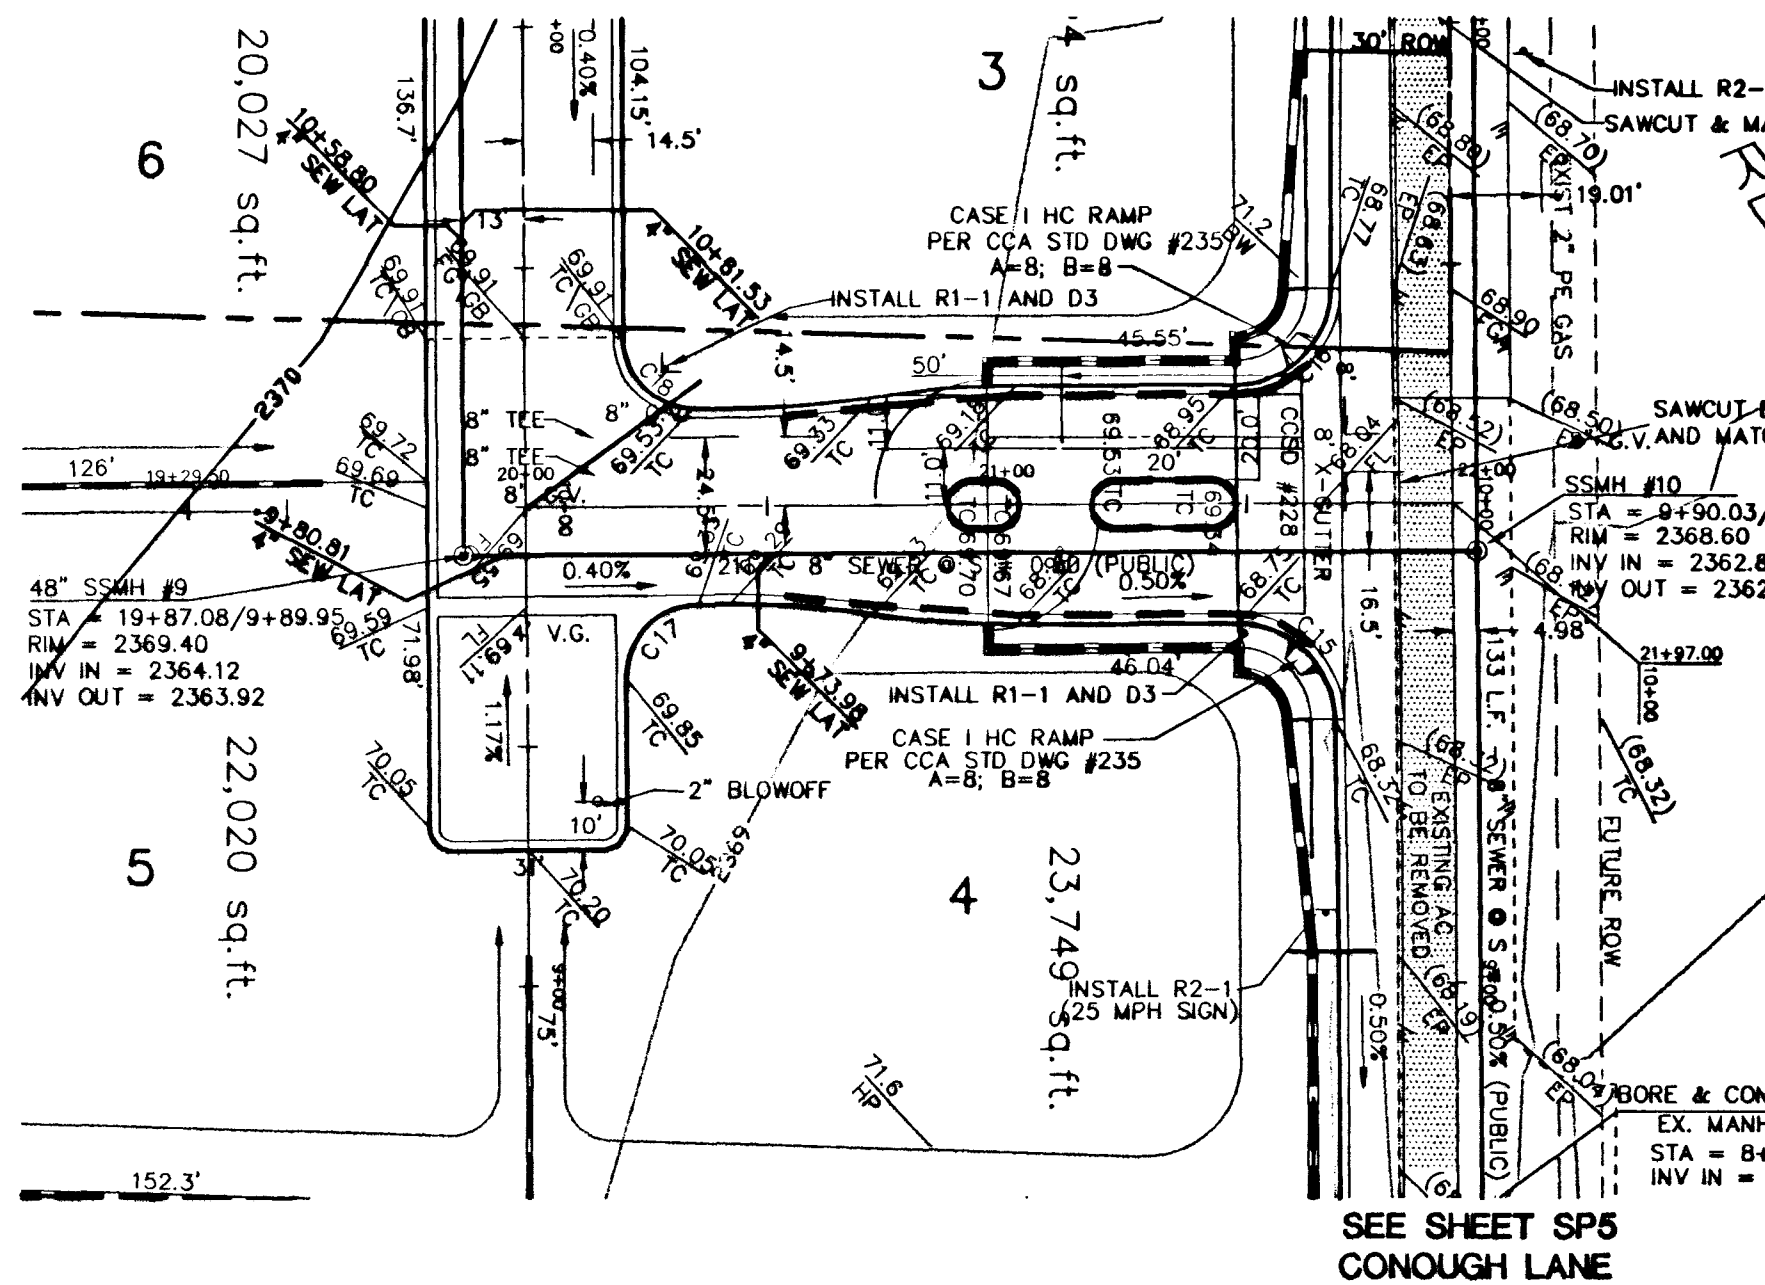

SPOTTED HORSE WAY PROFILE (PRIVATE)

GREY MESA STREET PLAN (PRIVATE)

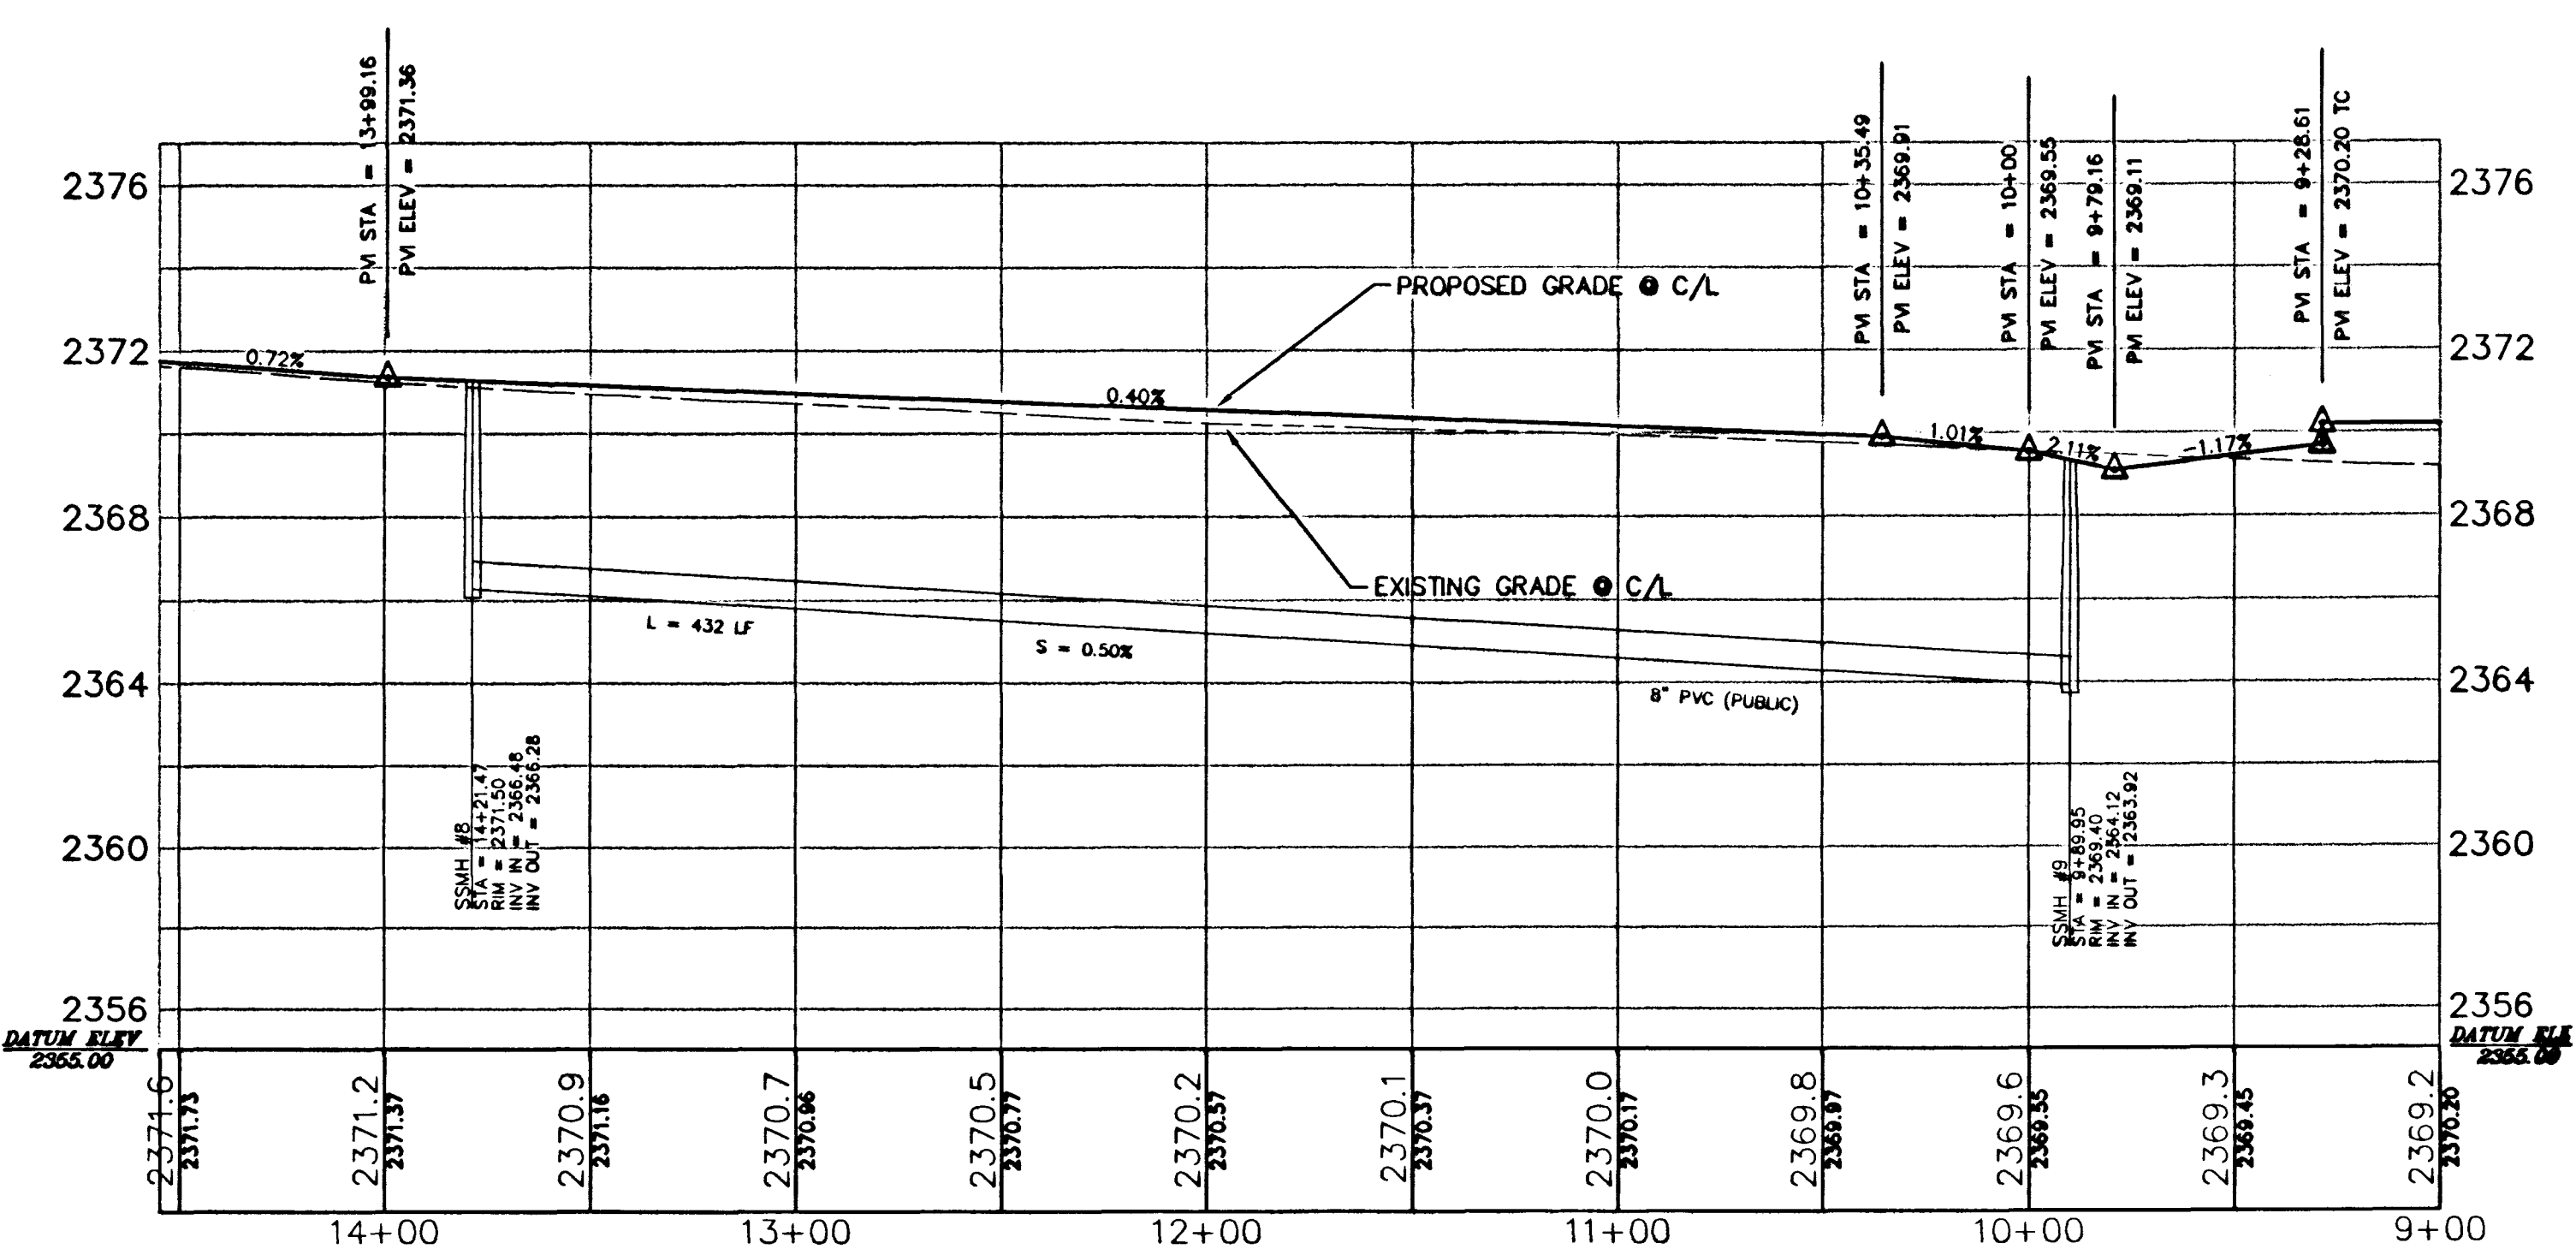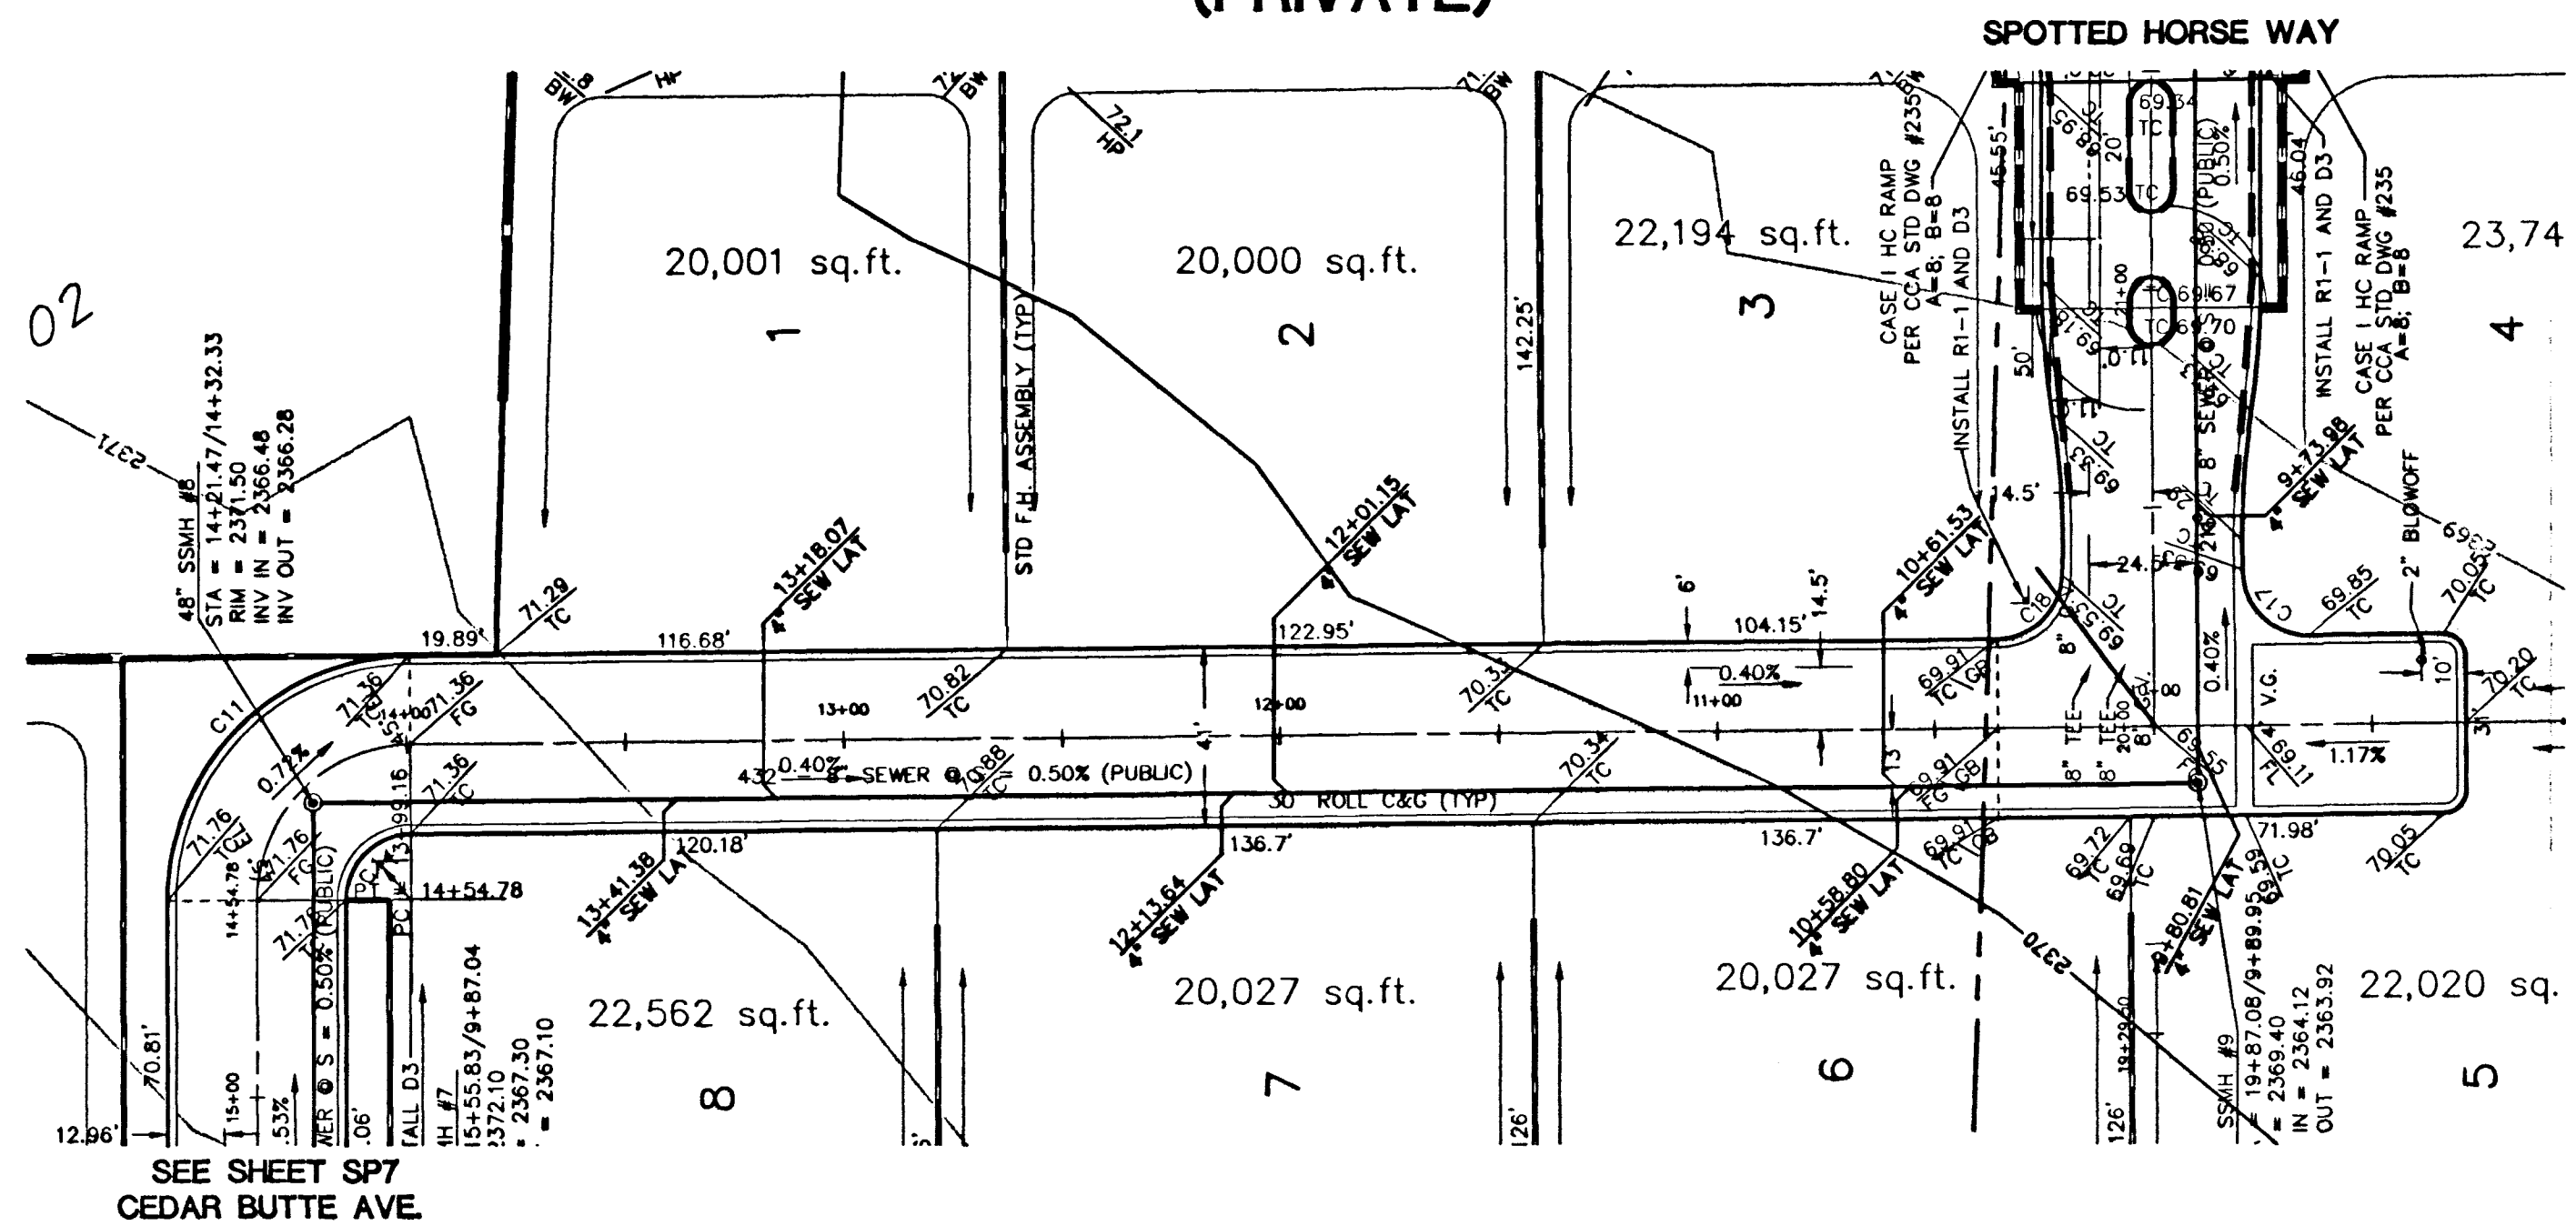

GREY MESA STREET PROFILE (PRIVATE)

BASIS OF BEARING
THE BASIS OF BEARINGS FOR THIS SURVEY IS THE WEST LINE OF THE SOUTHEAST ONE-QUARTER OF SECTION 33, TOWNSHIP 19 SOUTH, RANGE 60 EAST, N.D.M. WHICH BEARS NORTH 00° 05' 41" EAST AS SHOWN IN THE OFFICE OF THE CLARK COUNTY, NEVADA RECORDER IN FILE 4 OF PARCEL MAPS ON PAGE 28.

BENCHMARK
CITY OF LAS VEGAS BENCHMARK #11V90336B, RIVET & PLATE IN NORTH TOP OF CURB AT WASHBURN ROAD AND CONOUGH LANE.
723.9992M (2375.32FT) NAVD 1988 DATUM

NOTICE:
EXISTING UTILITIES ARE SHOWN ON PLANS FOR THE CONVEYANCE OF THE CONTRACTOR ONLY. THE CONTRACTOR IS RESPONSIBLE FOR THE LOCATION OF ALL UTILITIES. THE ENGINEER BEARS NO RESPONSIBILITY FOR UTILITIES NOT SHOWN OR SHOWN INCORRECTLY.

Coll Before You Dig
1-800-227-2600
UNDERGROUND SERVICE (USA)

EDWARD F. TANEY
CIVIL
No. 9903 NVNEN
9/23/99

SP6
13 OF 18 SHEETS
DRAWING NO. 1074-4620

**STREET PLAN & PROFILE
SPOTTED HORSE WAY /
GREY MESA STREET**

EAGLE DANCER


DRAWN BY: 9/24/99
DESIGNED BY: 3/2/98
CHECKED BY: EFT
PROJECT NO: 705104
SCALE: 1"=40'

Southwest Homes
3140 S. RAINBOW BLVD. #401
LAS VEGAS, NEVADA 89146
(702) 597-3233

ALPHA & ENGINEERING COMPANY
50 So. Jones #202, Las Vegas, NV, 89107
Telephone: (702) 877-1300



REV	DATE	BY	REVISION

SPOTTED HORSE WAY PLAN
(PRIVATE)

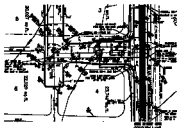

SPOTTED HORSE WAY PROFILE
(PRIVATE)

GREY MESA STREET PLAN
(PRIVATE)

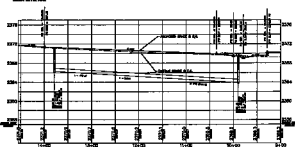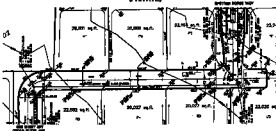

GREY MESA STREET PROFILE
(PRIVATE)



DATE OF RECORD
2011/05/24
BY: [Signature]
CHECKED BY: [Signature]
APPROVED BY: [Signature]

RECORDS
2011/05/24
2011/05/24



