GRAPHIC SCALE

(IN FEET)
1 inch = 40 ft.

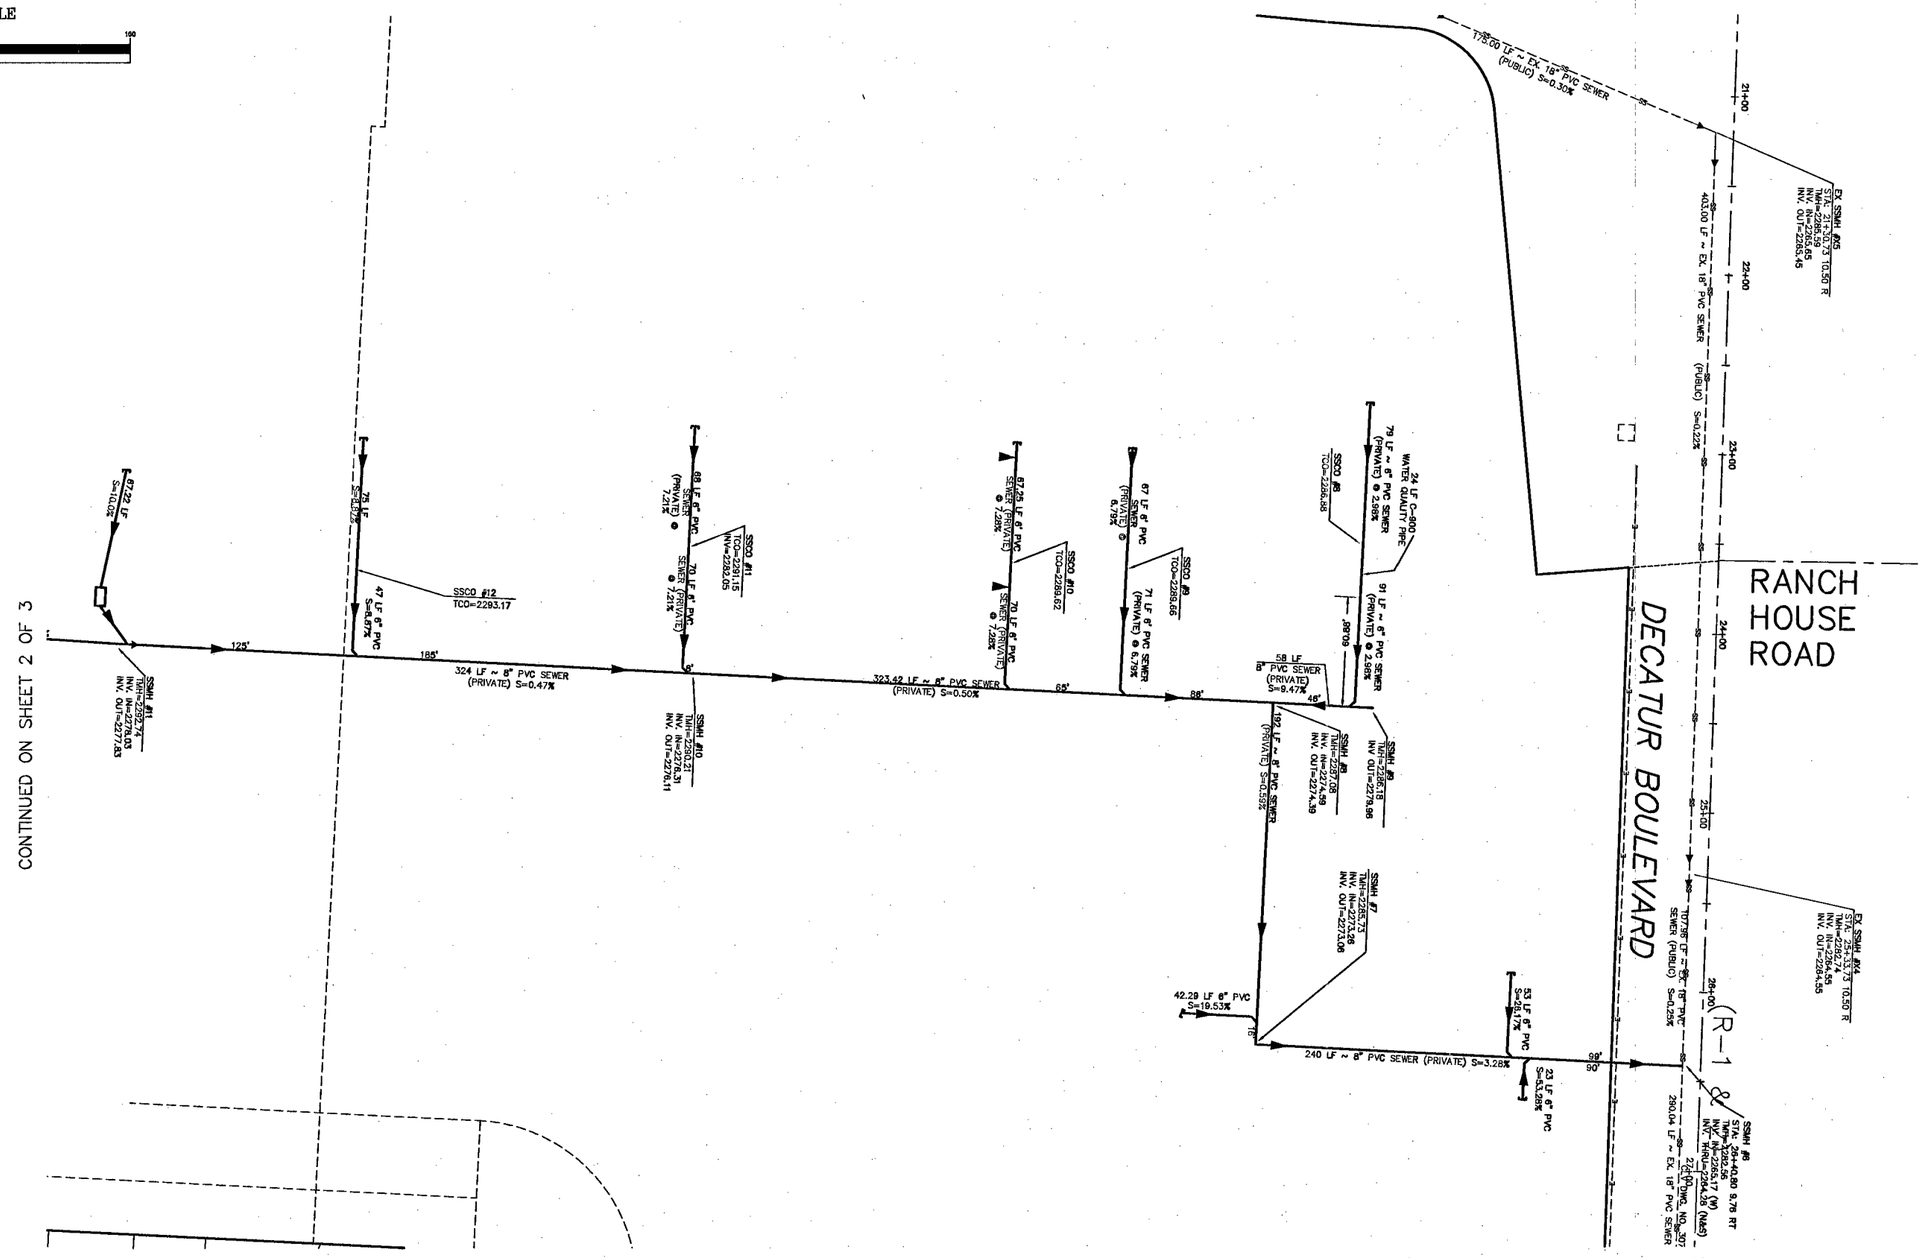

LEGEND

- EXISTING SANITARY SEWER MANHOLE
- EXISTING SANITARY SEWER CLEANOUT
- EXISTING SANITARY SEWER PER HTE #08-7046
- EXISTING SANITARY SEWER BY OTHERS

QUANTITIES

48" SS MANHOLE (PUBLIC)	2 EACH
48" SS MANHOLE (PRIVATE)	14 EACH
SSCO (PRIVATE)	12 EACH

MATERIALS

WATER- PVC C900 (JOHN MANSVILLE)
SEWER- SDR35 PIPE (JOHN MANSVILLE)

117190

NO.	DATE	BY	APPV'D.	REVISION DESCRIPTION

STAMP DATE:

SOUTHWEST ENGINEERING
3610 North Rancho Drive
Las Vegas, Nevada 89130
Telephone: (702) 645-8037
Fax: (702) 914-9148
LAND PLANNING • MAPPING • DEVELOPMENT

TITLE: SANITARY SEWER ASBUILT
HTE #08-7046

PROJECT: DECATUR & TROPICAL

WORK ORDER NO: 070619
DESIGN BY: JEL
DATE: 5-8-09
SCALE: 1"=100'
CADFILE: I:\070619\DT-BNDY
SHEET 1 OF 3 SHEETS

H 27324
107Y9968 (1)

"As Built" MH. Location